




A 374+00

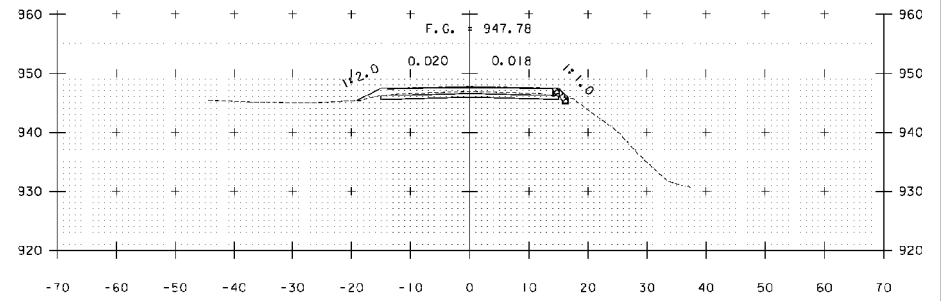

A 375+00

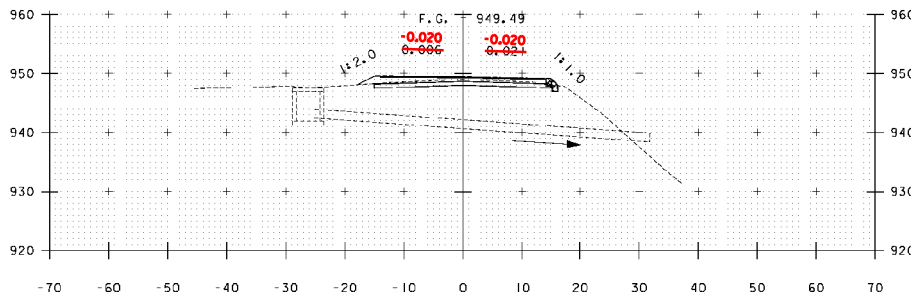

A 373+88

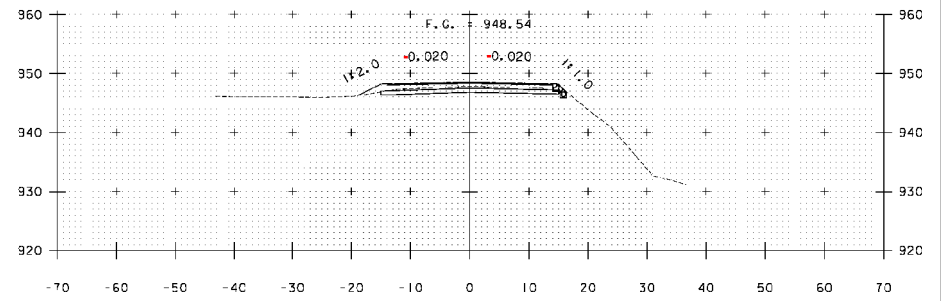

A 374+50

PROJECT NAME:	WARDSBORO-JAMAICA
PROJECT NUMBER:	ER STP 013-1(17)
FILE NAME:	xs.dgn
PROJECT LEADER:	K. LPMAL
DESIGNED BY:	E. KIPP
CROSS SECTIONS	
PLLOT DATE:	3/18/2014
DRAWN BY:	B. KIPP
CHECKED BY:	HSD
SHEET	318 OF 444

STA. A 373+88 TO STA. A 375+00