




A 381+50

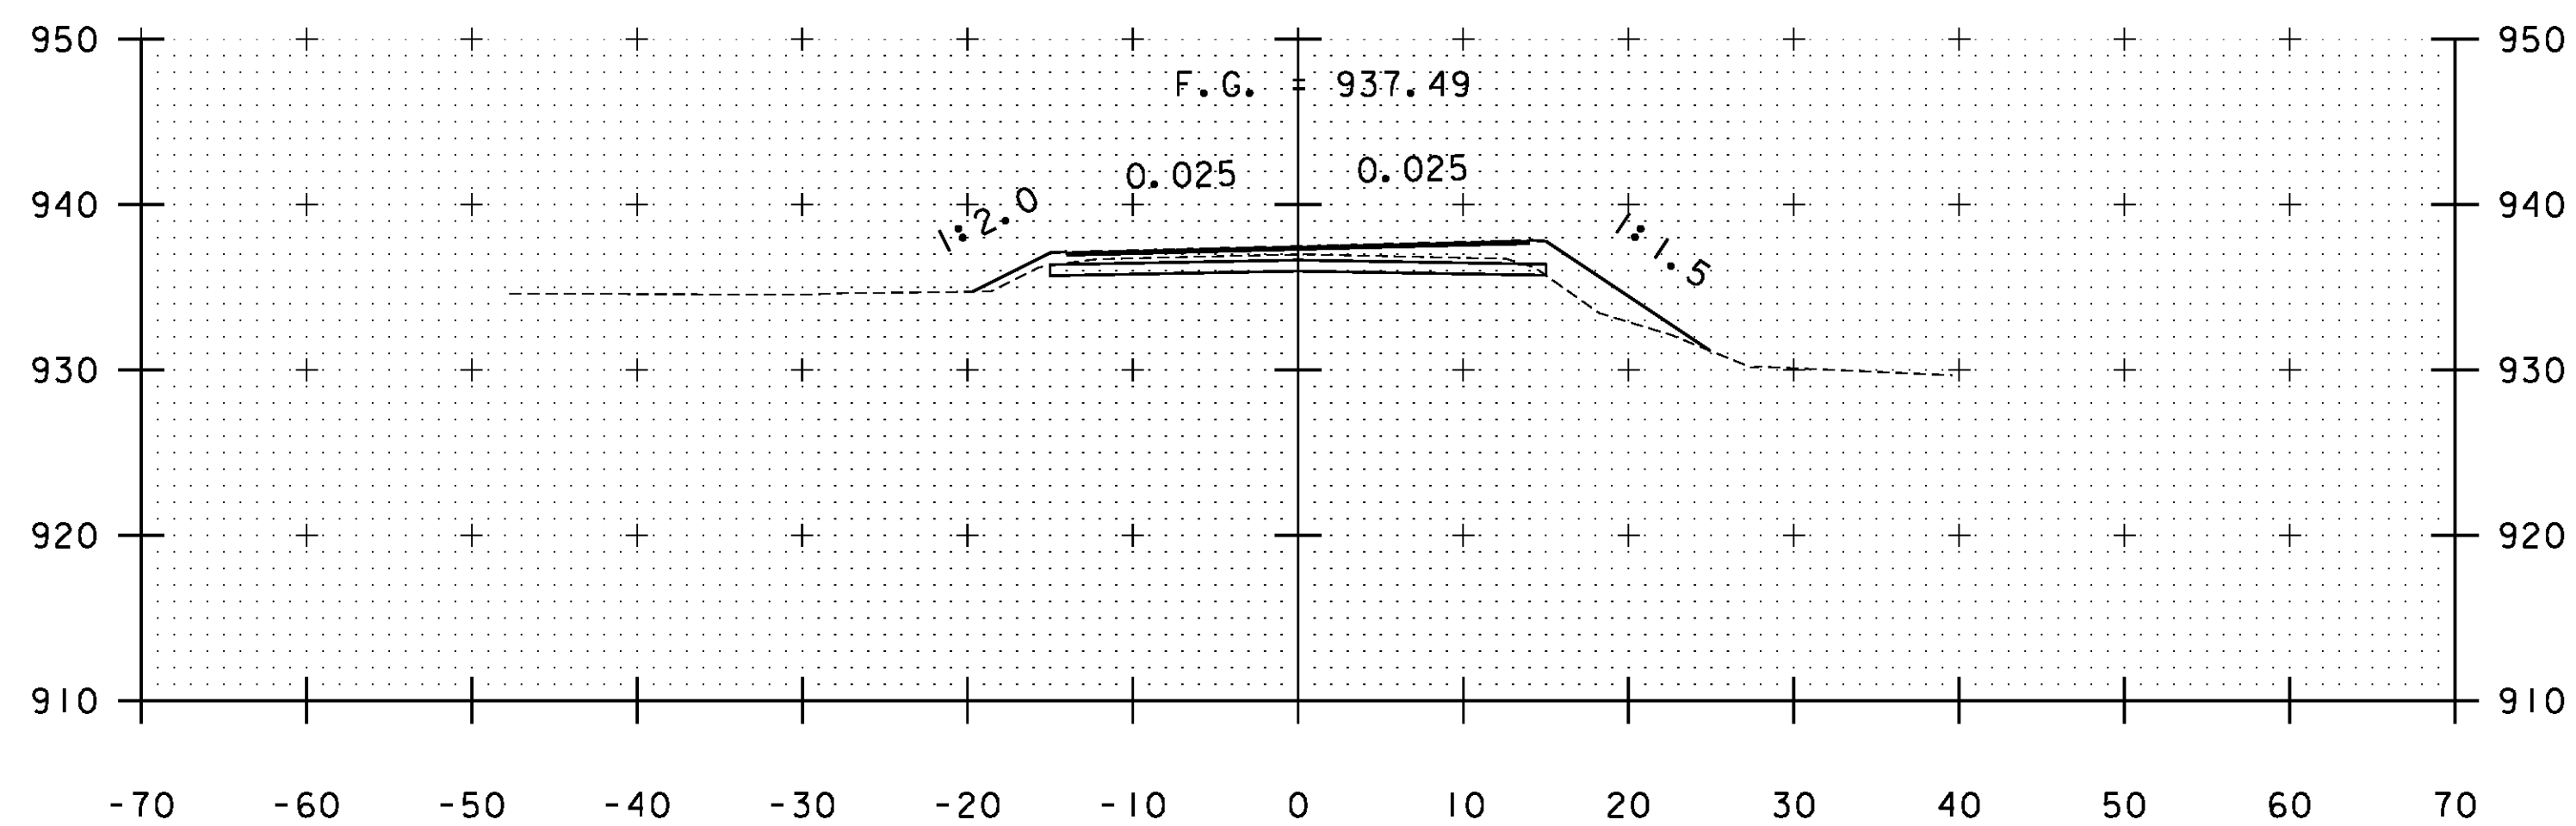


A 381+00

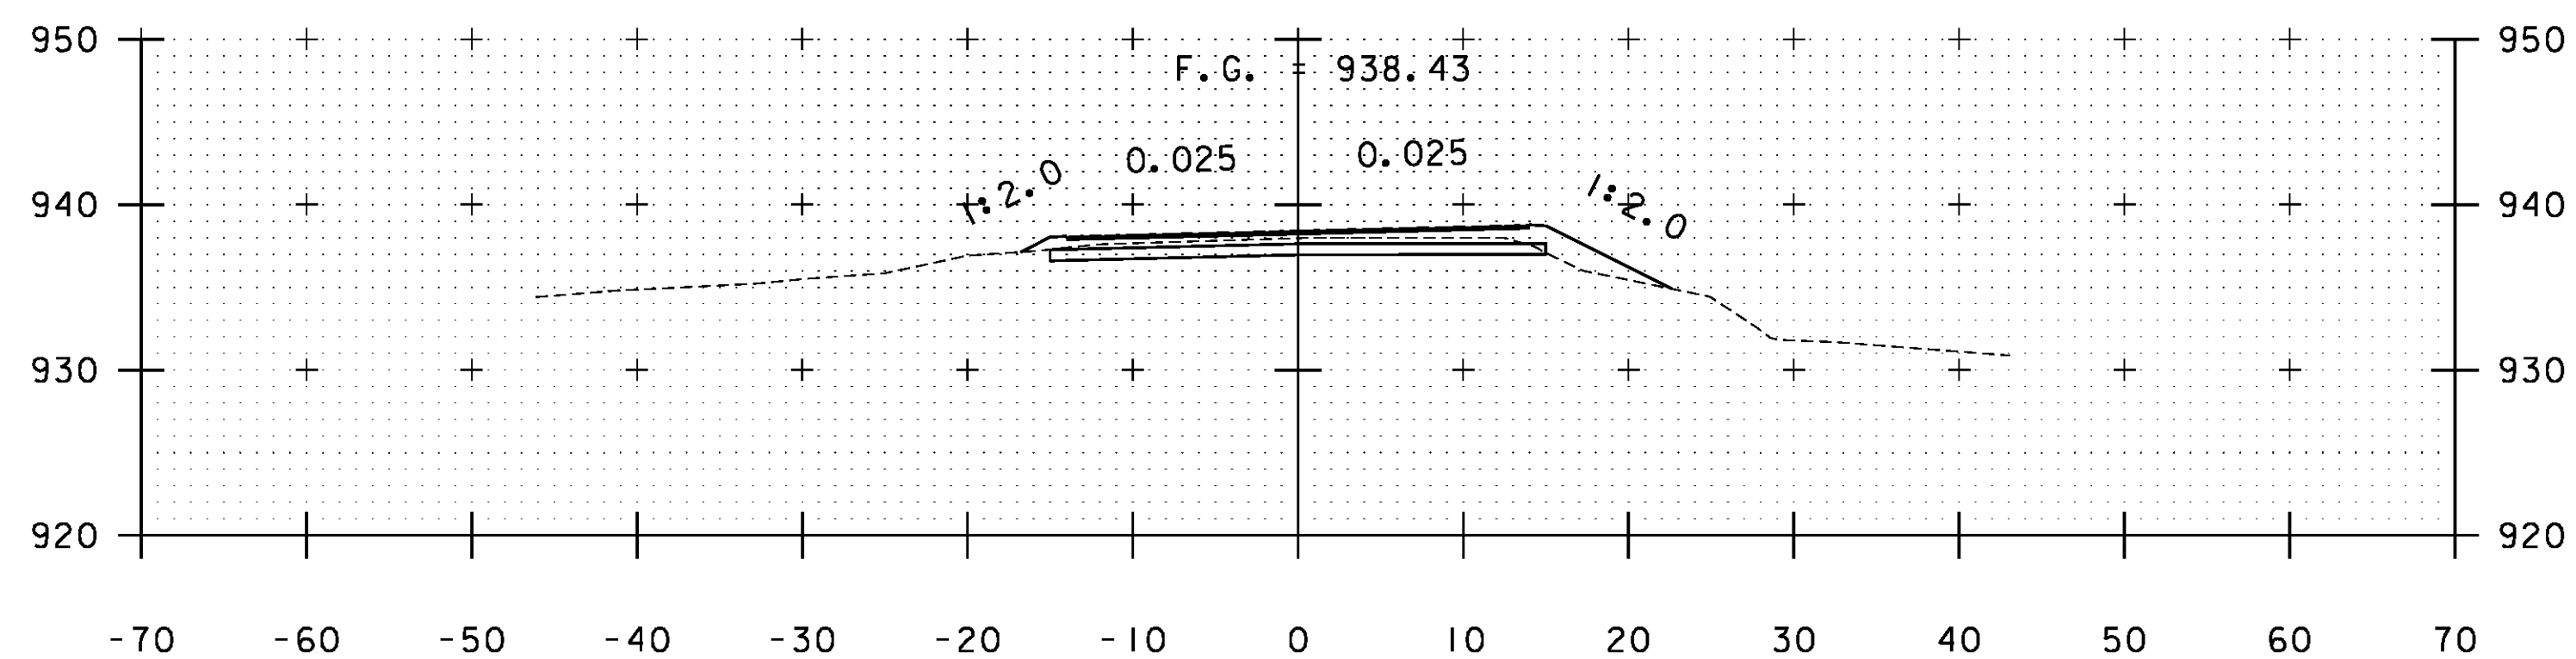


A 380+50

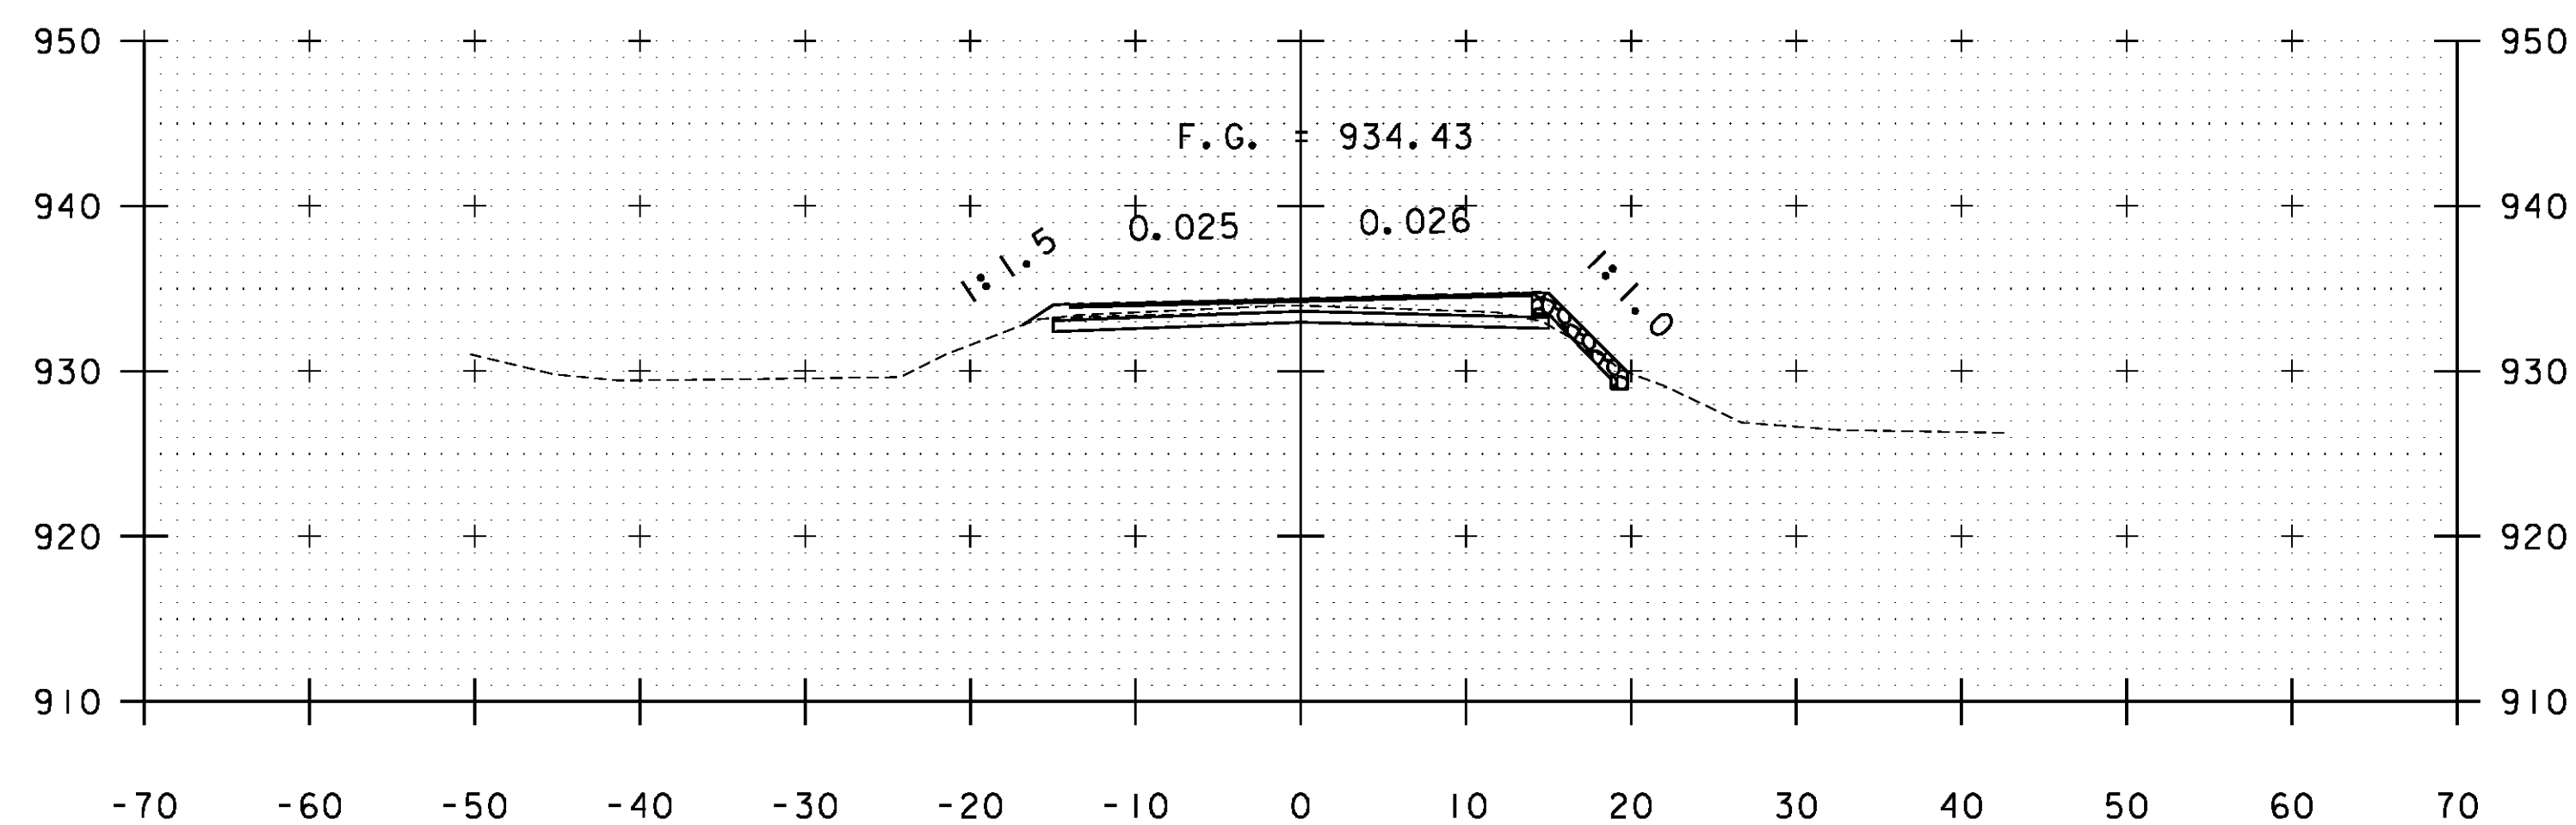

A 383+00

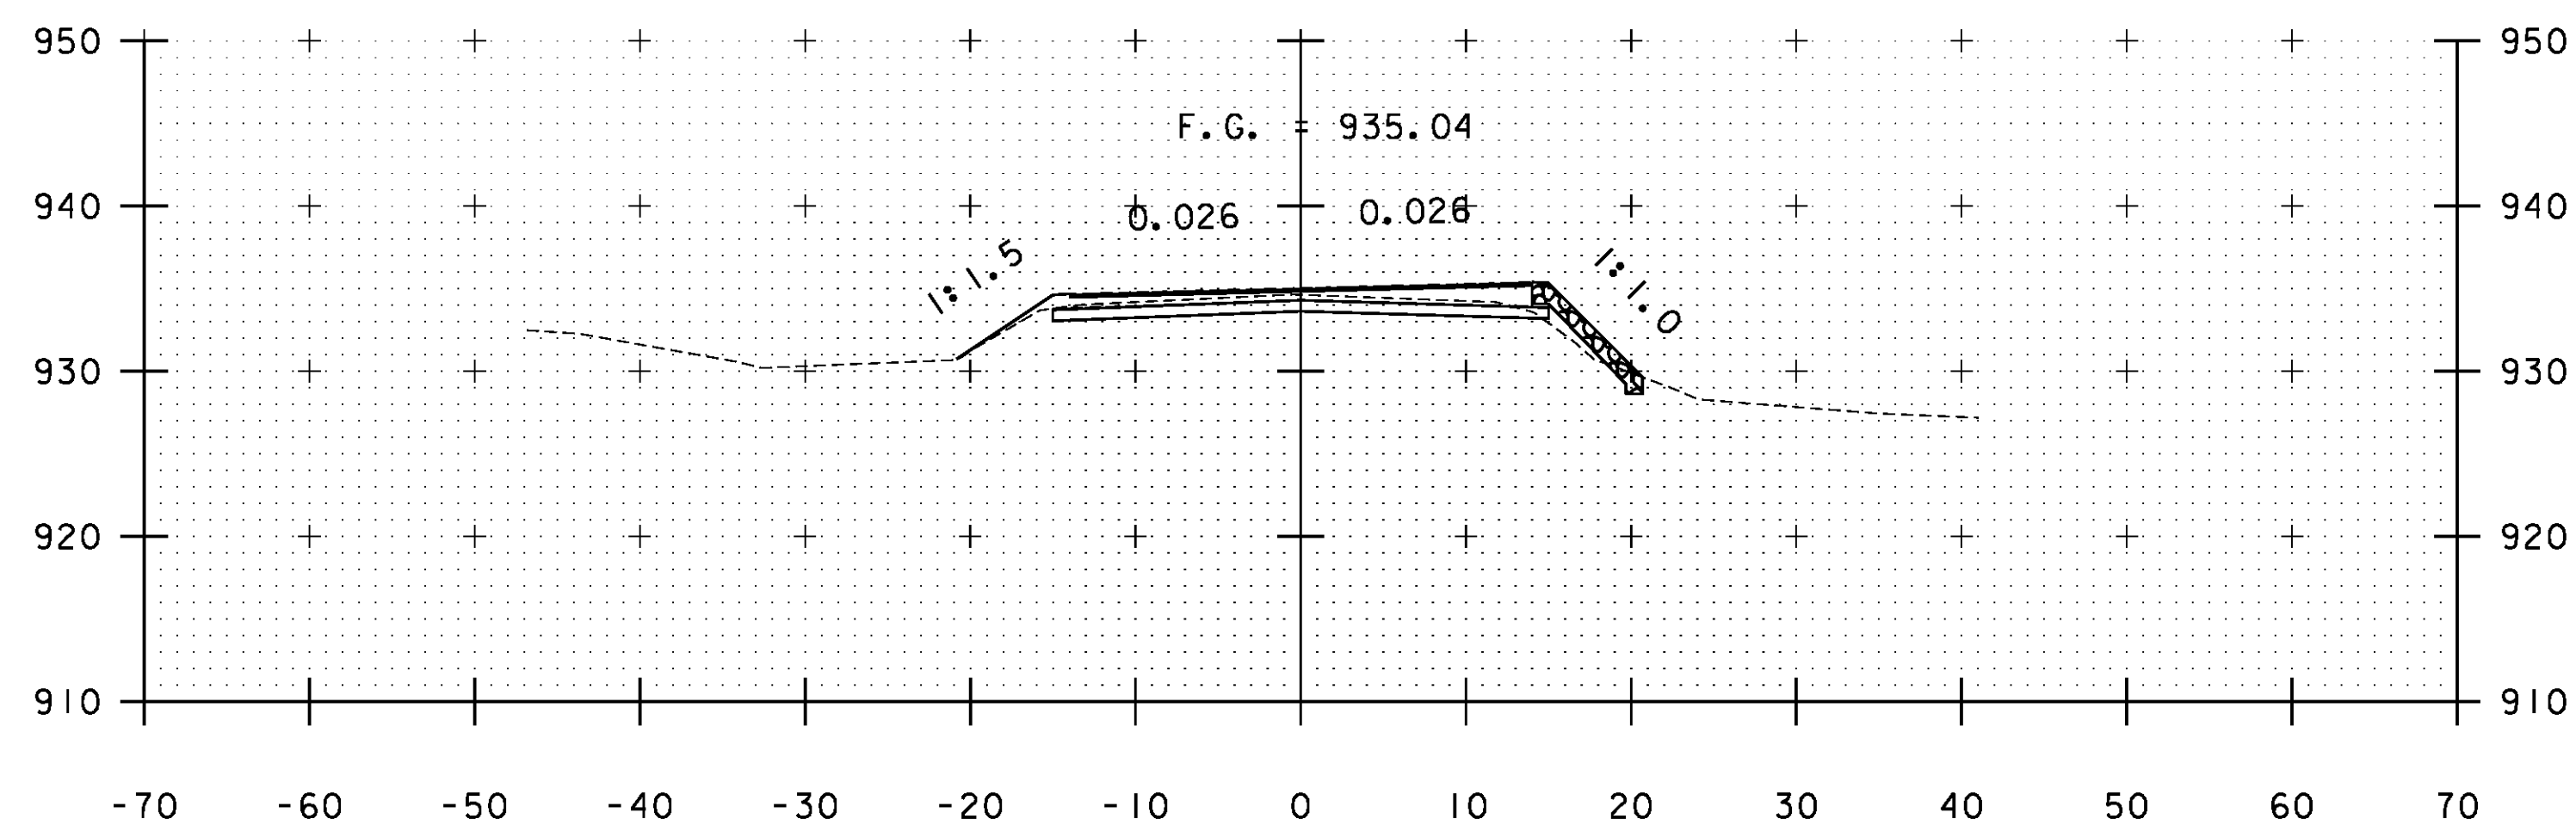

A 382+50

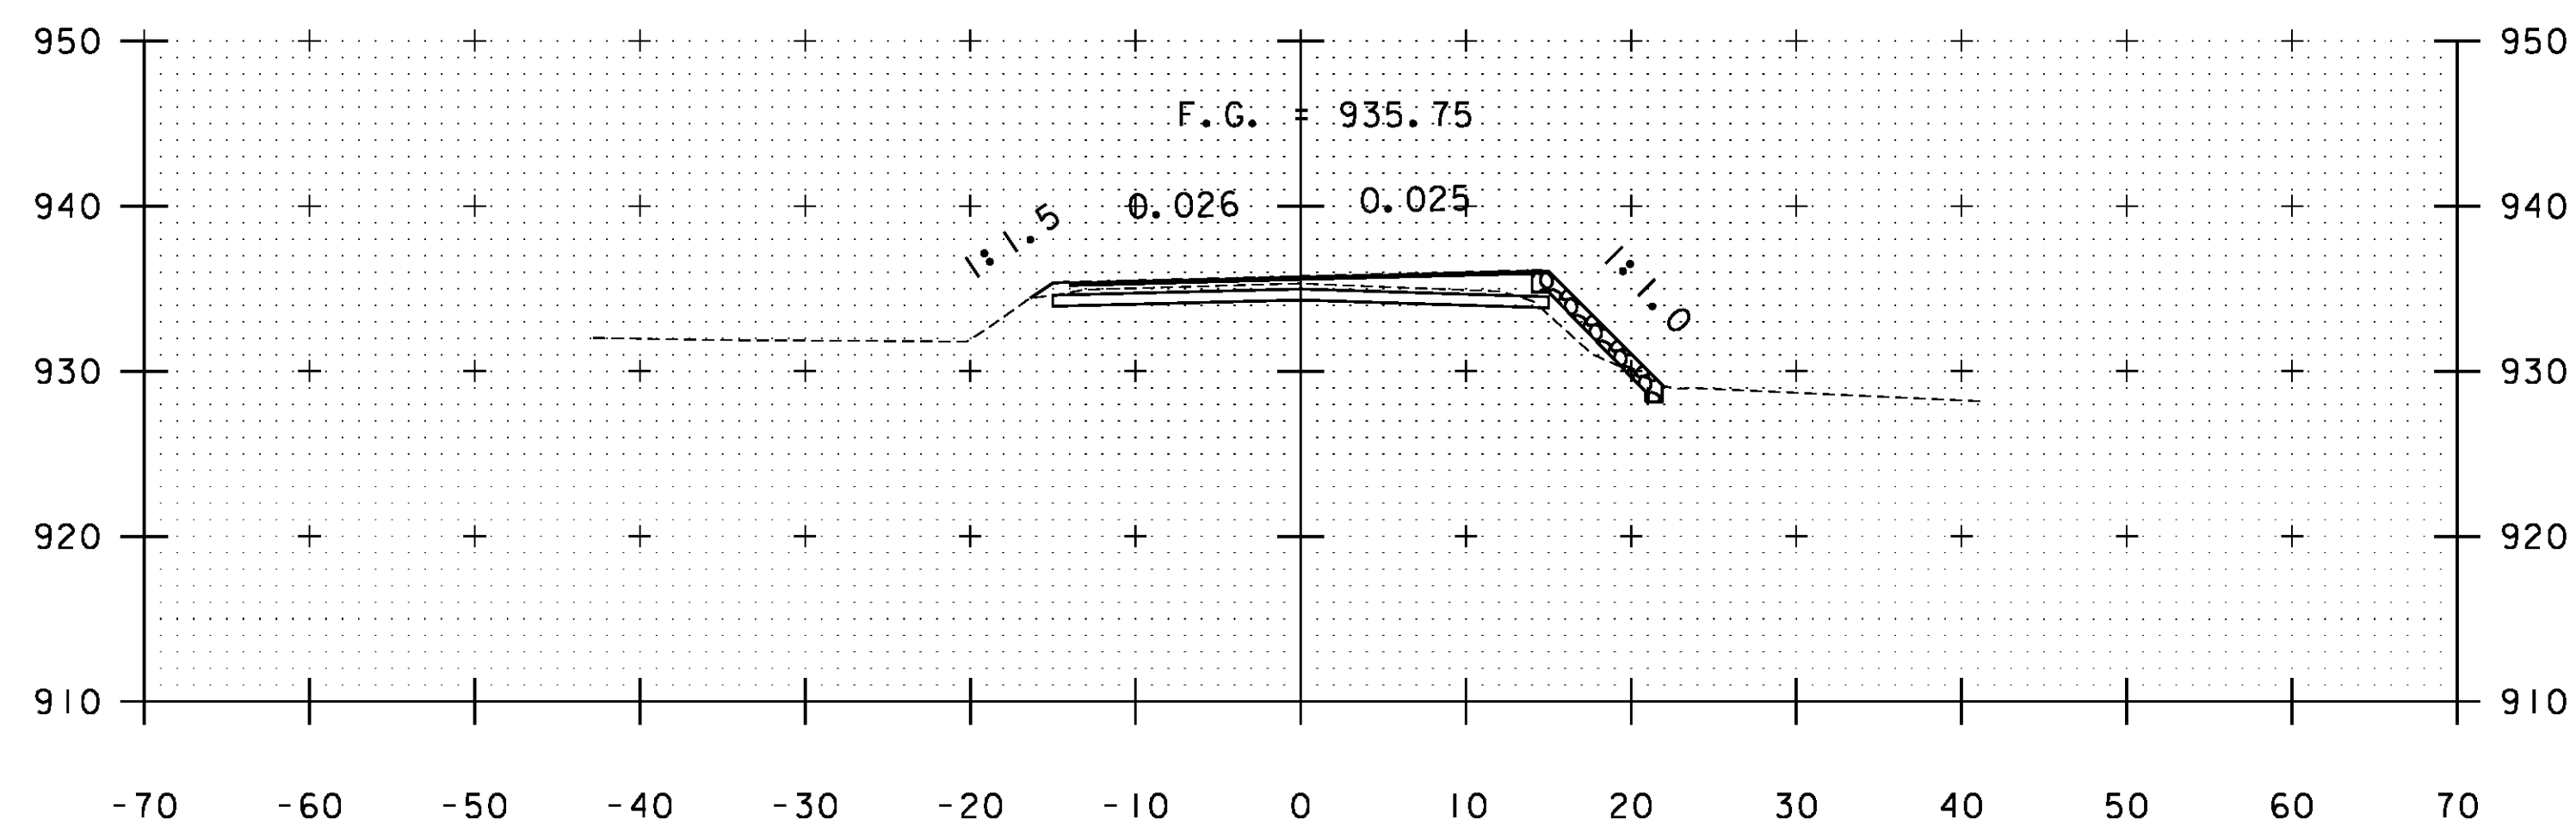

A 382+00

STA. A 380+50 TO STA. A 383+00

PROJECT NAME: WARDBORO-JAMAICA	PLOT DATE: 2/26/2014
PROJECT NUMBER: ER STP 013-1(17)	DRAWN BY: B. KIPP
FILE NAME: xs.dgn	CHECKED BY: HSD
PROJECT LEADER: K. UPMAL	SHEET 321 OF 444
DESIGNED BY: B. KIPP	
CROSS SECTIONS	