




A 384+50

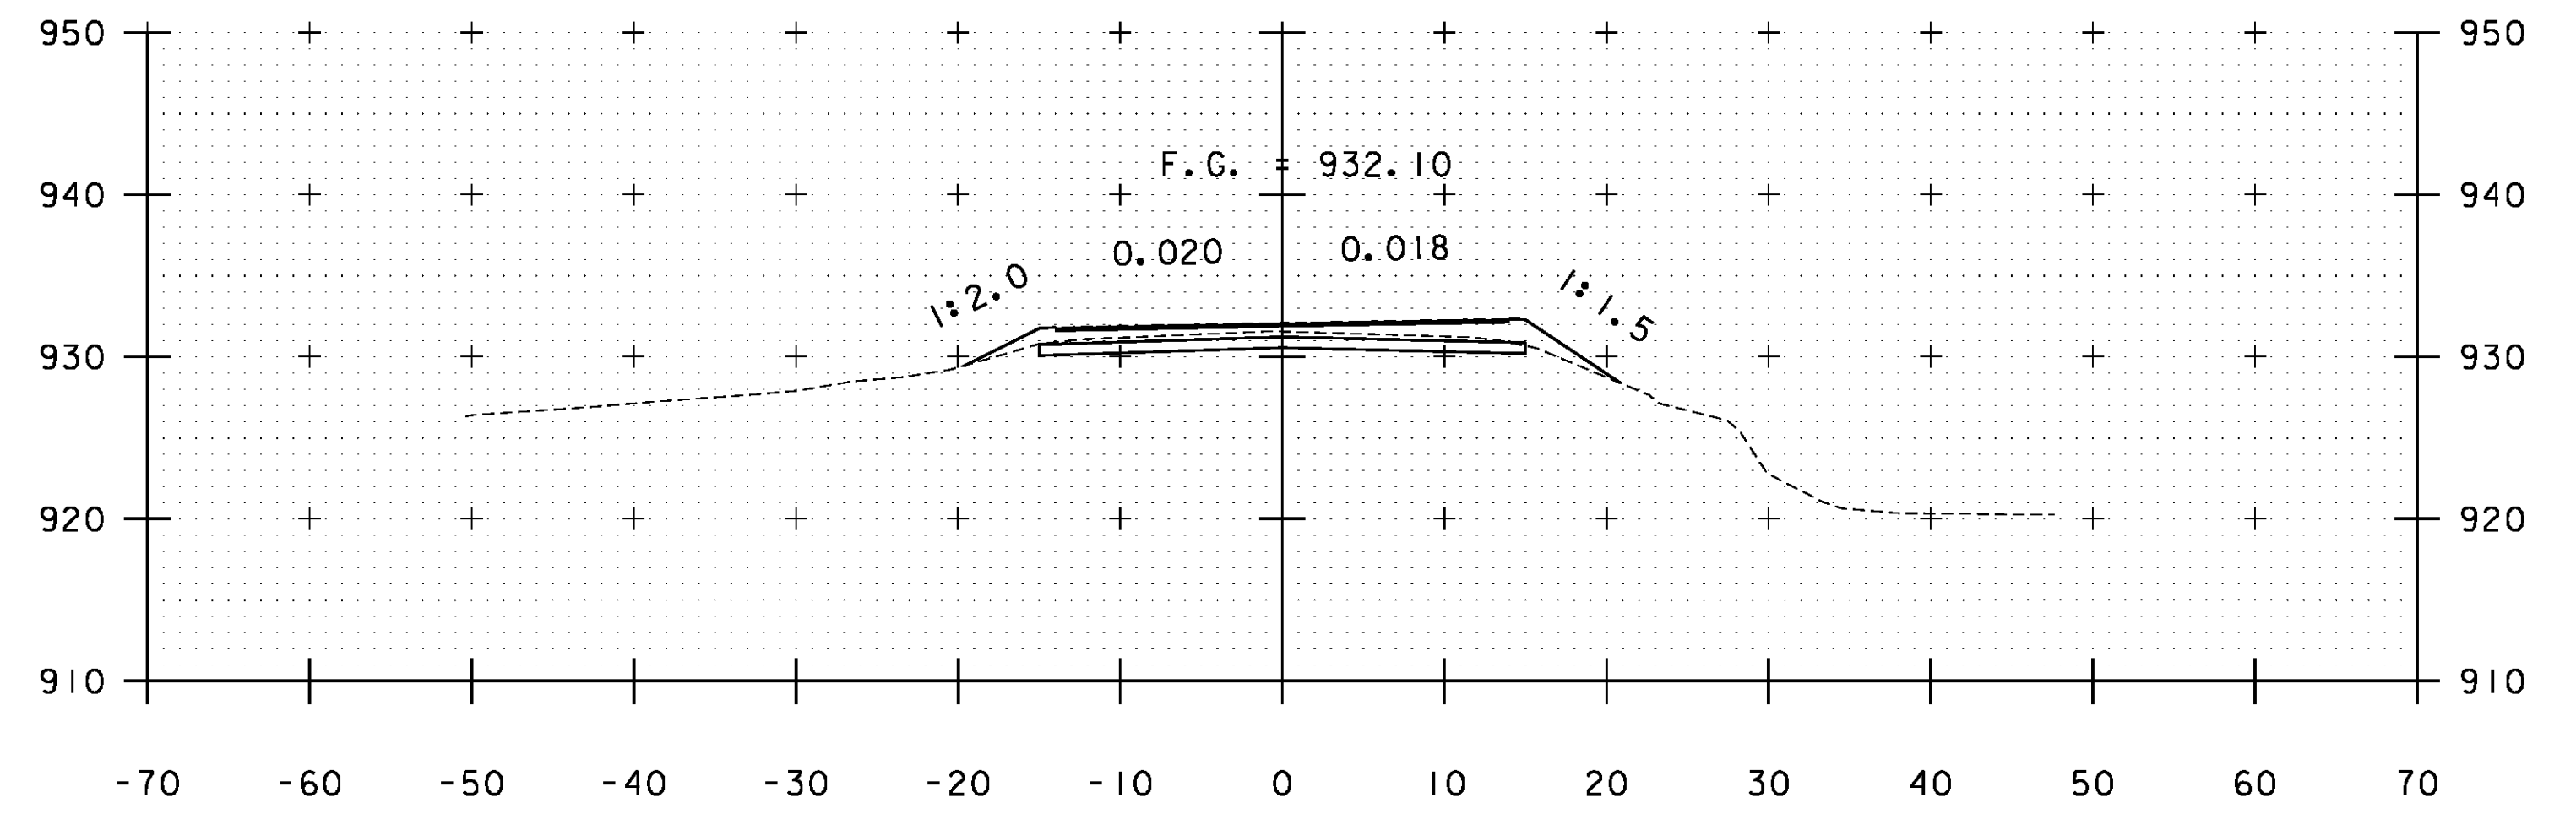


A 386+00

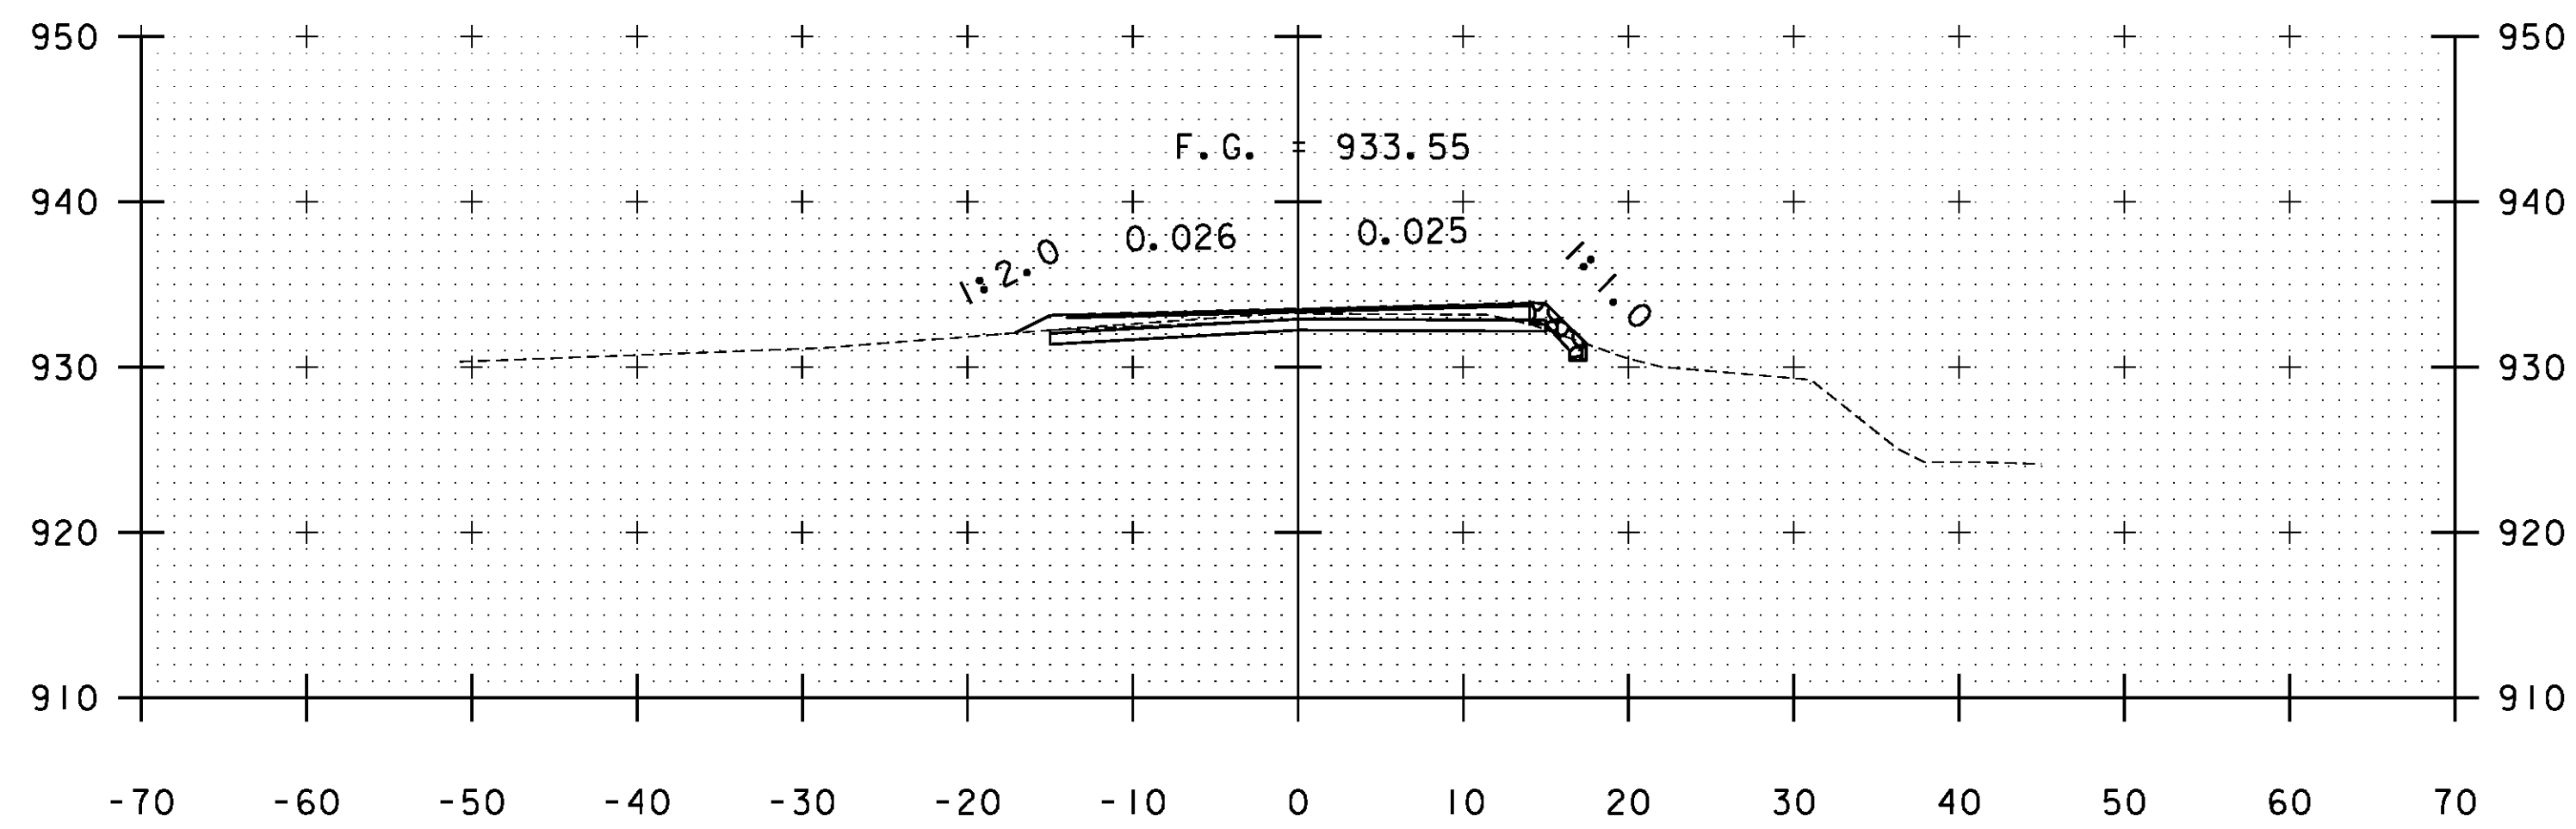


A 384+00

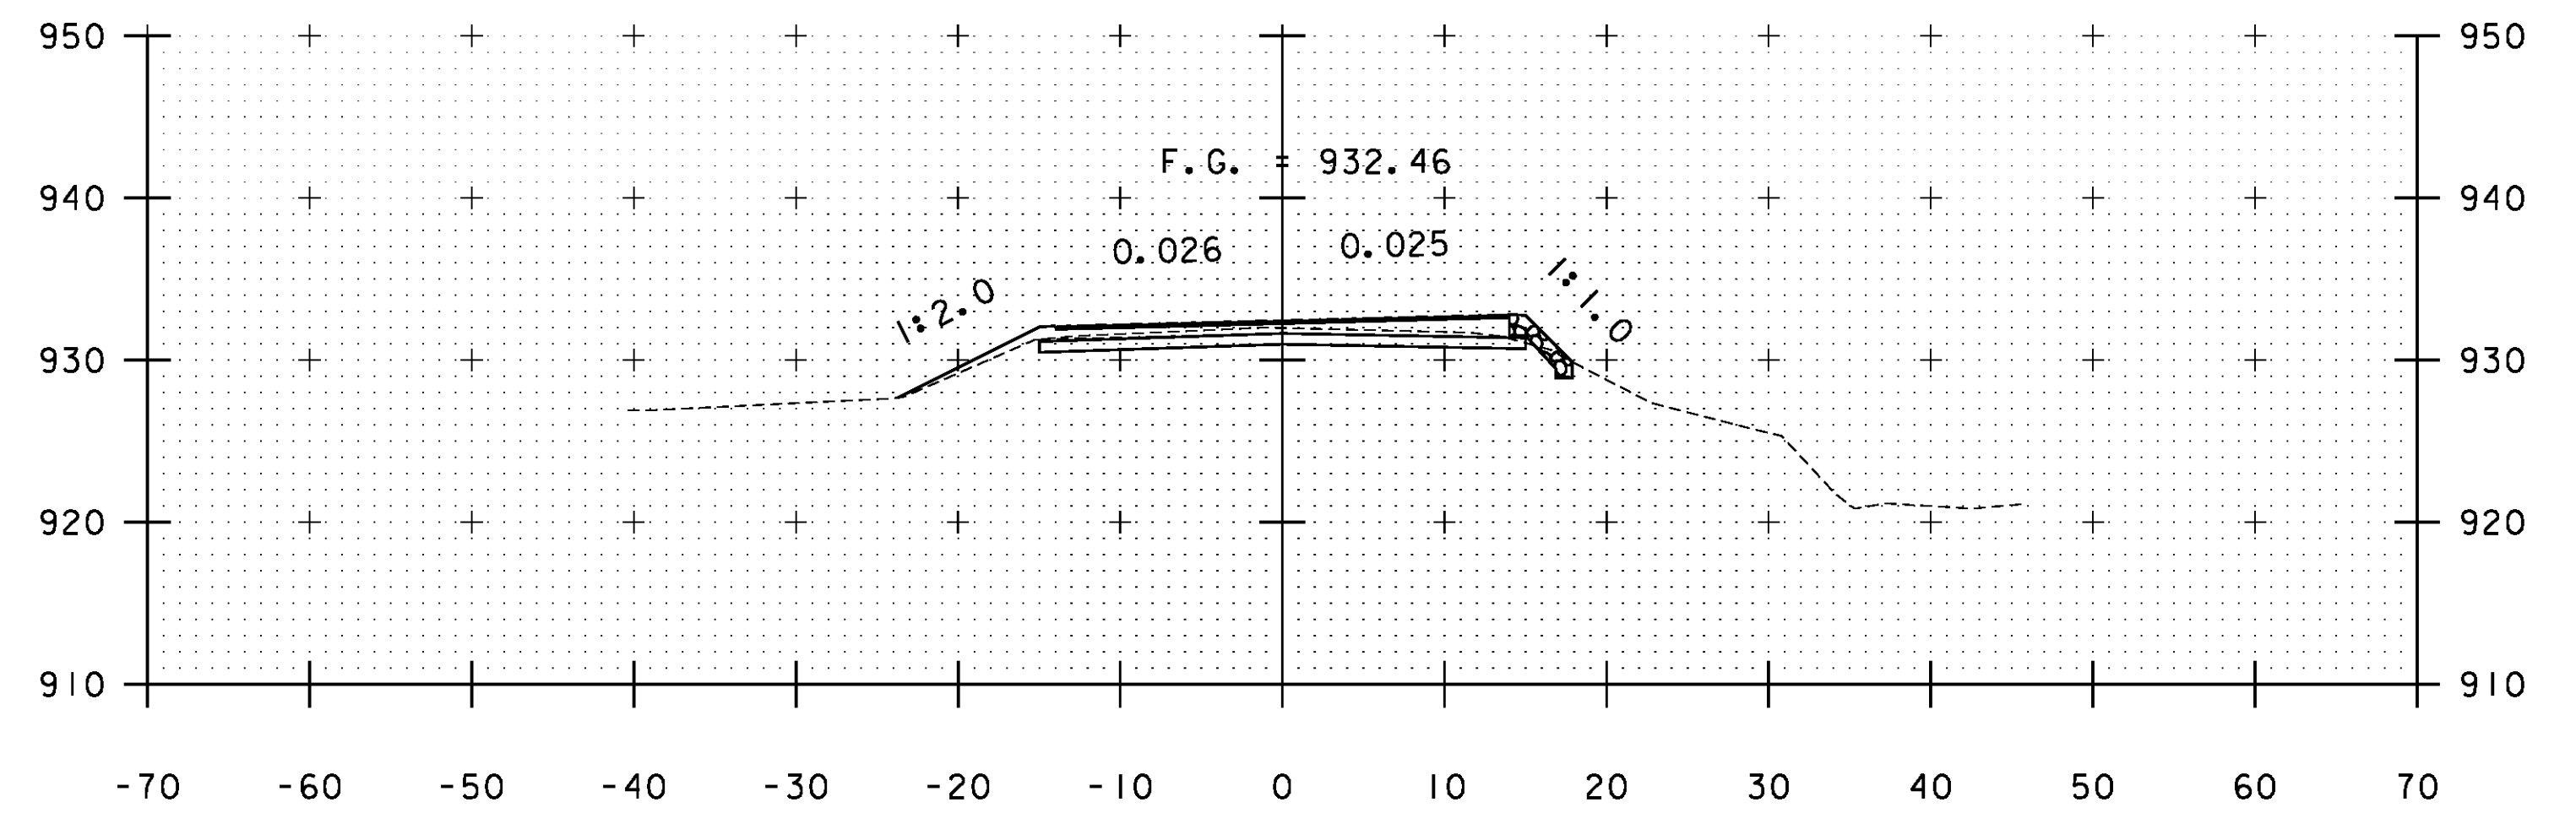

A 385+50

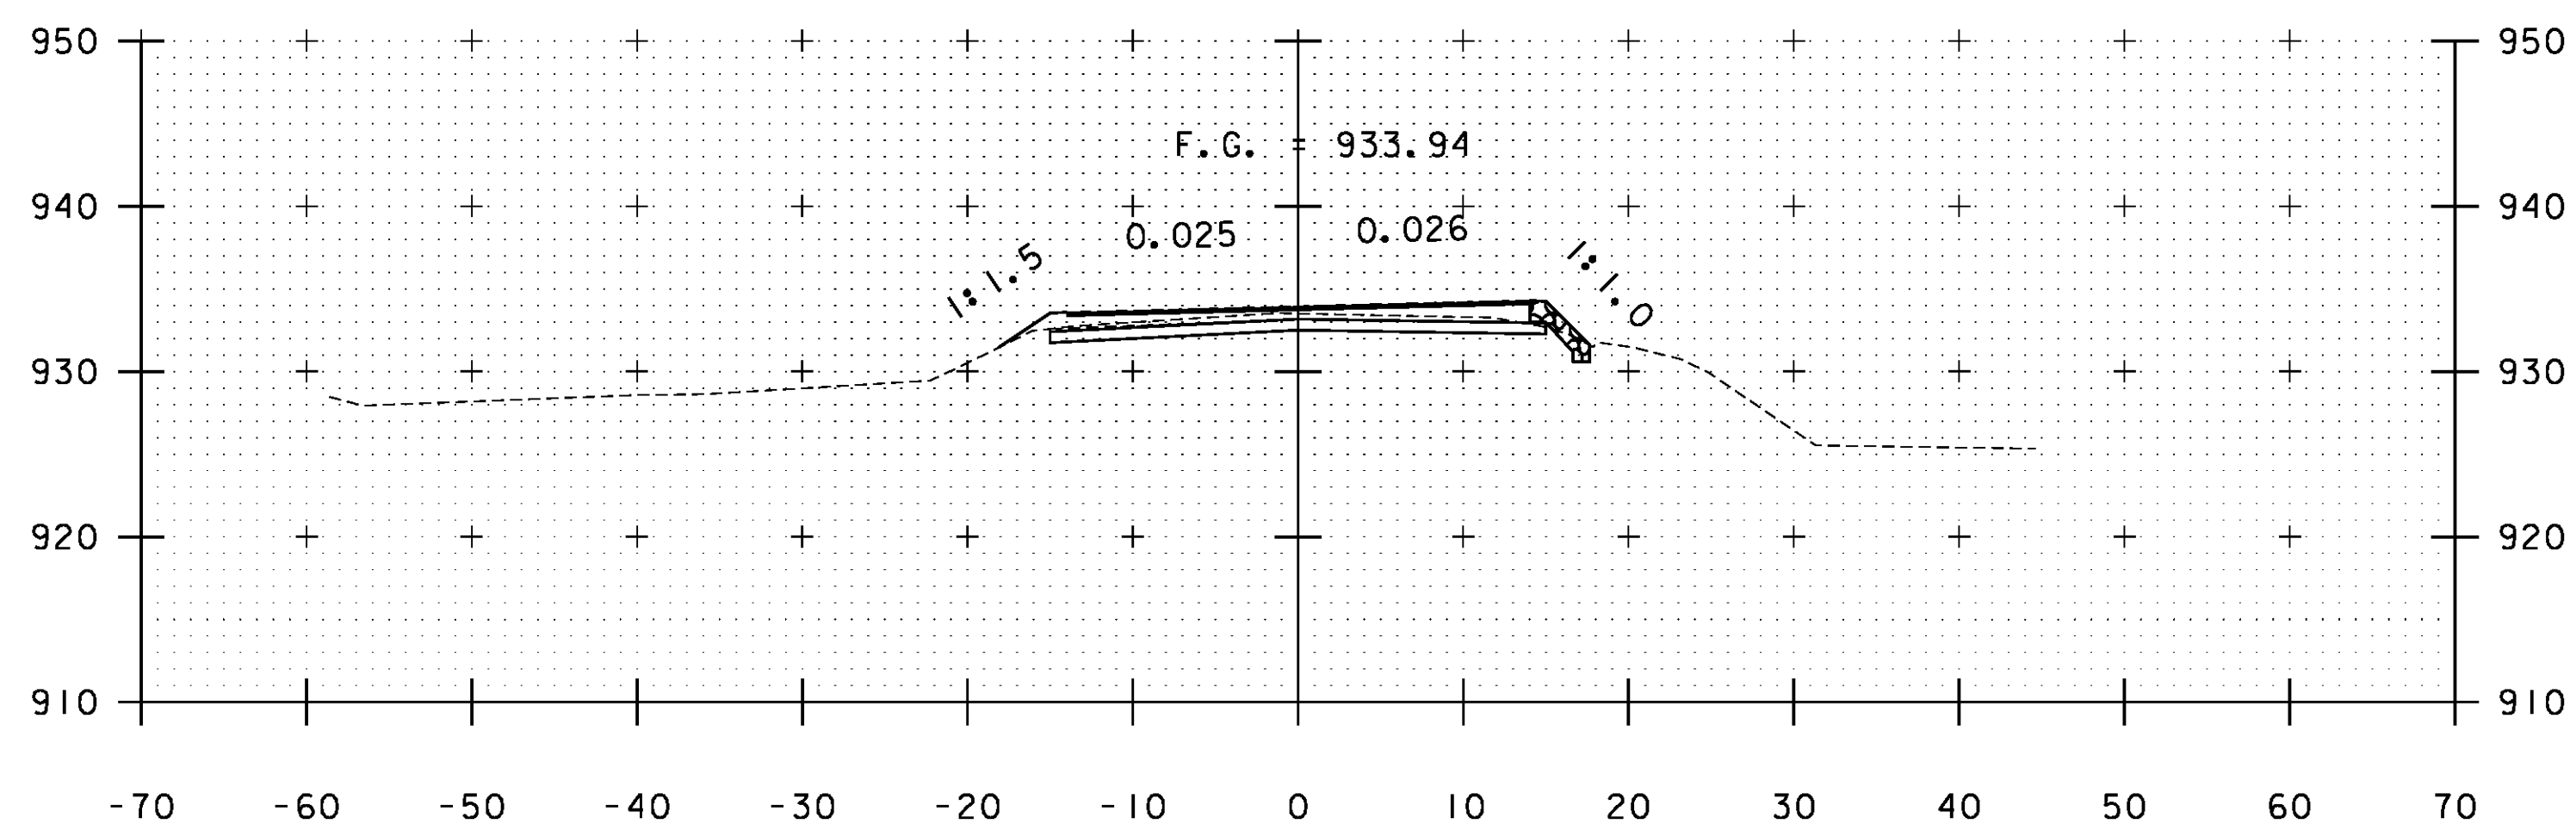

A 383+50

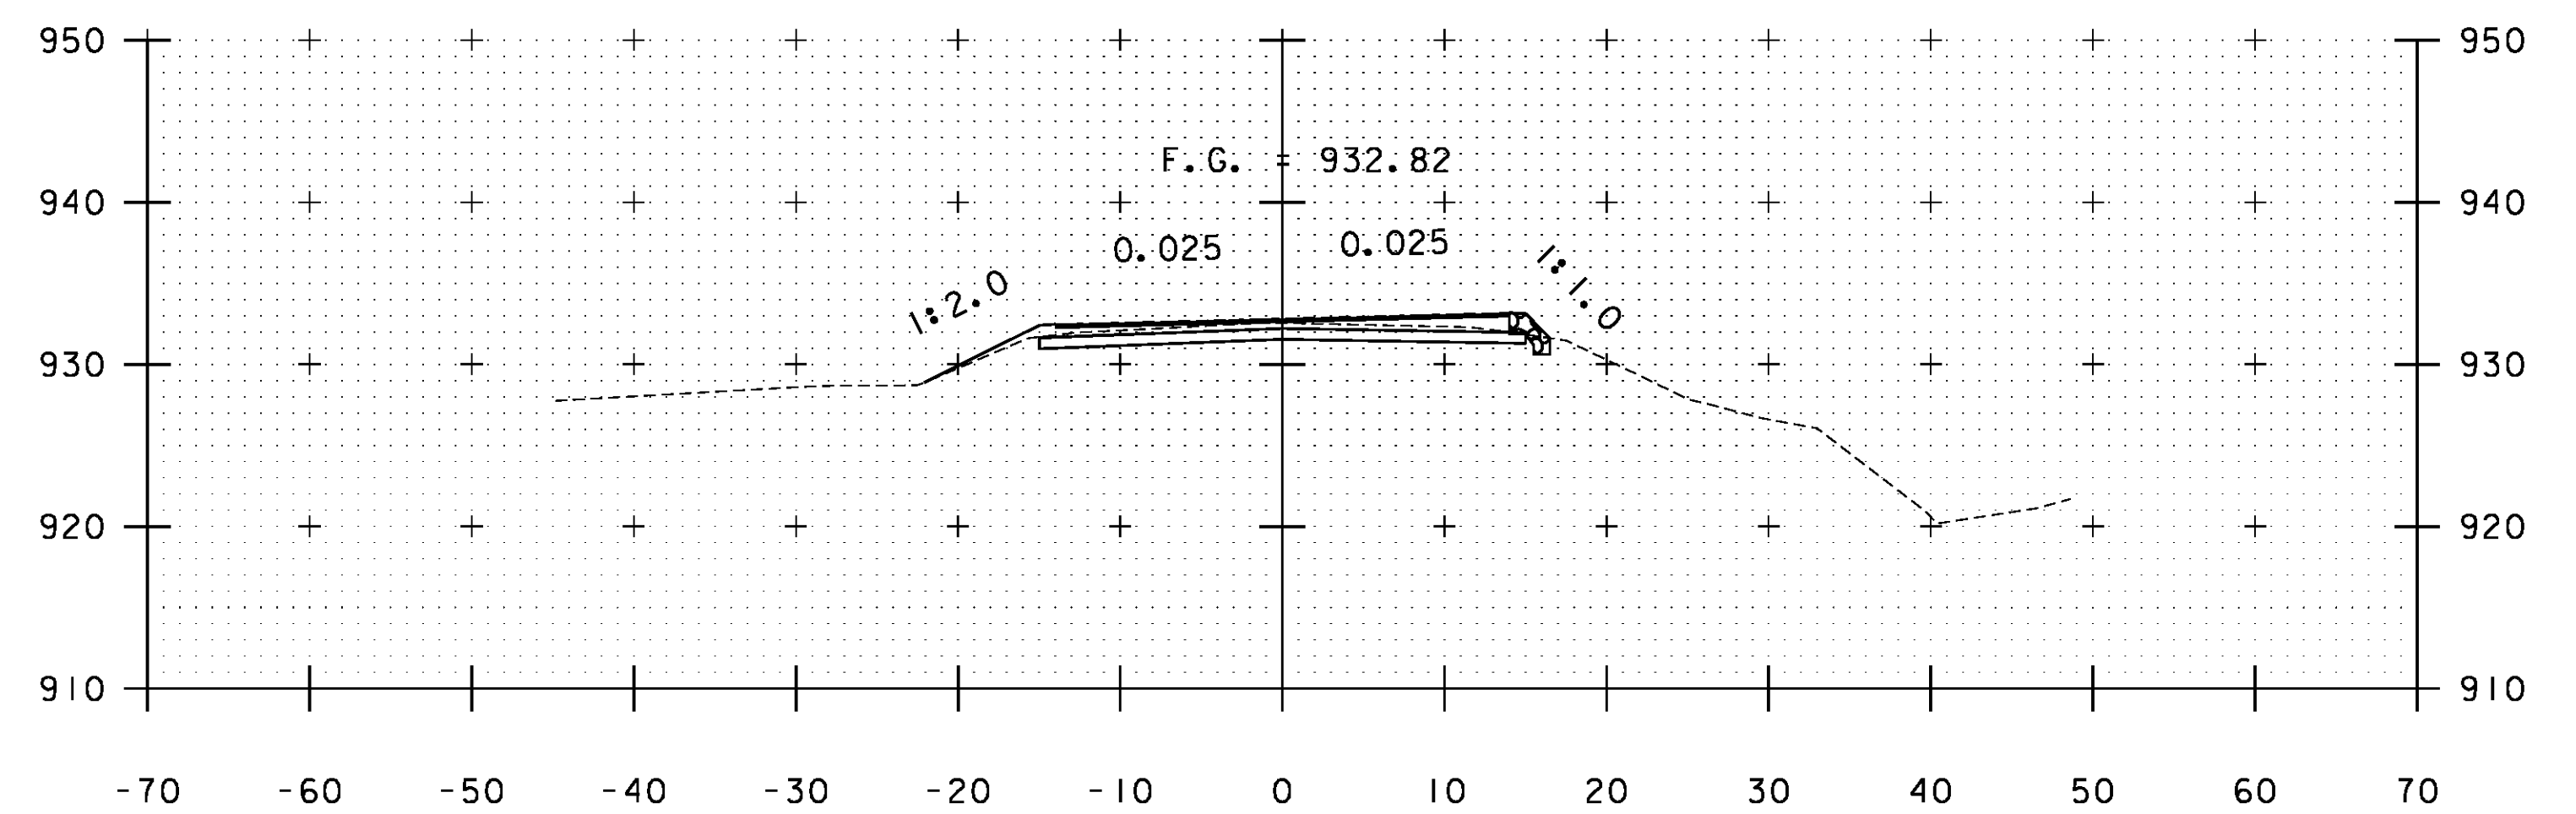

A 385+00

STA. A 383+50 TO STA. A 386+00

PROJECT NAME:	WARDSBORO-JAMAICA	PLOT DATE:	2/26/2014
PROJECT NUMBER:	ER STP 013-(17)	DRAWN BY:	B. KIPP
FILE NAME:	xs.dgn	CHECKED BY:	HSD
PROJECT LEADER:	K. UPMAL	SHEET	322 OF 444
DESIGNED BY:	B. KIPP	CROSS SECTIONS	