




B 2+00

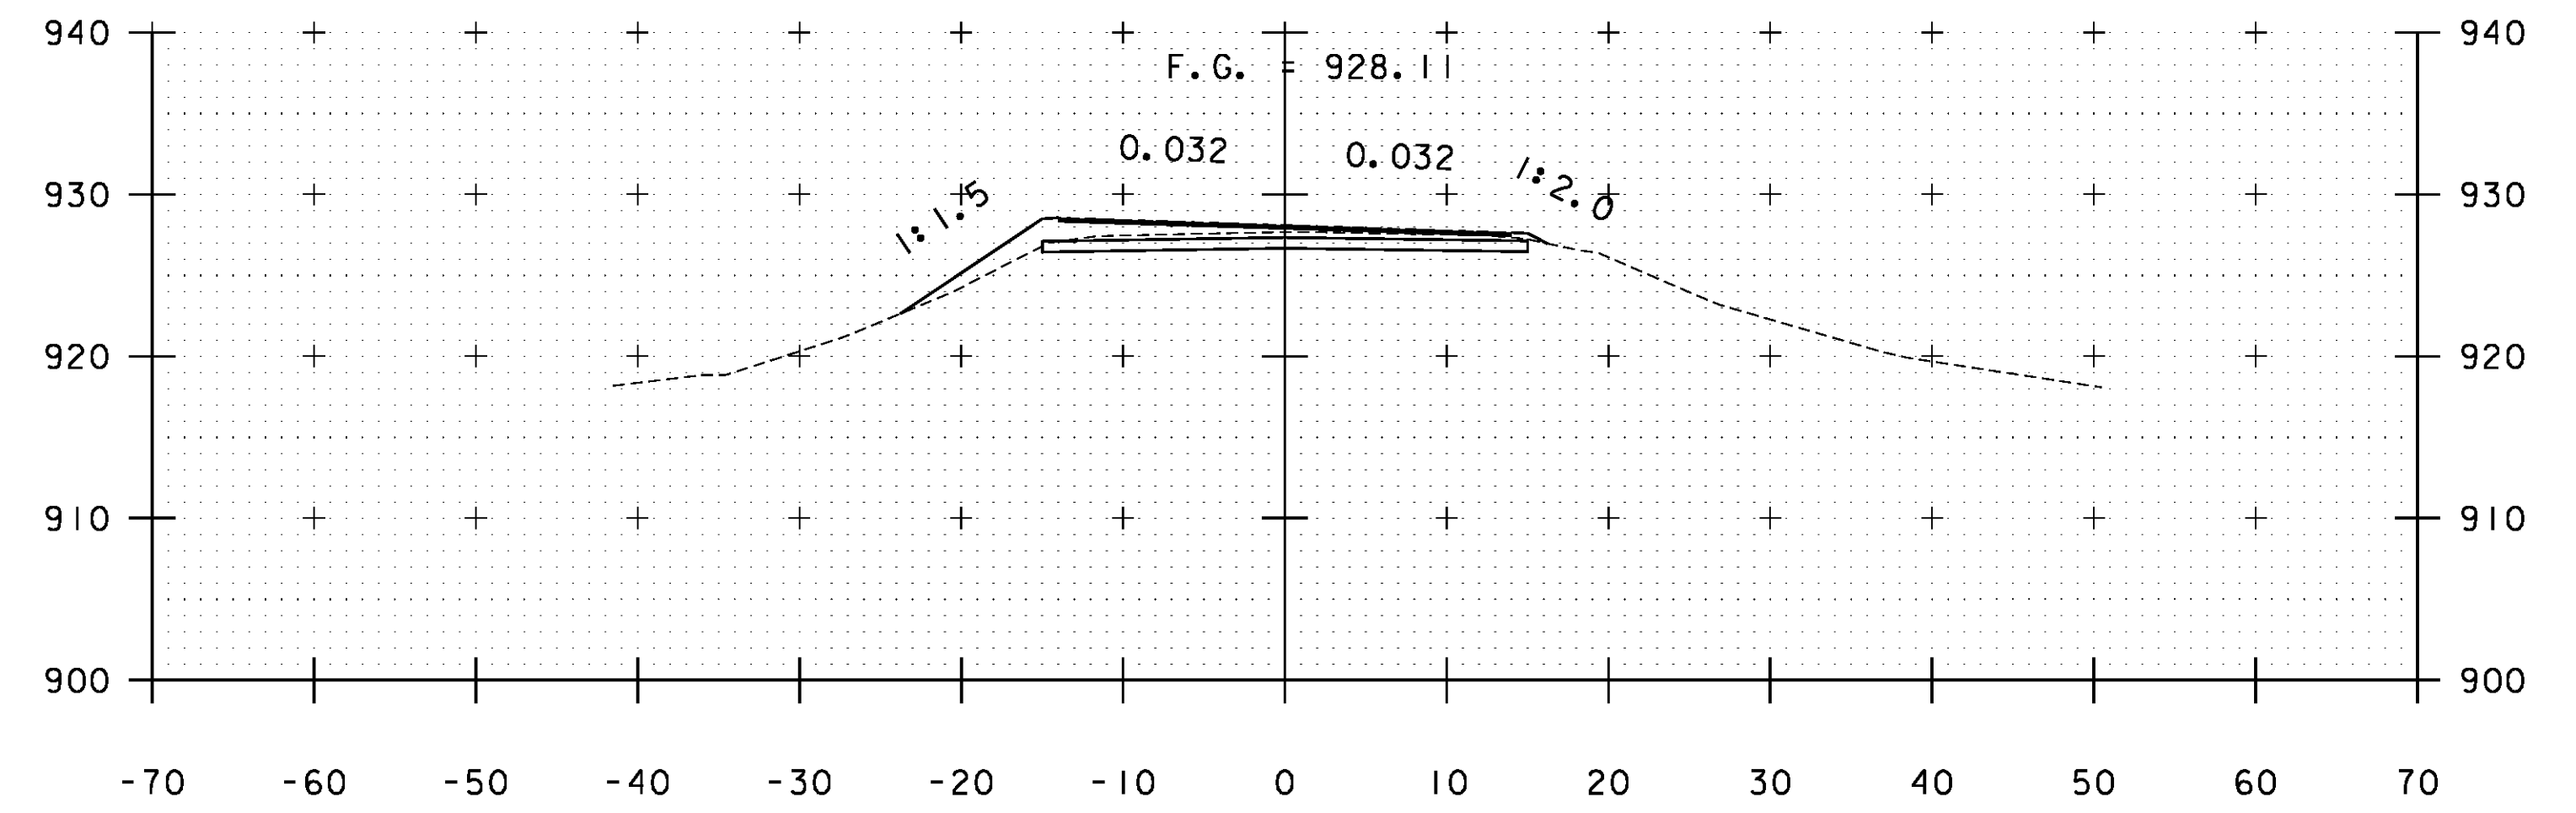


B 3+50

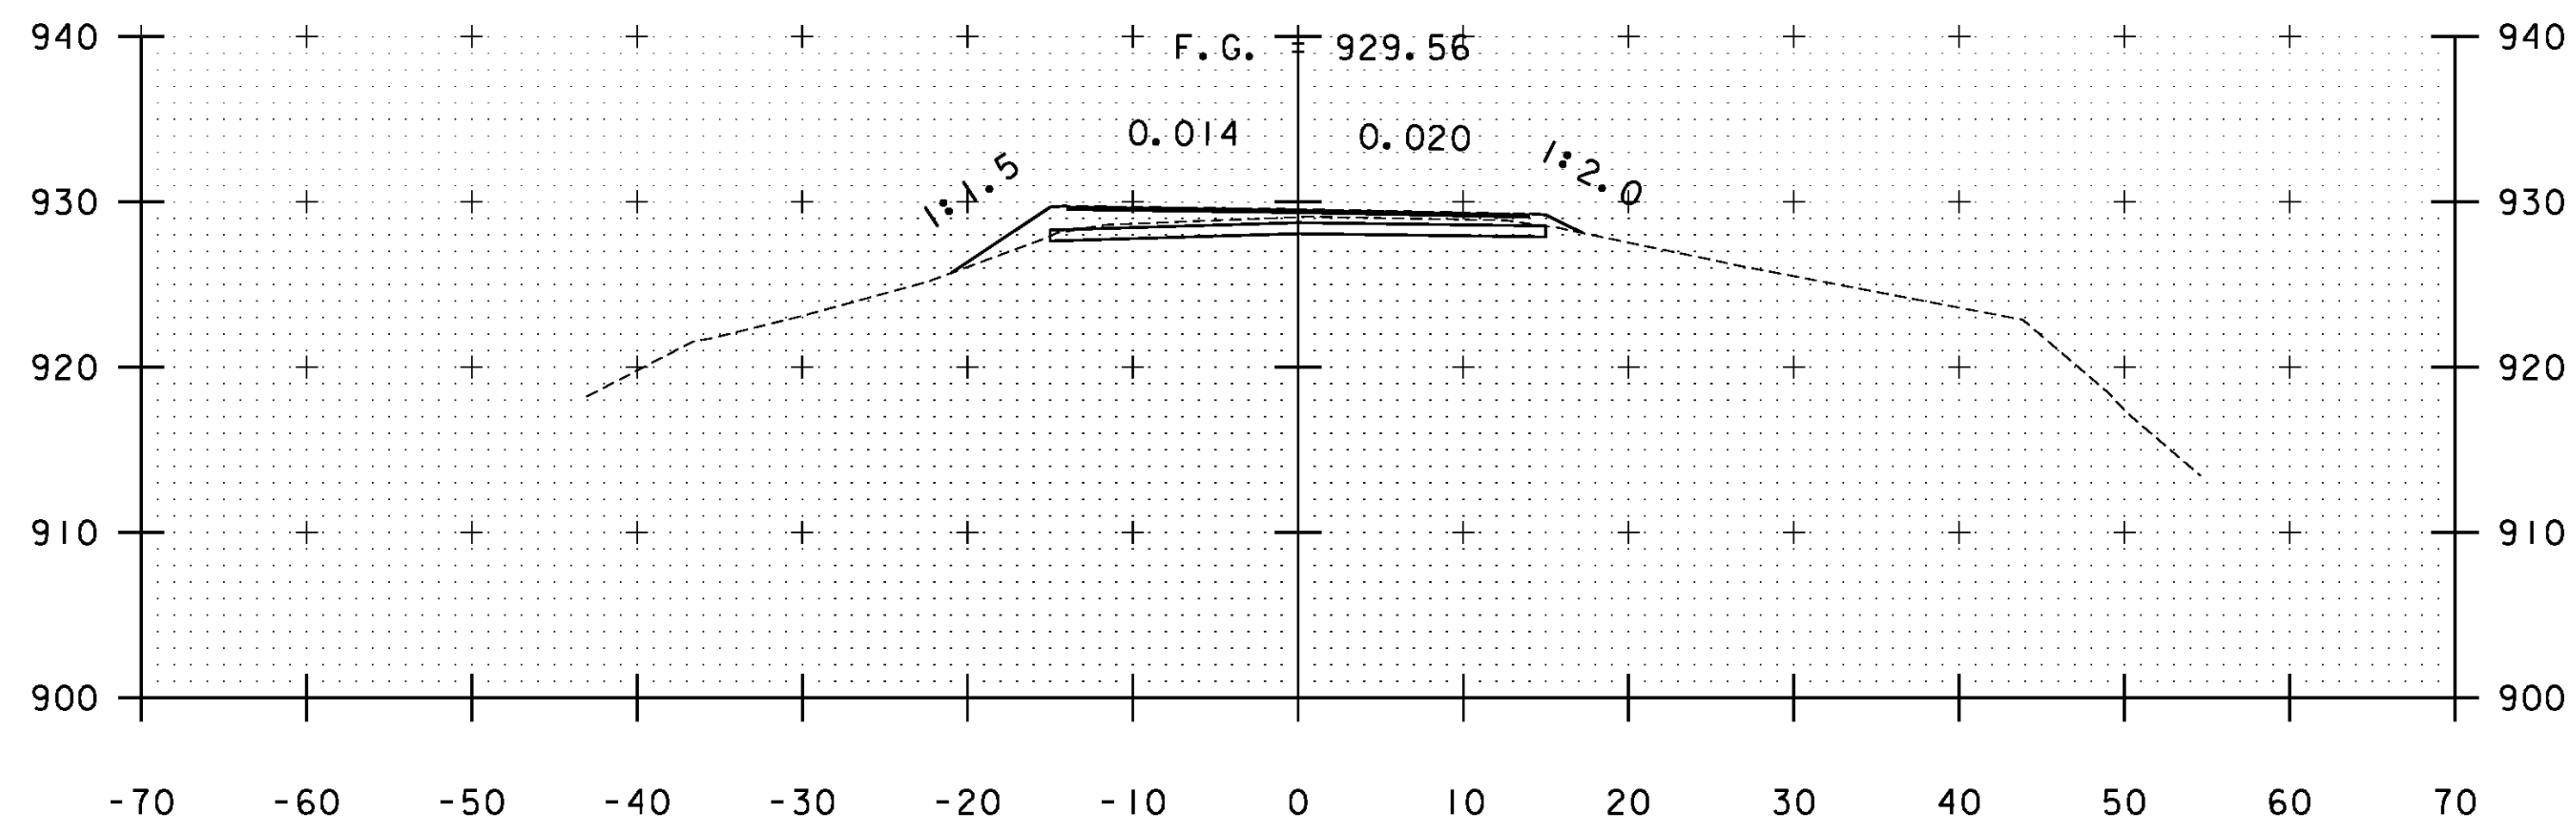


B 1+50

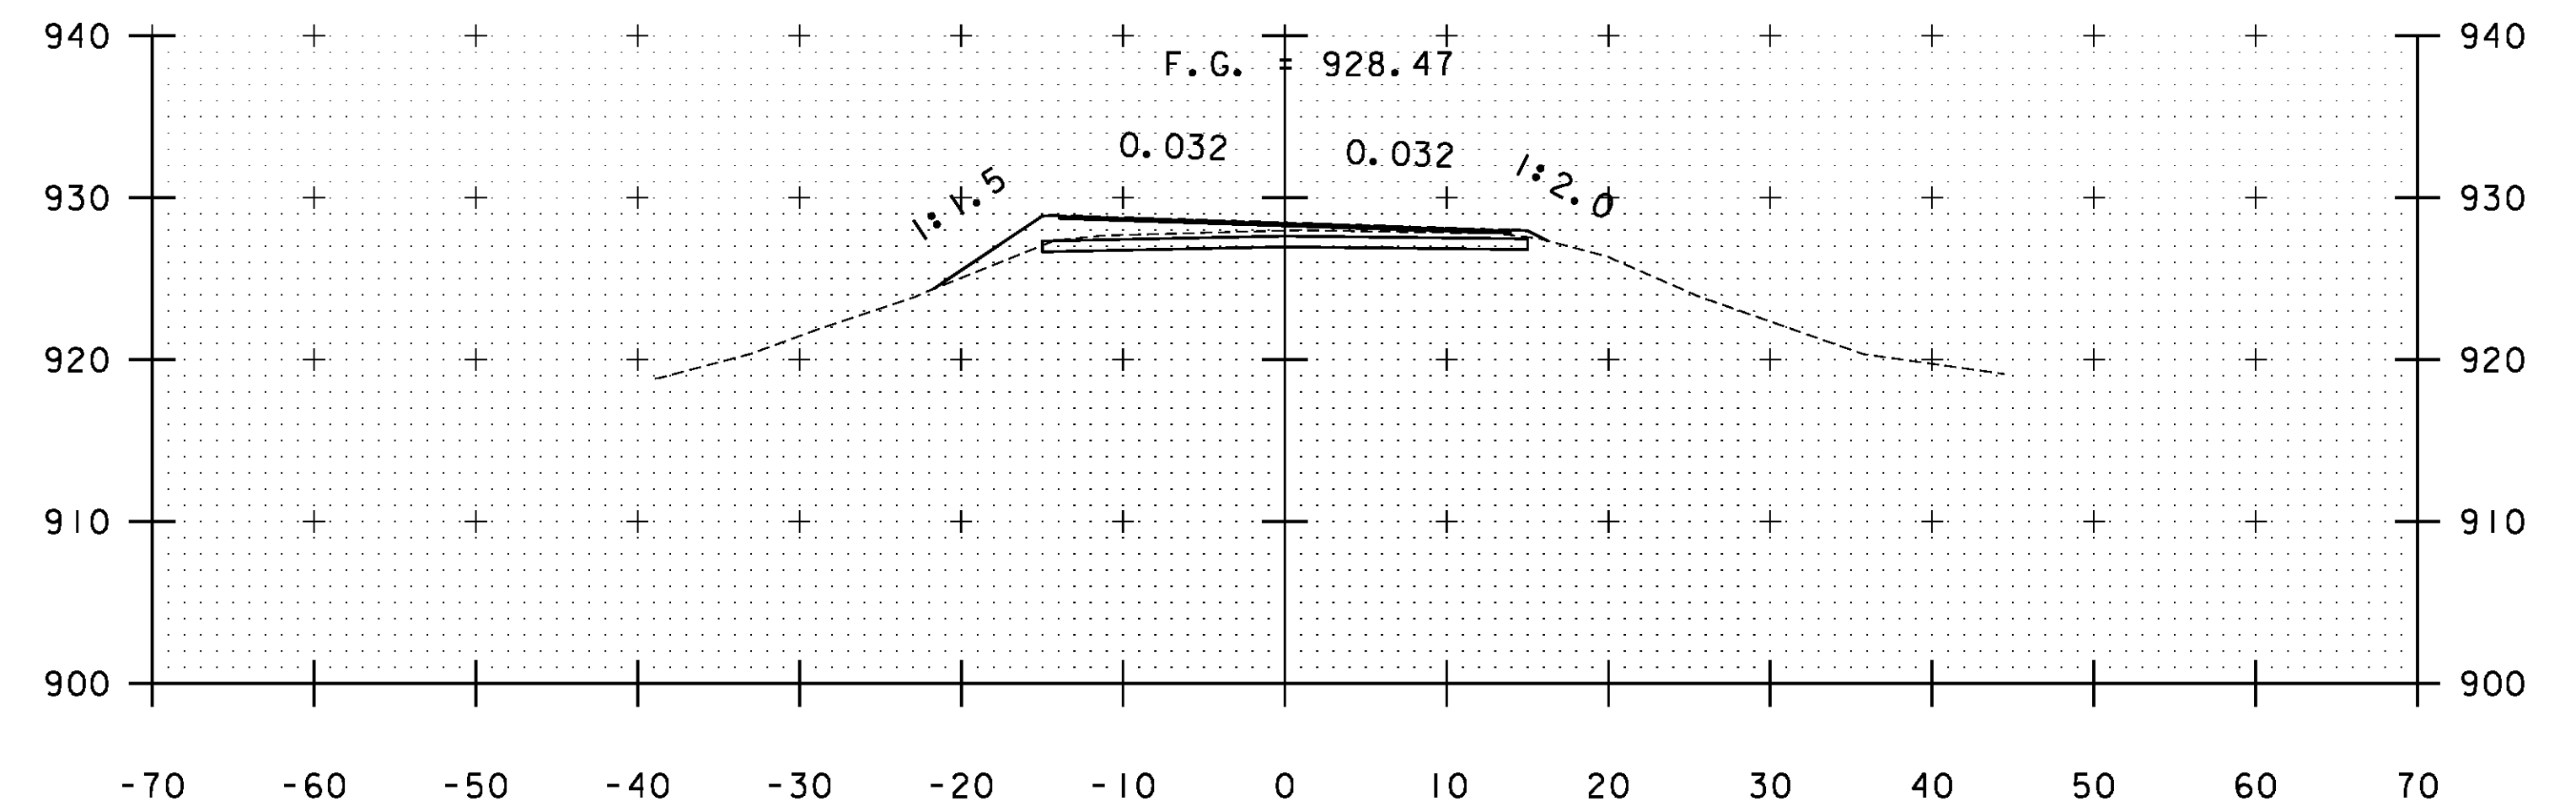

B 3+00

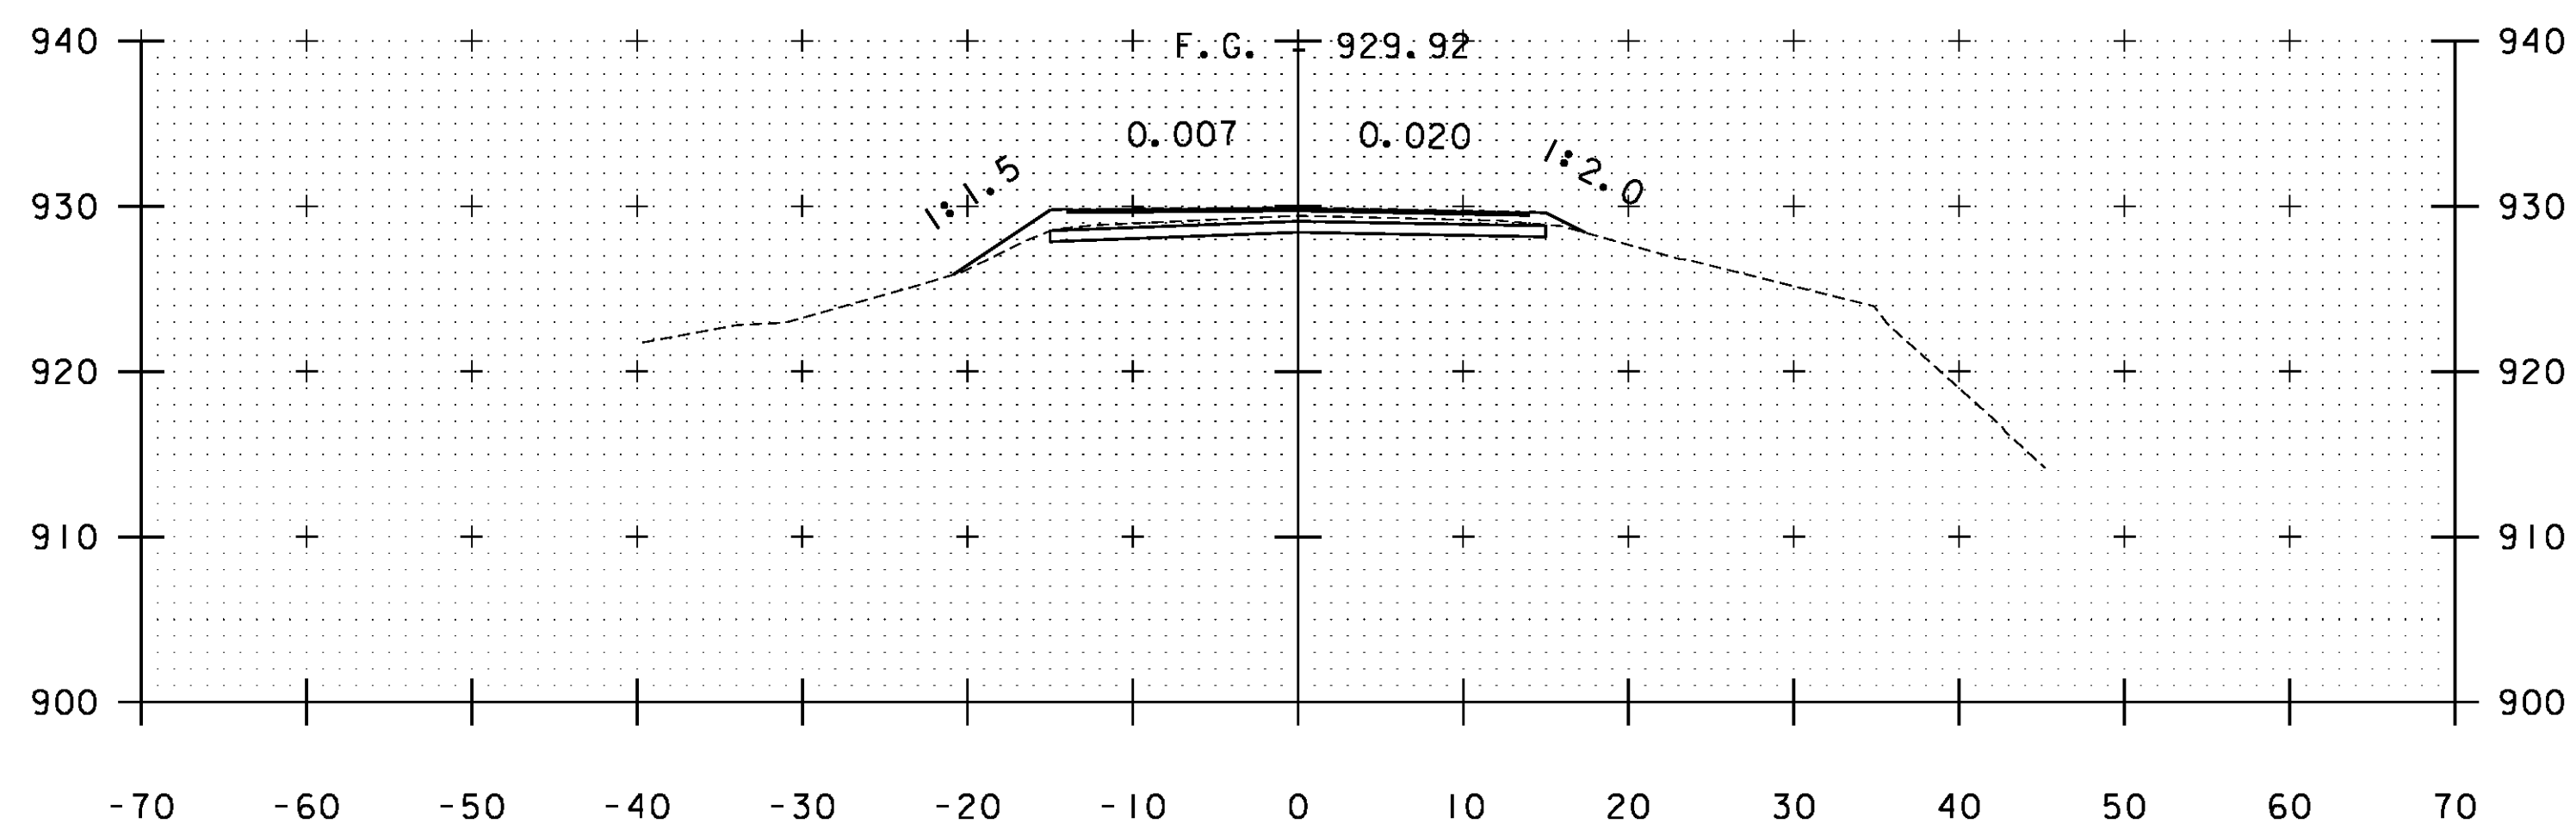

B 1+00

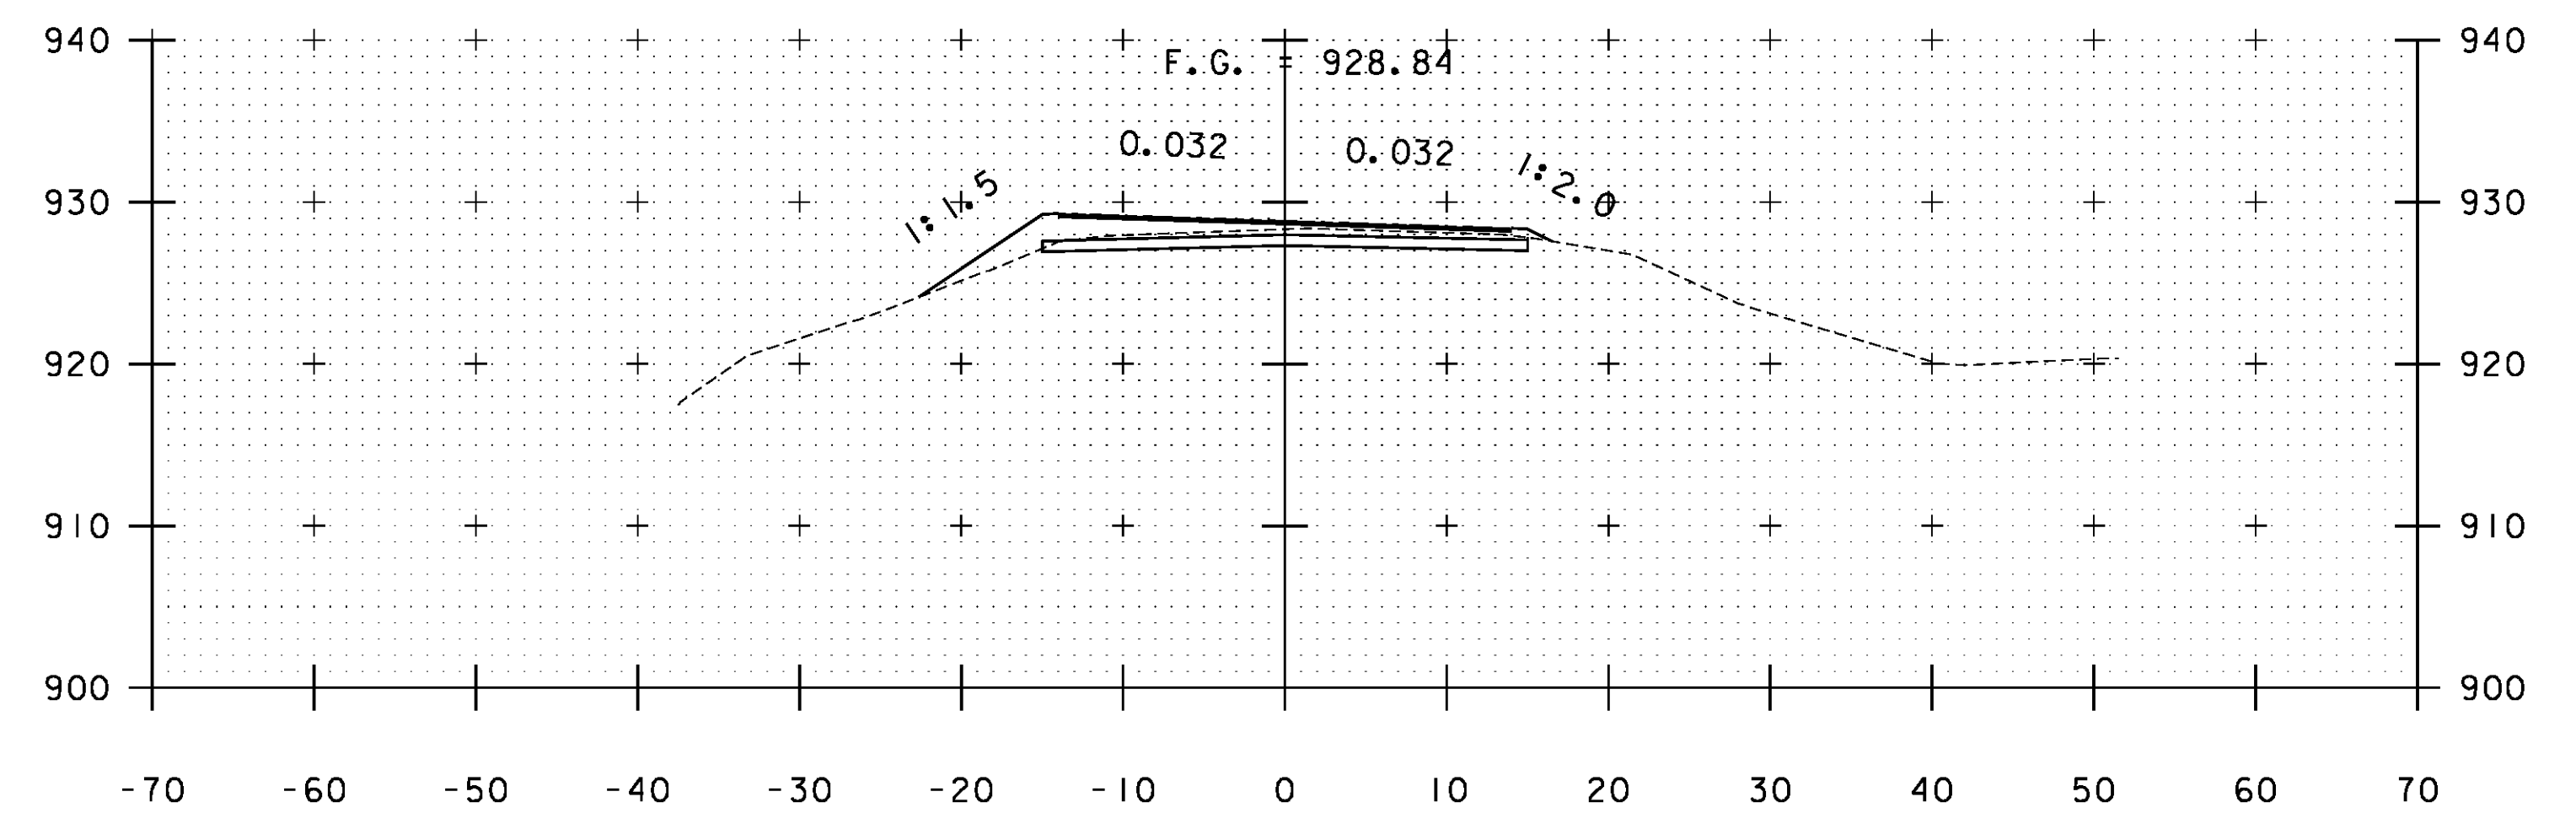

B 2+50

STA. B 1+00 TO STA. B 3+50

PROJECT NAME:	WARDSBORO-JAMAICA	PLOT DATE:	2/26/2014
PROJECT NUMBER:	ER STP 013-1(17)	DRAWN BY:	B. KIPP
FILE NAME:	xs.dgn	CHECKED BY:	HSD
PROJECT LEADER:	K. UPMAL	SHEET	324 OF 444
DESIGNED BY:	B. KIPP	CROSS SECTIONS	