




B 9+00

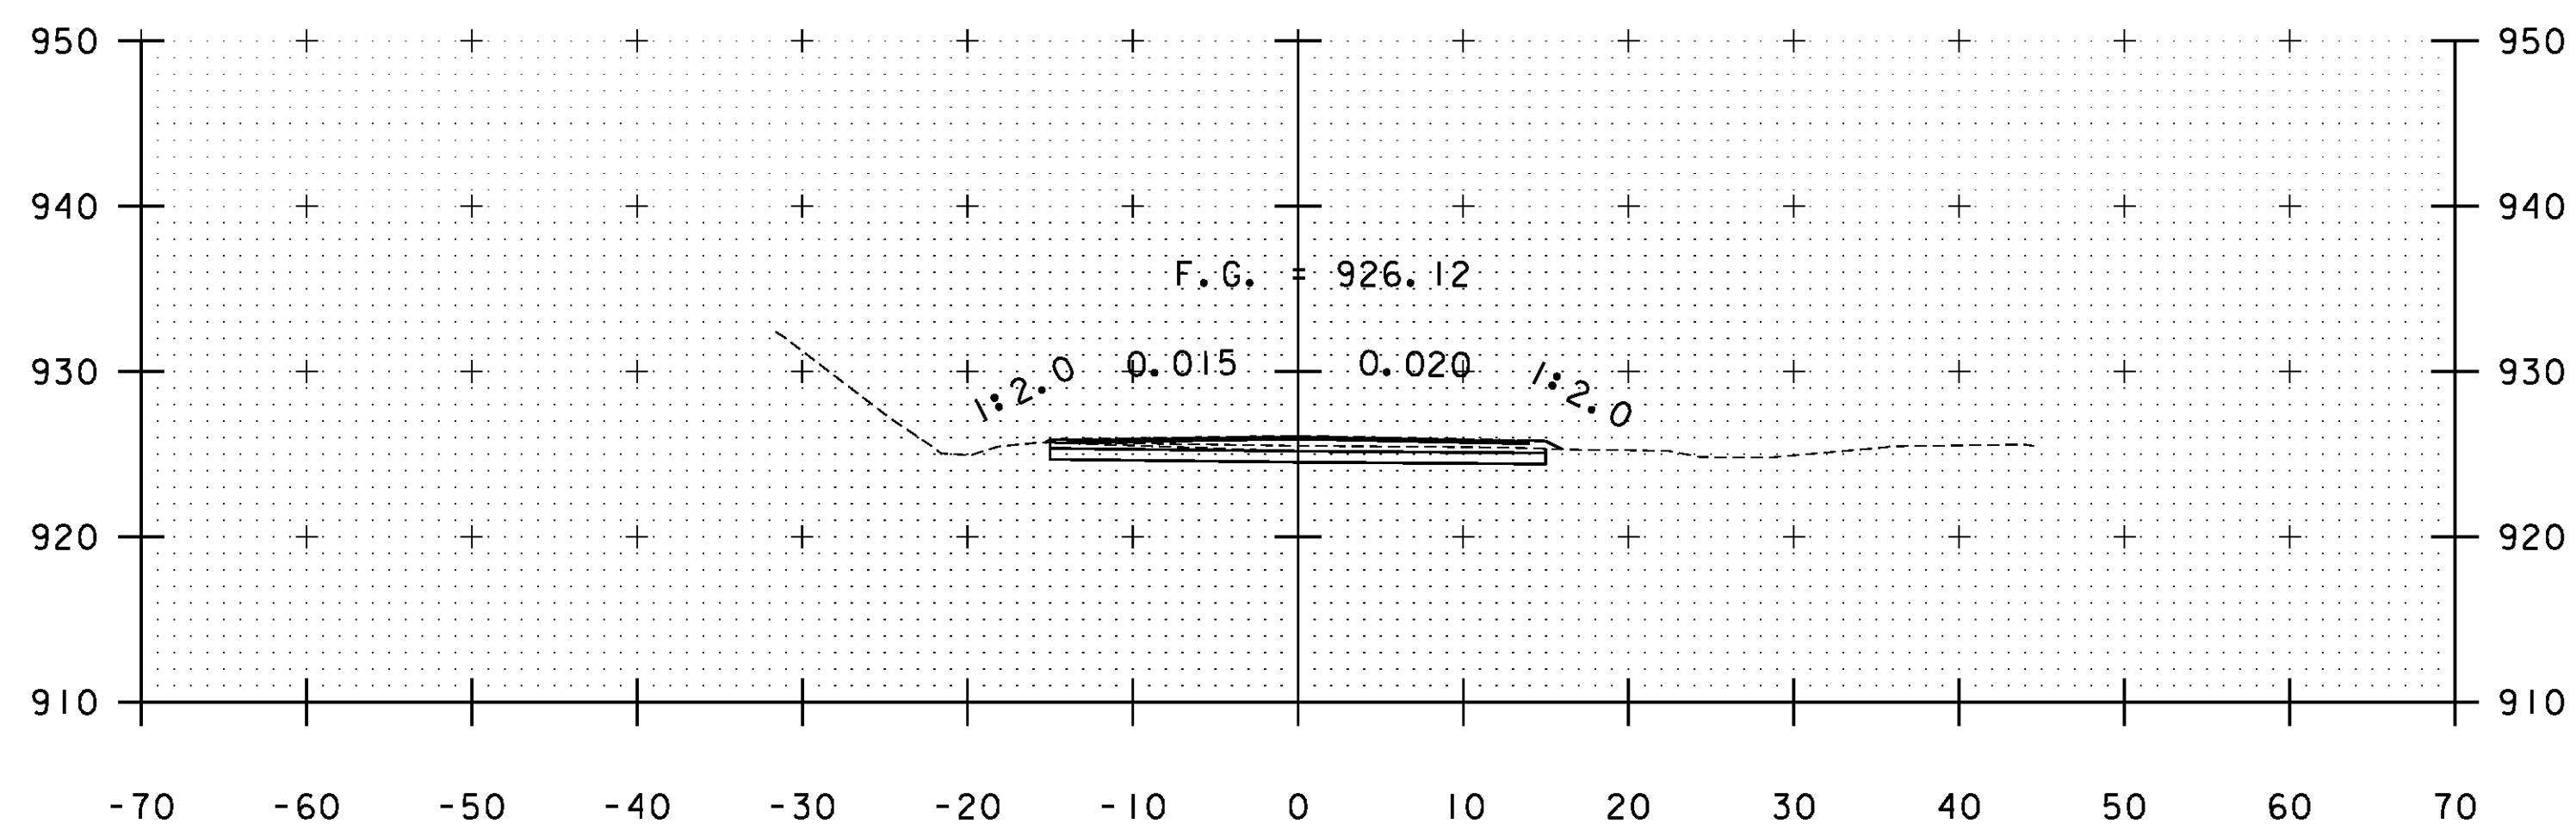


B 8+50

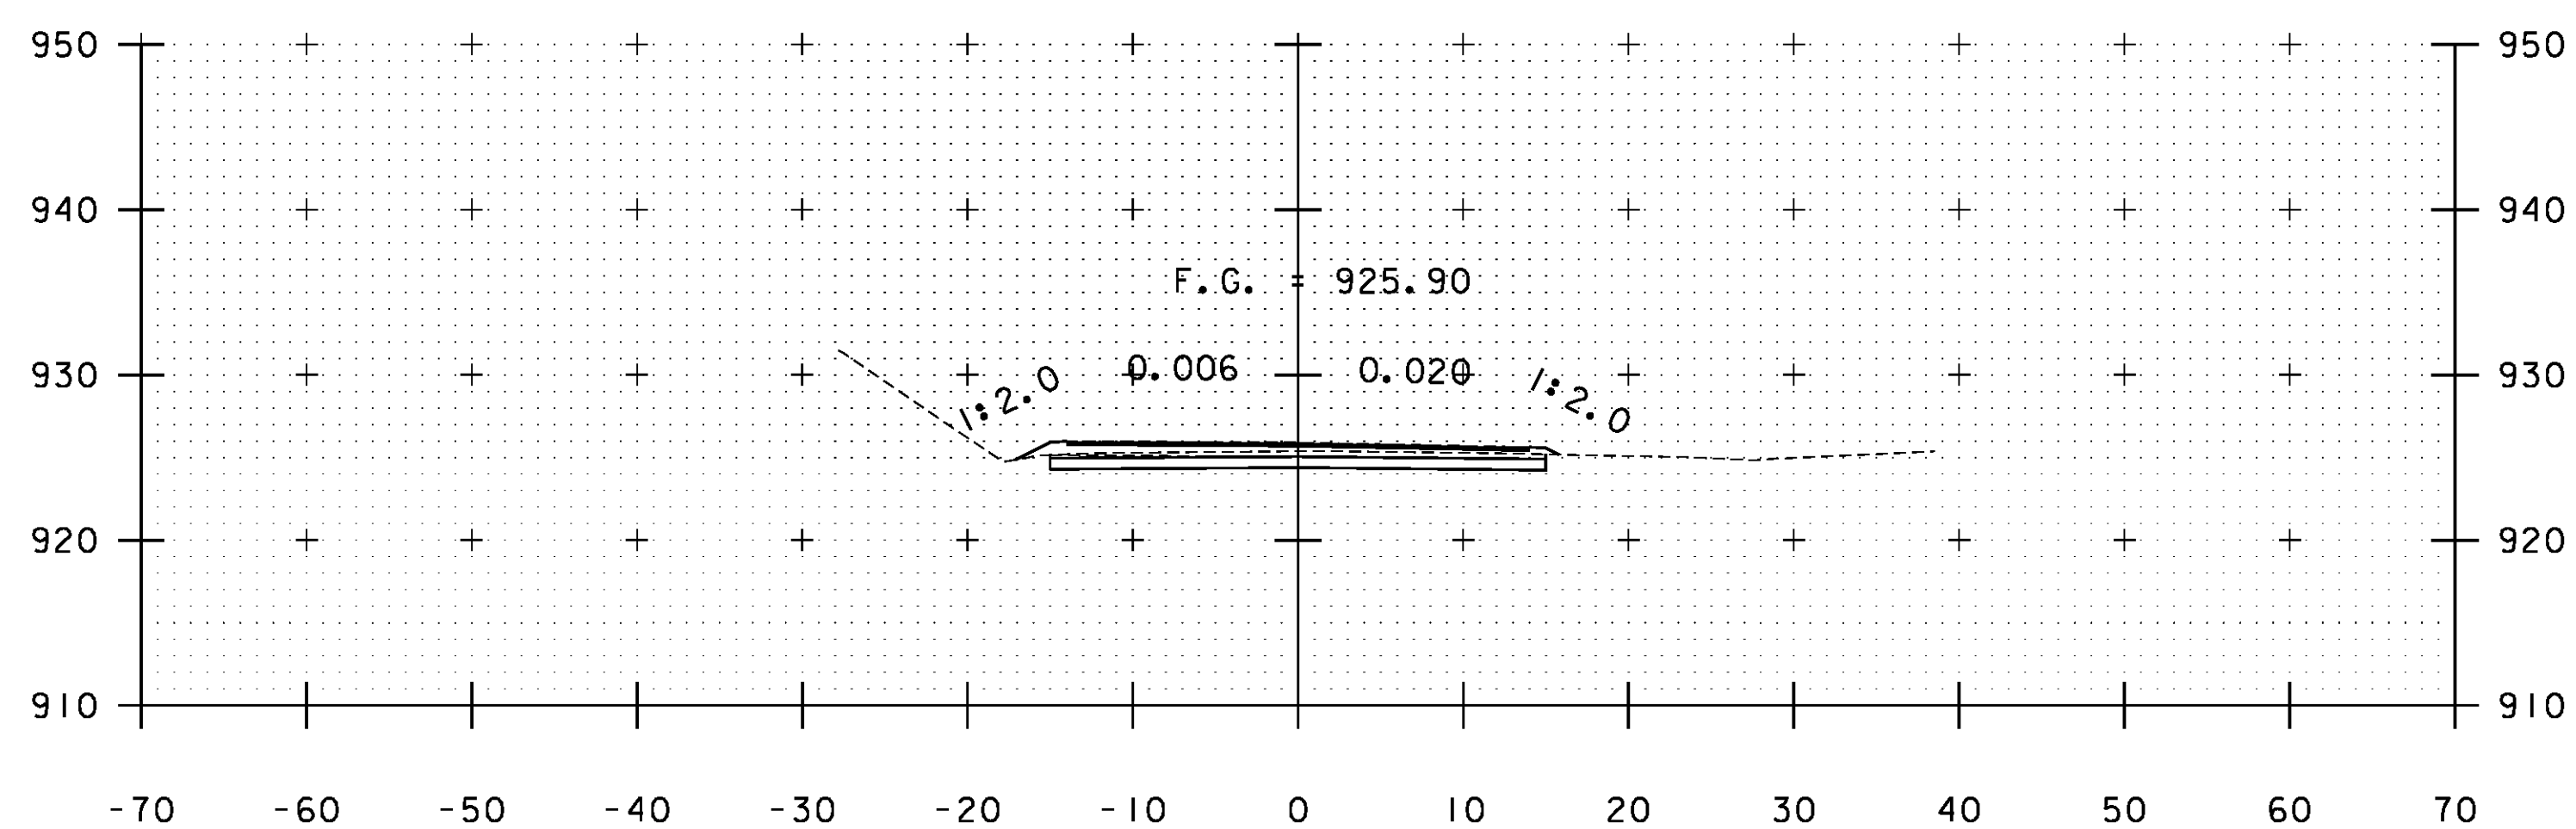


B 8+00

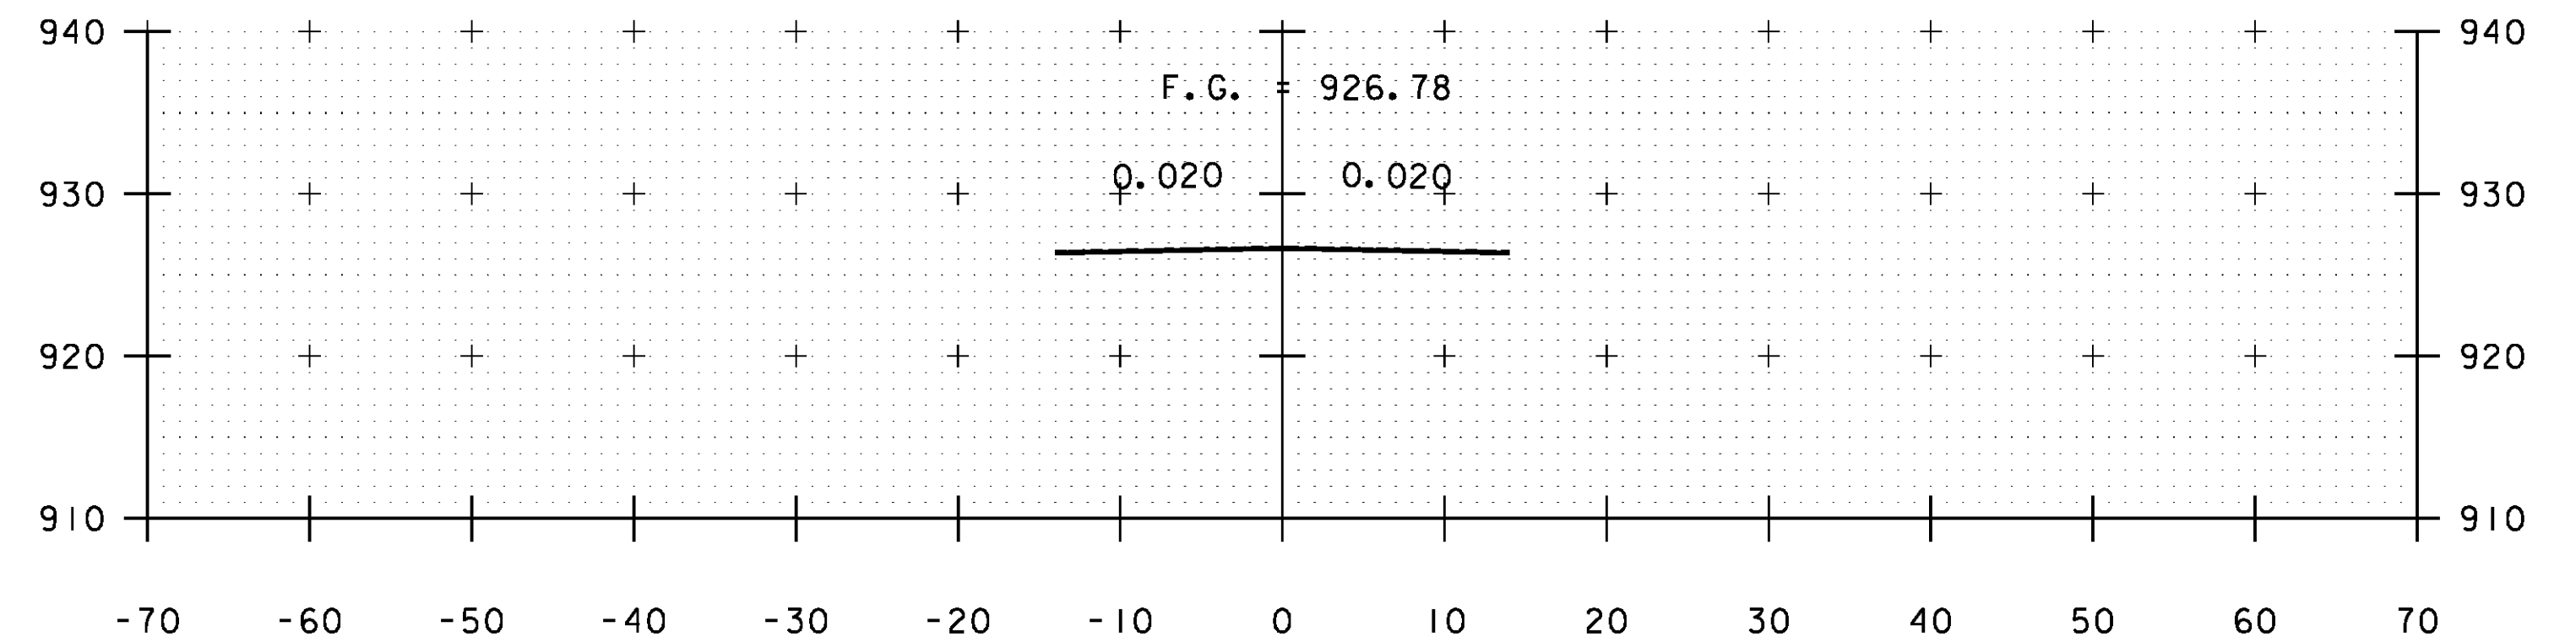

B 10+00

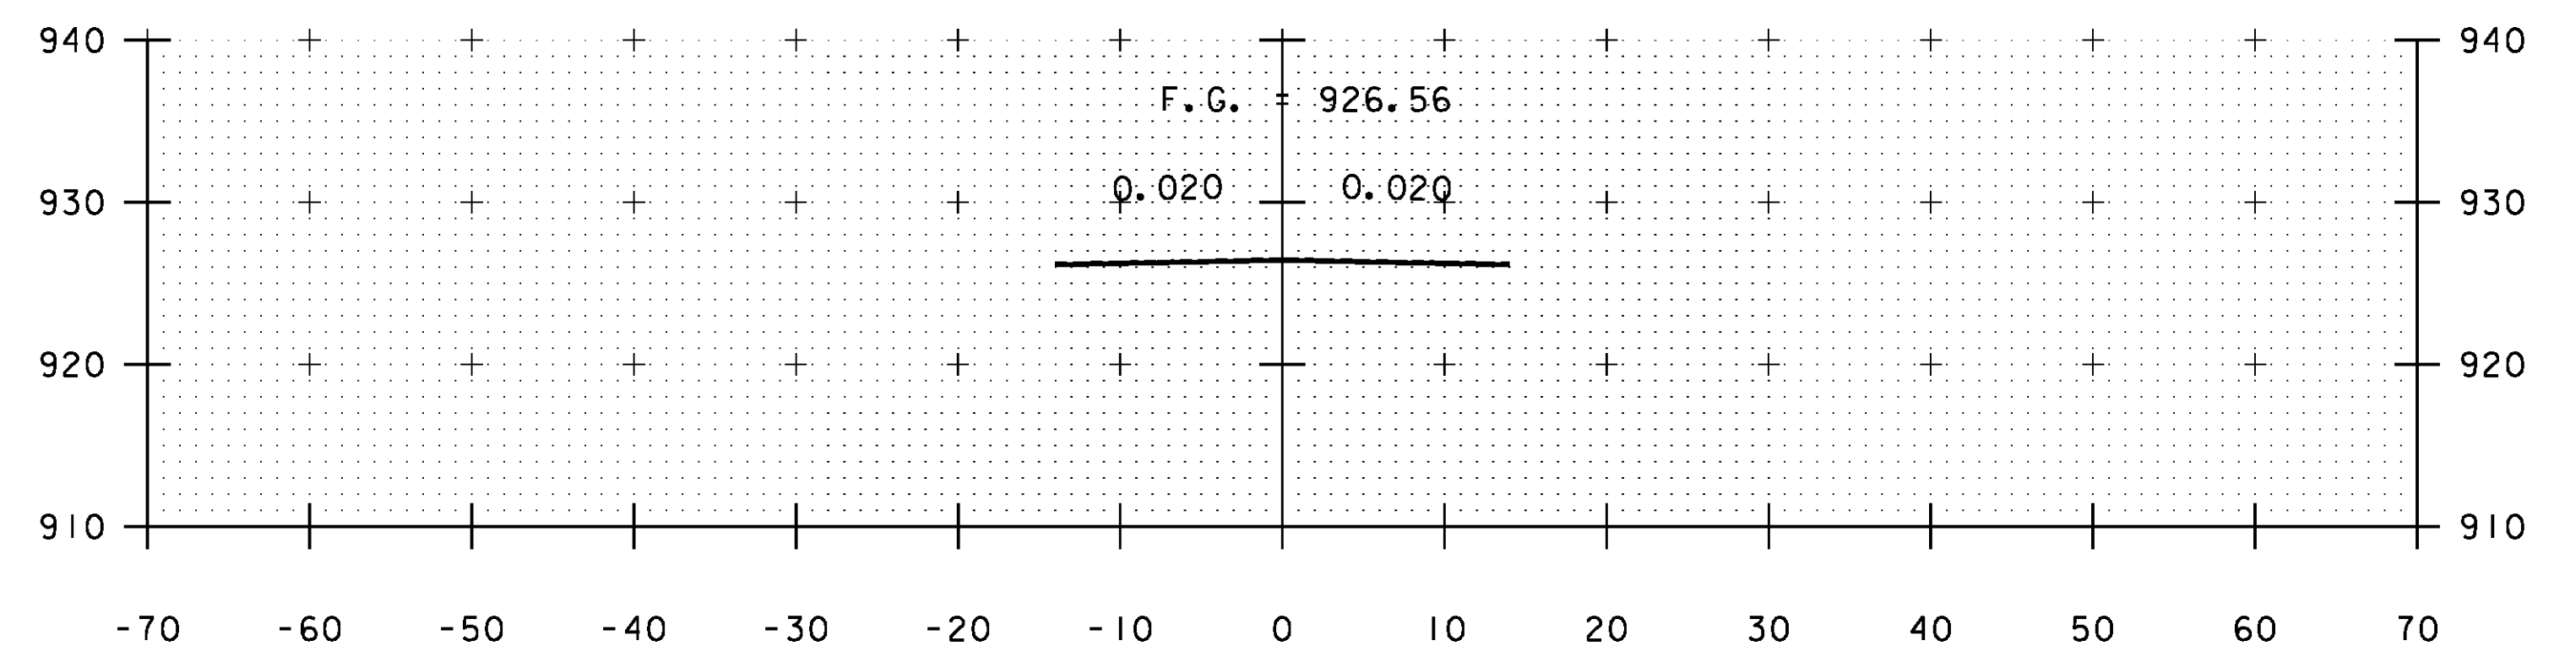

B 9+50

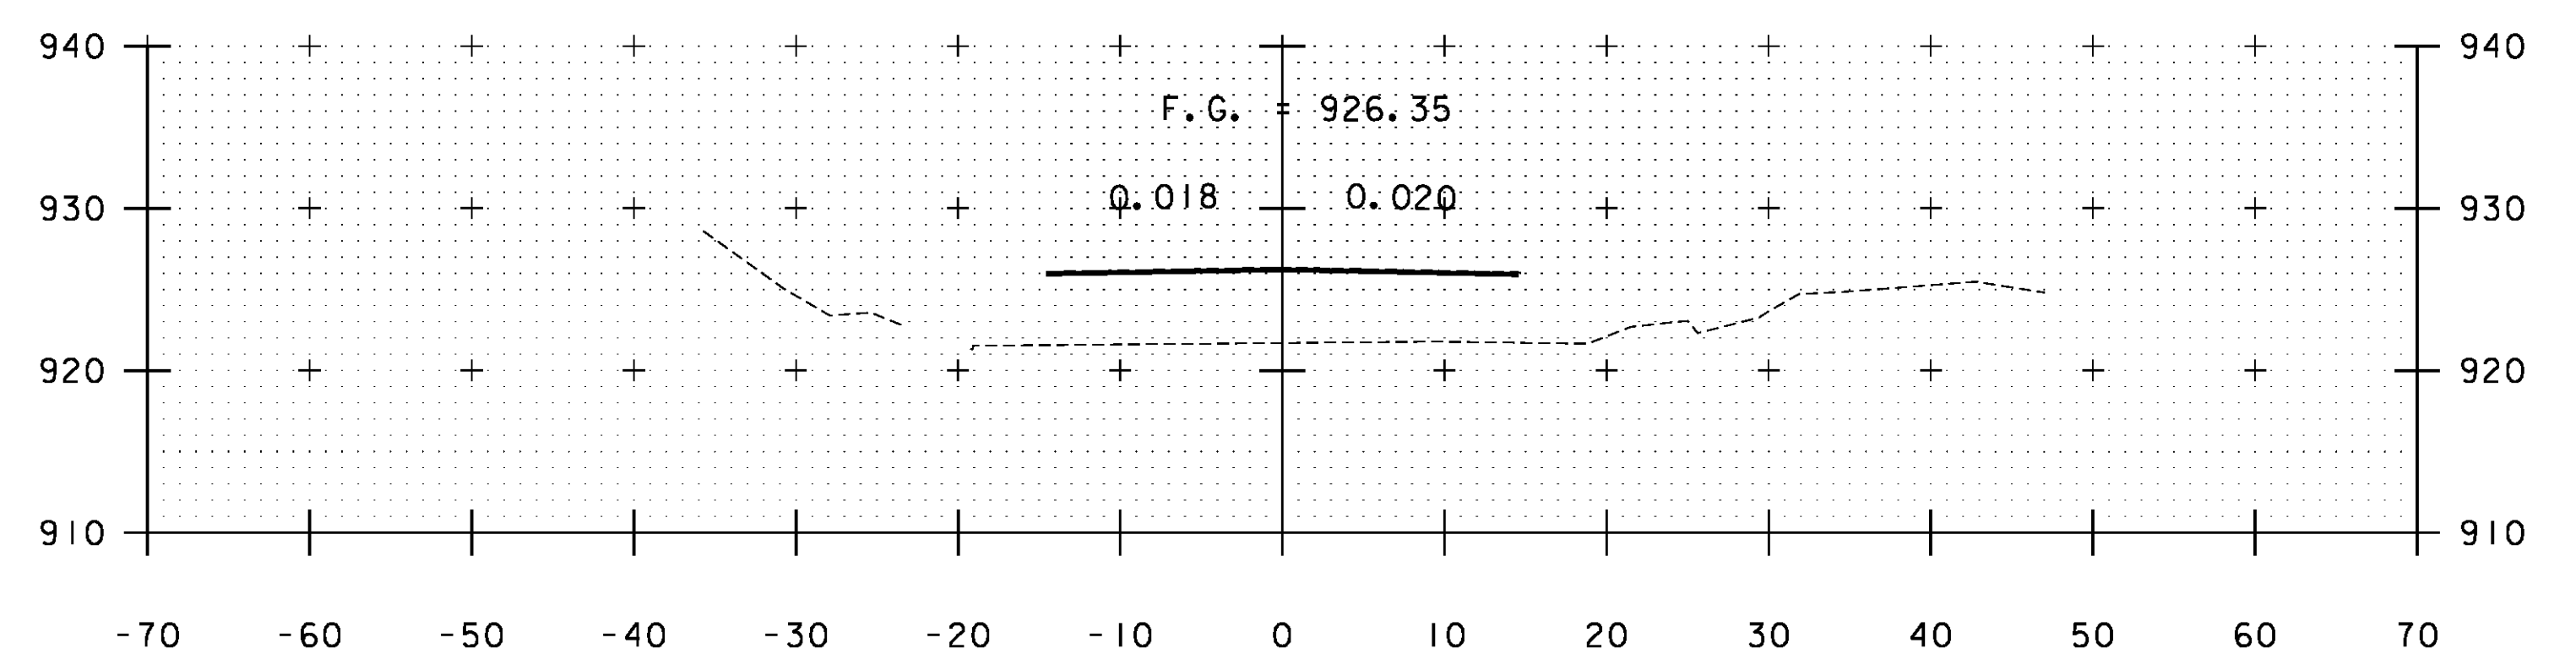

B 9+02

STA. B 8+00 TO STA. B 10+00

PROJECT NAME: WARDBORO-JAMAICA	PLOT DATE: 2/26/2014
PROJECT NUMBER: ER STP 013-1(17)	DRAWN BY: B. KIPP
FILE NAME: xs.dgn	CHECKED BY: HSD
PROJECT LEADER: K. UPMAL	SHEET 327 OF 444
DESIGNED BY: B. KIPP	CROSS SECTIONS