




B 11+04

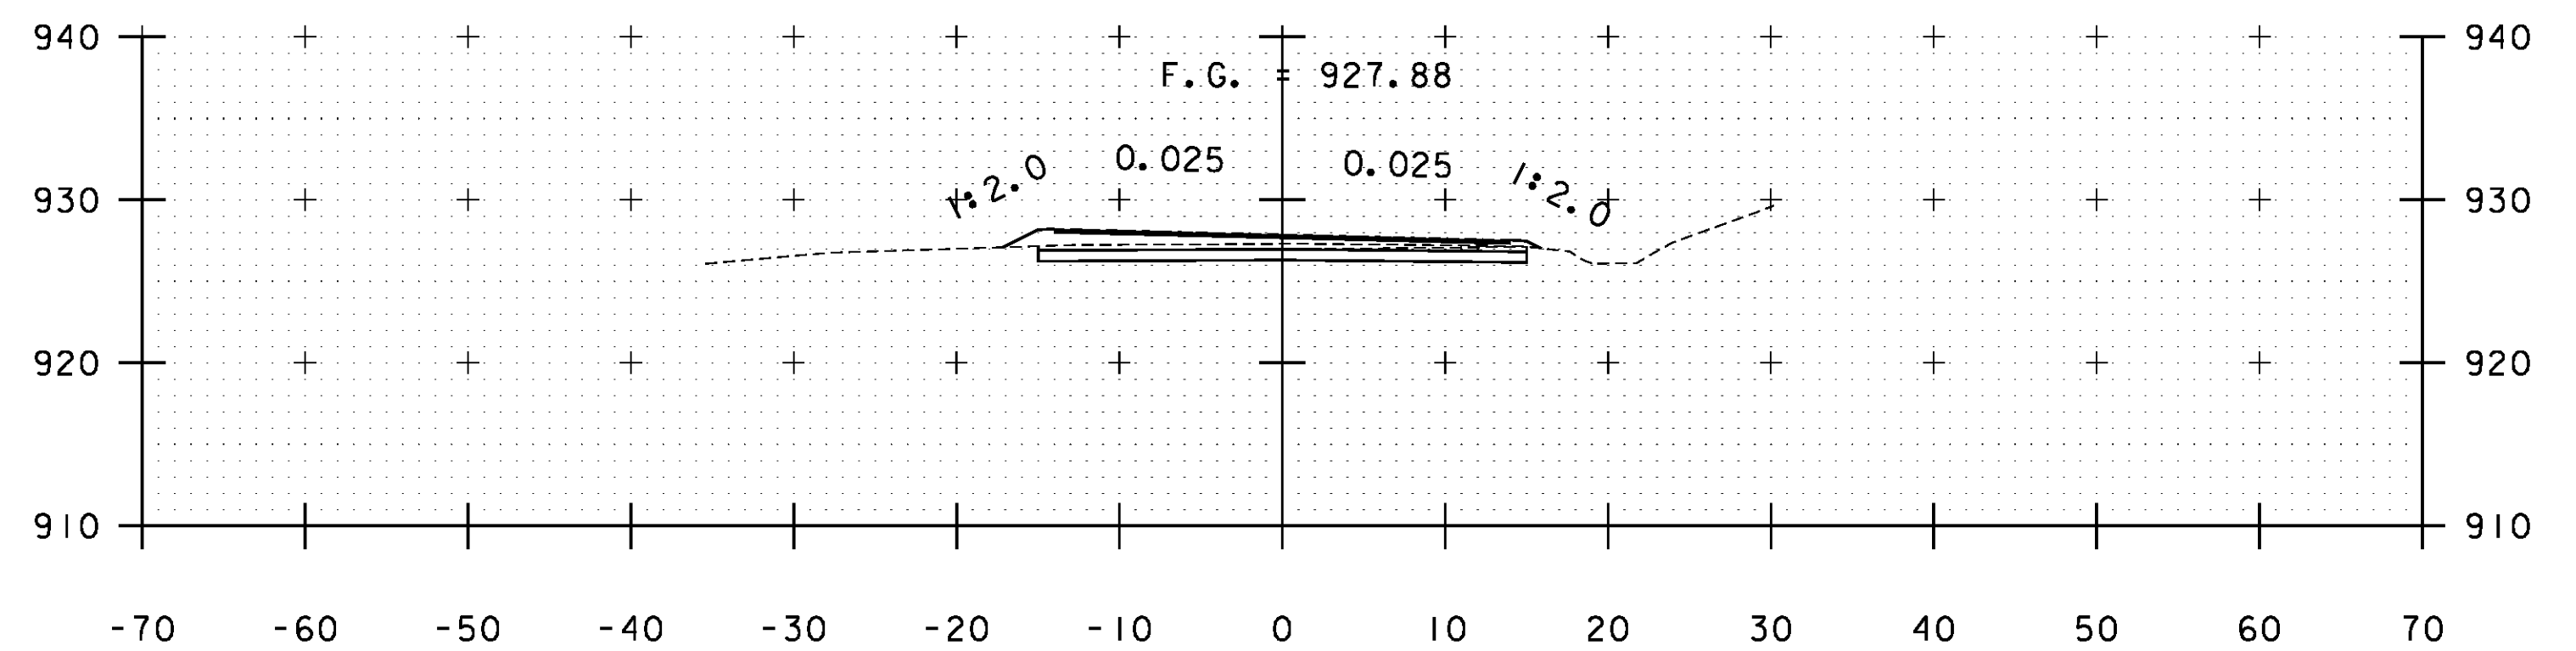


B 12+50

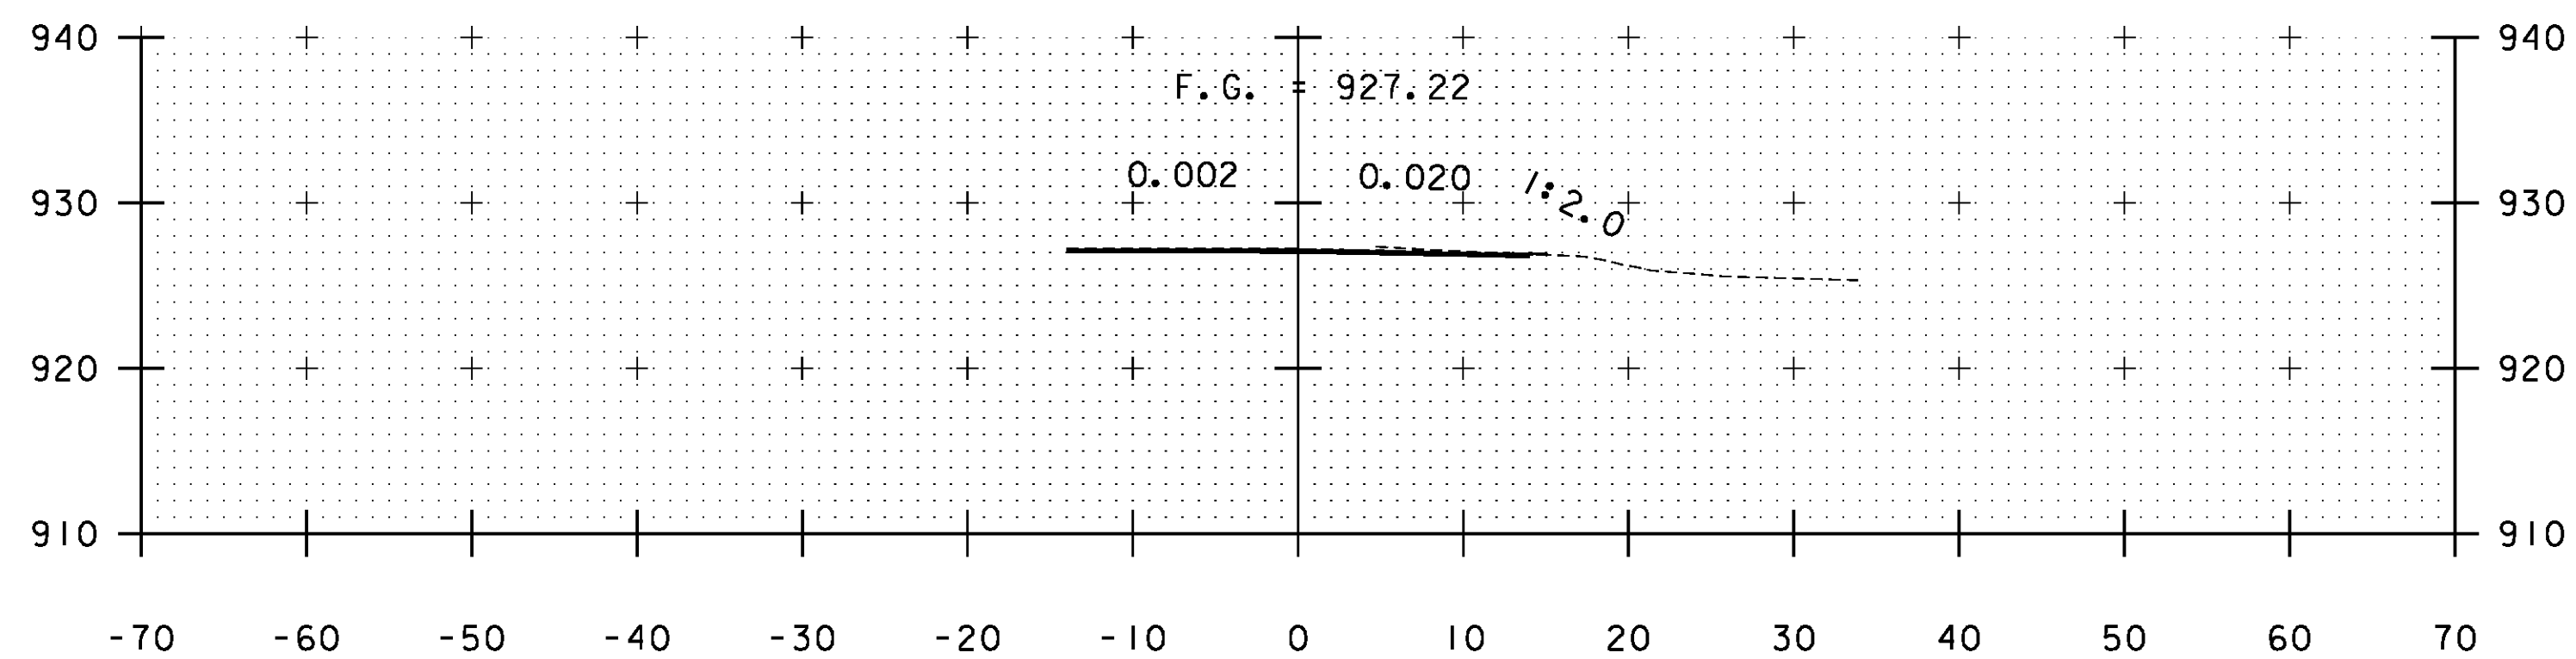


B 11+00

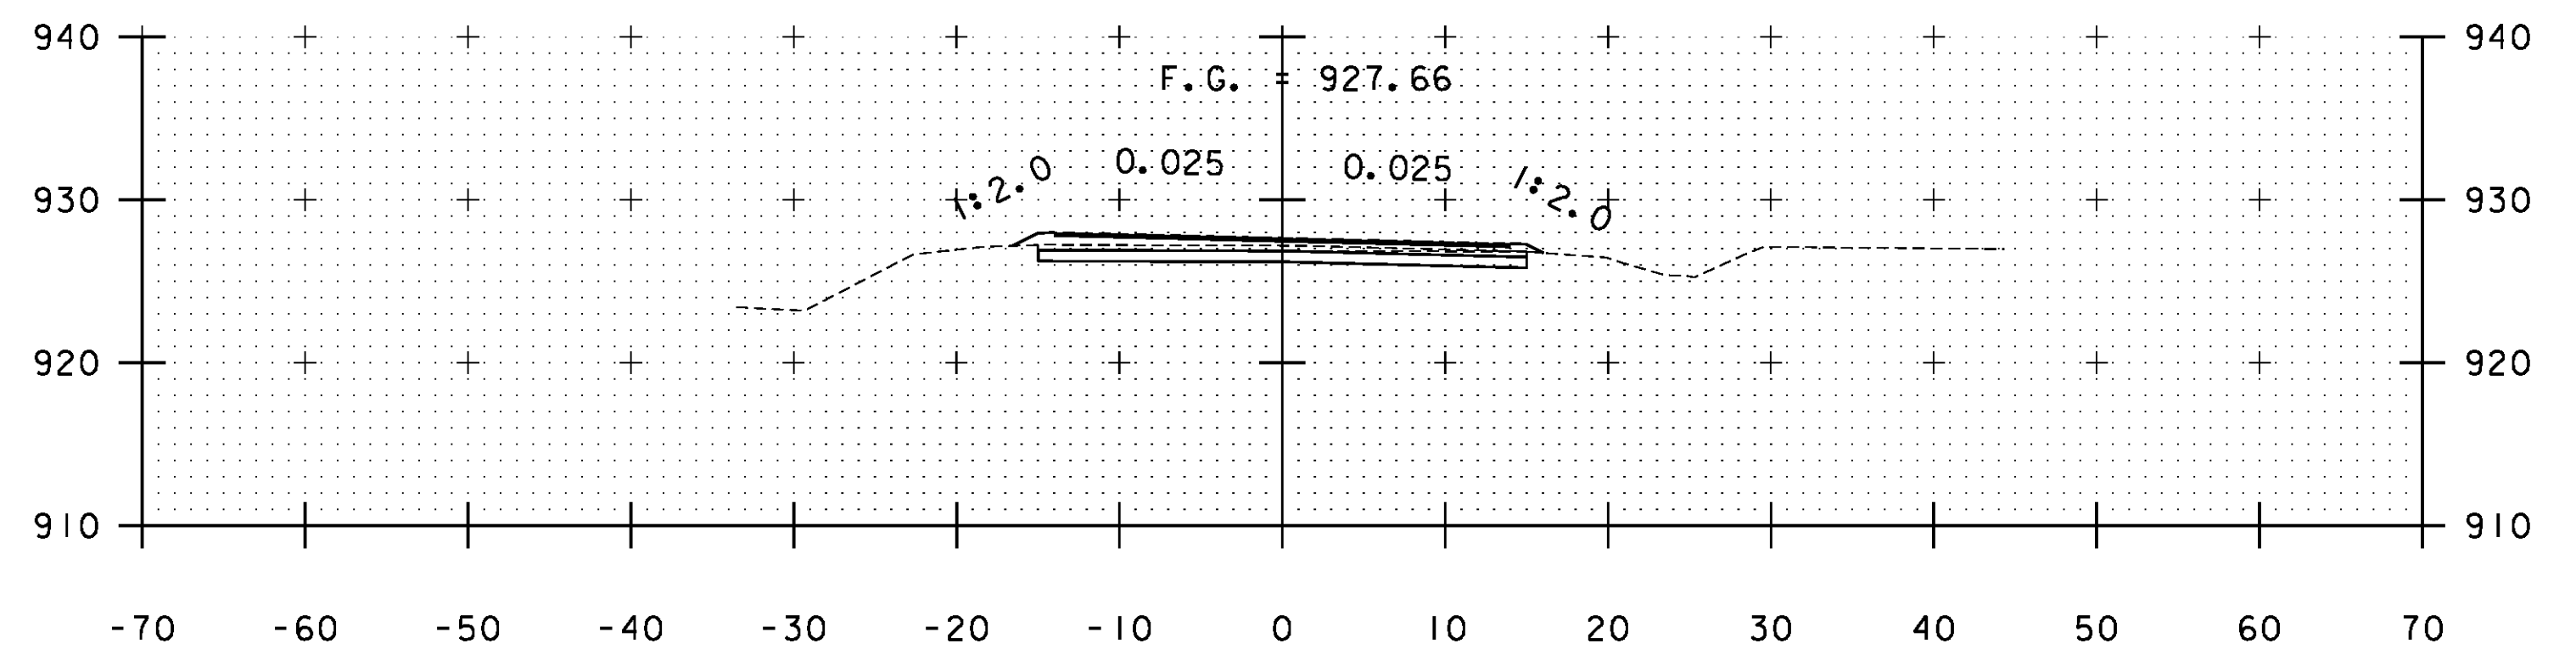

B 12+00

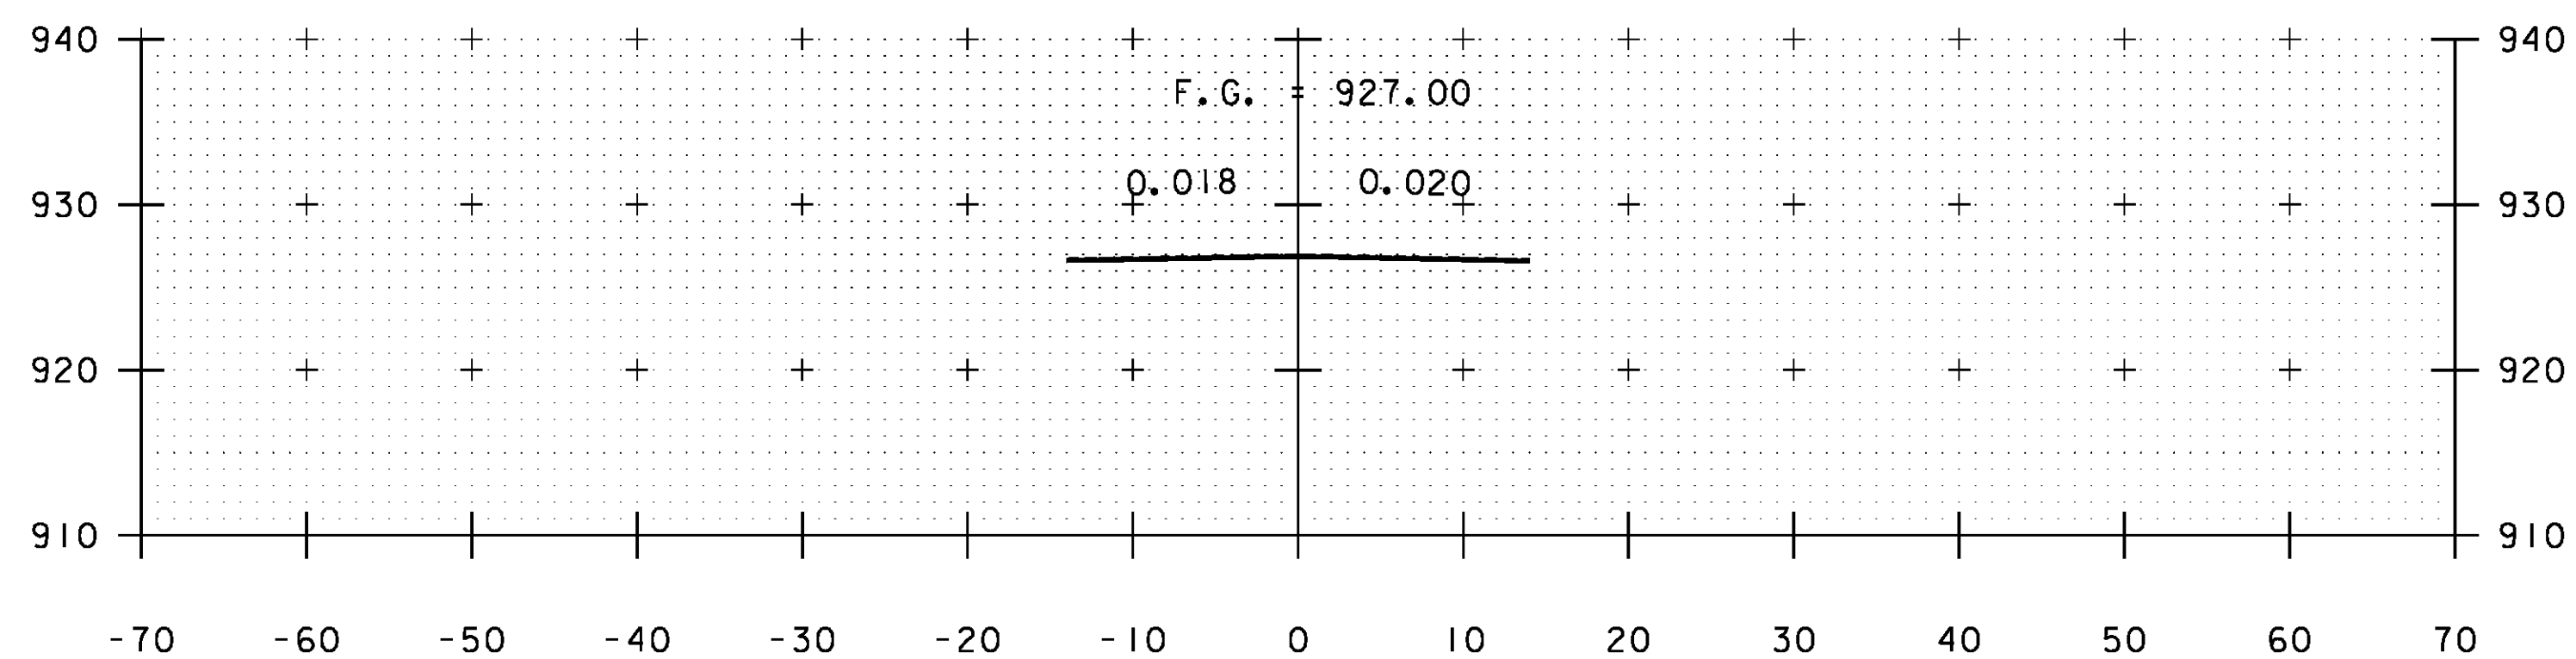

B 10+50

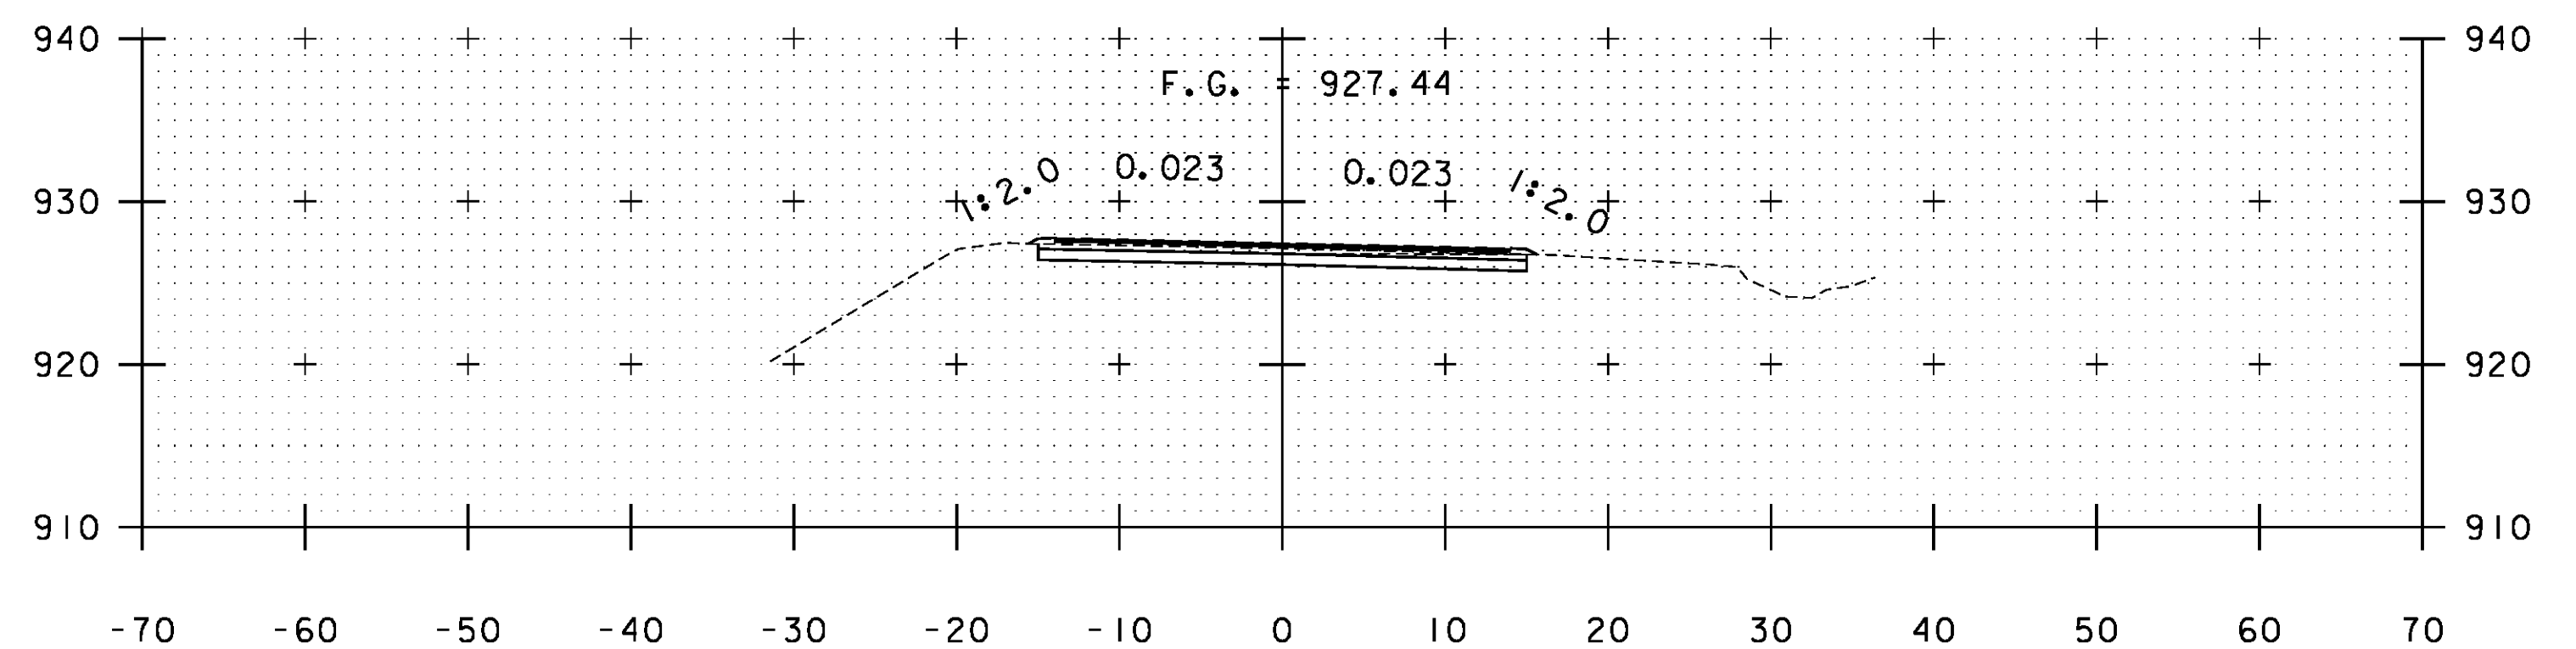

B 11+50

STA. B 10+50 TO STA. B 12+50

PROJECT NAME: WARDSBORO-JAMAICA	PLOT DATE: 2/26/2014
PROJECT NUMBER: ER STP 013-1(17)	DRAWN BY: B. KIPP
FILE NAME: xs.dgn	CHECKED BY: HSD
PROJECT LEADER: K. UPMAL	SHEET 328 OF 444
DESIGNED BY: B. KIPP	
CROSS SECTIONS	