




B 18+53

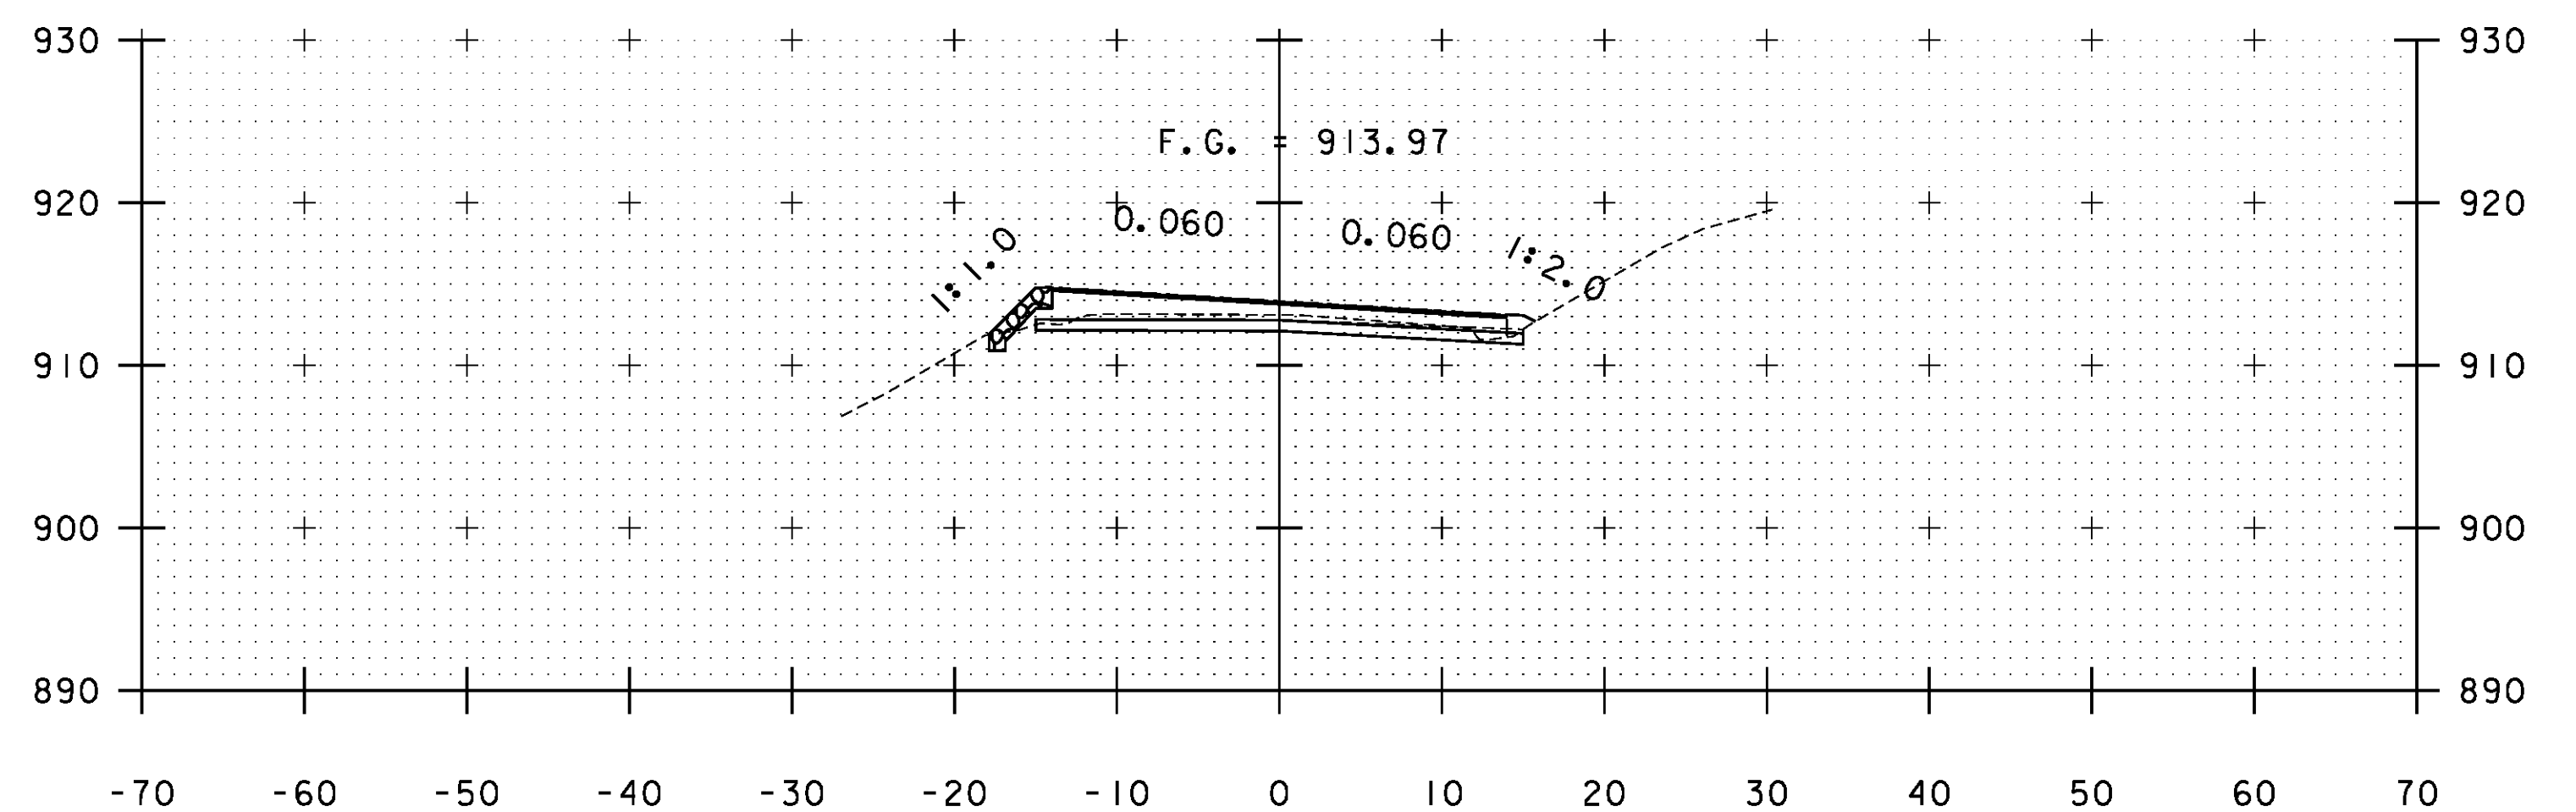


B 18+50

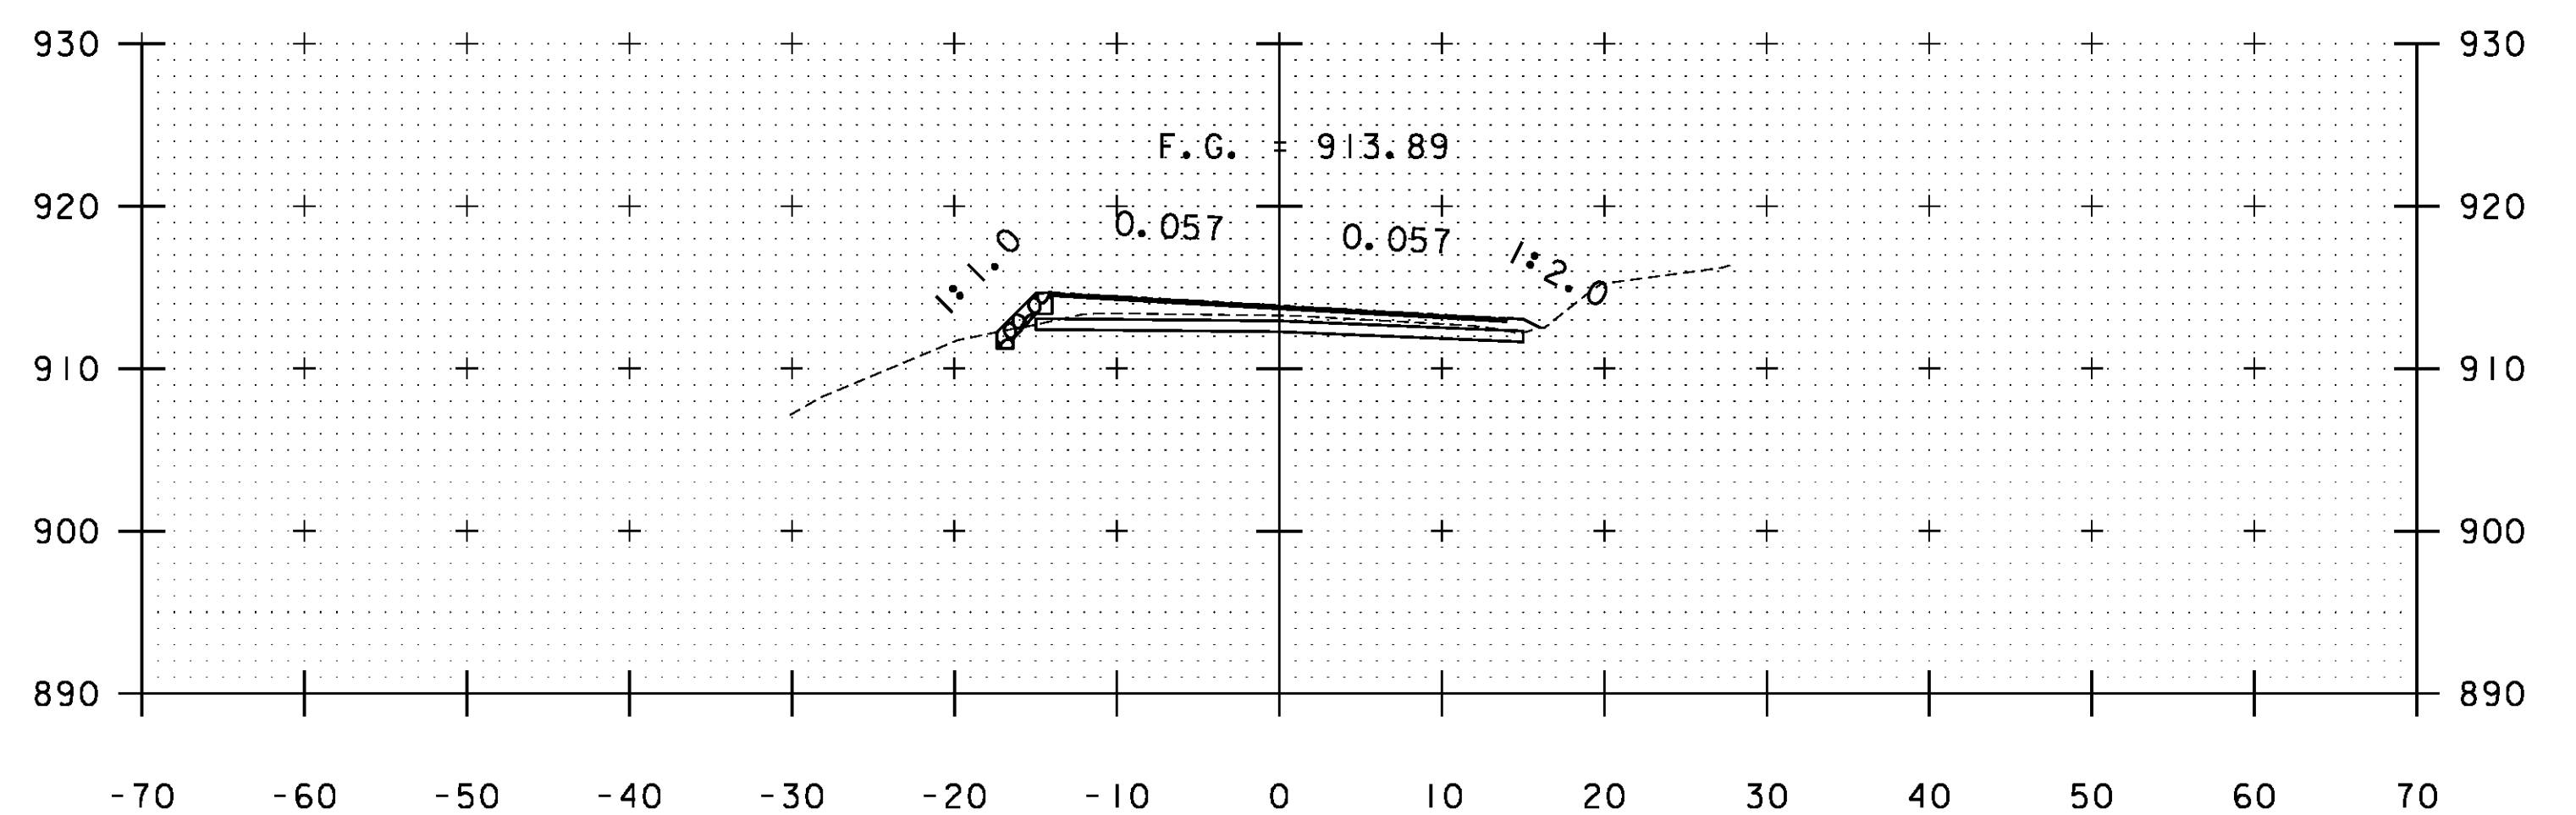

B 18+00

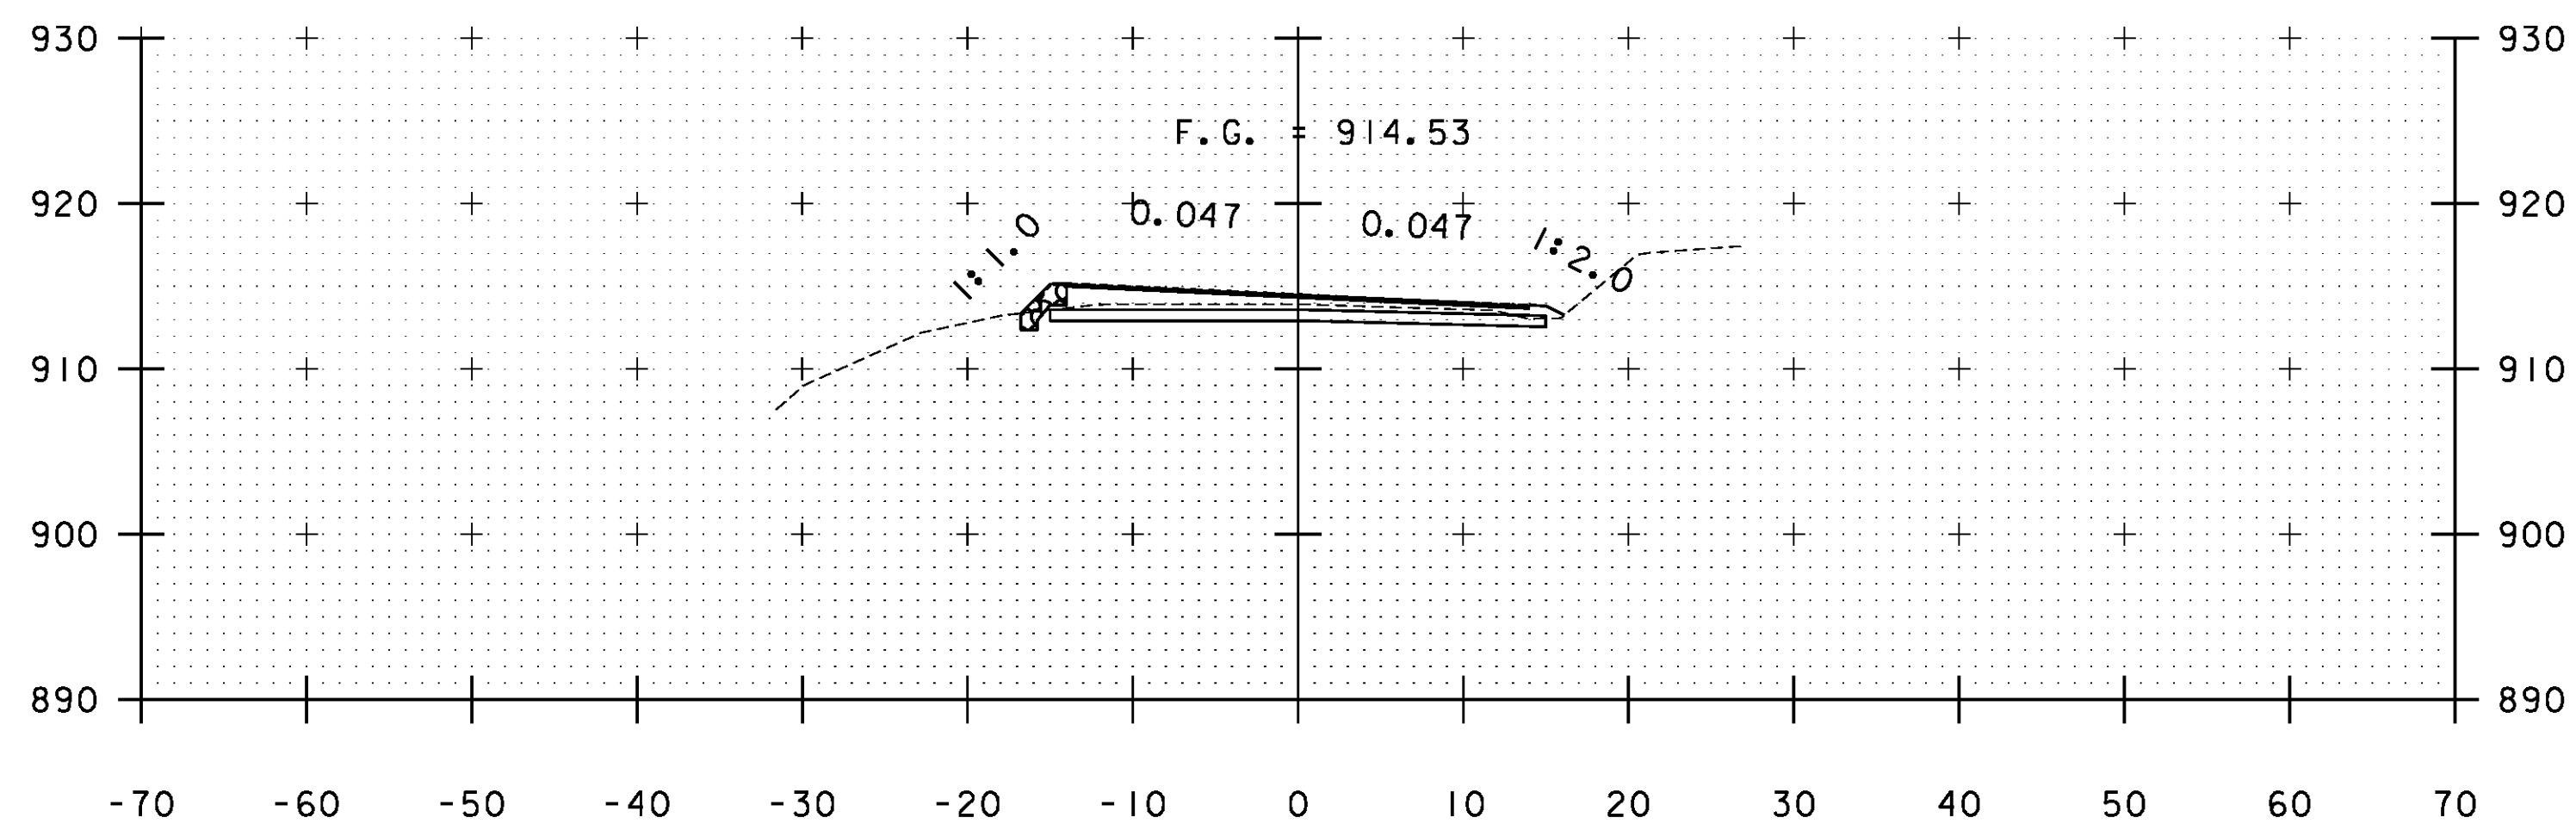

B 17+50

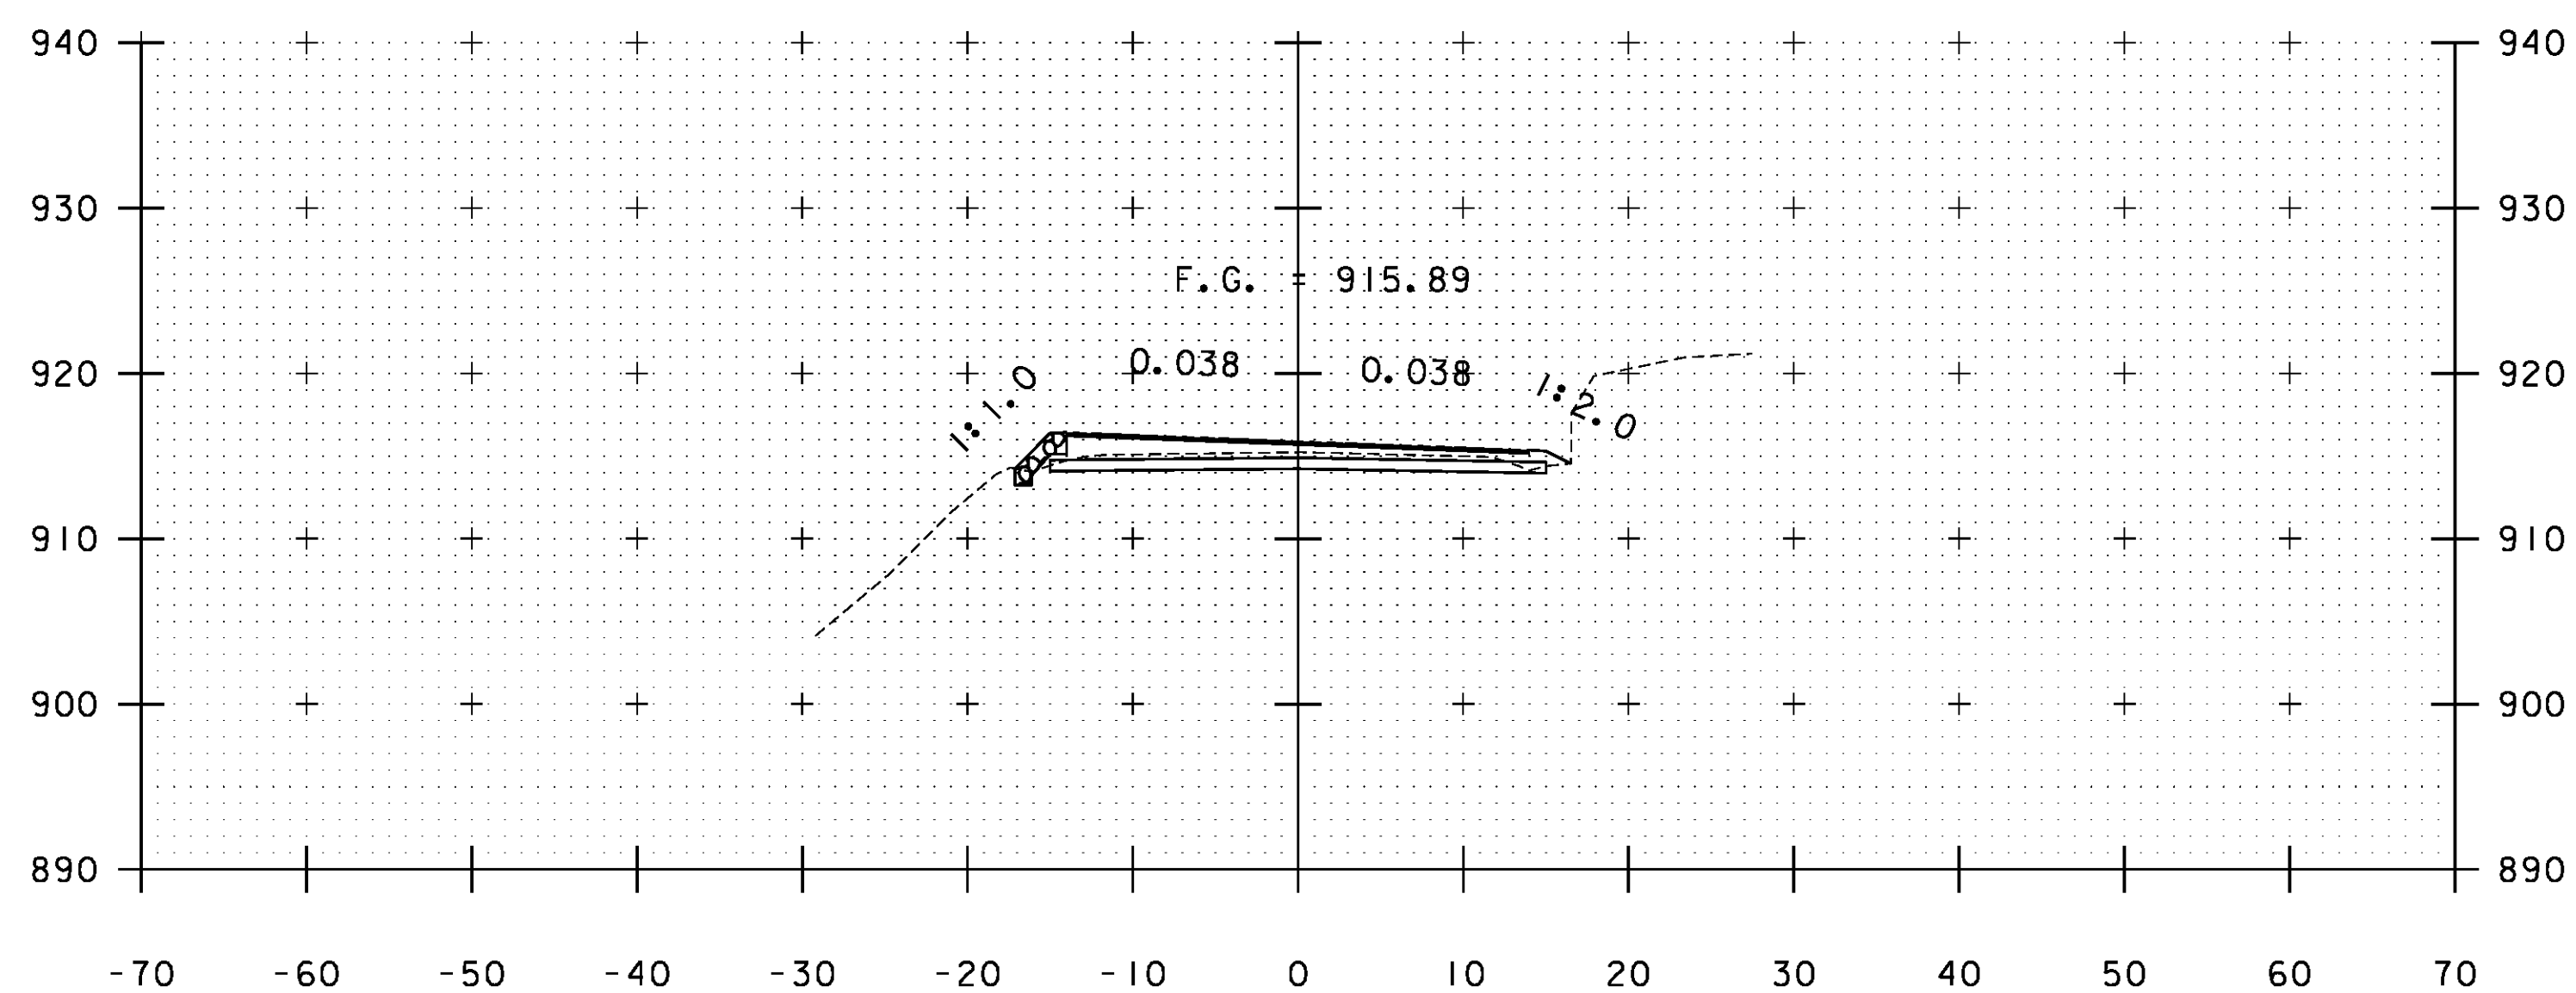

B 17+00

STA. B 17+00 TO STA. B 18+53

PROJECT NAME: WARDBORO-JAMAICA	PLOT DATE: 2/26/2014
PROJECT NUMBER: ER STP 013-1(17)	DRAWN BY: B. KIPP
FILE NAME: xs.dgn	CHECKED BY: HSD
PROJECT LEADER: K. UPMAL	SHEET 331 OF 444
DESIGNED BY: B. KIPP	
CROSS SECTIONS	