




B 35+50

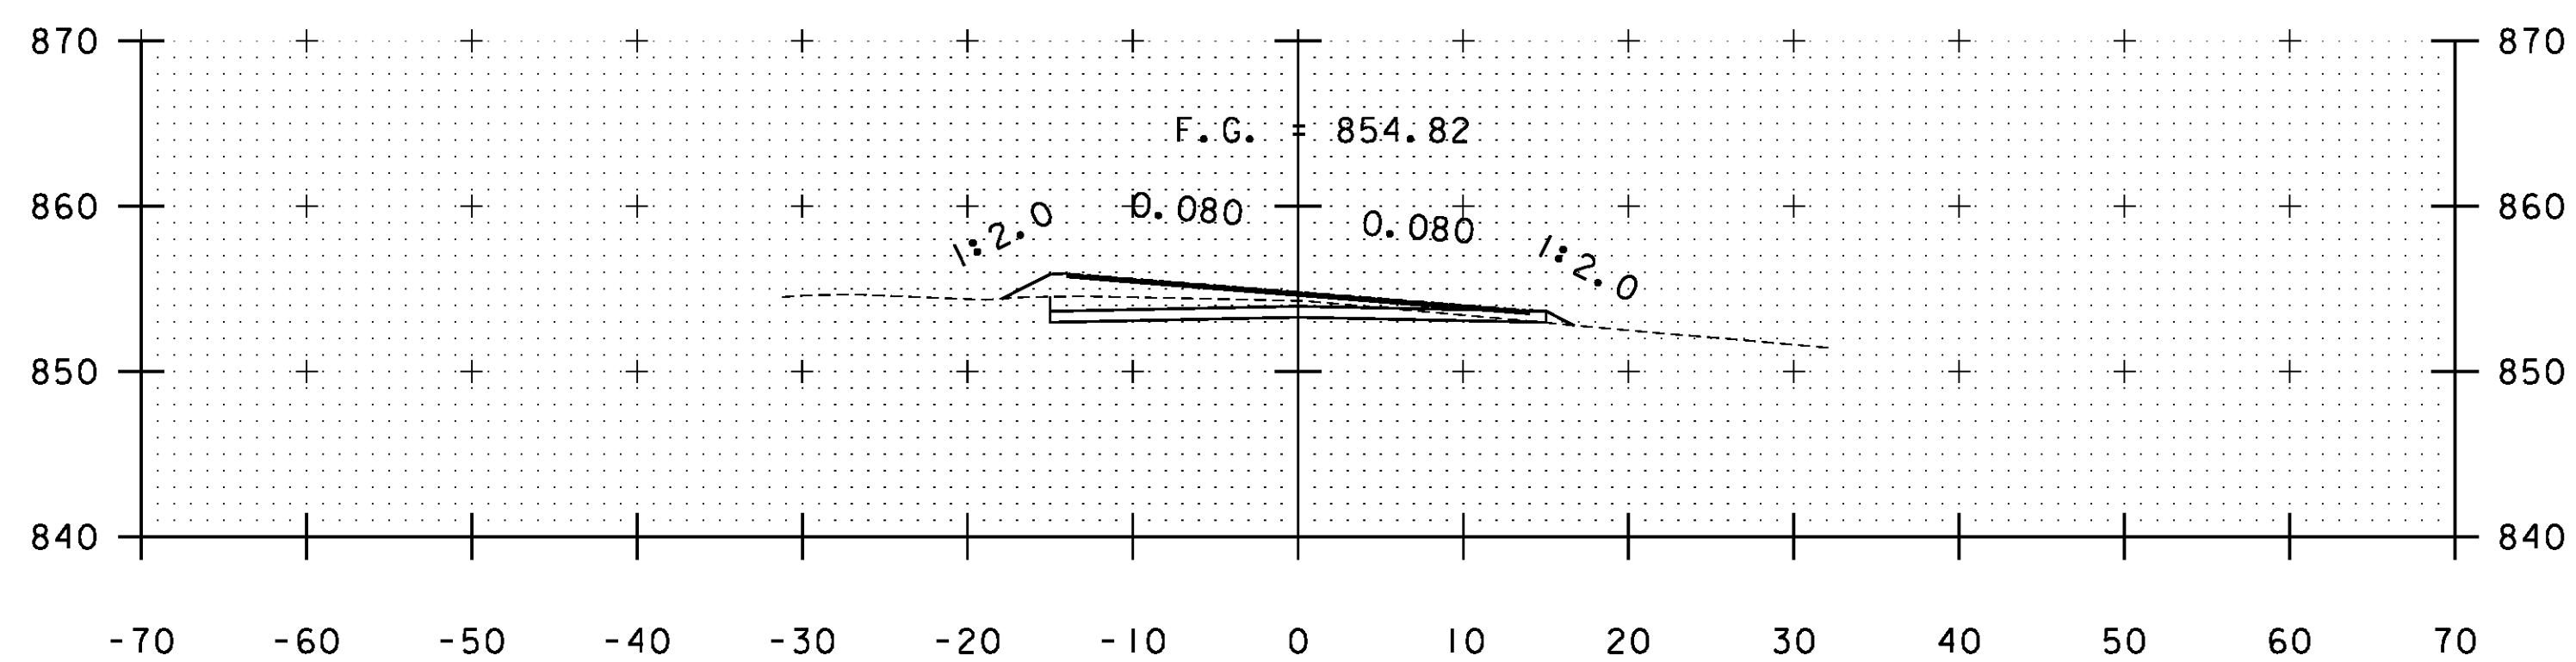


B 35+00

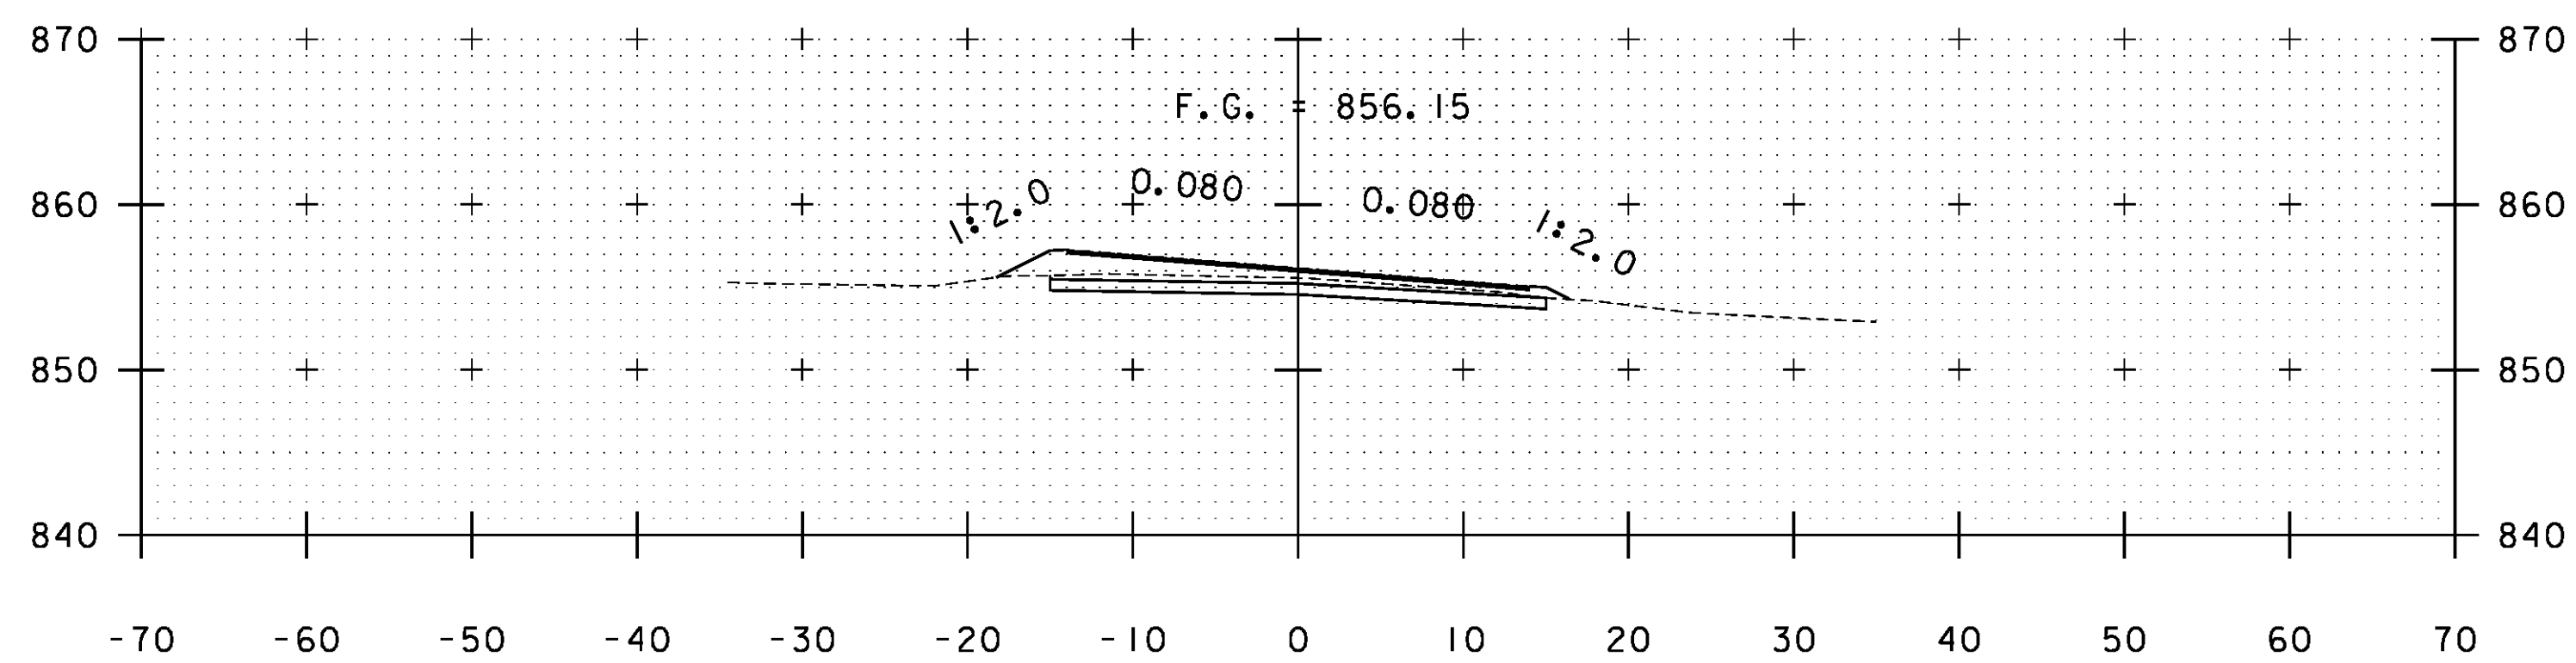


B 34+50

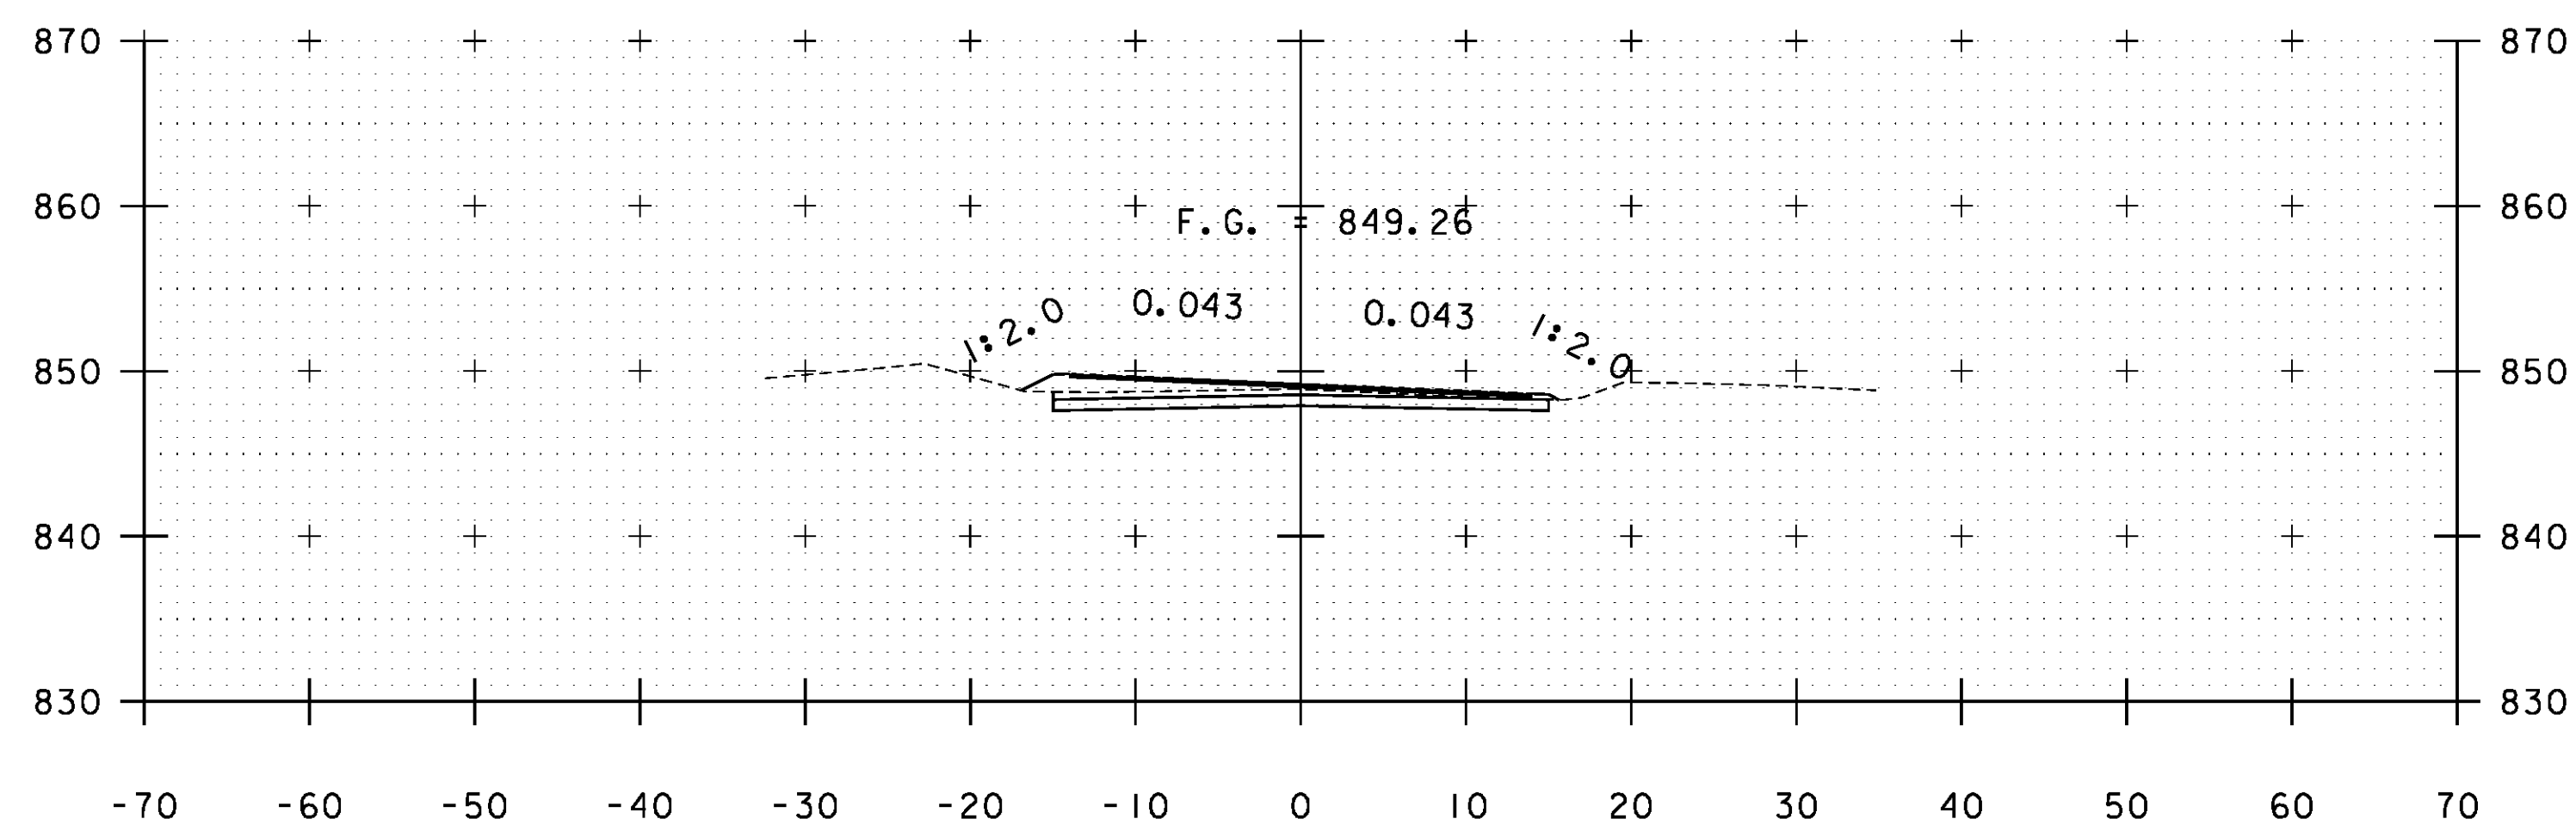

B 37+00

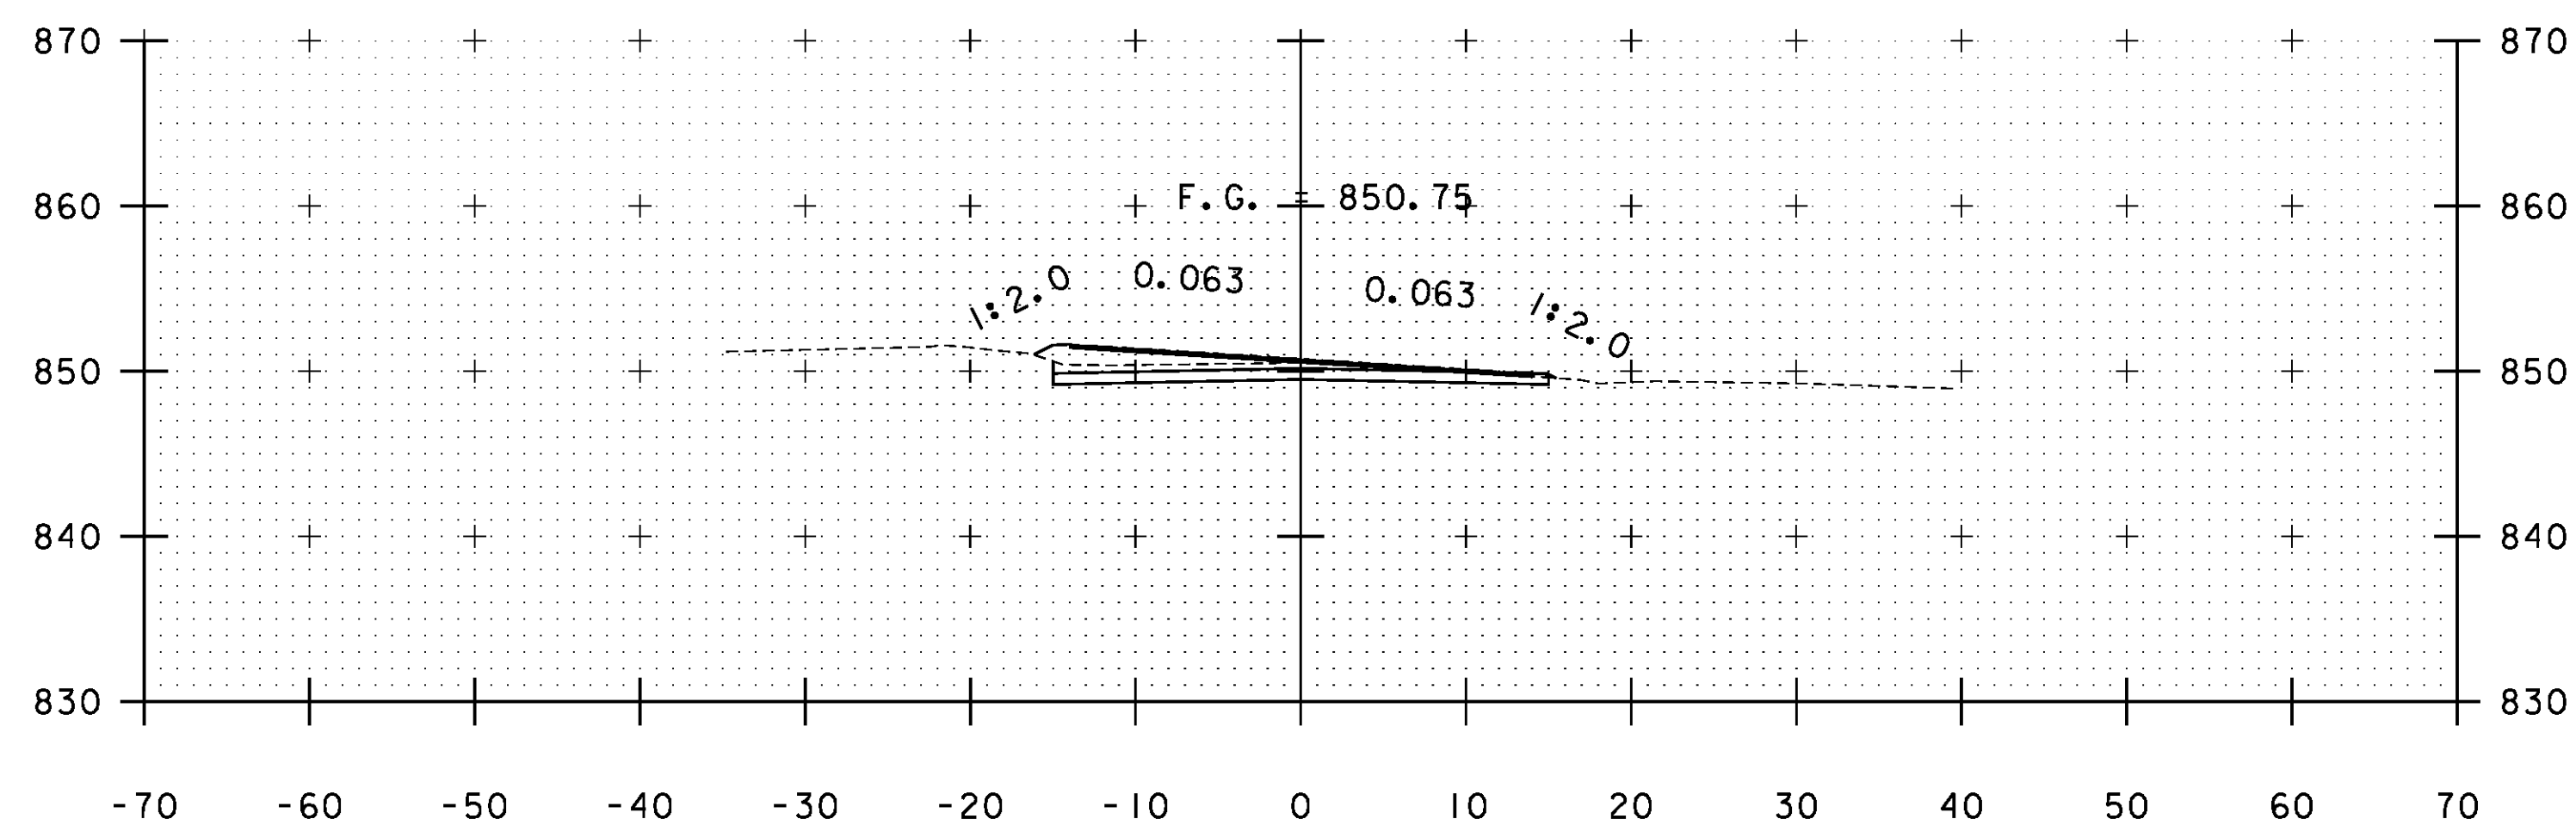

B 36+50

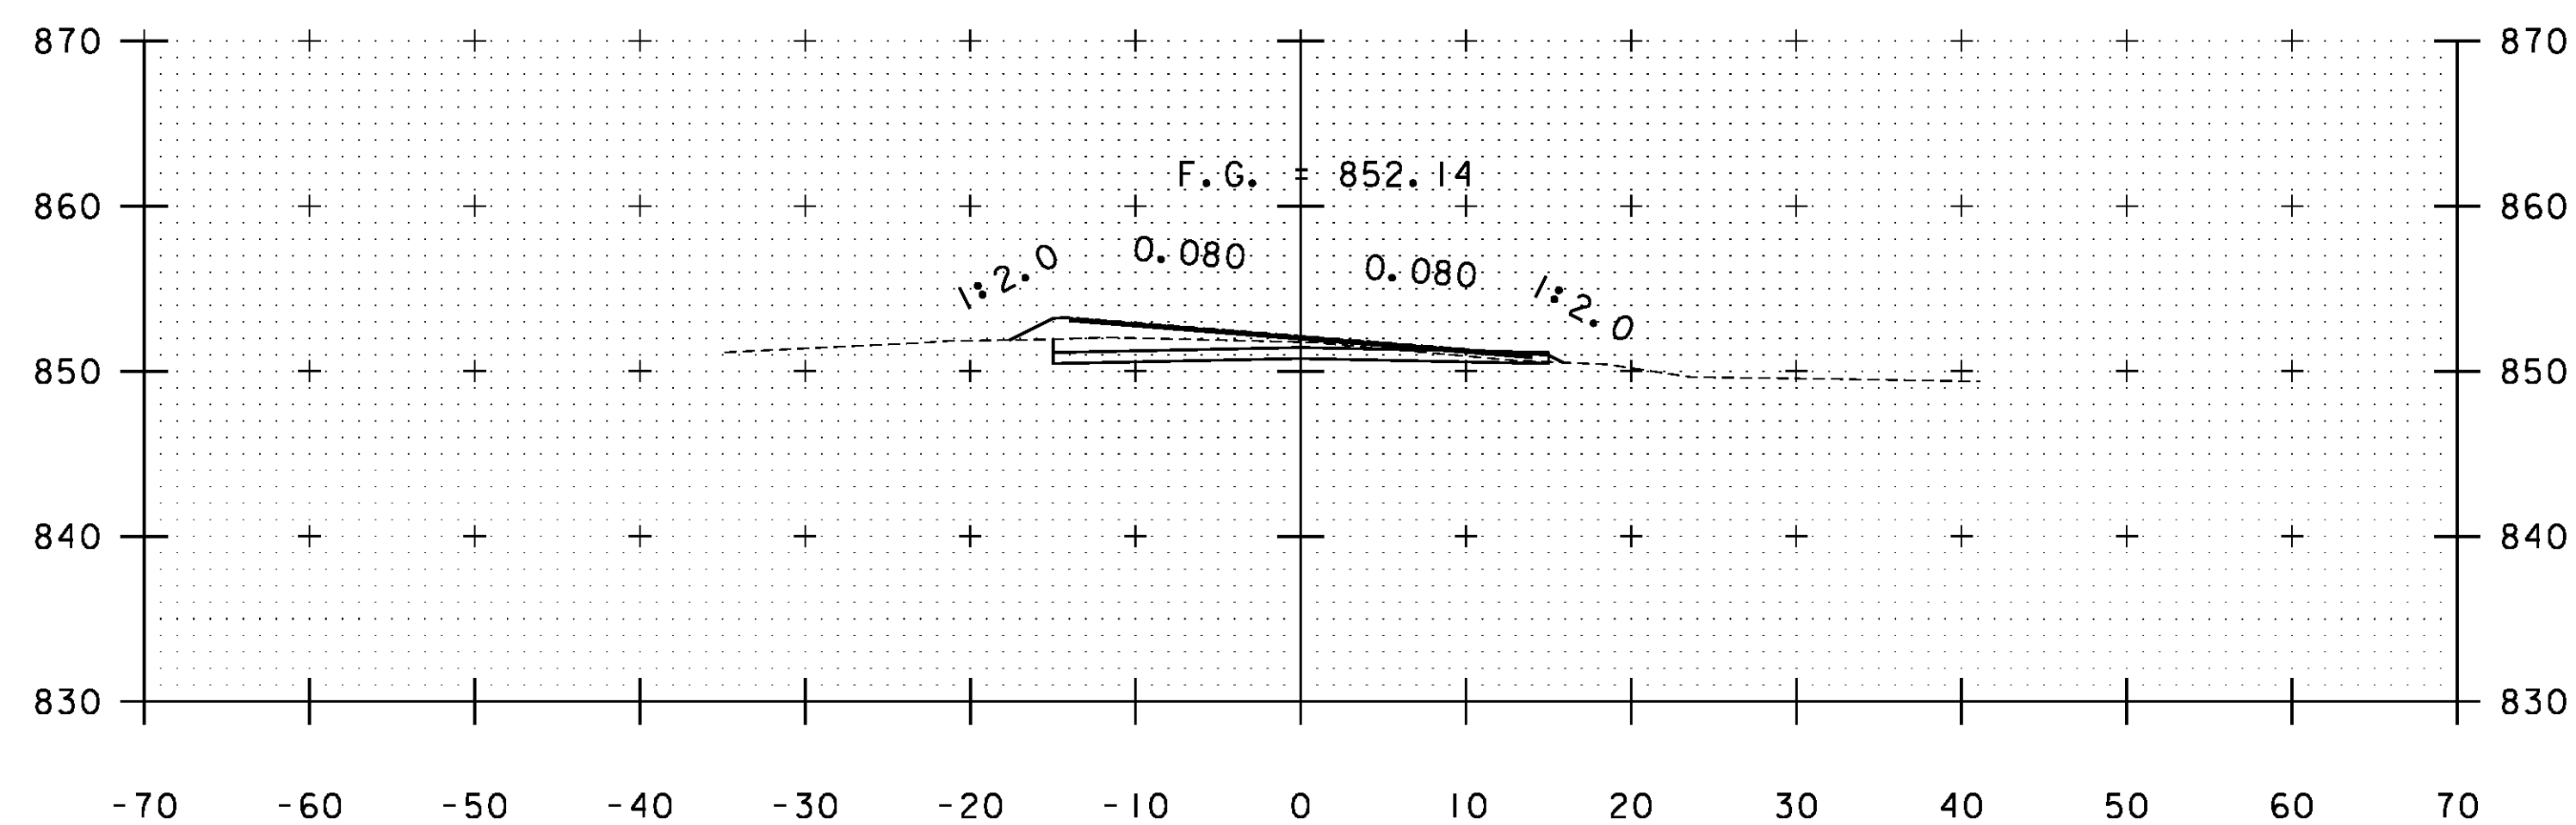

B 36+00

PROJECT NAME: WARDBORO-JAMAICA	
PROJECT NUMBER: ER STP 013-1(17)	
FILE NAME: xs.dgn	PLOT DATE: 2/26/2014
PROJECT LEADER: K. UPMAL	DRAWN BY: B. KIPP
DESIGNED BY: B. KIPP	CHECKED BY: HSD
CROSS SECTIONS	SHEET 338 OF 444

STA. B 34+50 TO STA. B 37+00