




B 53+00

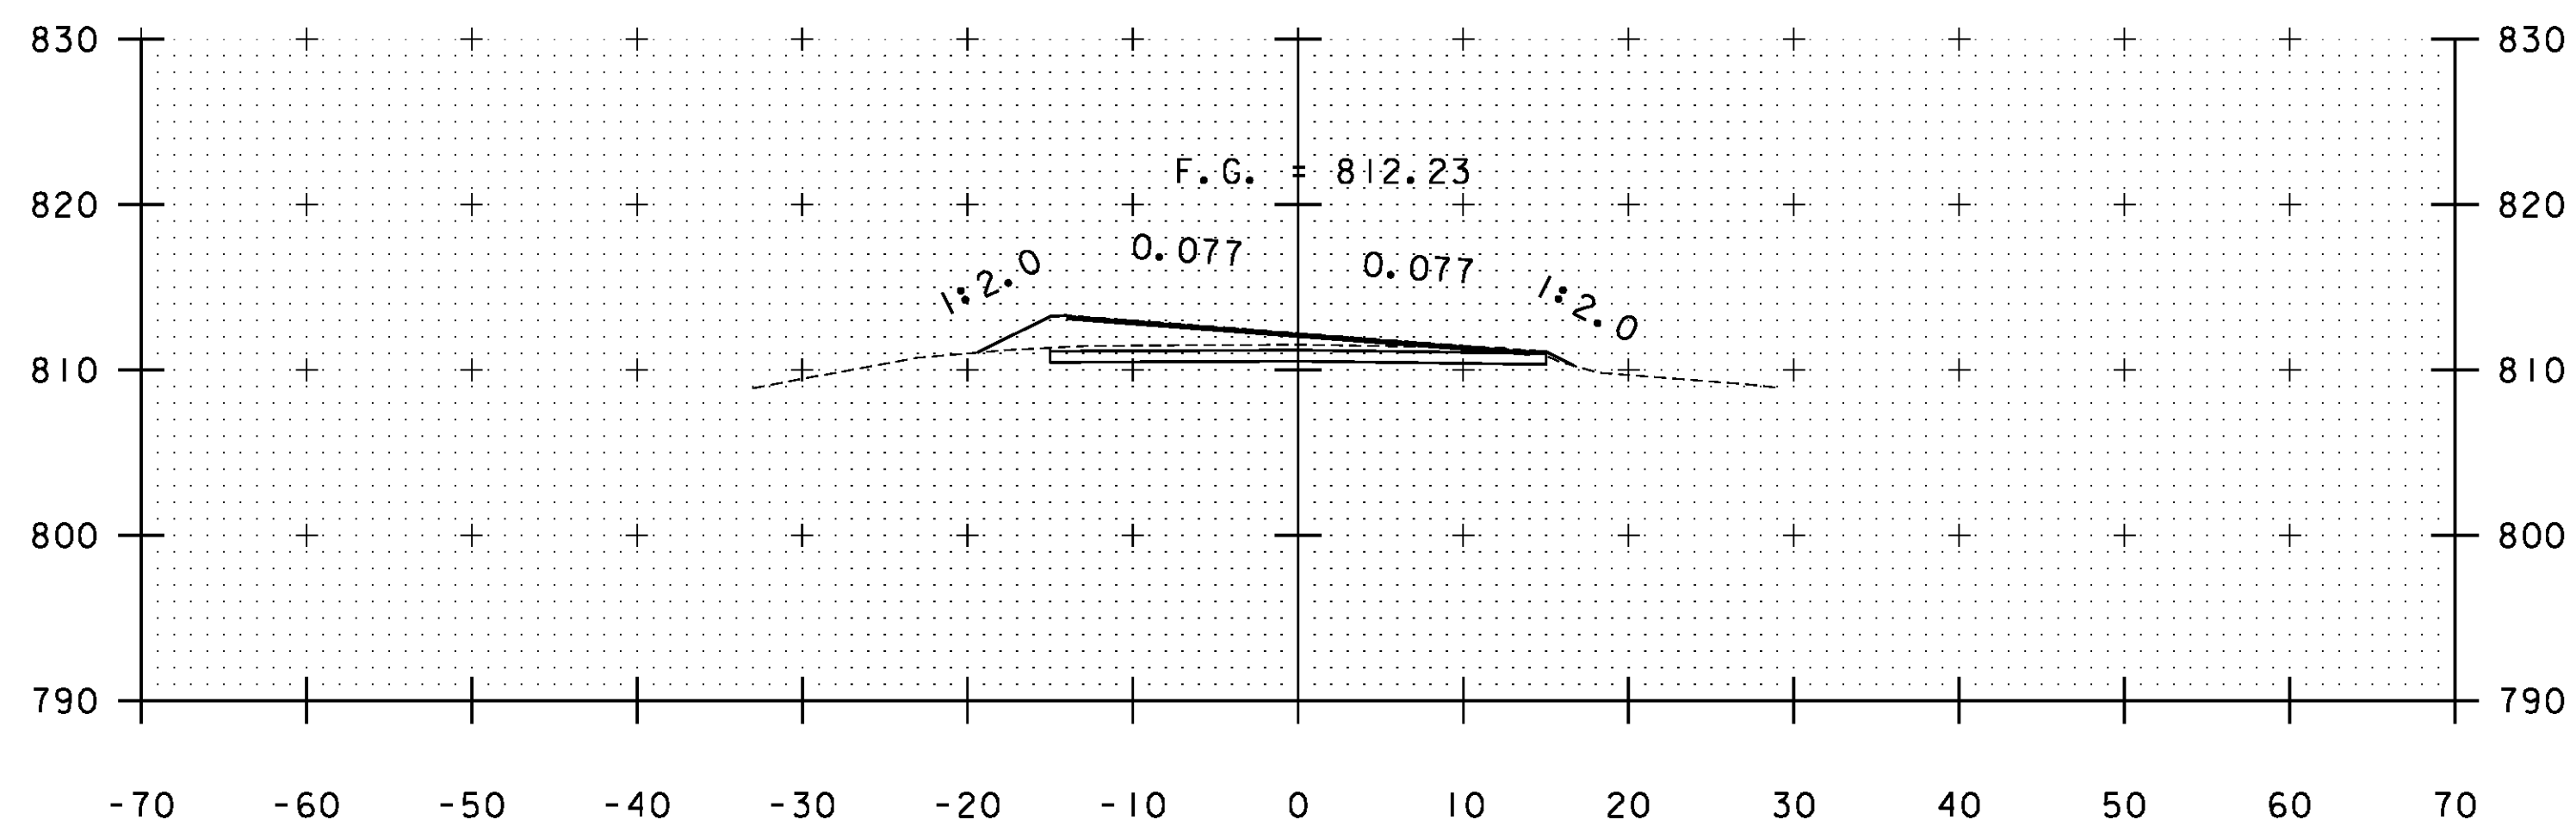


B 52+50

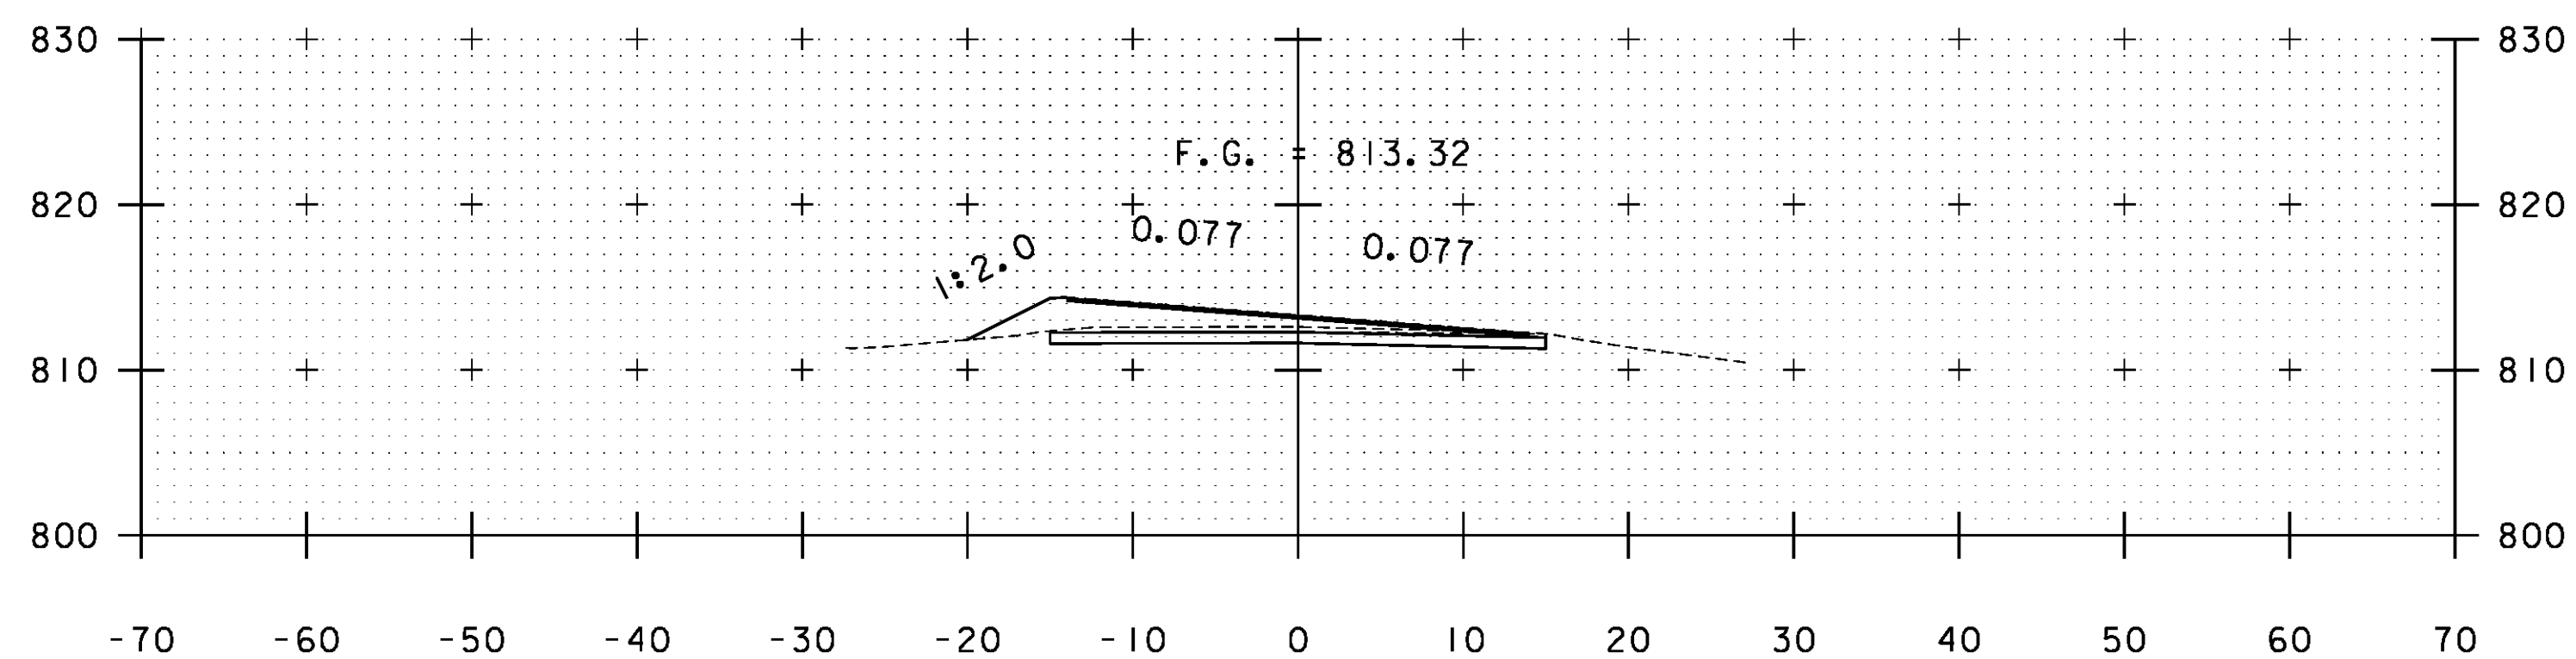


B 52+00

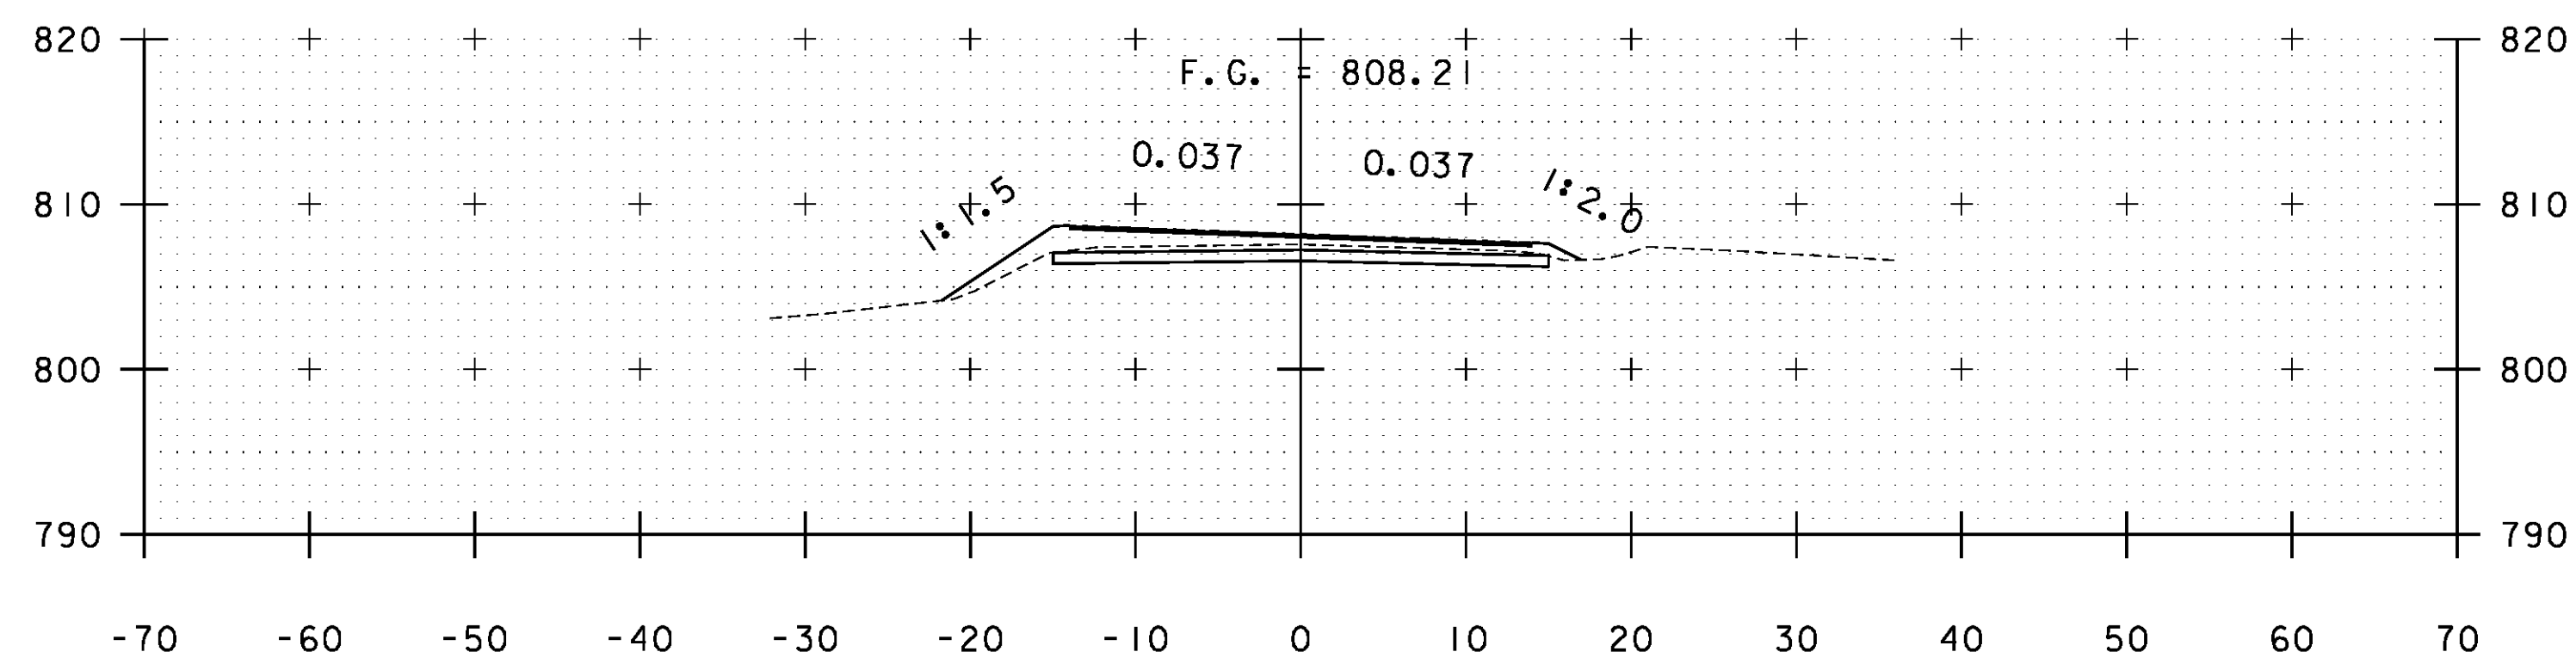

B 54+50

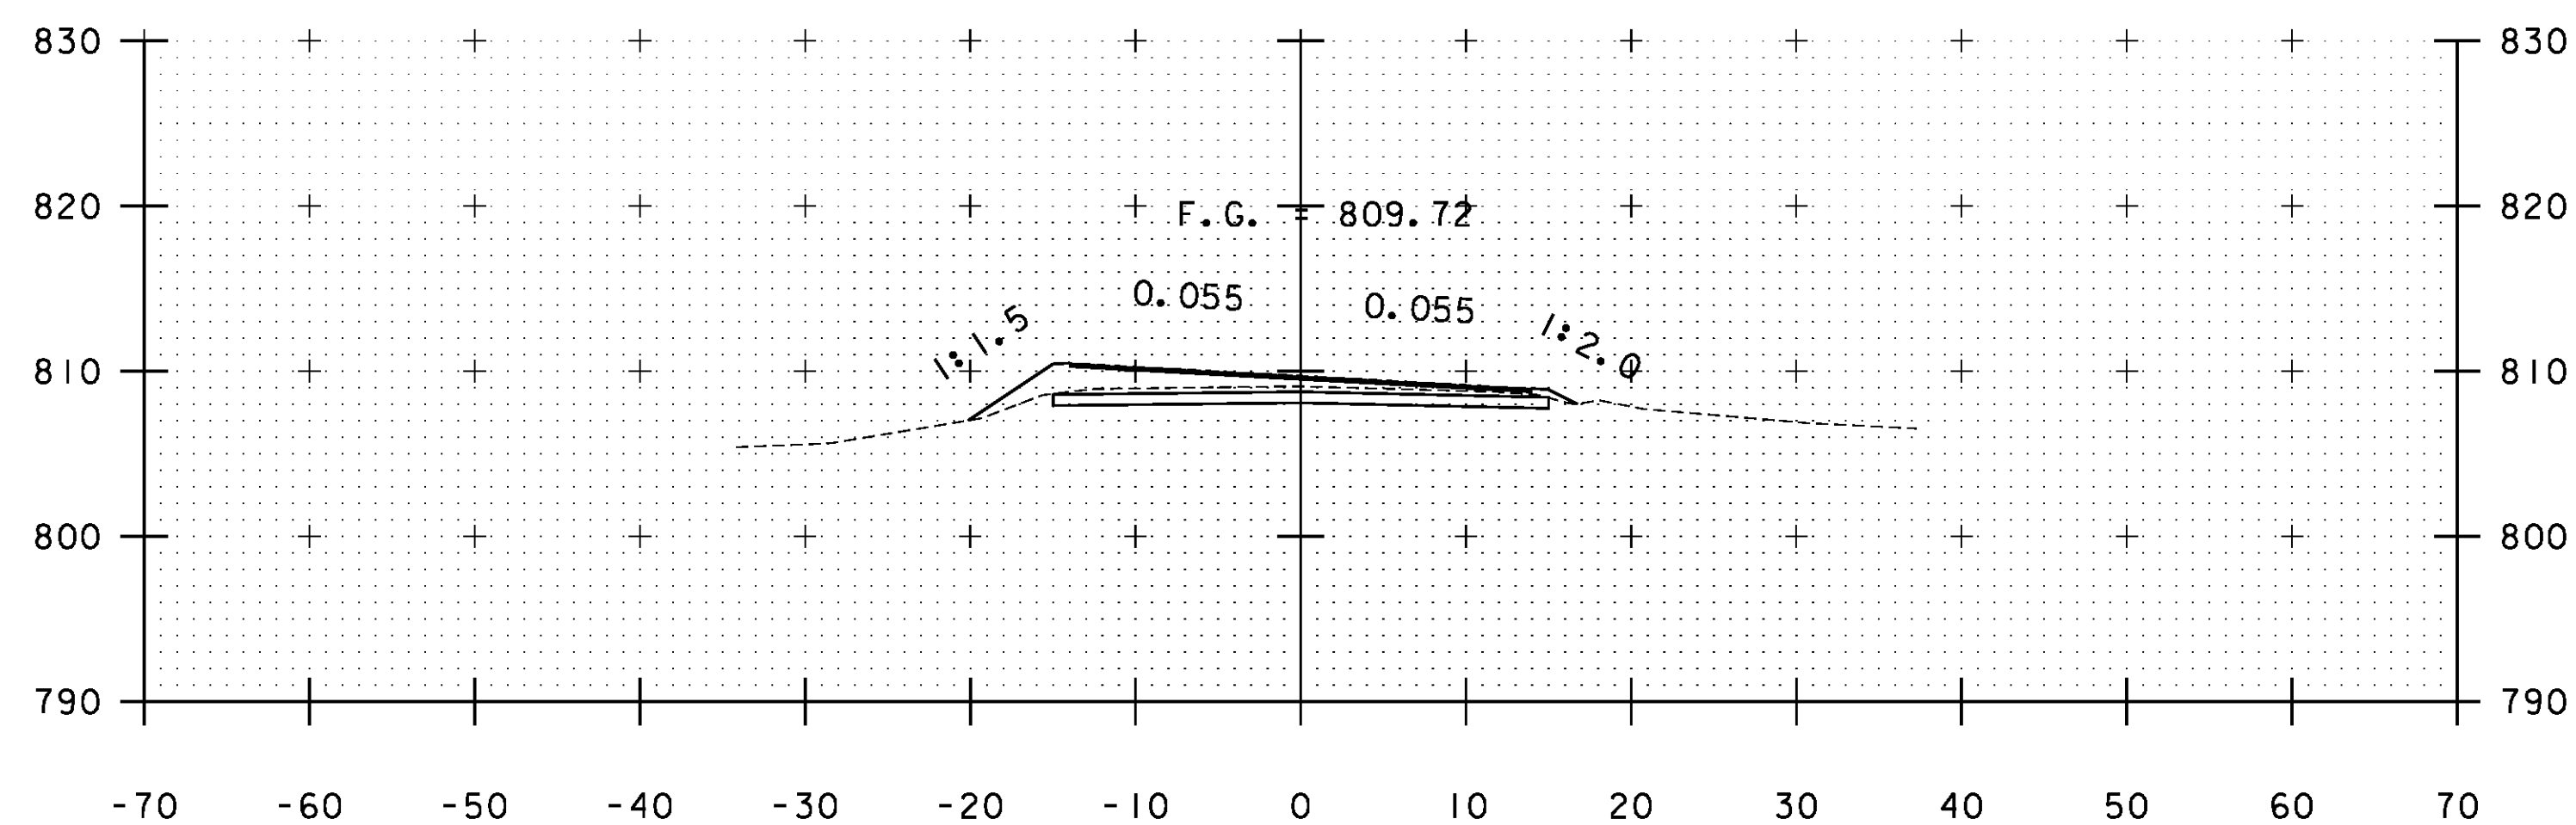

B 54+00

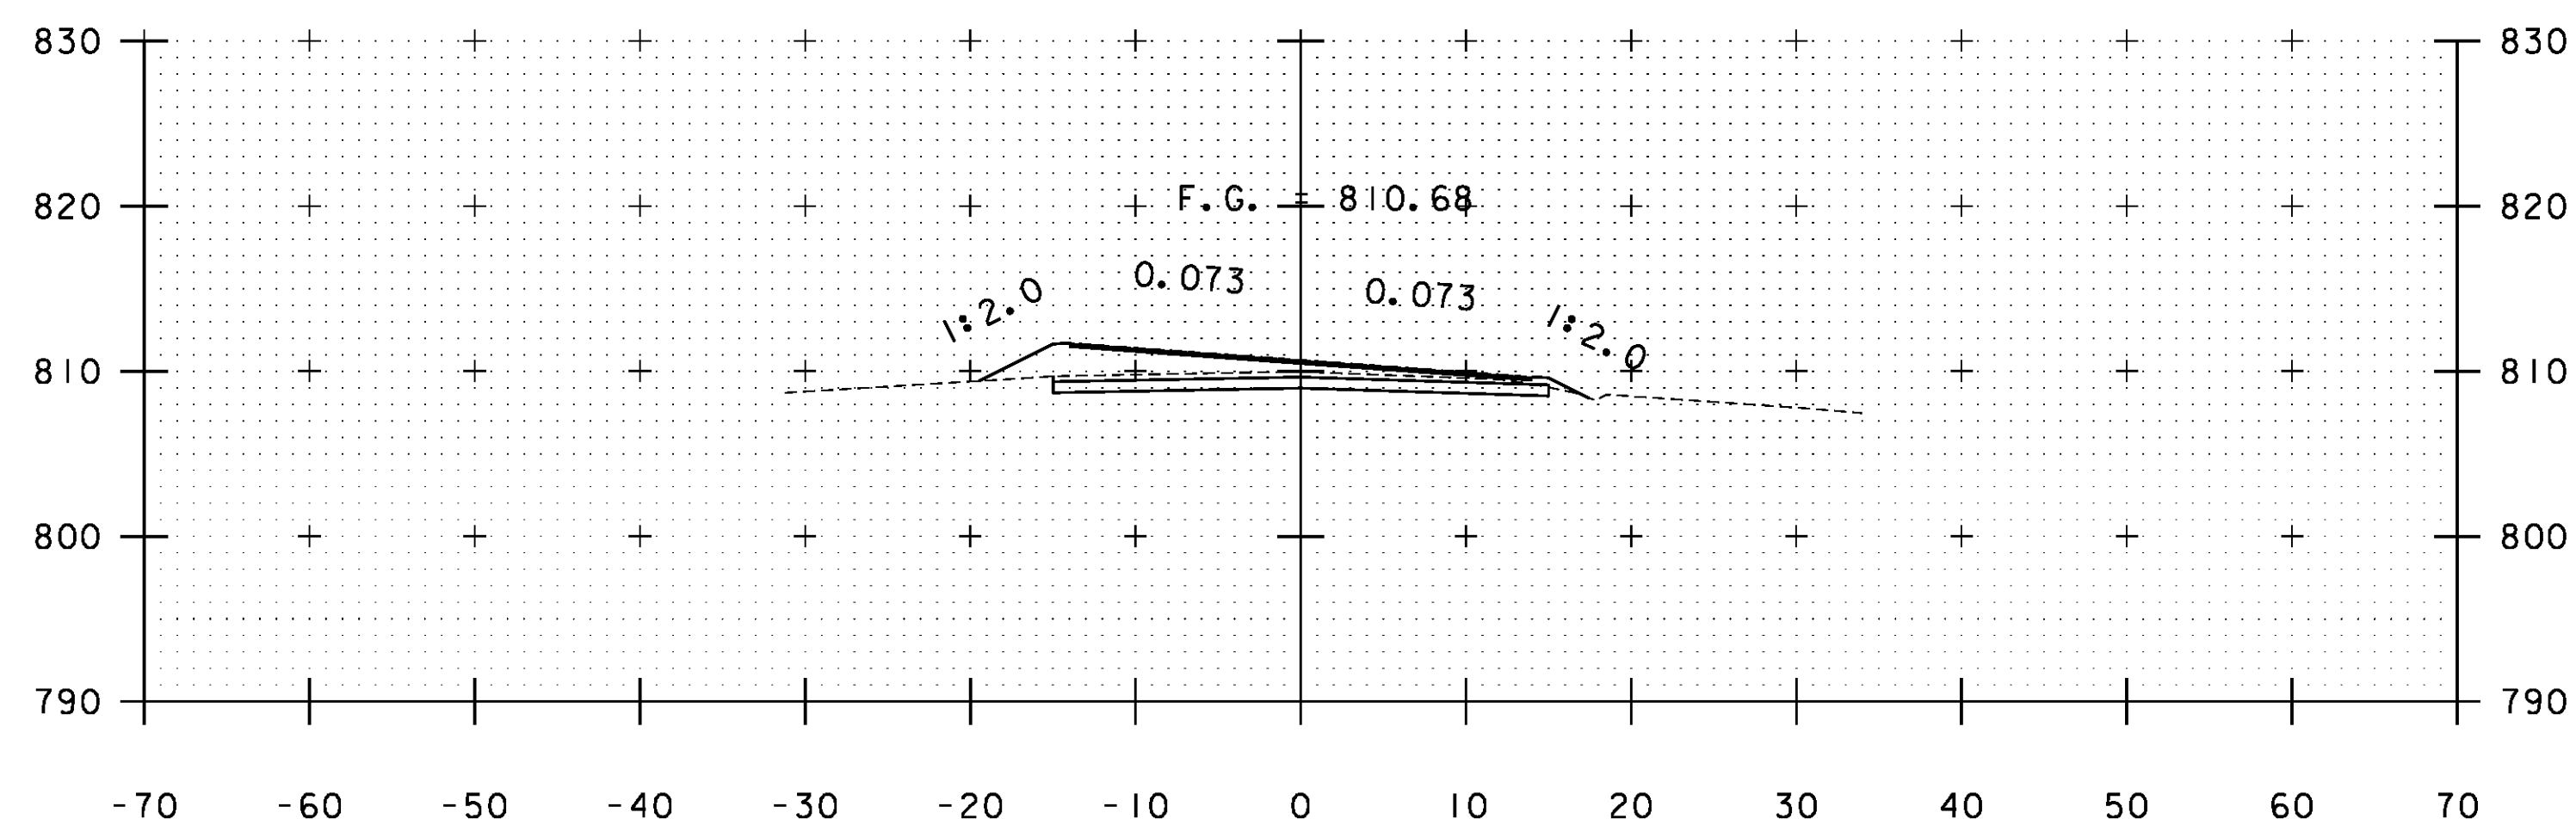

B 53+50

STA. B 52+00 TO STA. B 54+50

PROJECT NAME: WARDBORO-JAMAICA	PLOT DATE: 2/26/2014
PROJECT NUMBER: ER STP 013-1(17)	DRAWN BY: B. KIPP
FILE NAME: xs.dgn	CHECKED BY: HSD
PROJECT LEADER: K. UPMAL	SHEET 345 OF 444
DESIGNED BY: B. KIPP	CROSS SECTIONS