




B 58+60

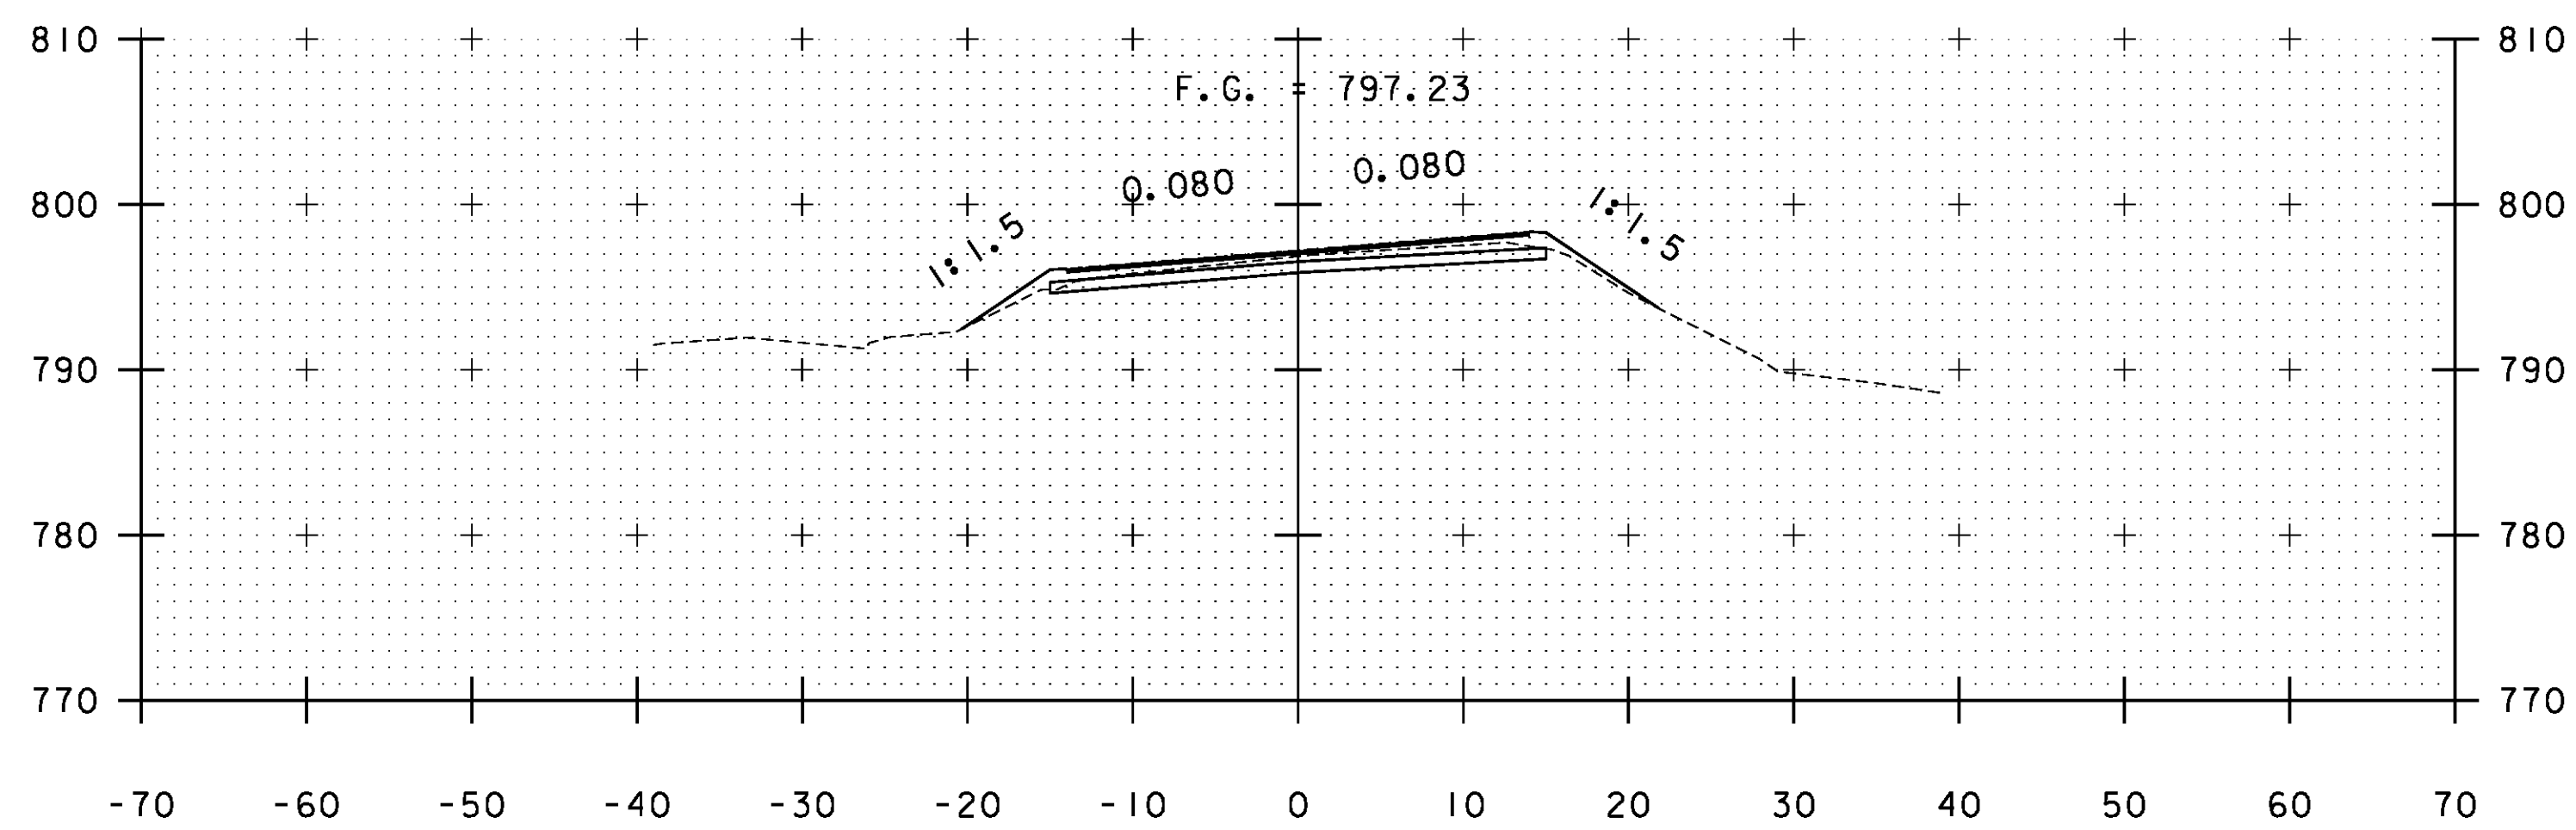


B 58+50

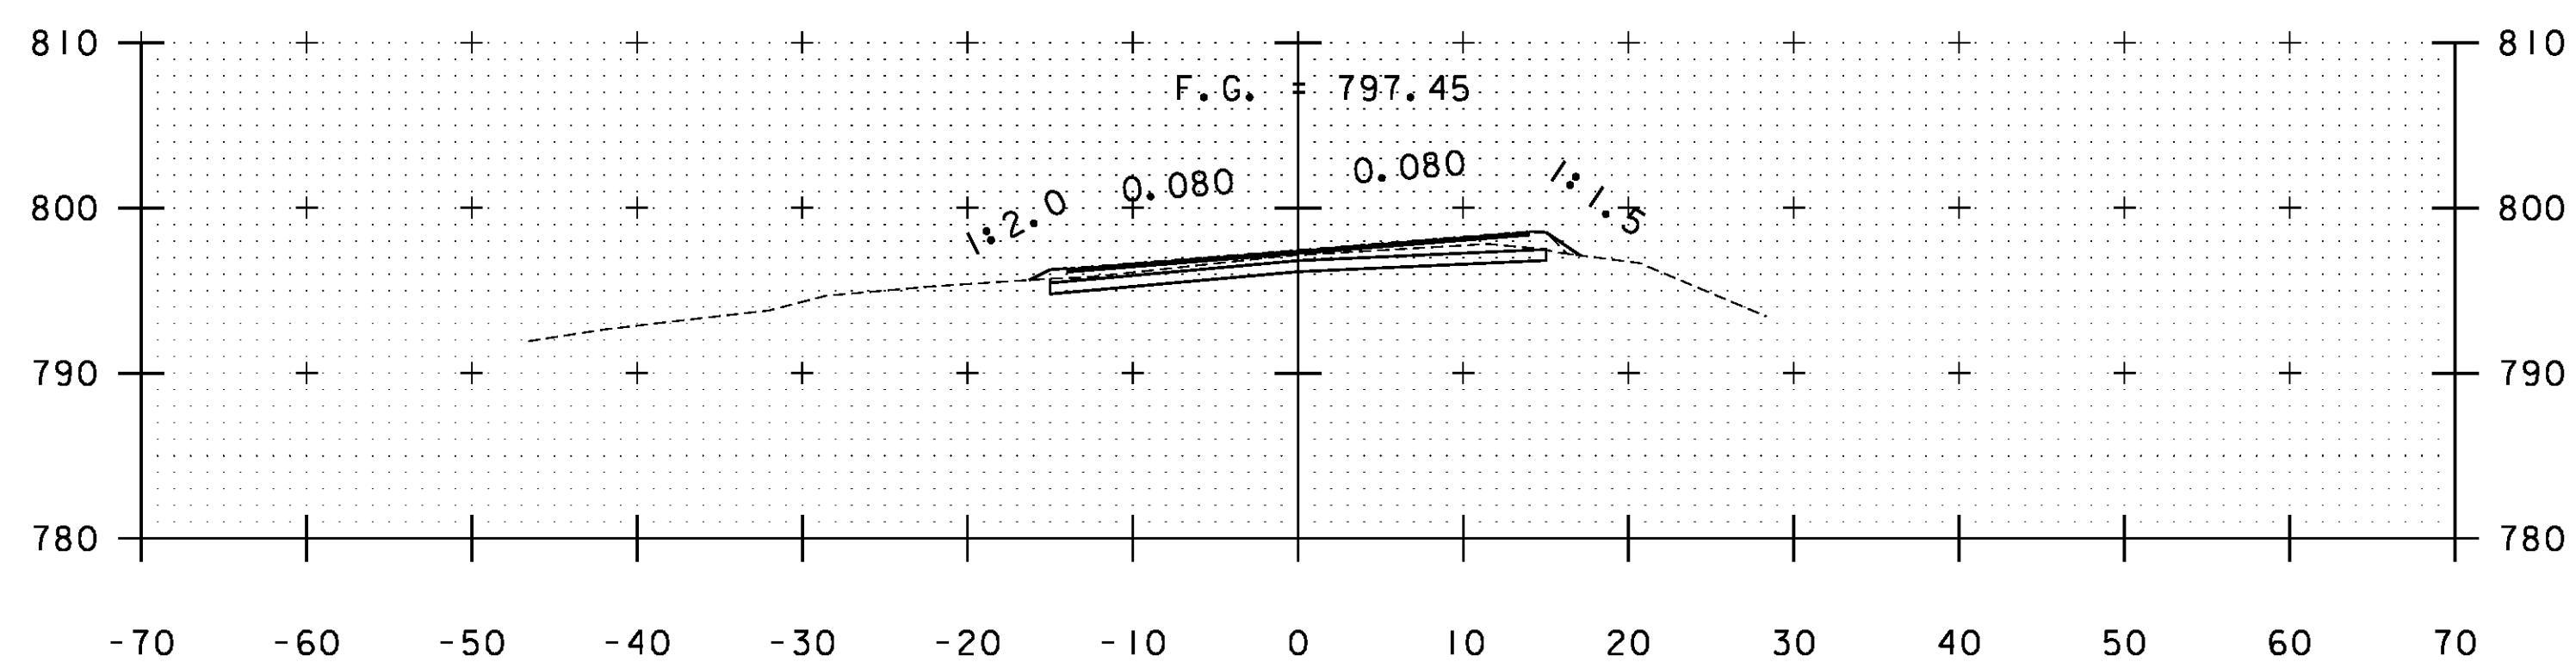

B 58+00

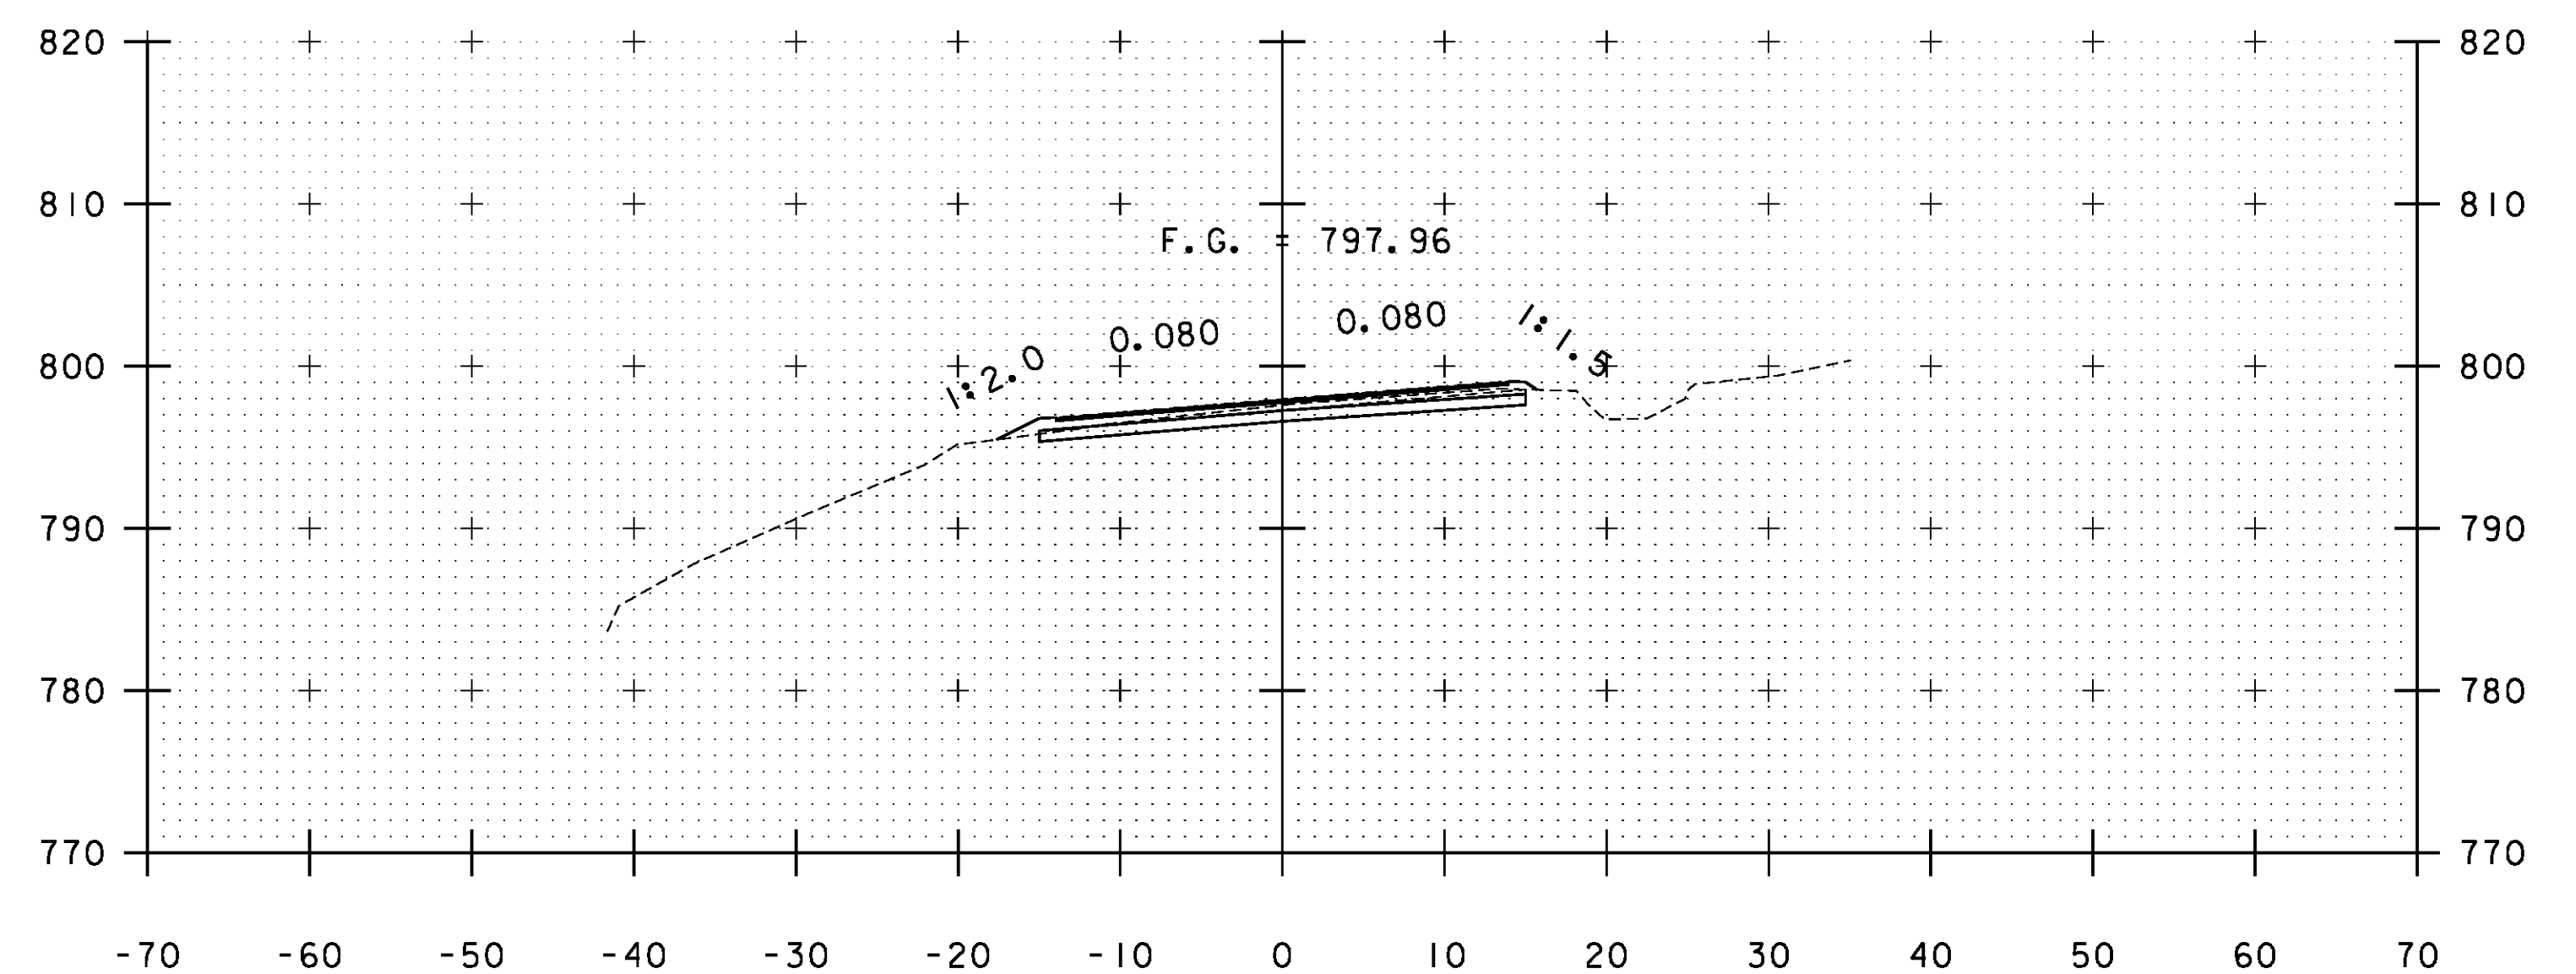

B 59+50

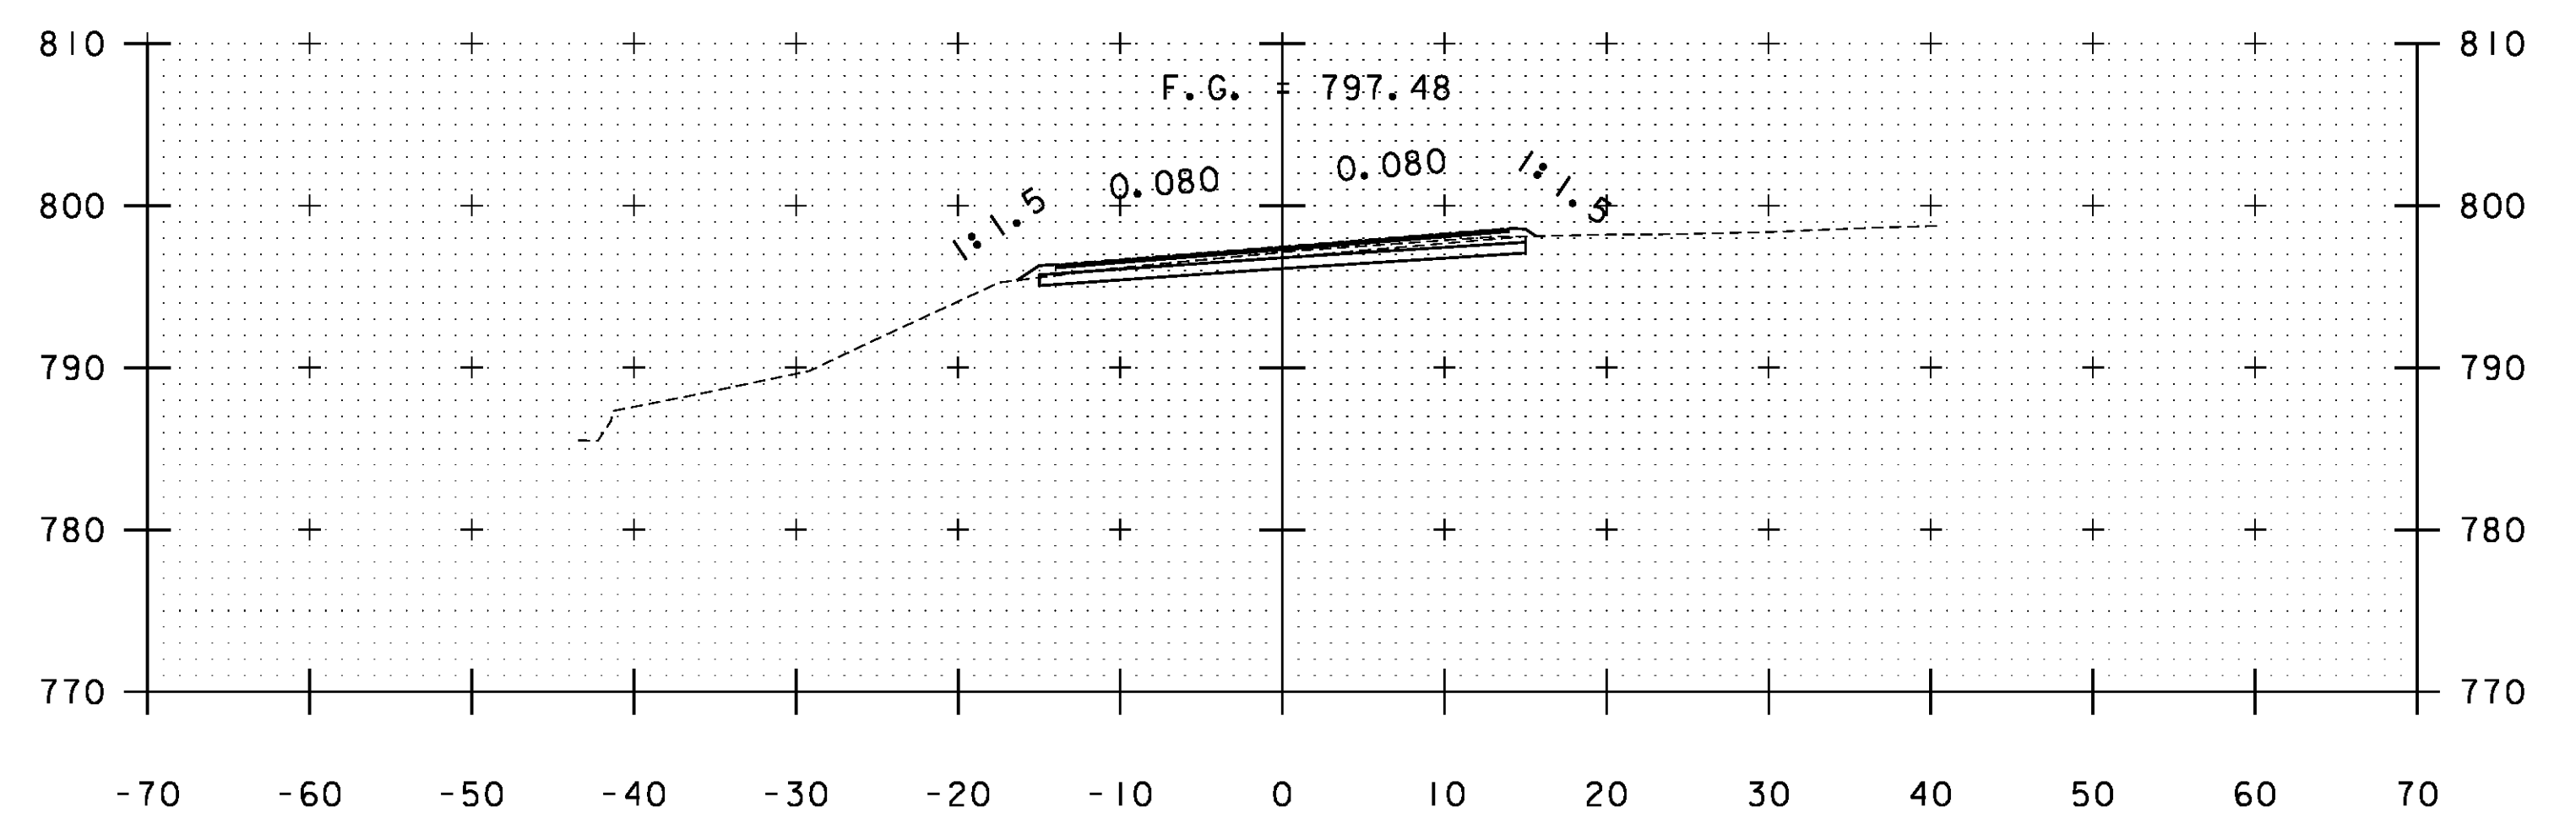

B 59+00

STA. B 58+00 TO STA. B 59+50

PROJECT NAME: WARDBORO-JAMAICA	PLOT DATE: 2/26/2014
PROJECT NUMBER: ER STP 013-1(17)	DRAWN BY: B. KIPP
FILE NAME: xs.dgn	CHECKED BY: HSD
PROJECT LEADER: K. UPMAL	SHEET 347 OF 444
DESIGNED BY: B. KIPP	
CROSS SECTIONS	