




B 60+50

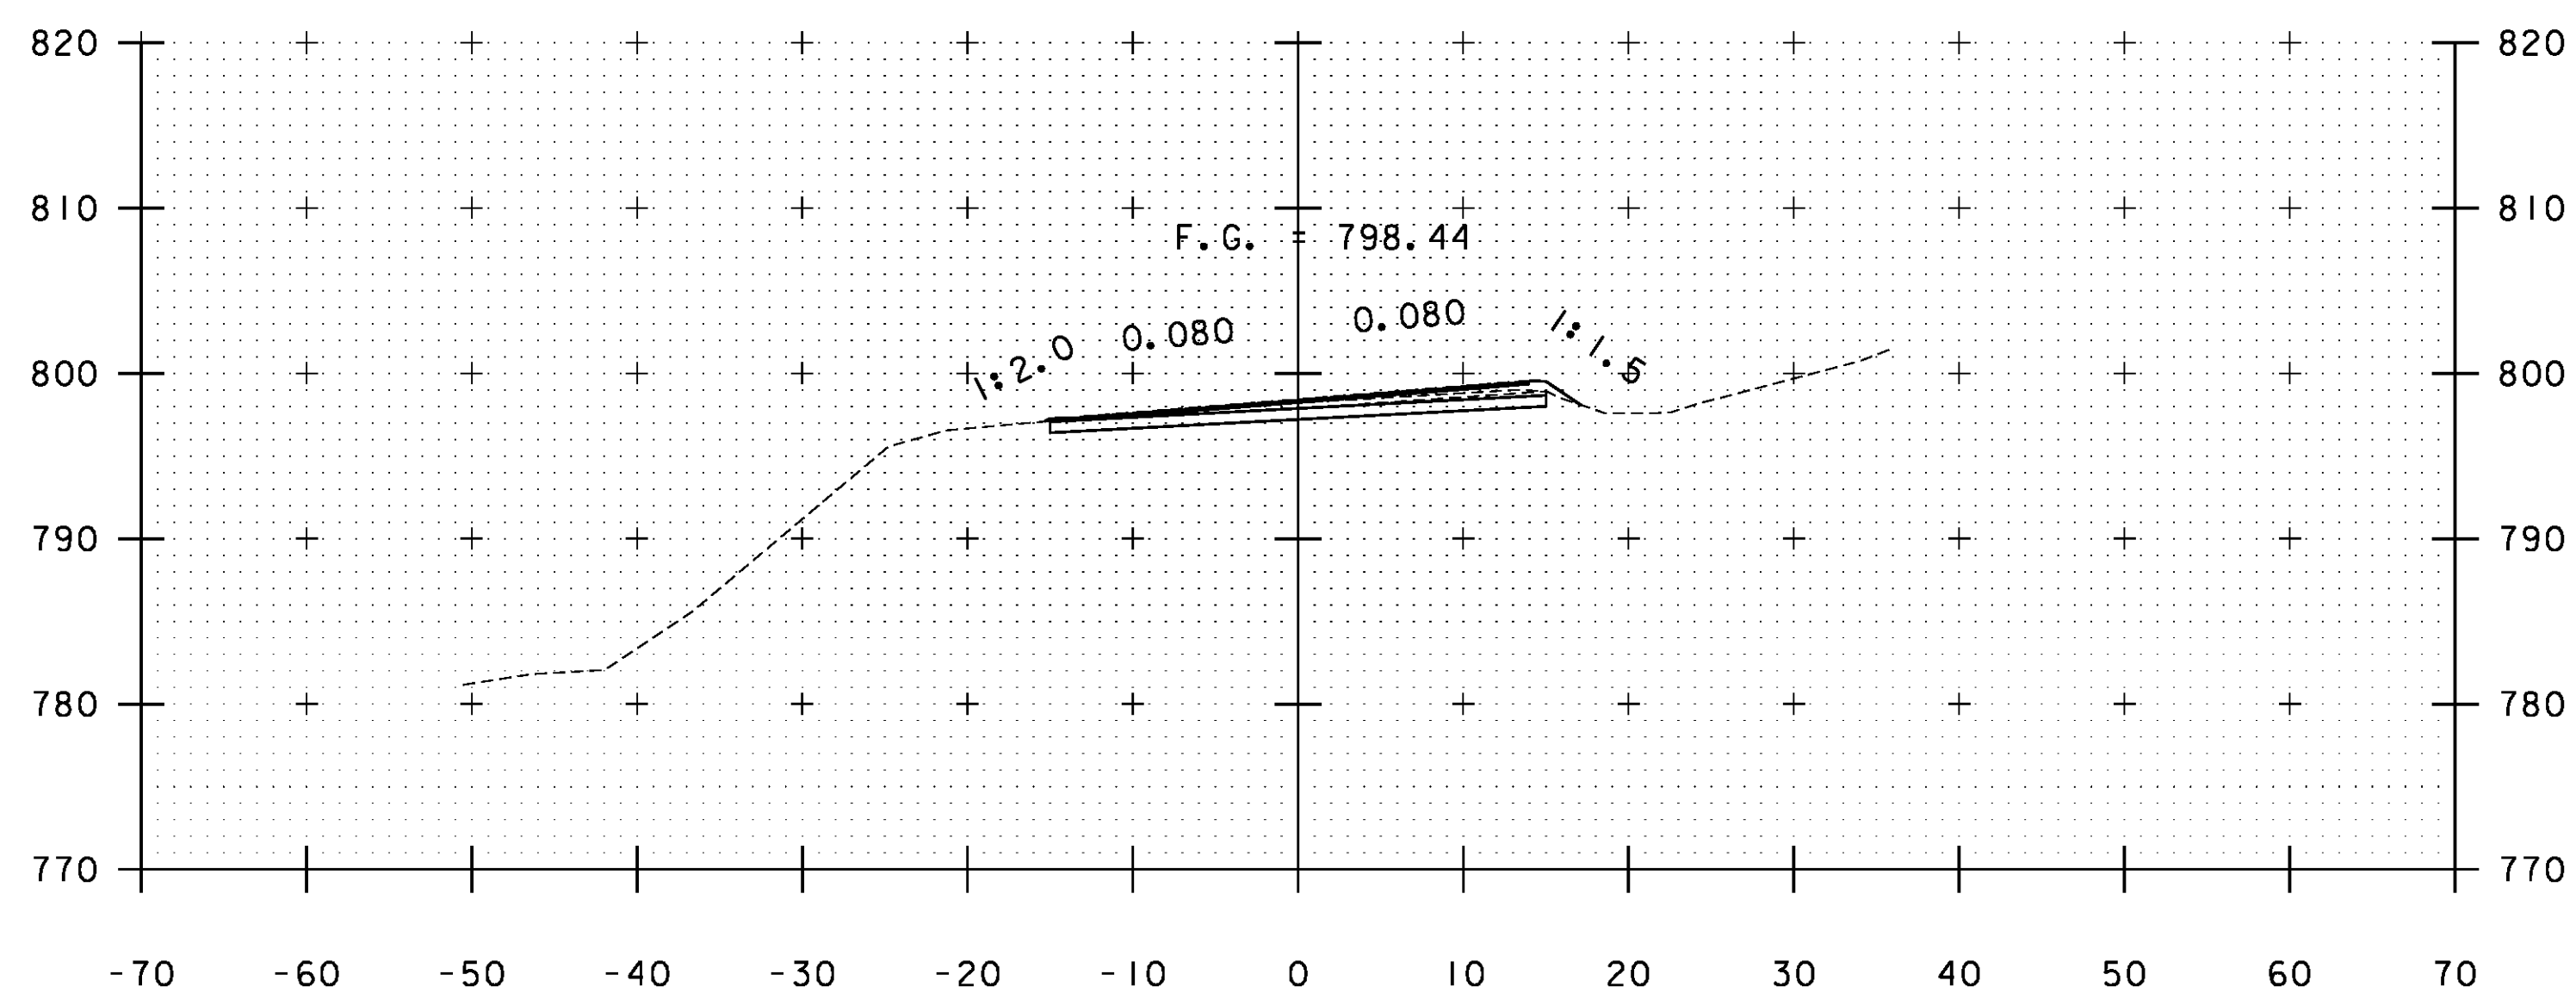

B 60+00

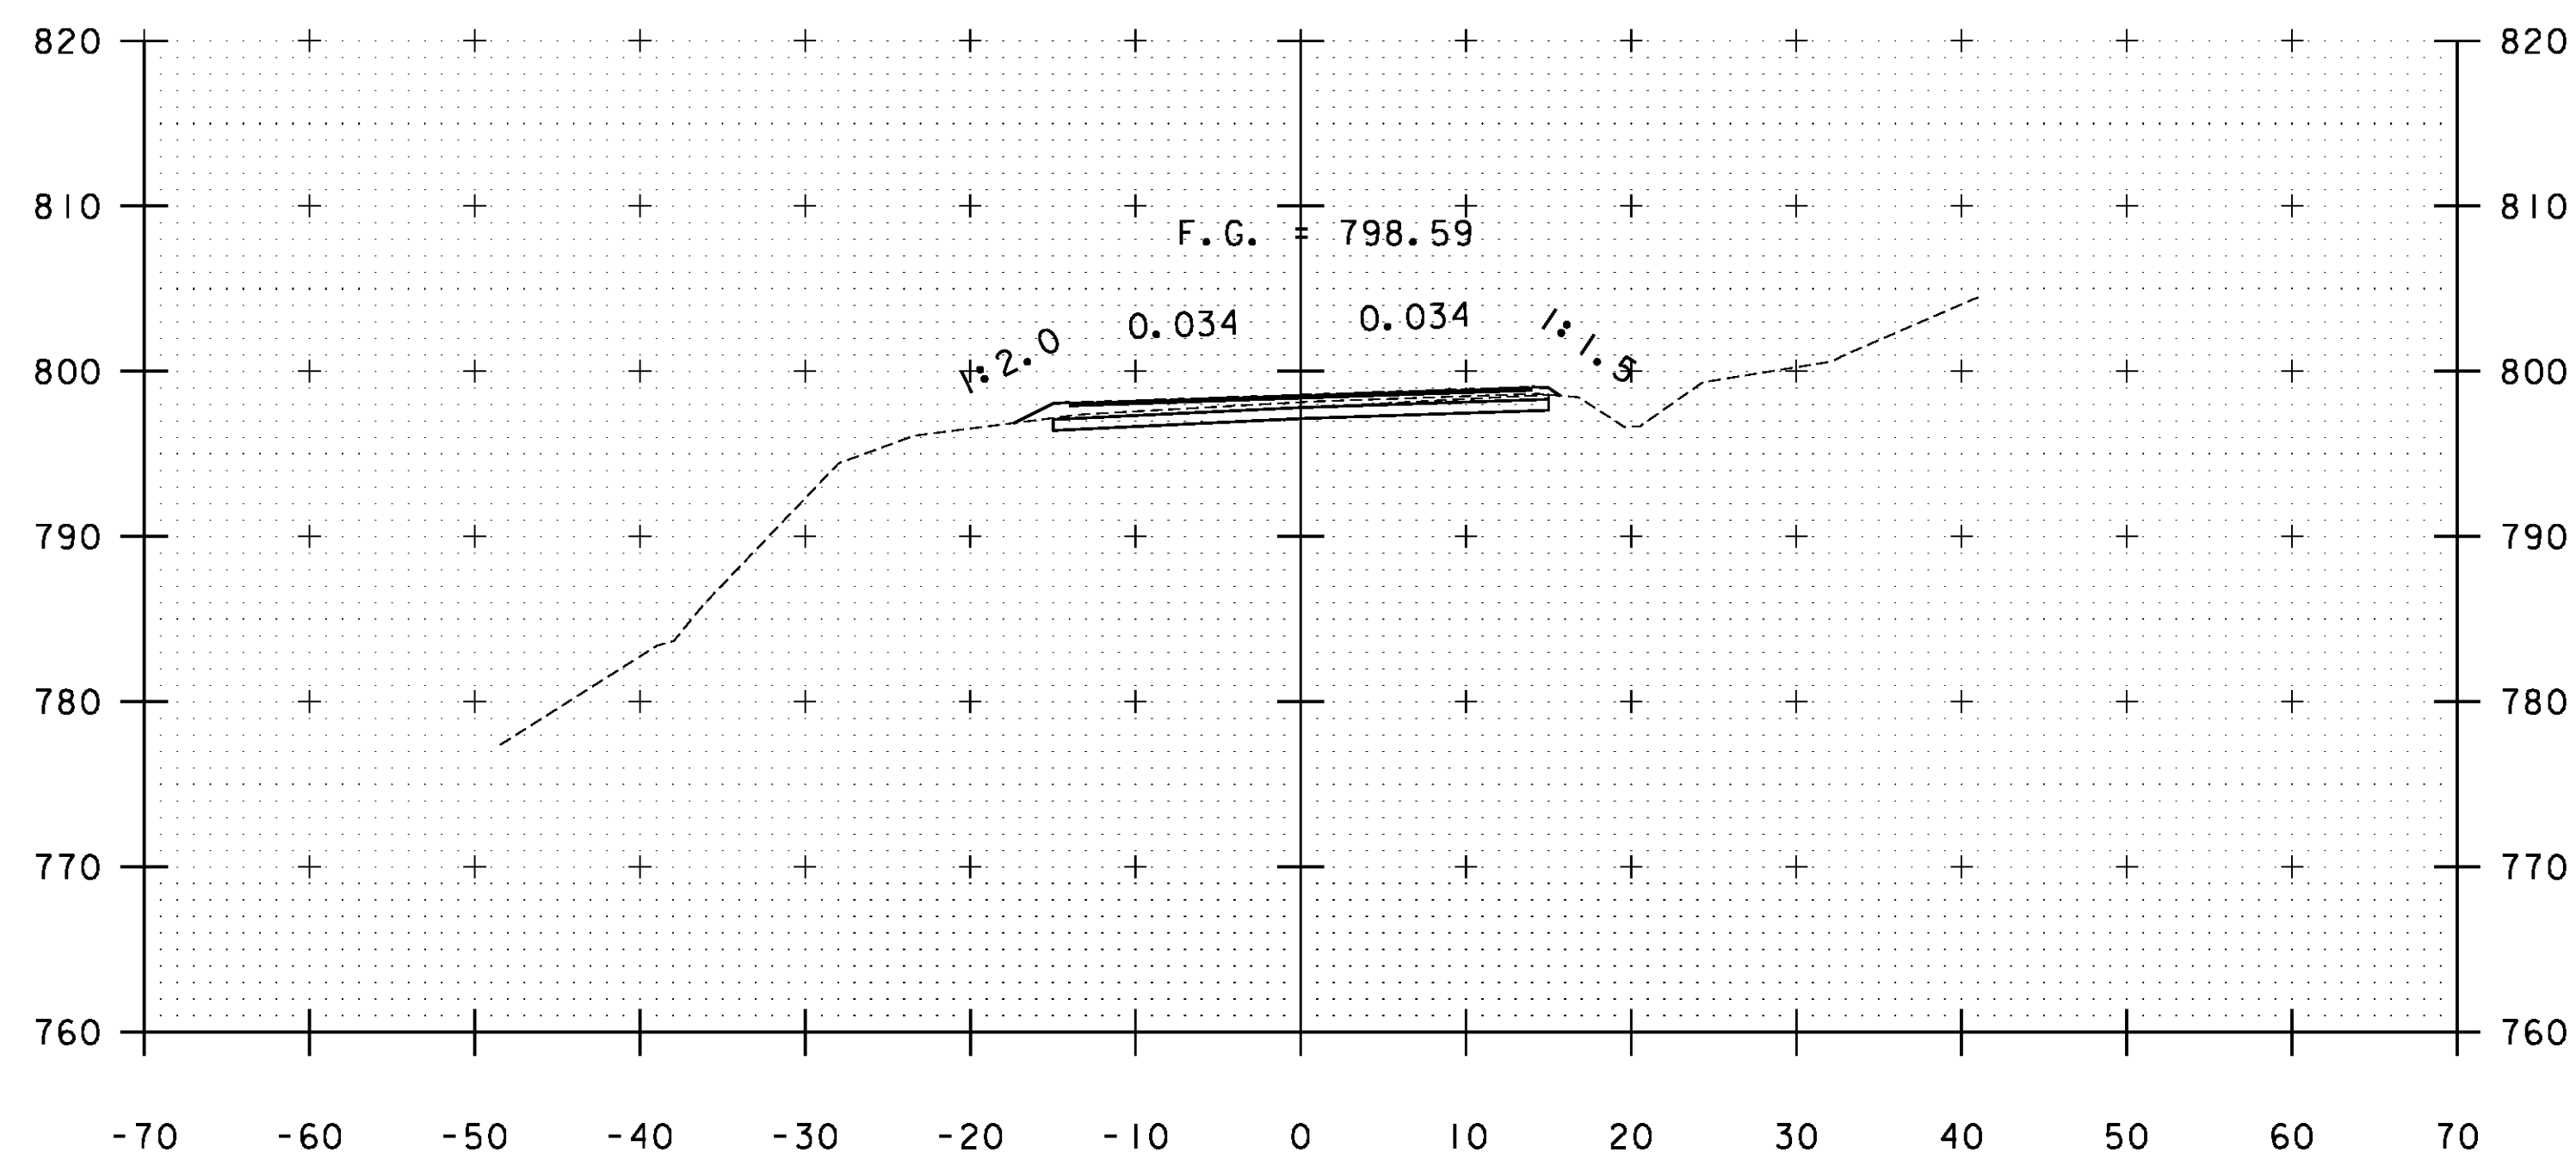

B 61+00

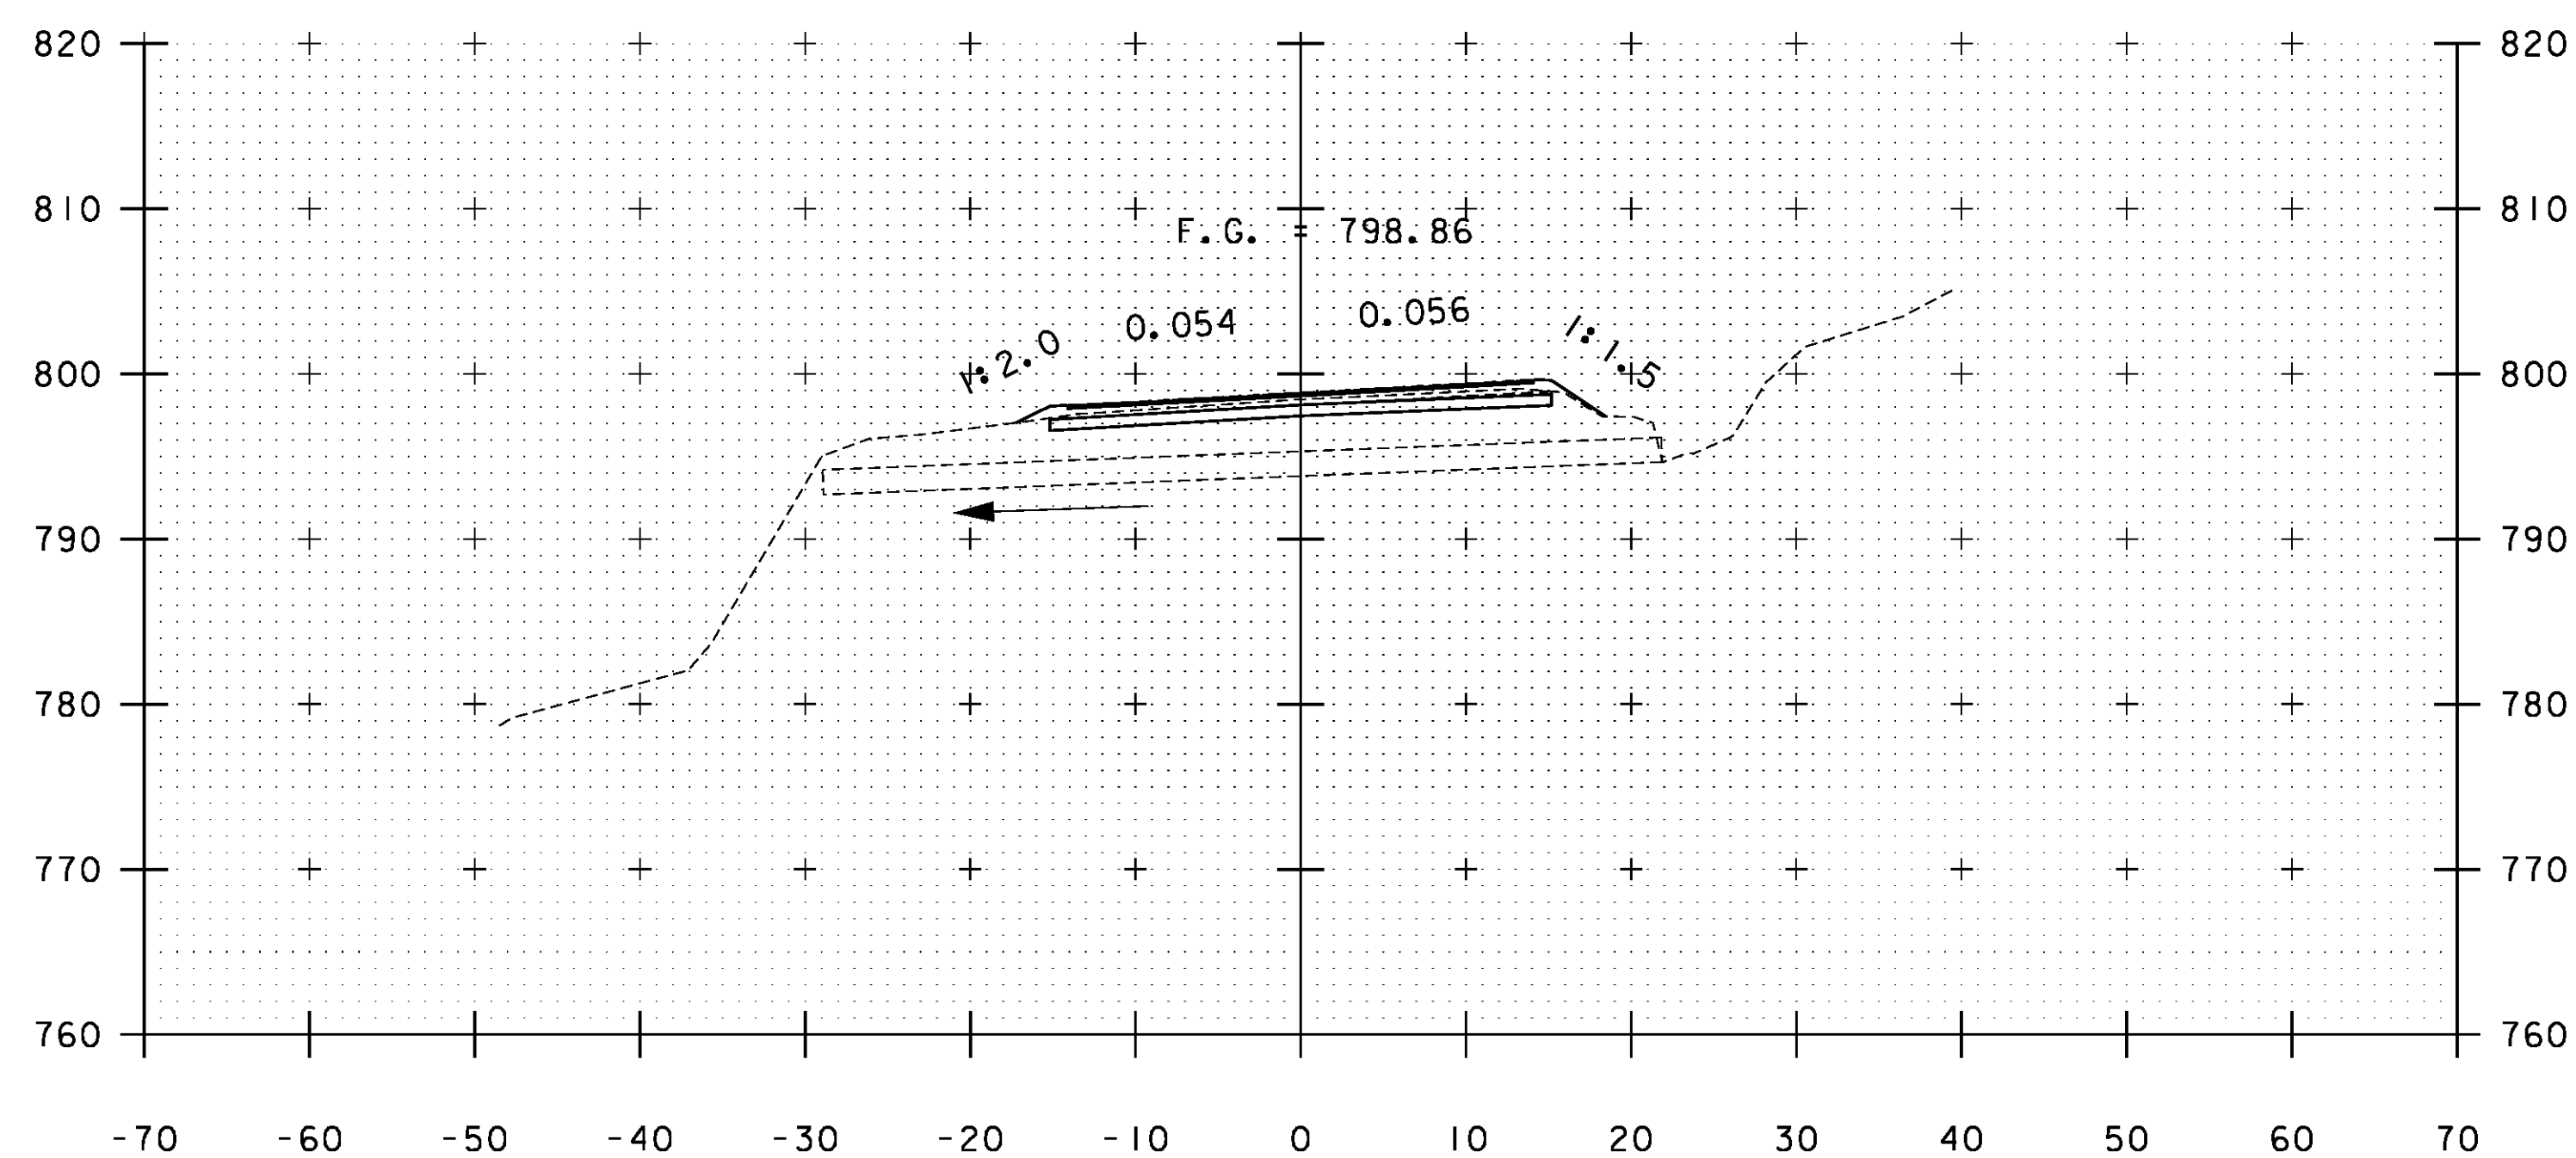

B 60+64

STA. B 60+00 TO STA. B 61+00

PROJECT NAME: WARDBORO-JAMAICA	PLOT DATE: 2/26/2014
PROJECT NUMBER: ER STP 013-K17	DRAWN BY: B. KIPP
FILE NAME: xs.dgn	CHECKED BY: HSD
PROJECT LEADER: K. UPMAL	SHEET 348 OF 444
DESIGNED BY: B. KIPP	
CROSS SECTIONS	