




B 67+00

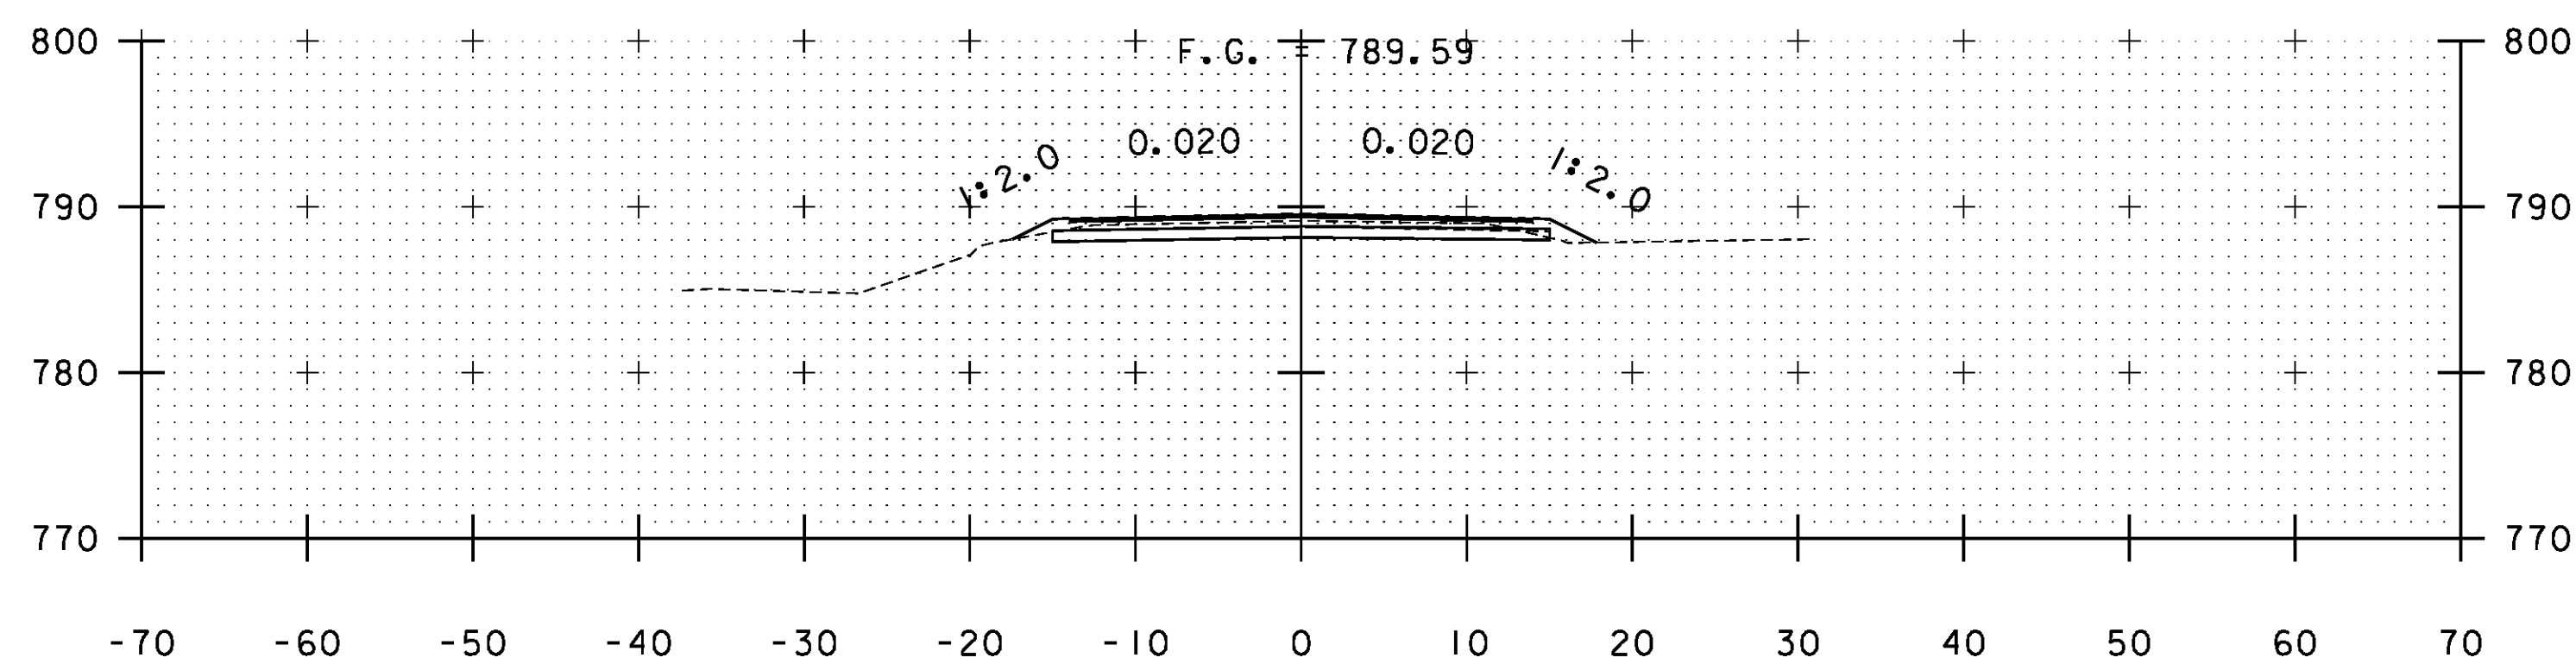


B 66+50

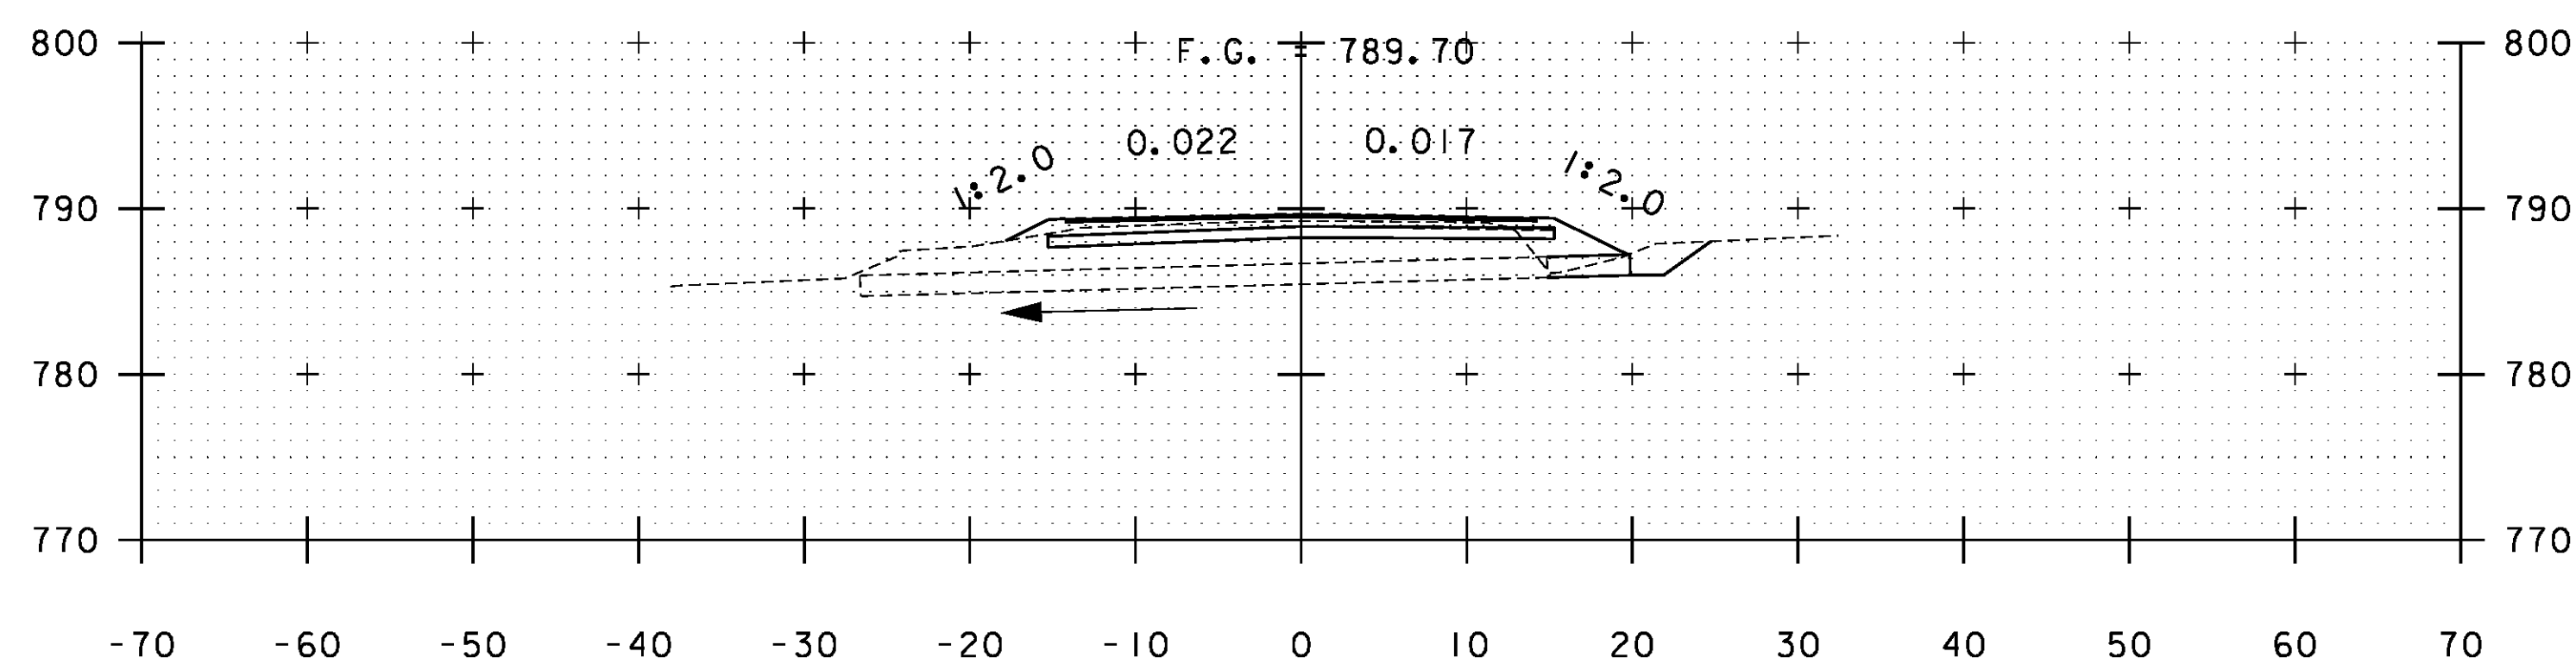


B 66+42

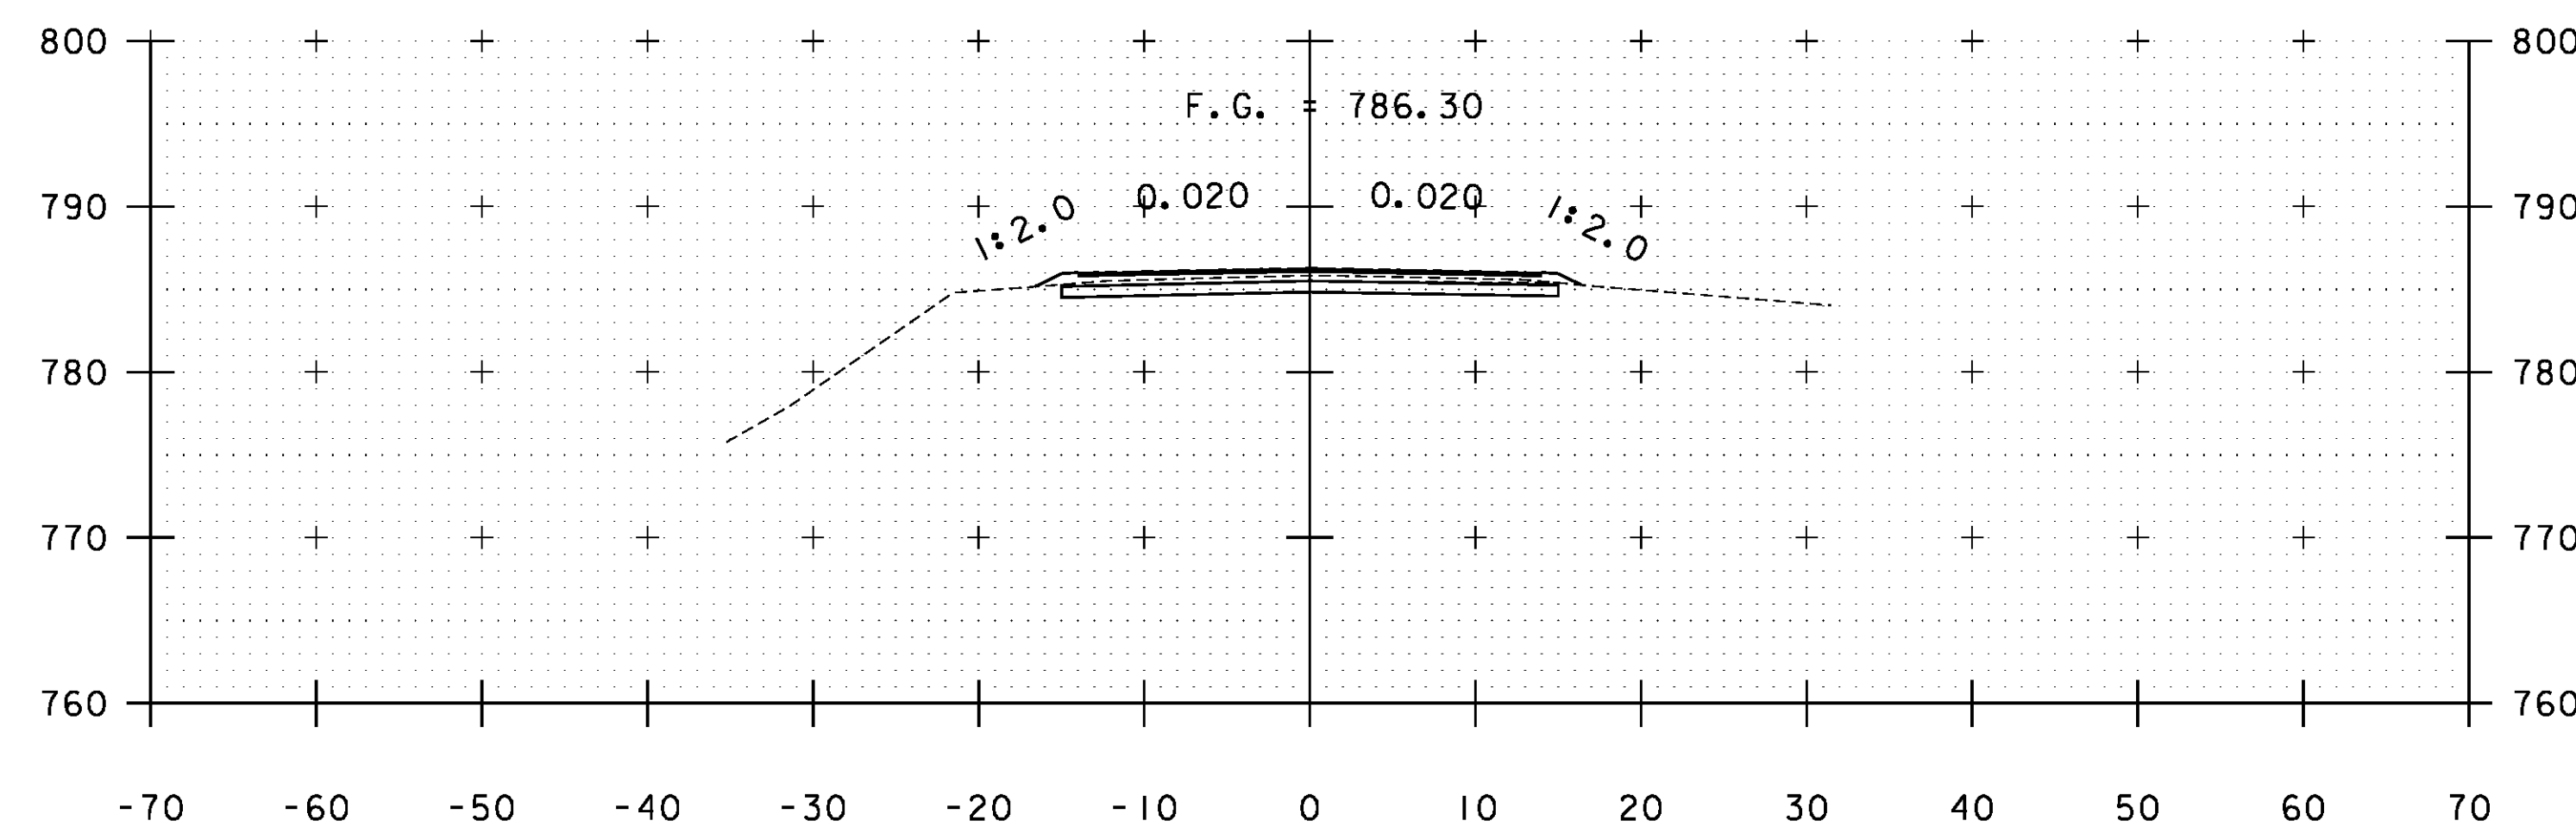

B 68+50

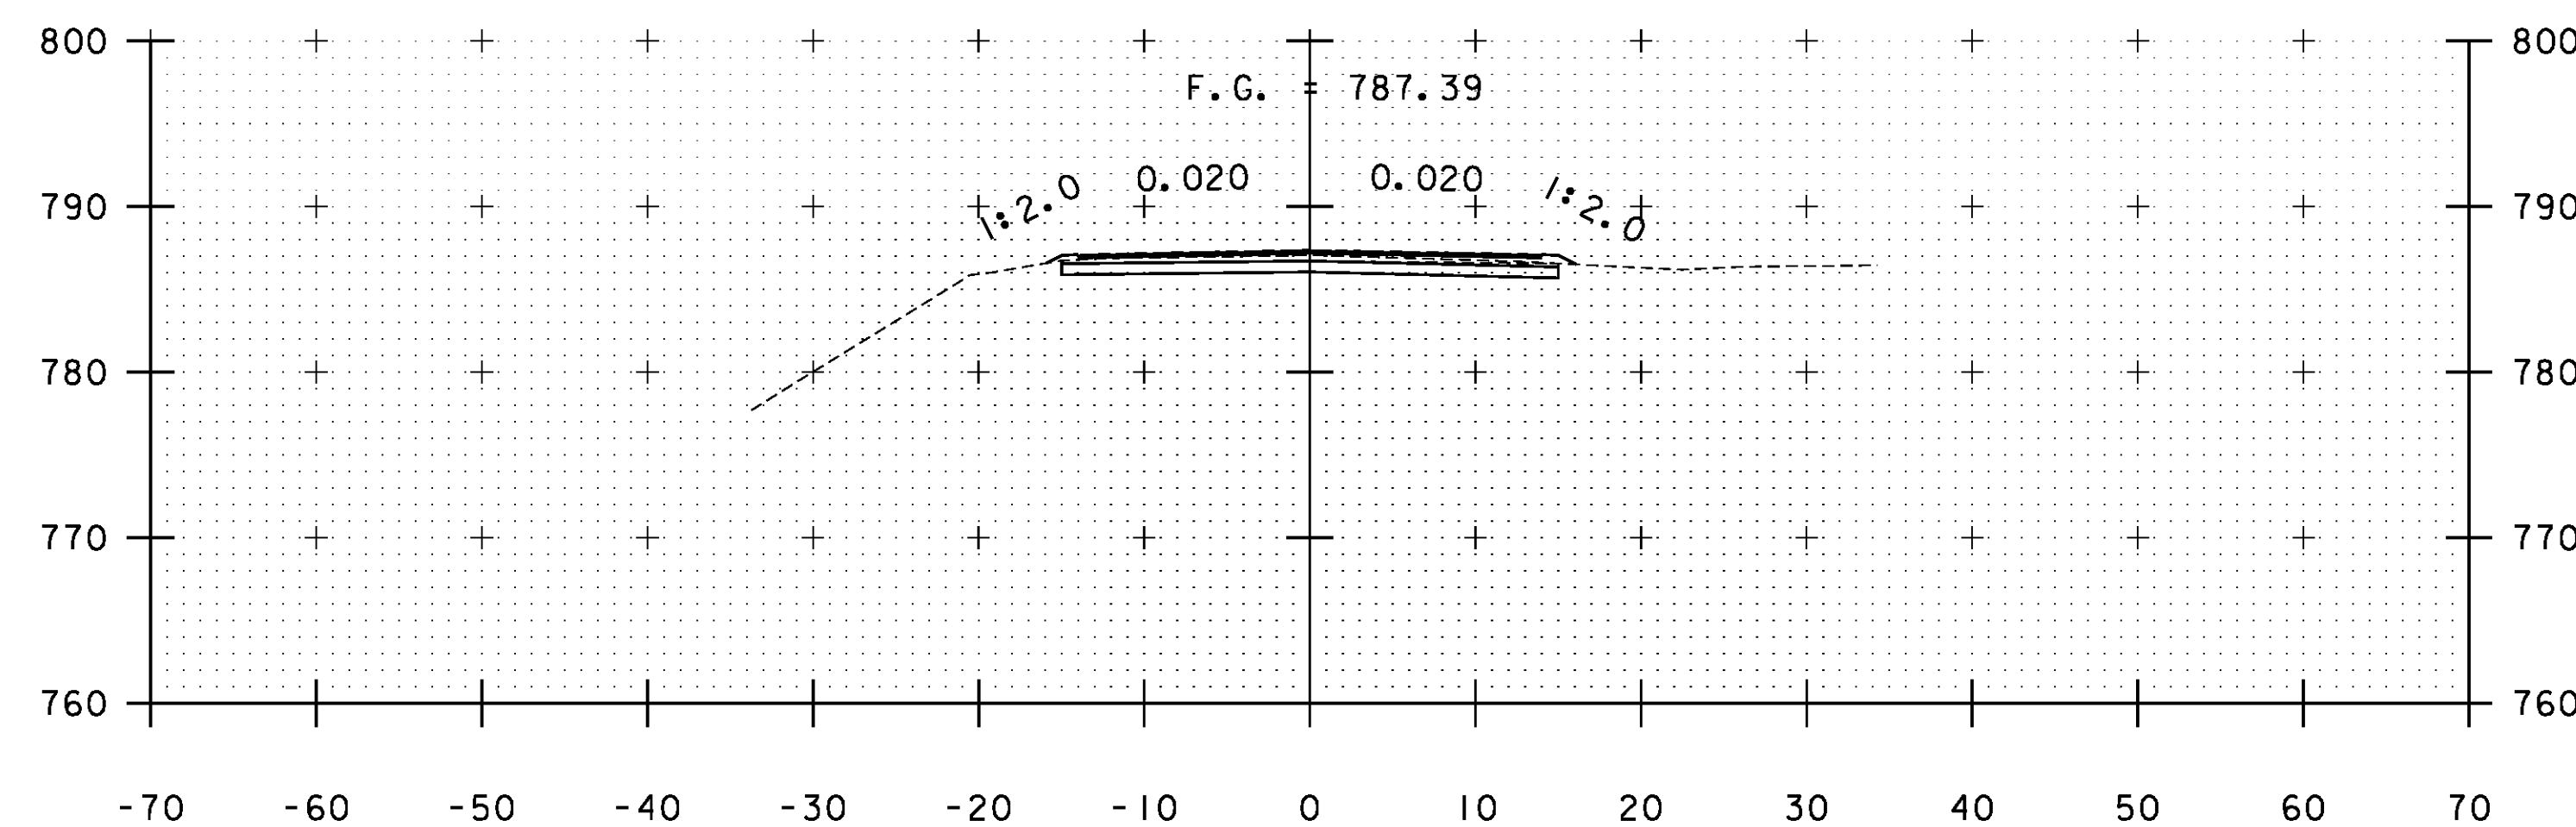

B 68+00

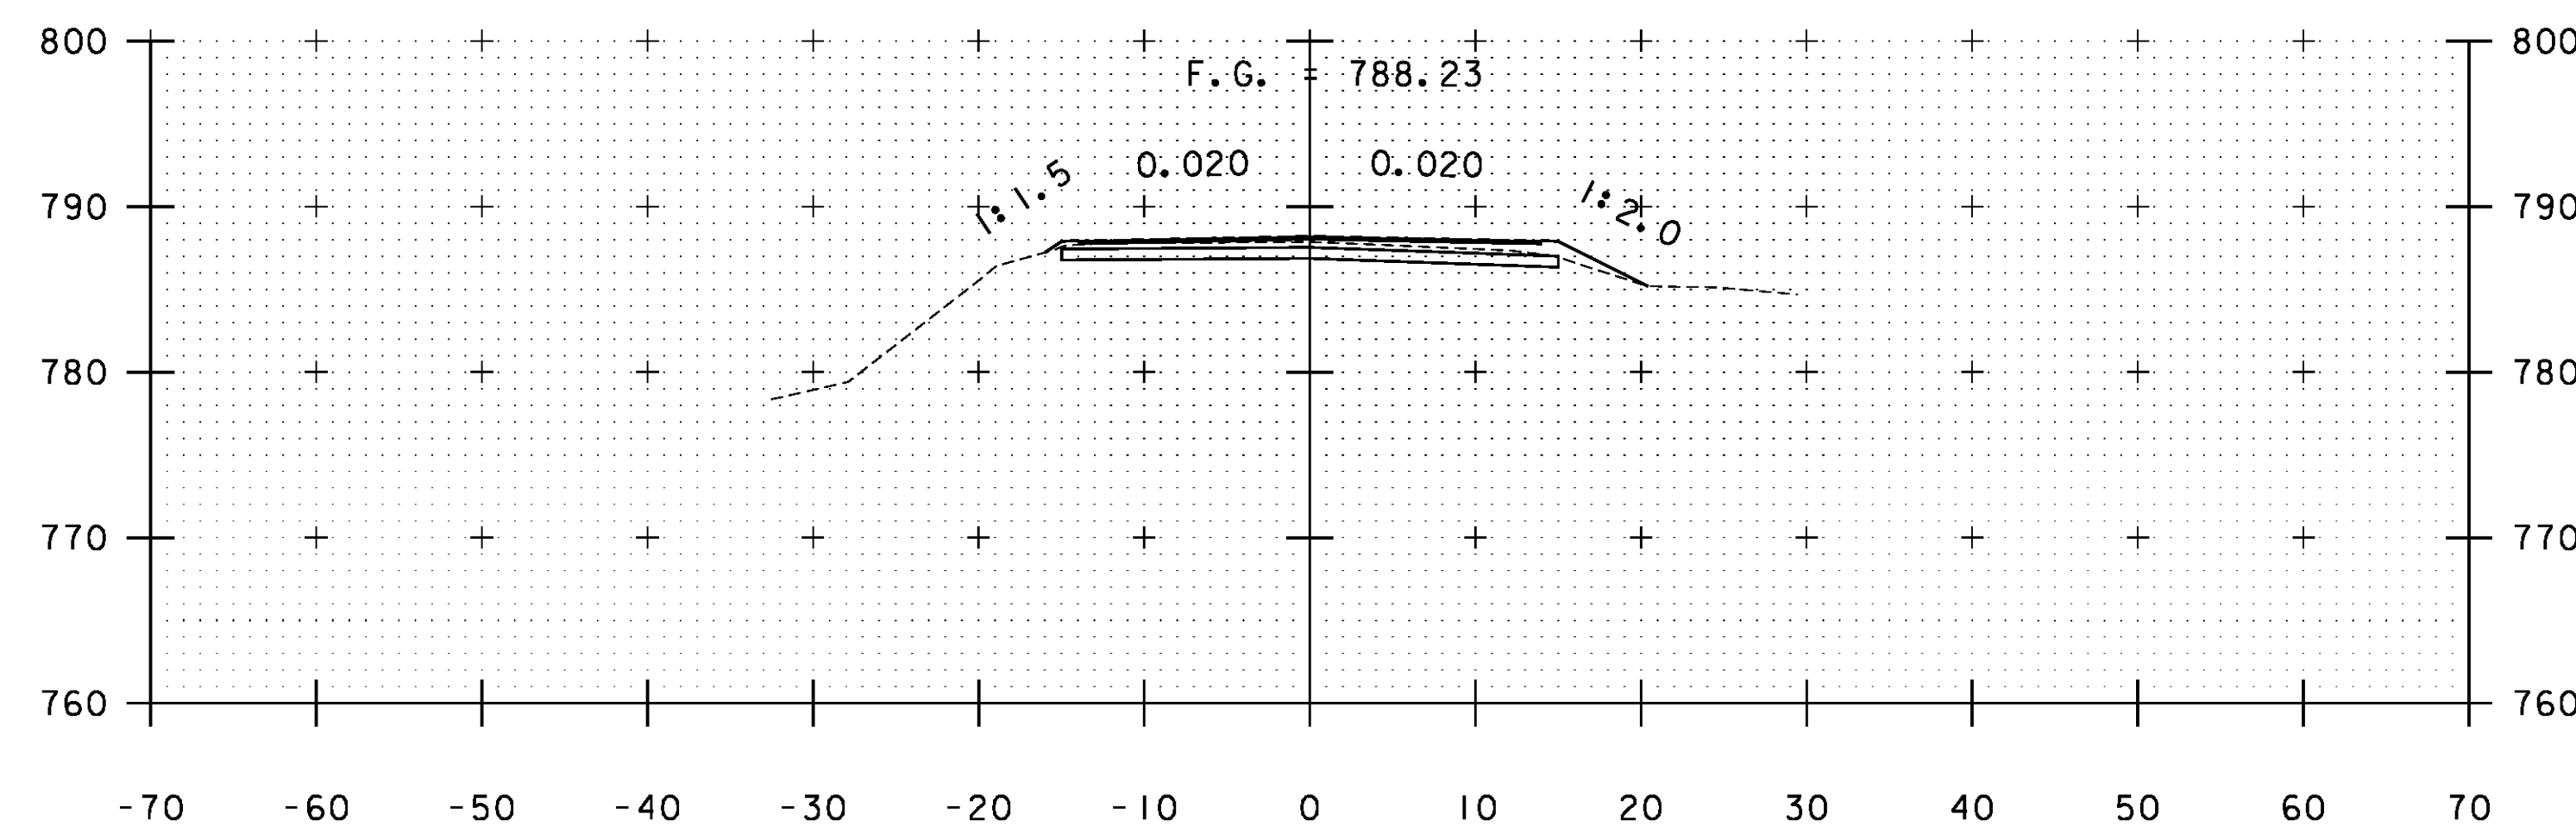

B 67+50

STA. B 66+42 TO STA. B 68+50

| | |
|----------------------------------|----------------------|
| PROJECT NAME: WARDBORO-JAMAICA | |
| PROJECT NUMBER: ER STP 013-1(17) | |
| FILE NAME: xs.dgn | PLOT DATE: 2/26/2014 |
| PROJECT LEADER: K. UPMAL | DRAWN BY: B. KIPP |
| DESIGNED BY: B. KIPP | CHECKED BY: HSD |
| CROSS SECTIONS | SHEET 351 OF 444 |