




B 78+50

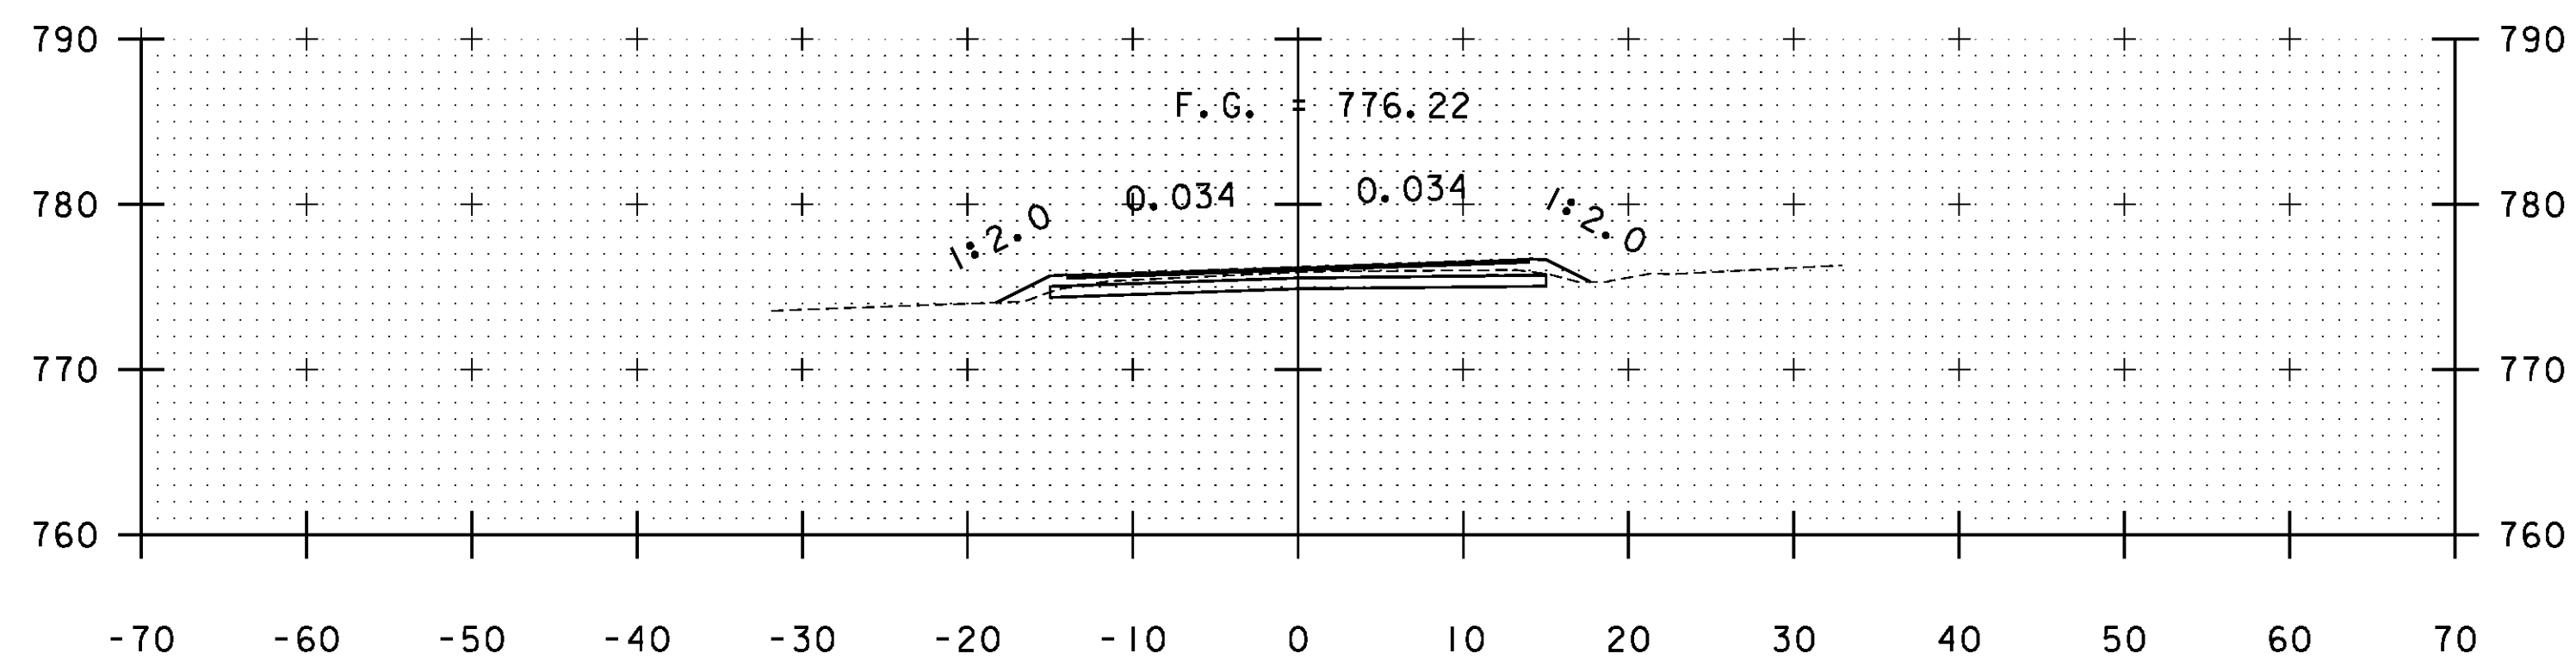


B 78+00

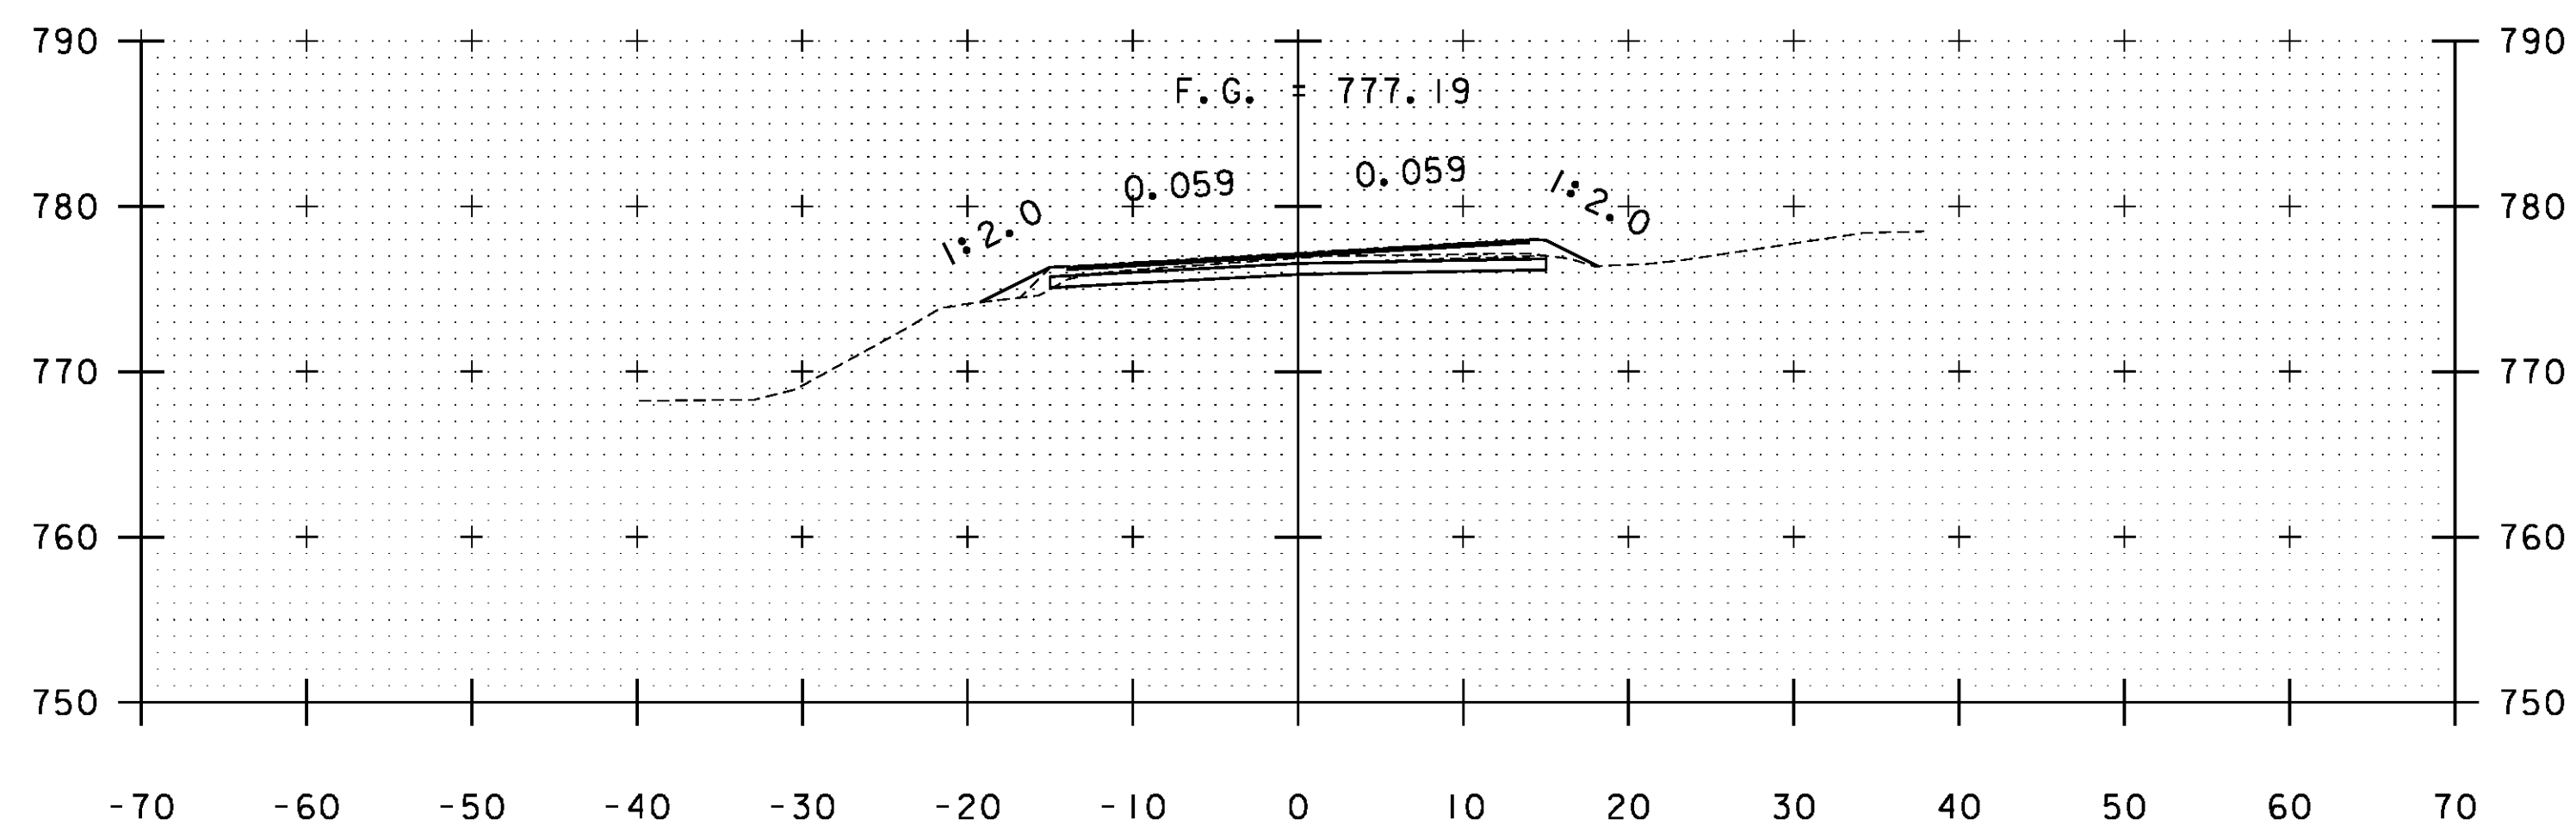


B 77+50

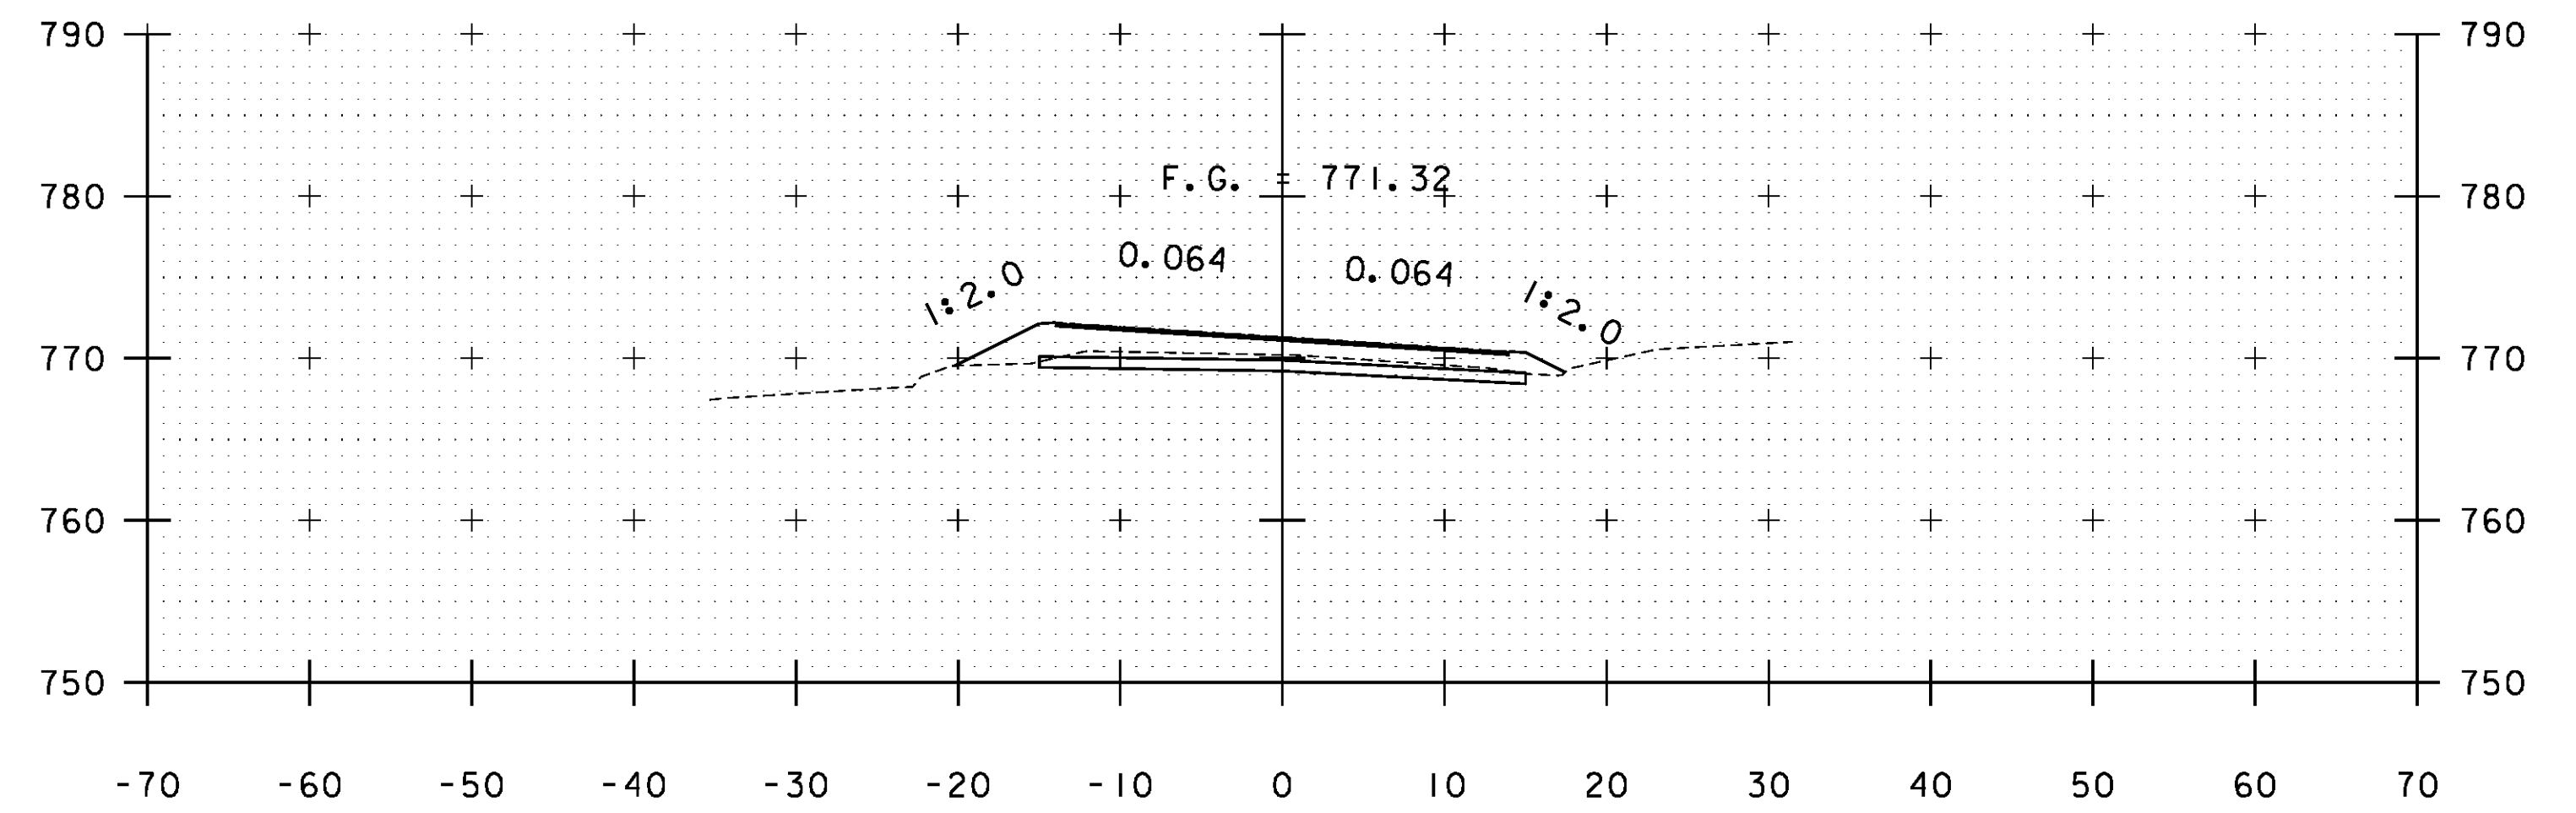

B 80+00

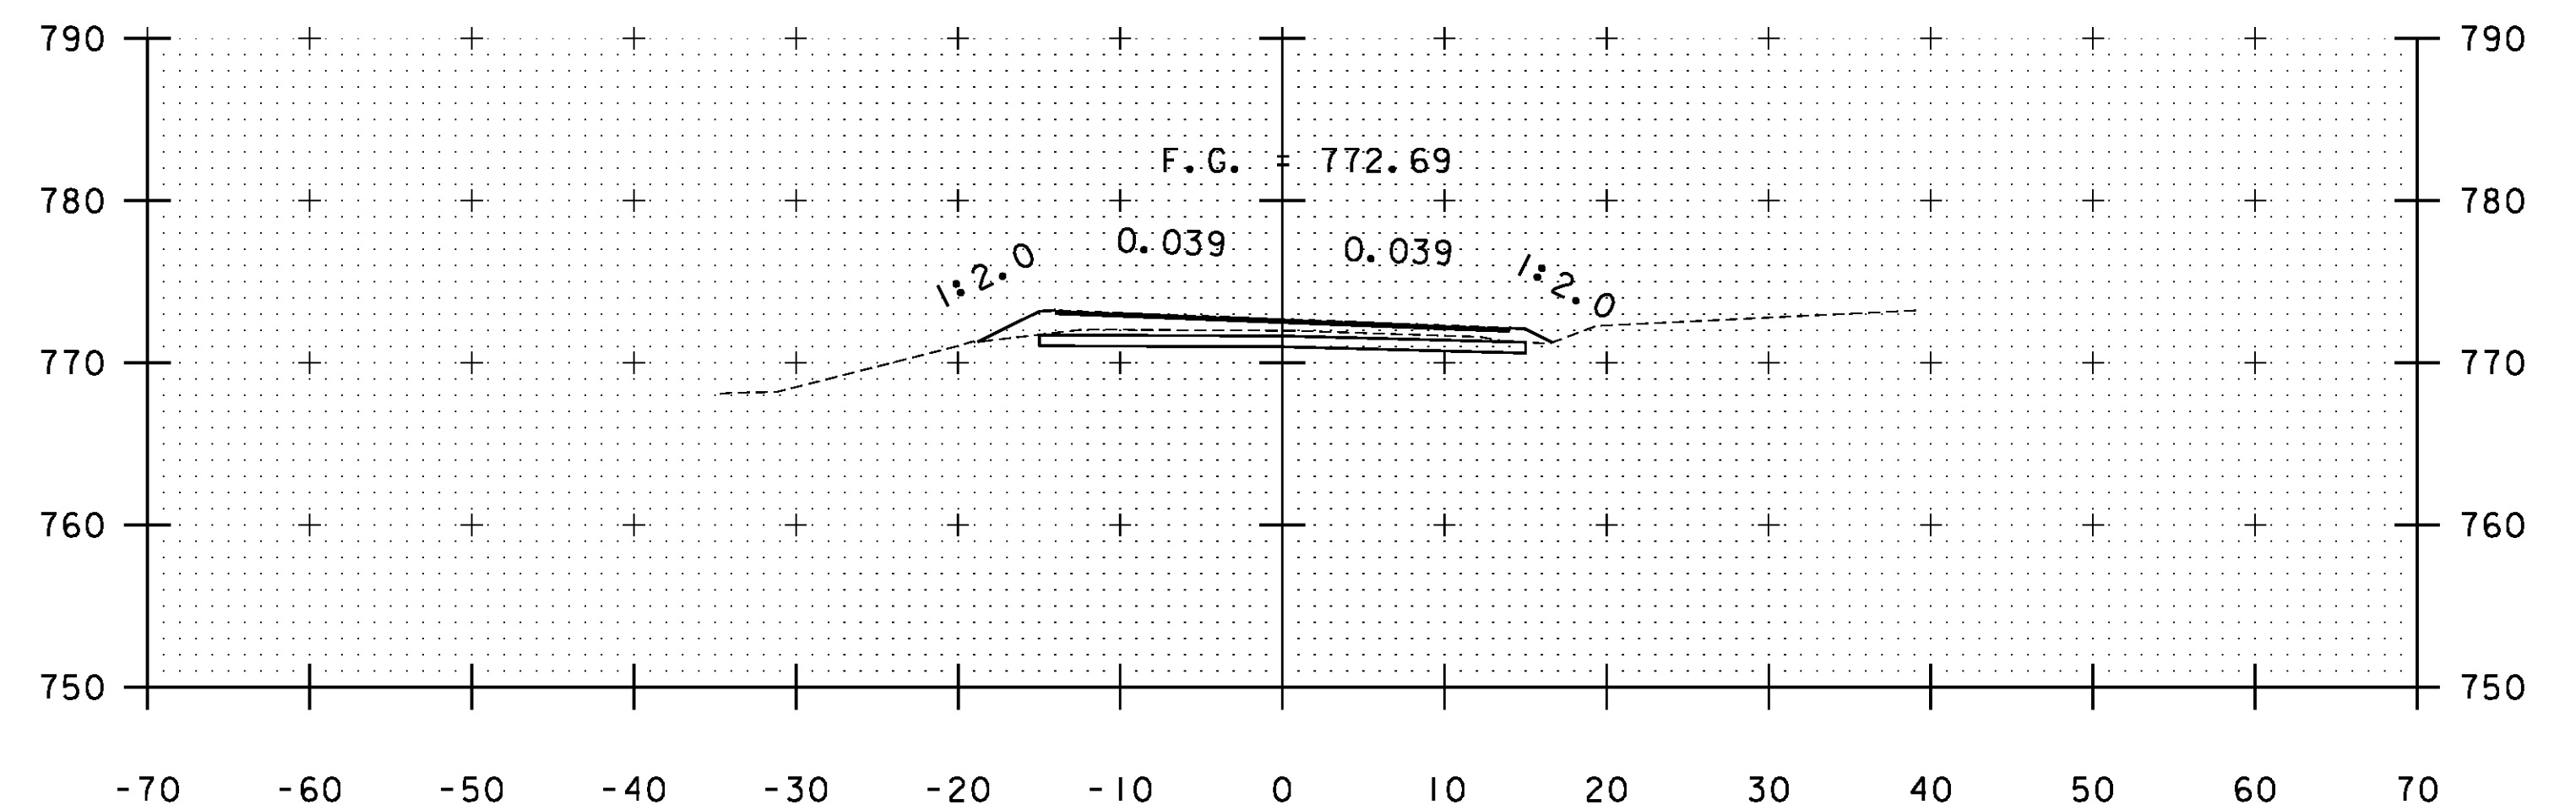

B 79+50

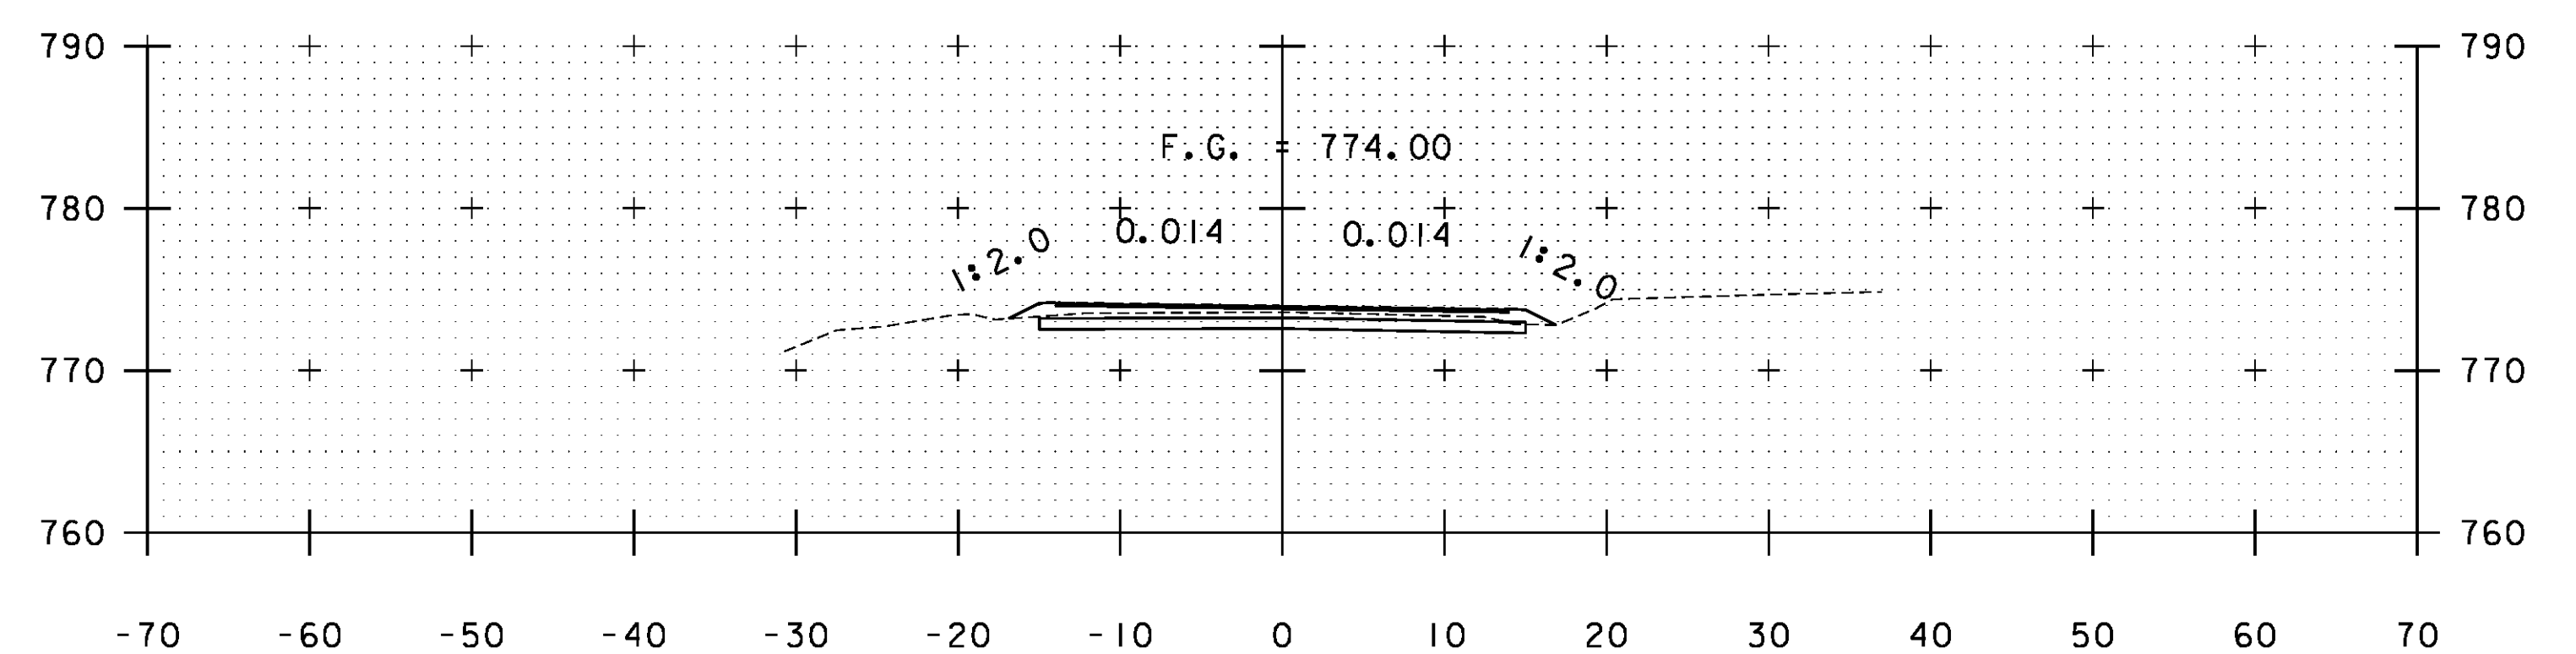

B 79+00

STA. B 77+50 TO STA. B 80+00

PROJECT NAME: WARDBORO-JAMAICA	
PROJECT NUMBER: ER STP 013-1(17)	
FILE NAME: xs.dgn	PLOT DATE: 2/26/2014
PROJECT LEADER: K. UPMAL	DRAWN BY: B. KIPP
DESIGNED BY: B. KIPP	CHECKED BY: HSD
CROSS SECTIONS	SHEET 356 OF 444