




B 89+50

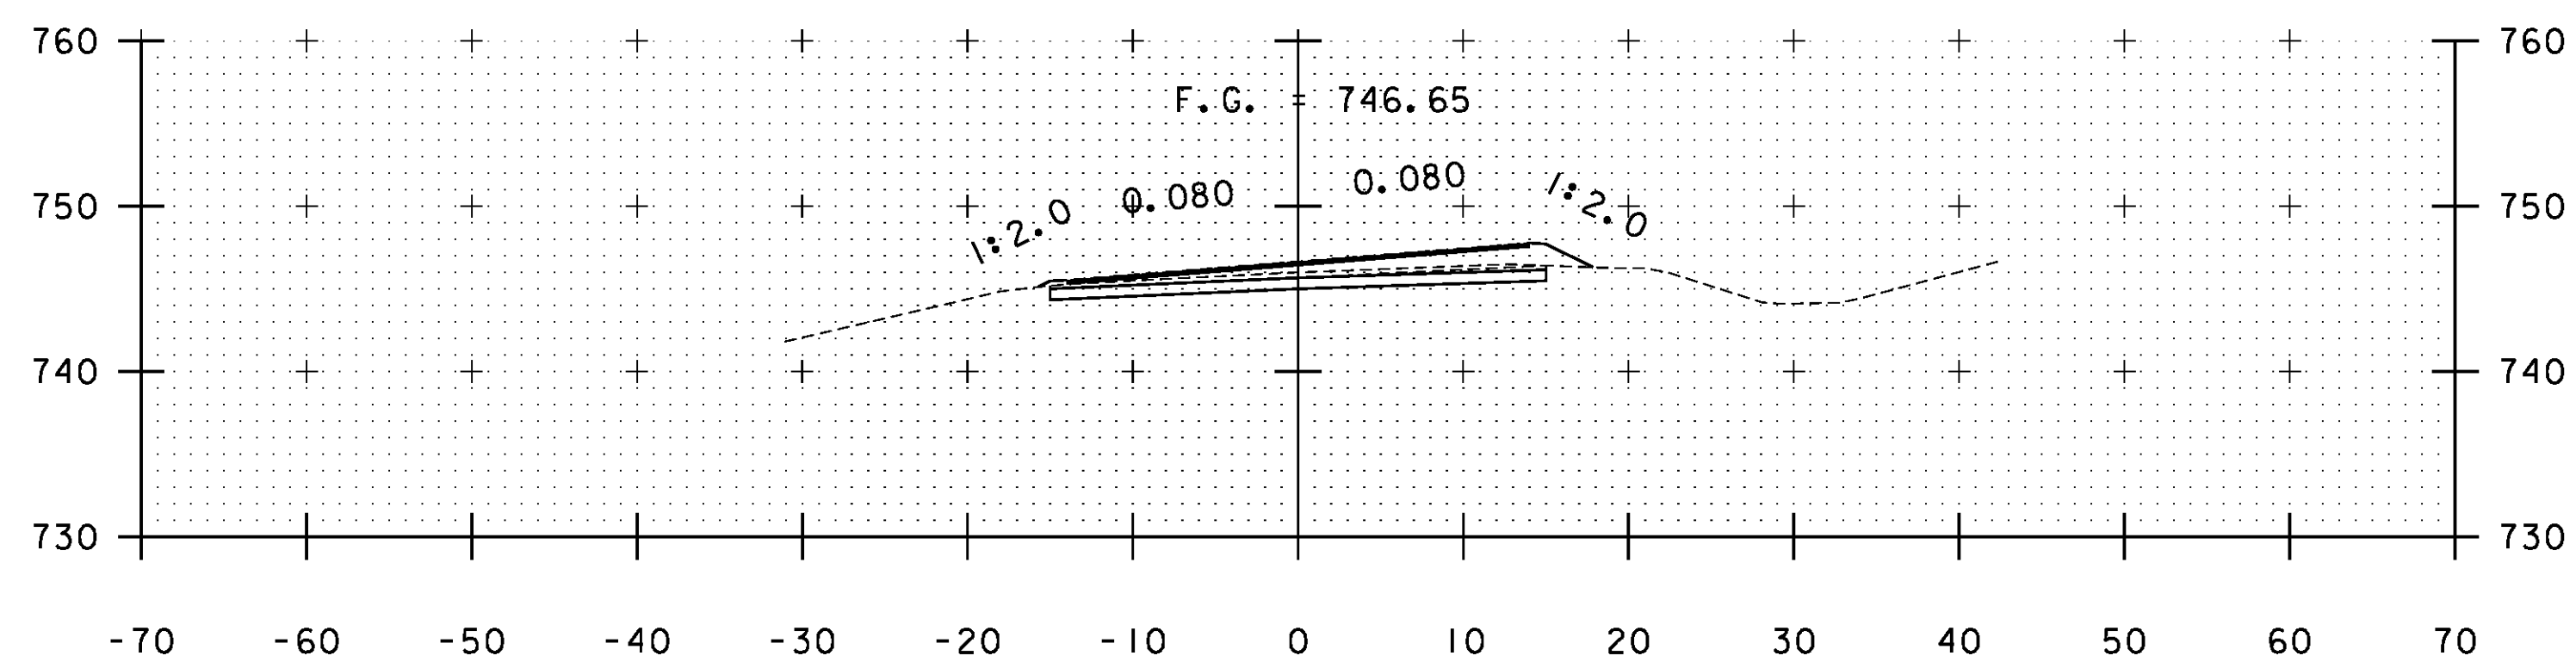


B 89+00

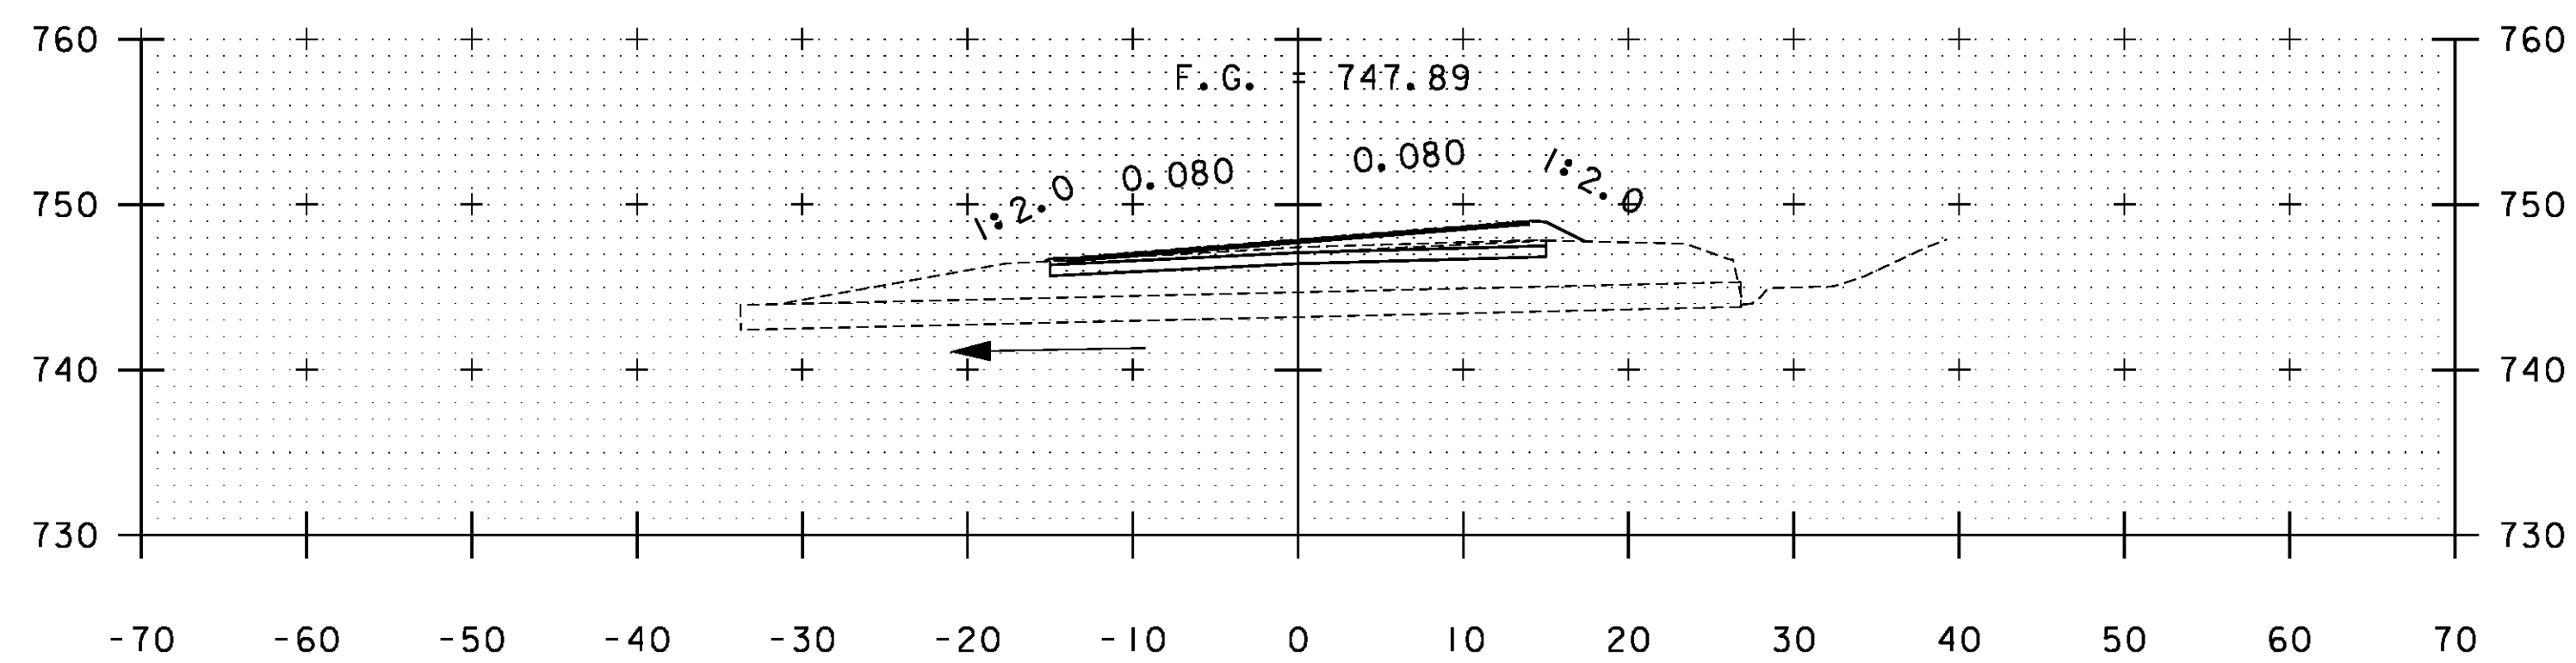


B 88+55

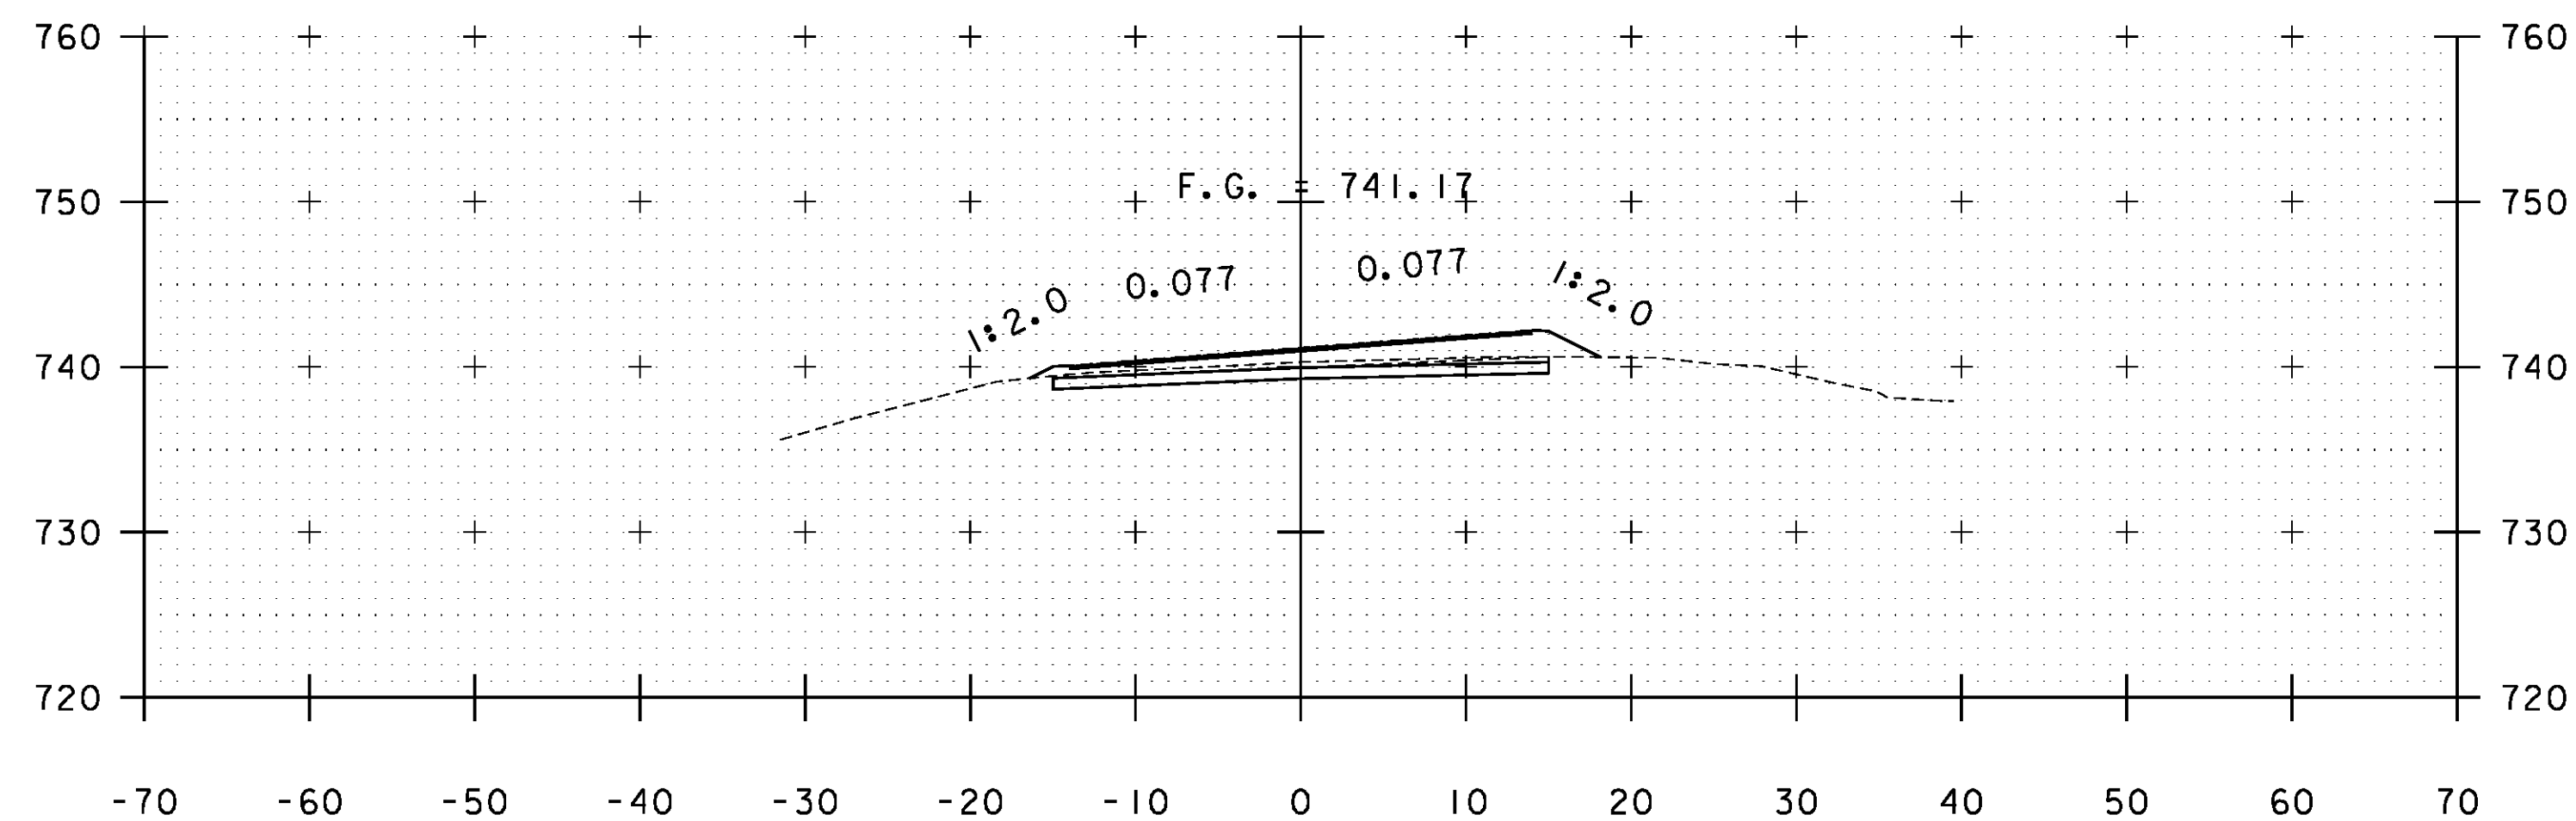

B 91+00

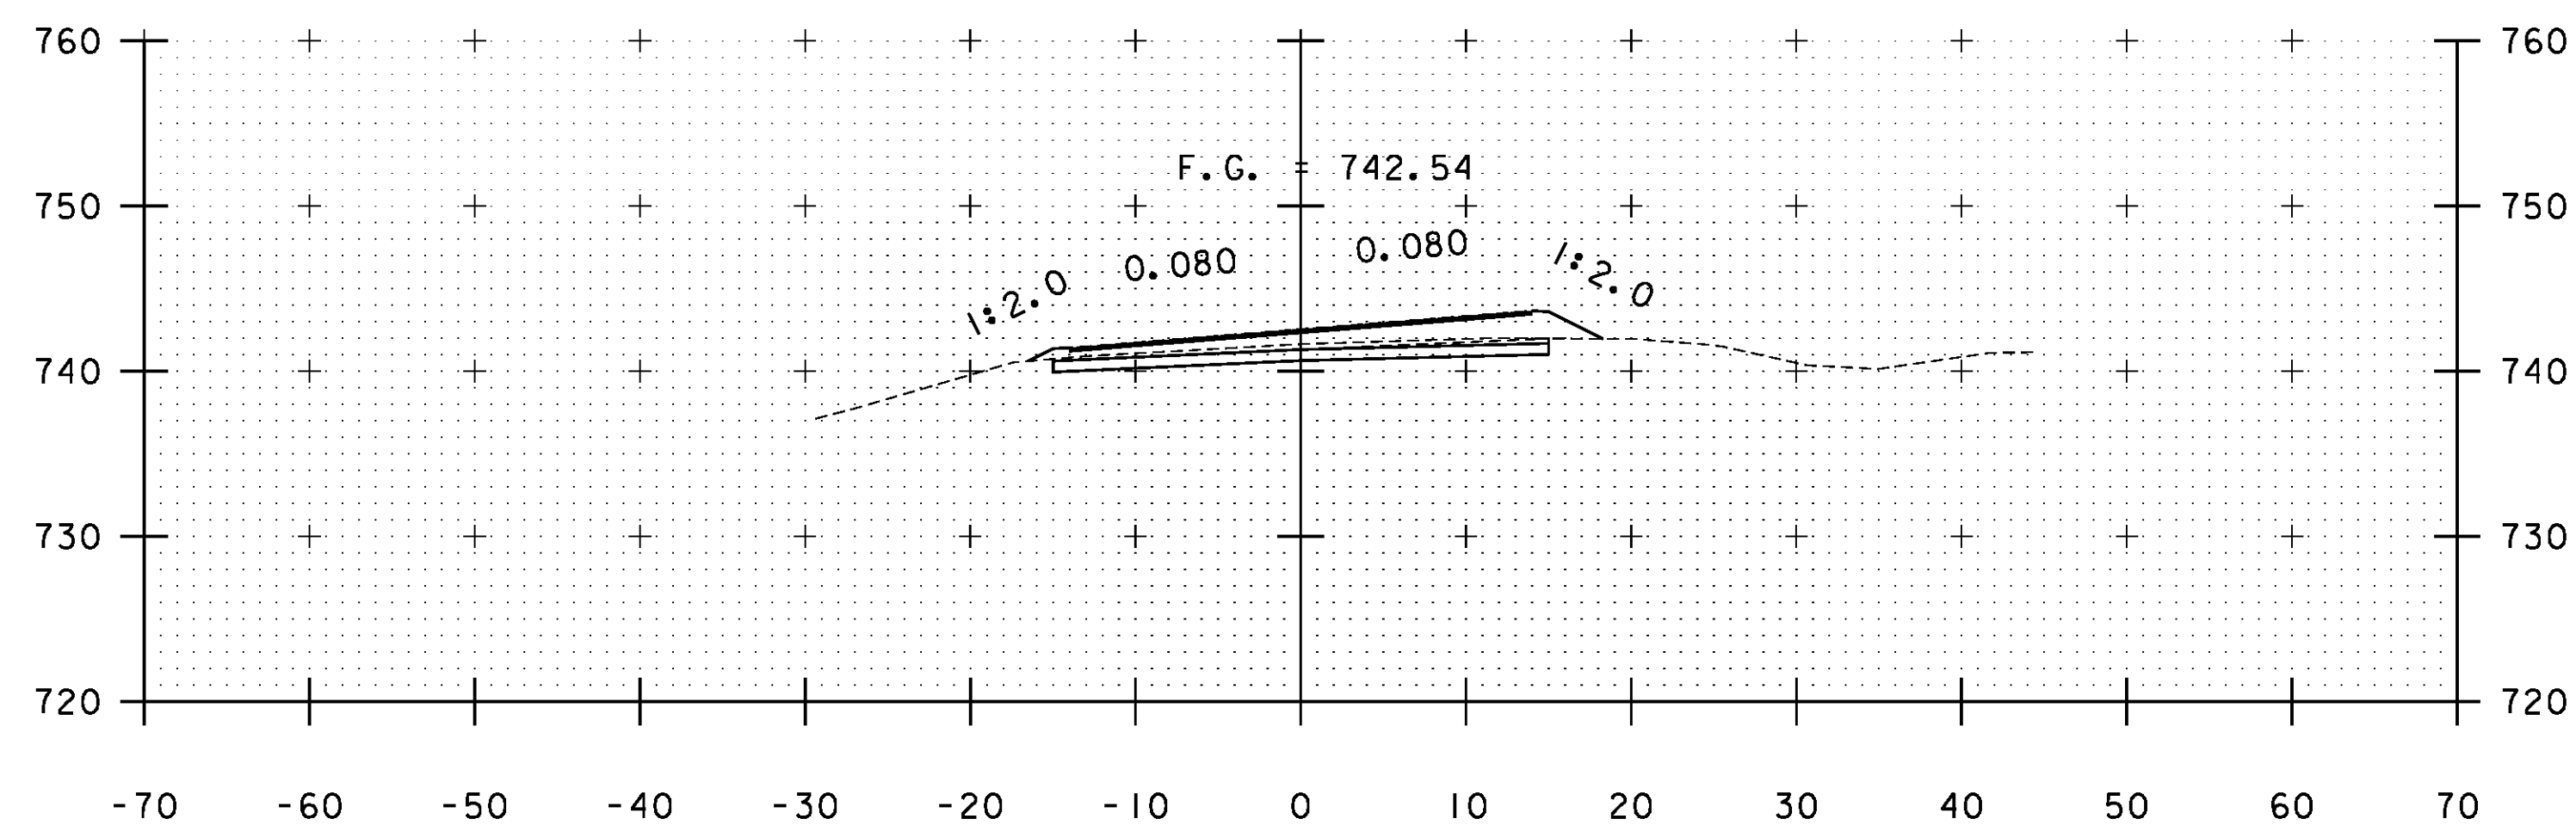

B 90+50

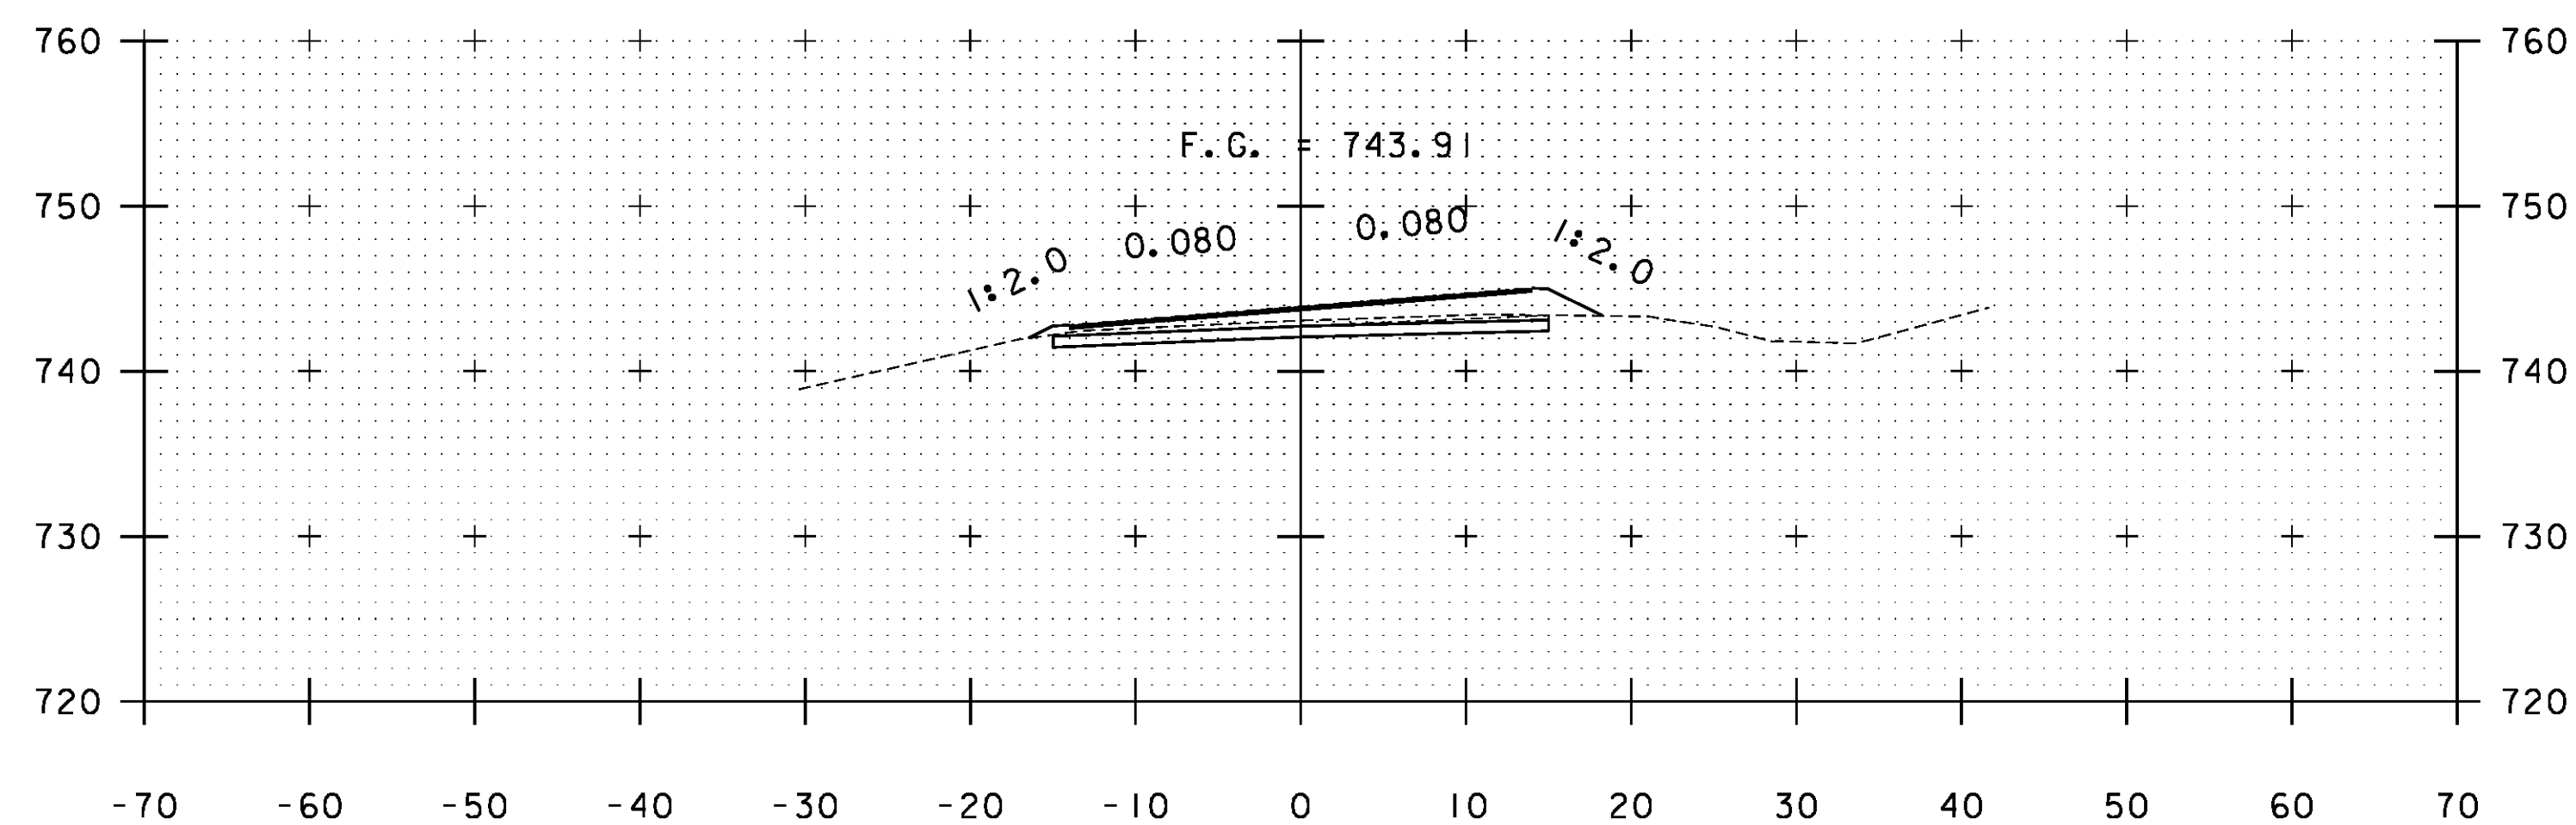

B 90+00

STA. B 88+55 TO STA. B 91+00

PROJECT NAME: WARDBORO-JAMAICA	PLOT DATE: 2/26/2014
PROJECT NUMBER: ER STP 013-1(17)	DRAWN BY: B. KIPP
FILE NAME: xs.dgn	CHECKED BY: HSD
PROJECT LEADER: K. UPMAL	SHEET 360 OF 444
DESIGNED BY: B. KIPP	
CROSS SECTIONS	