




B 92+00

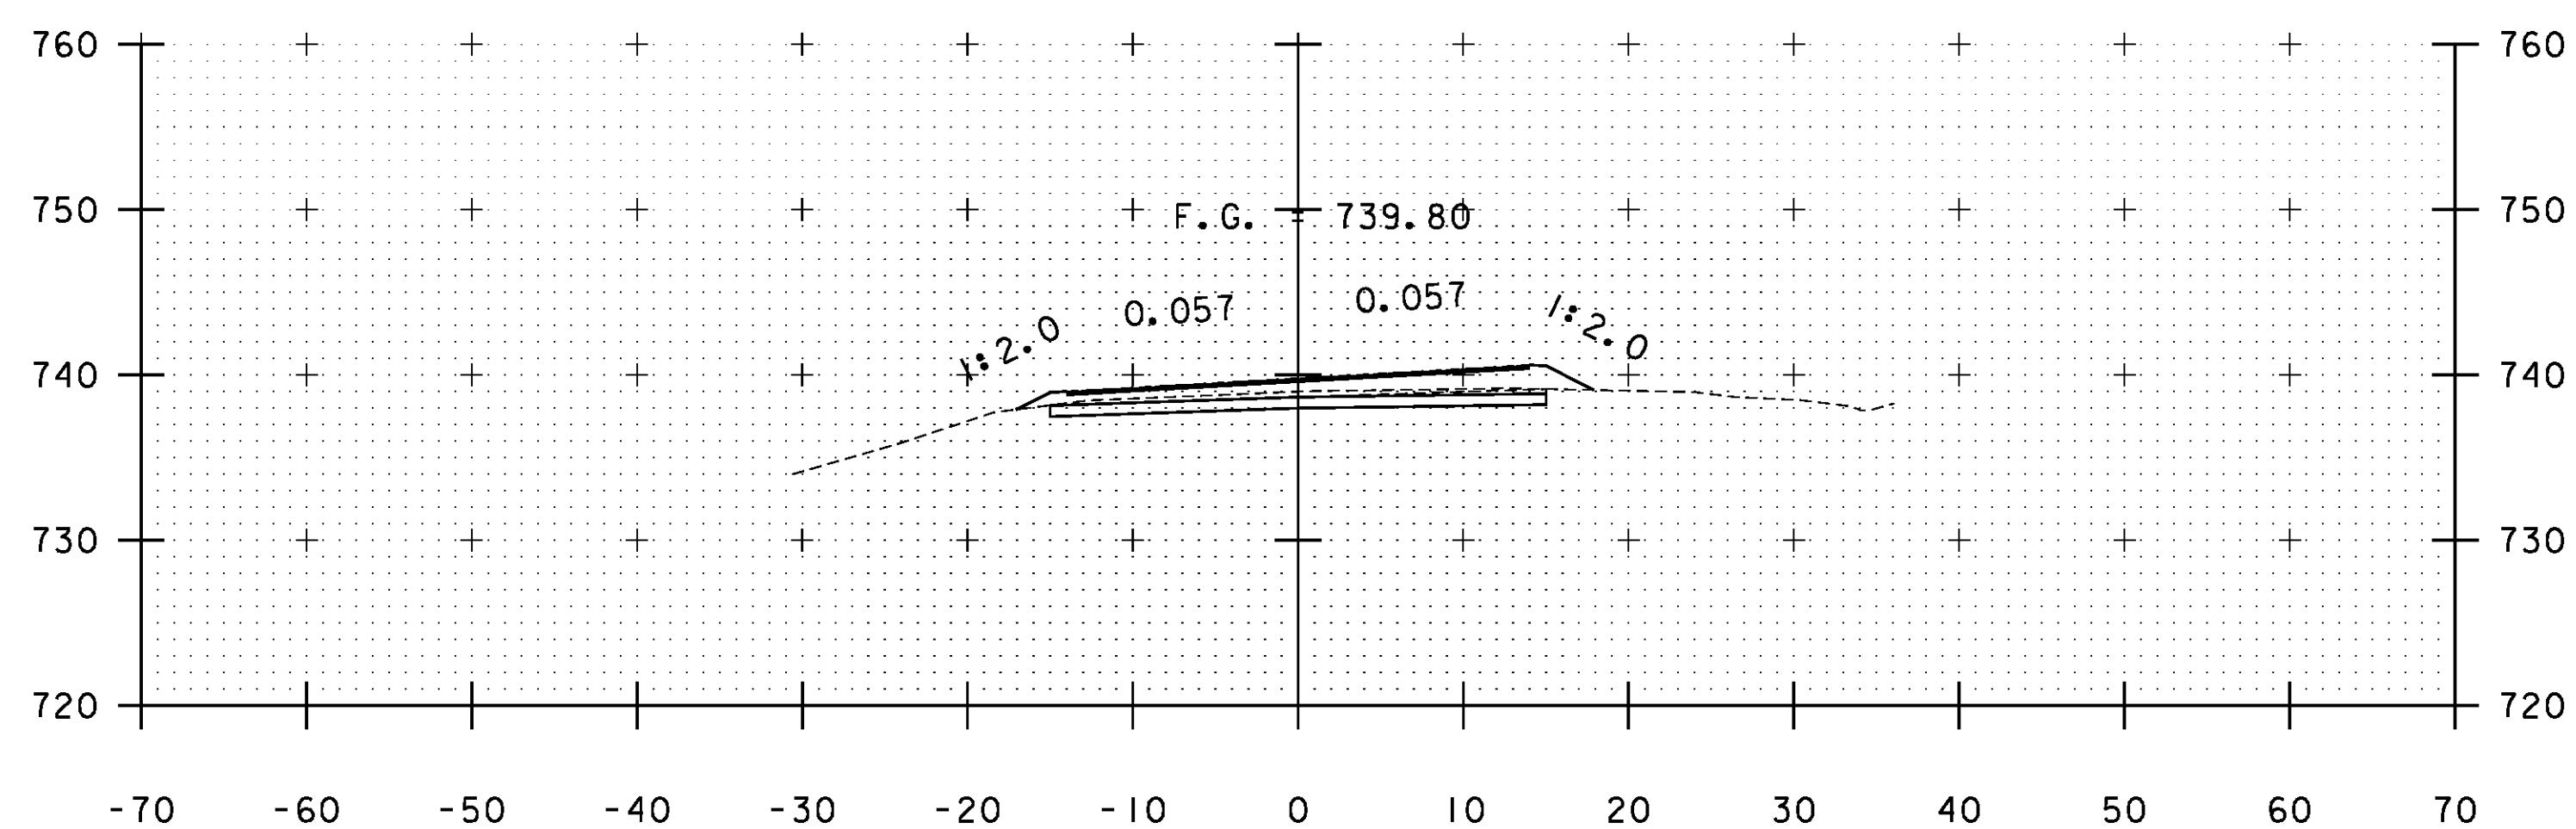


B 91+50

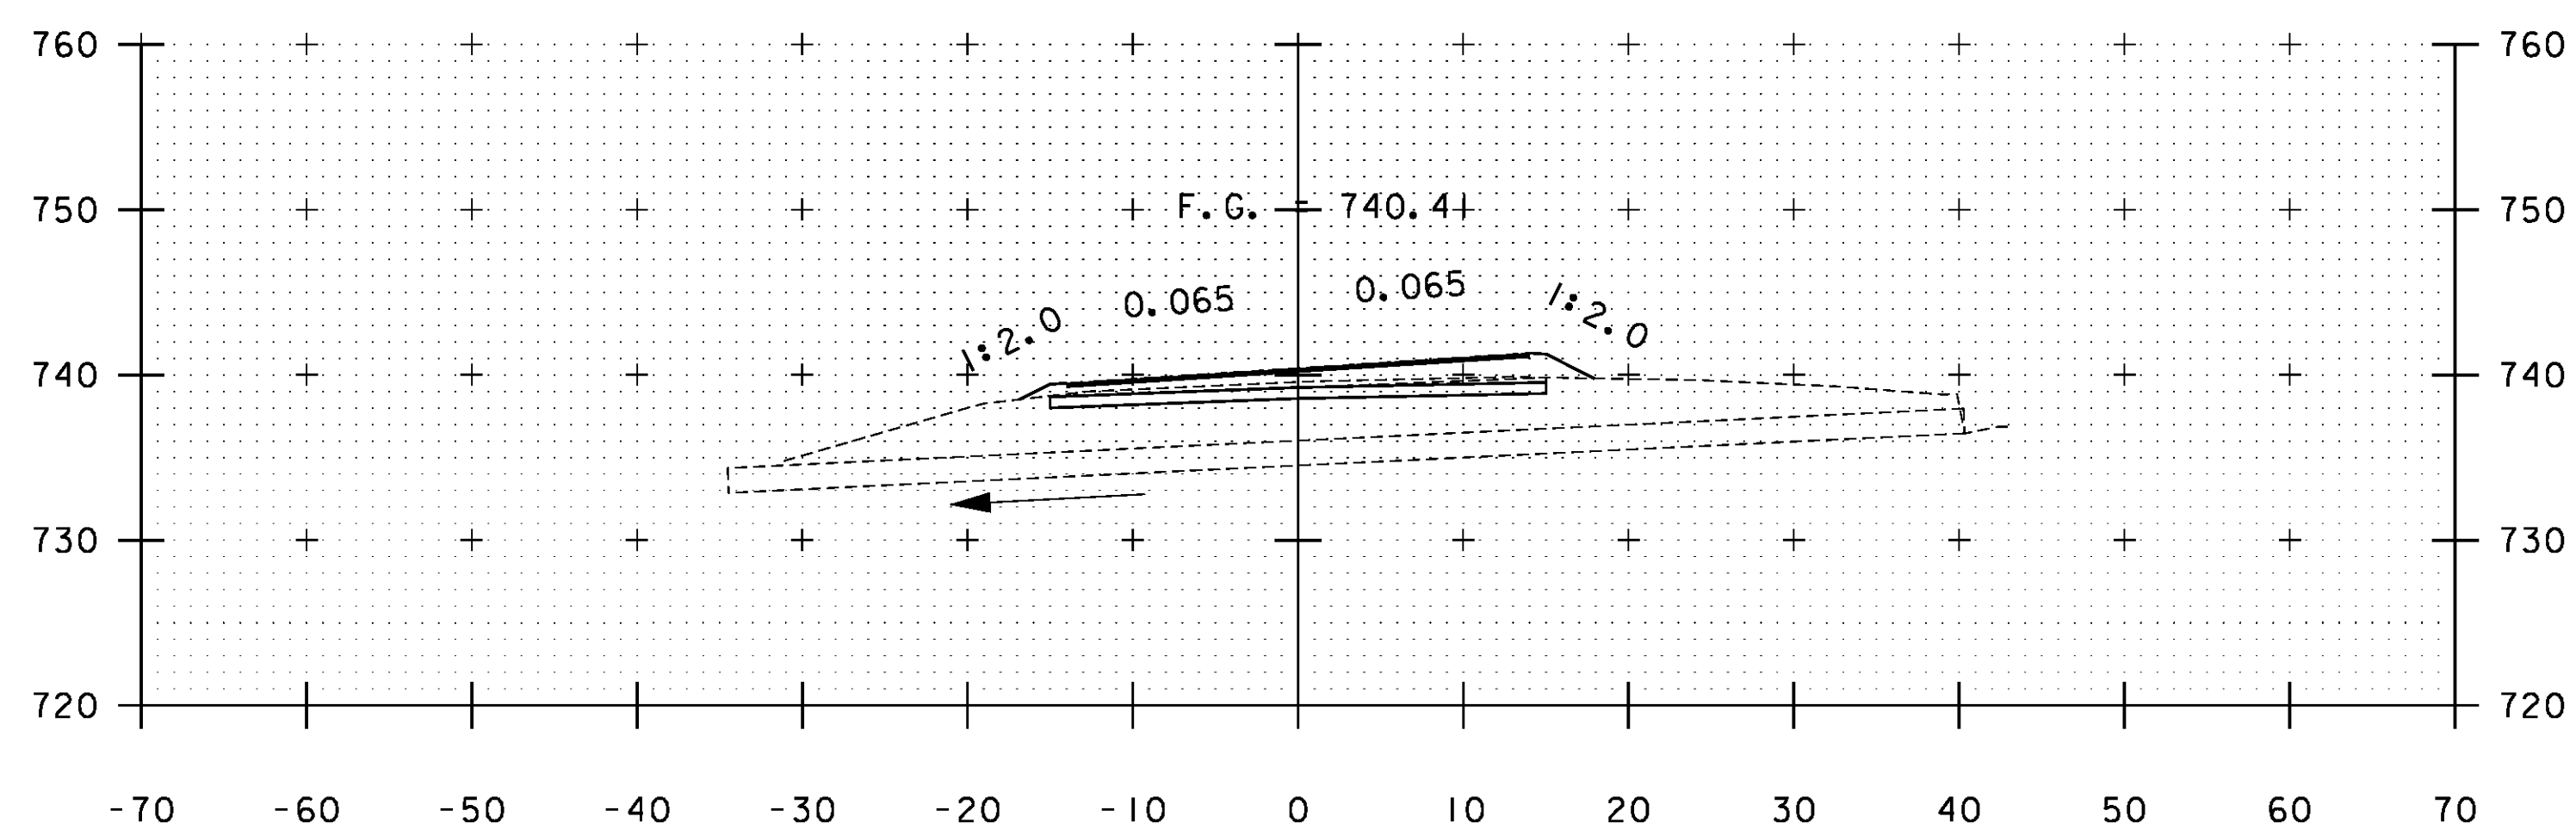


B 91+28

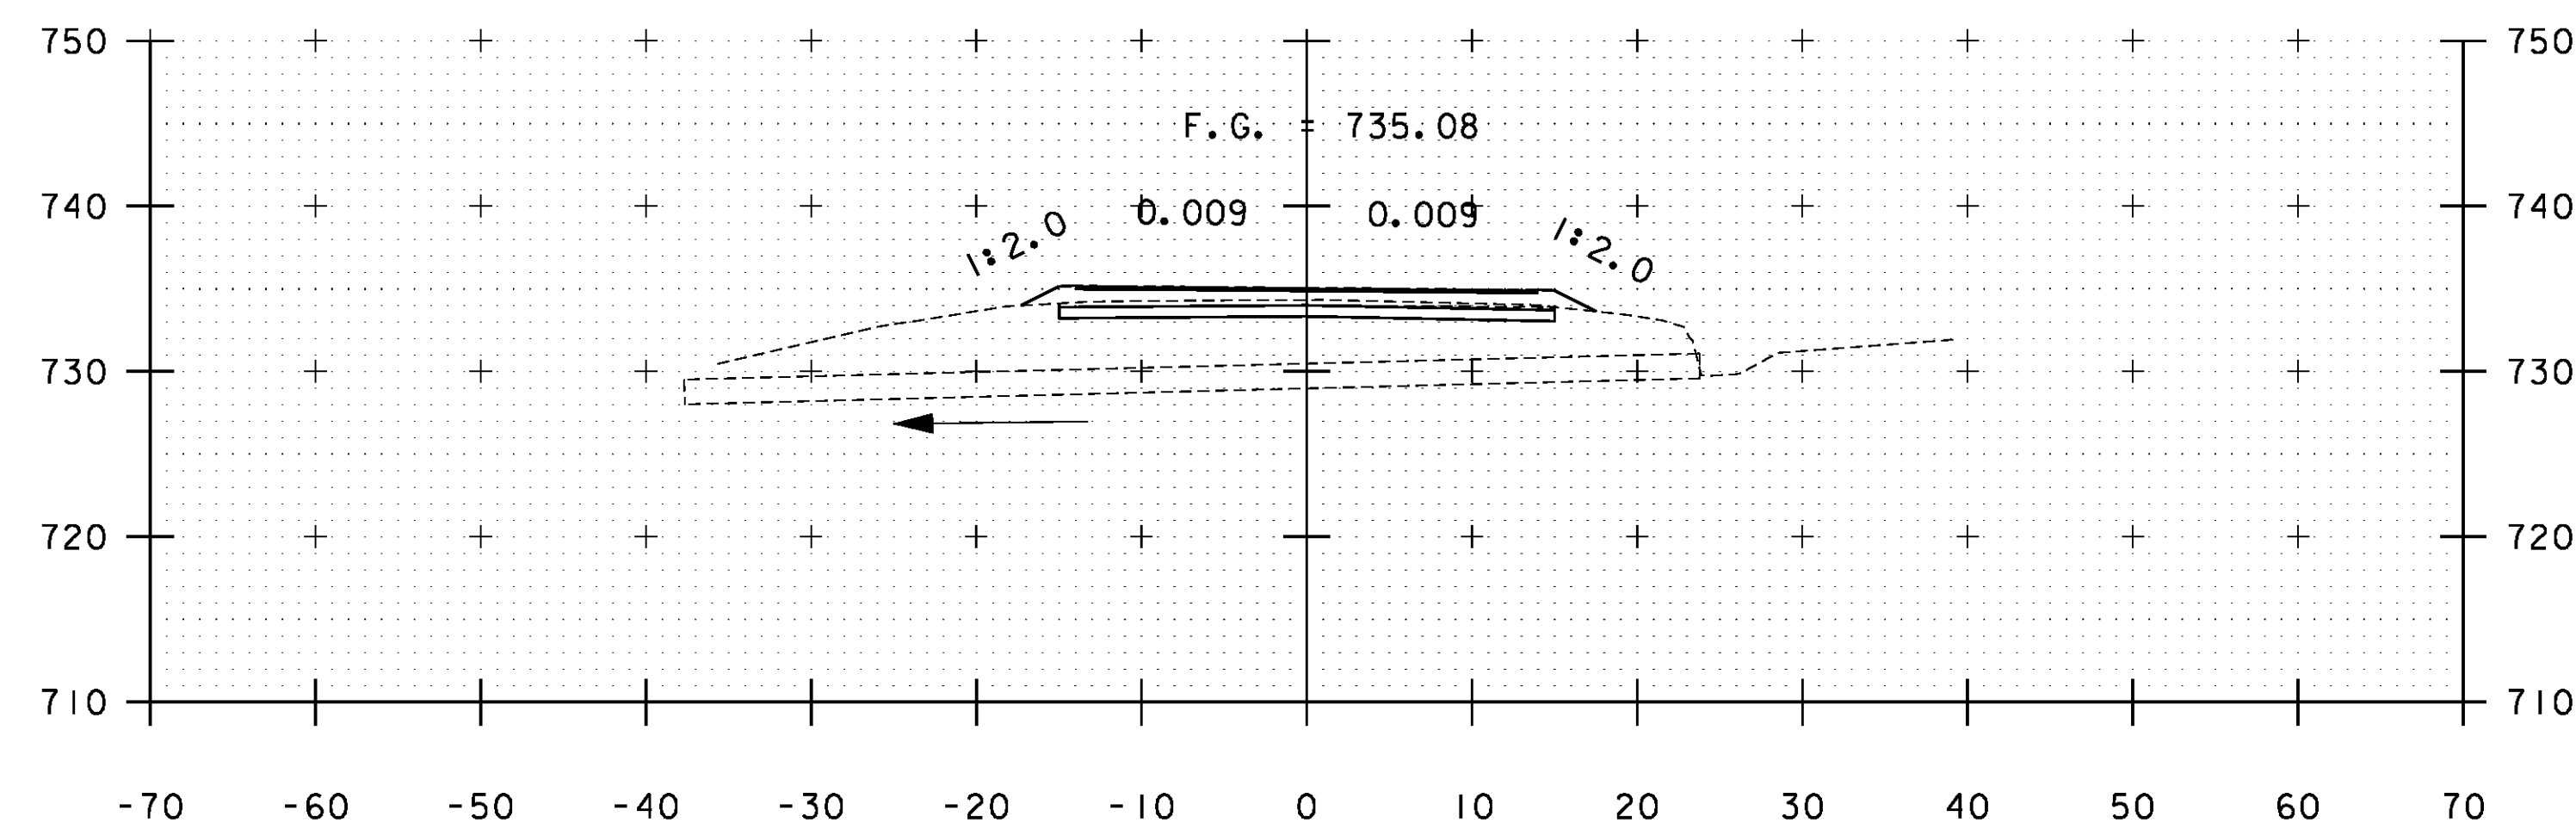

B 93+22

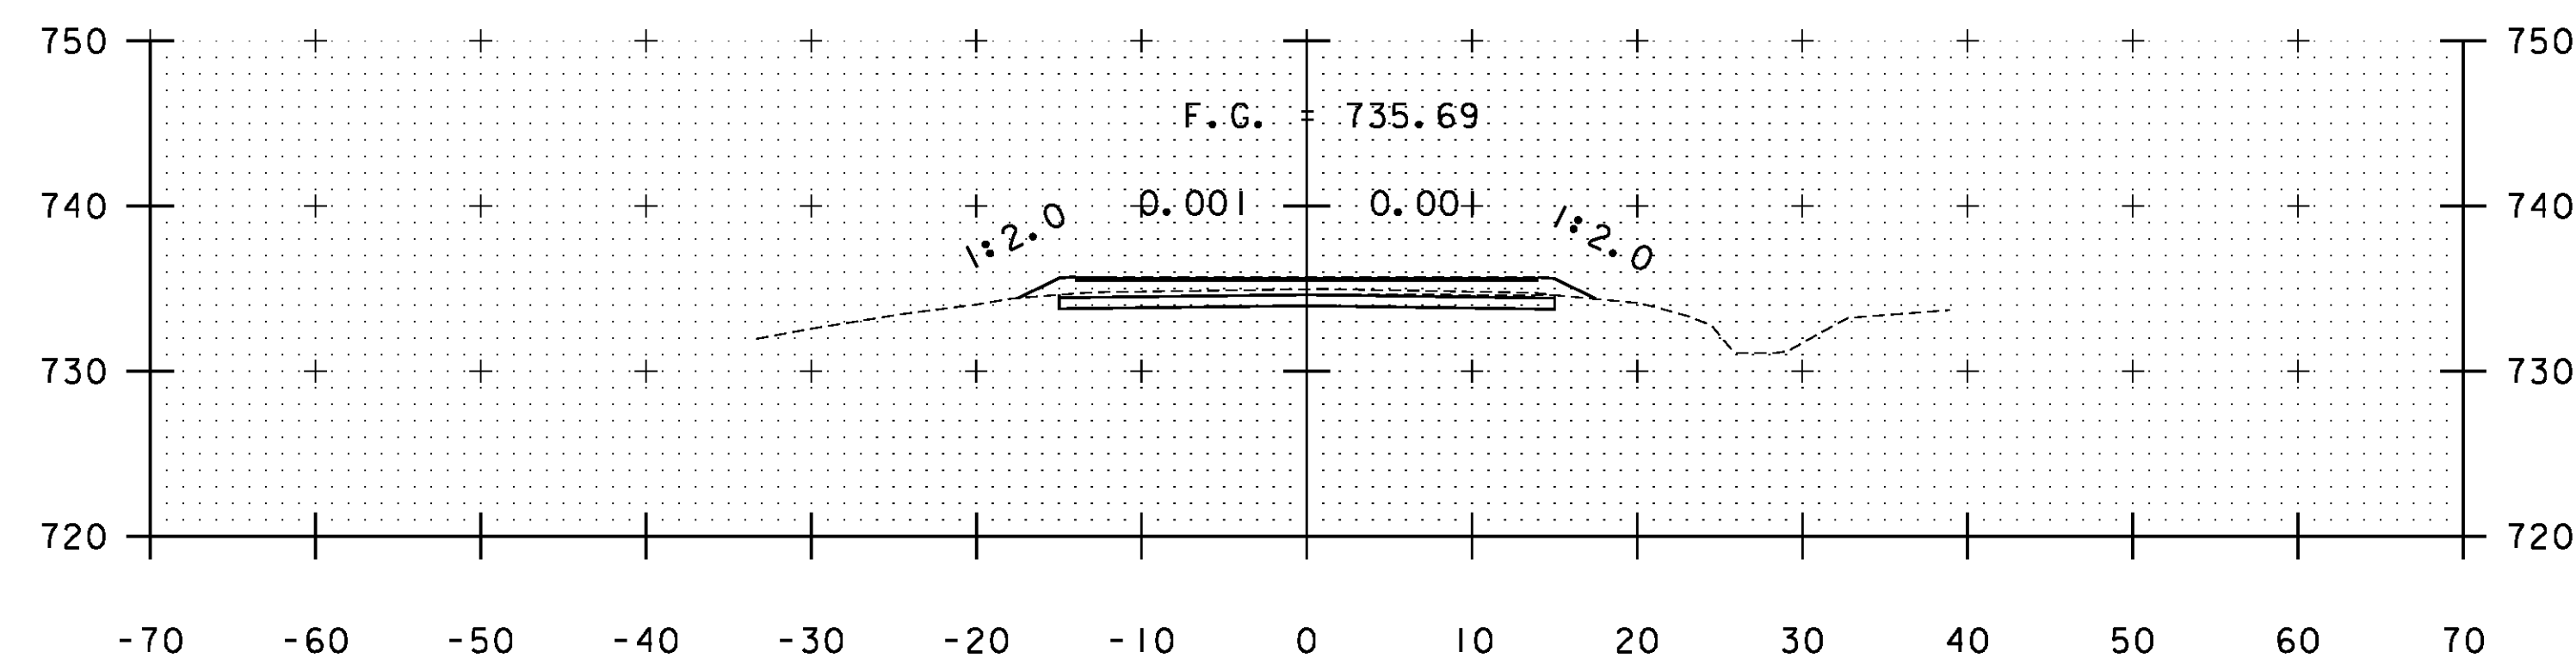

B 93+00

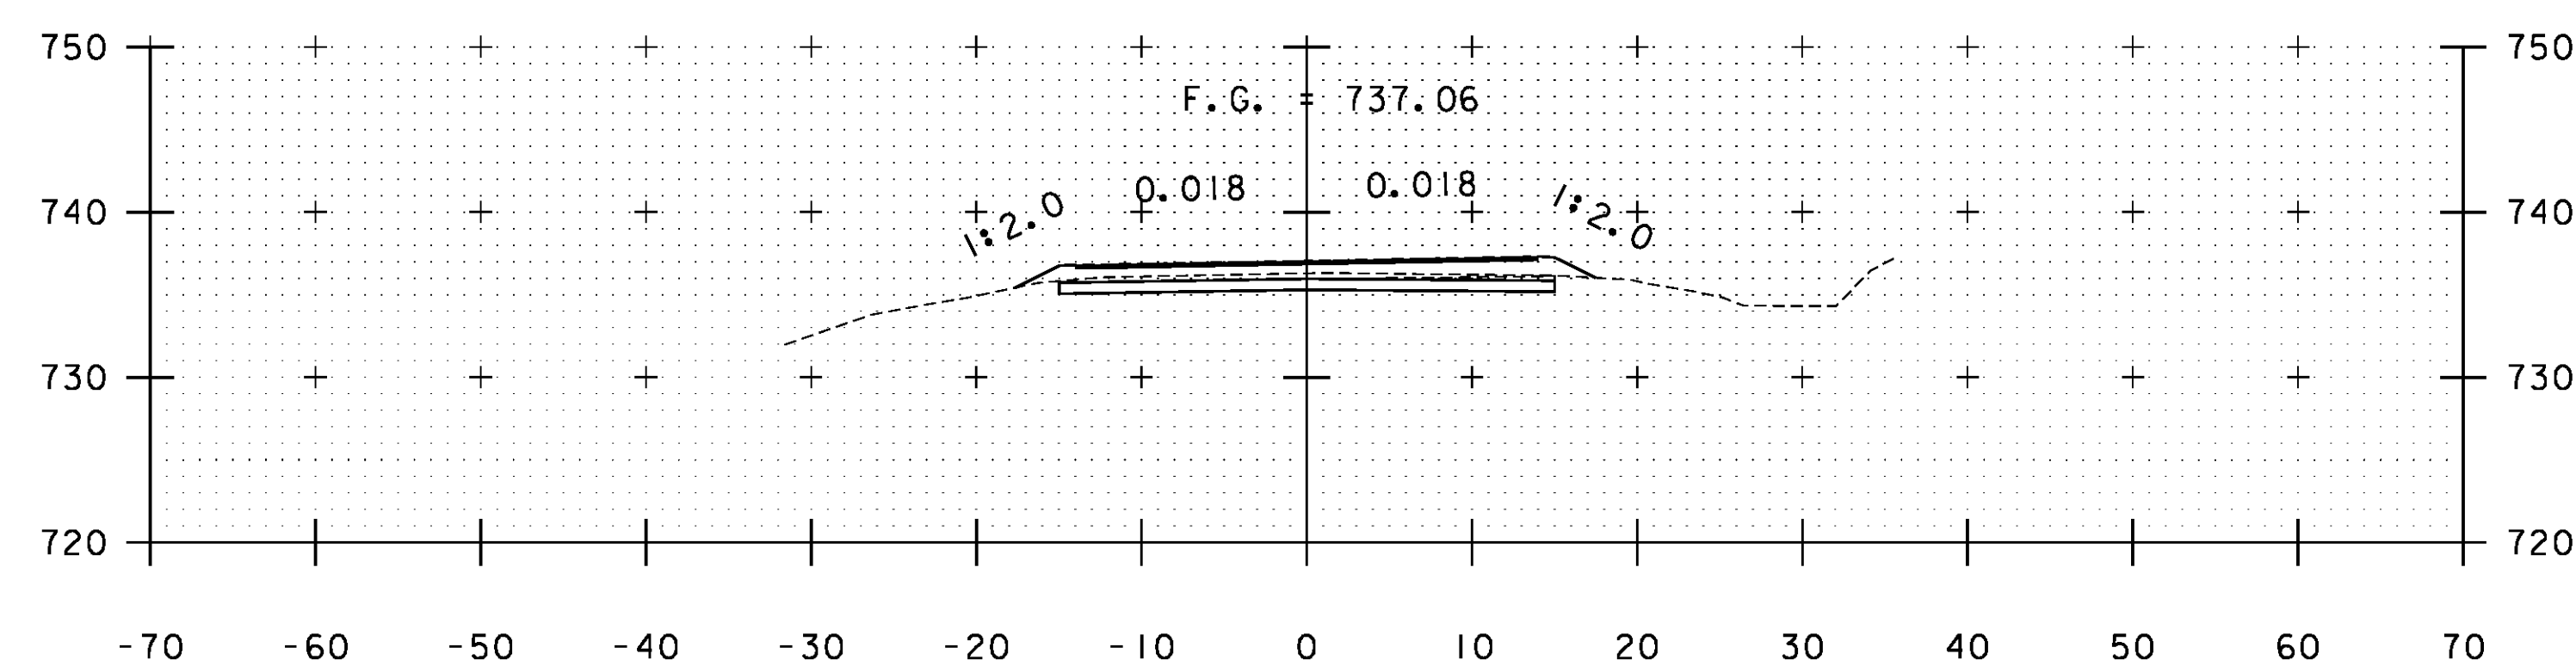

B 92+50

STA. B 91+28 TO STA. B 93+22

PROJECT NAME: WARDBORO-JAMAICA	
PROJECT NUMBER: ER STP 013-1(17)	
FILE NAME: xs.dgn	PLOT DATE: 2/26/2014
PROJECT LEADER: K. UPMAL	DRAWN BY: B. KIPP
DESIGNED BY: B. KIPP	CHECKED BY: HSD
CROSS SECTIONS	SHEET 361 OF 444