




B 96+00

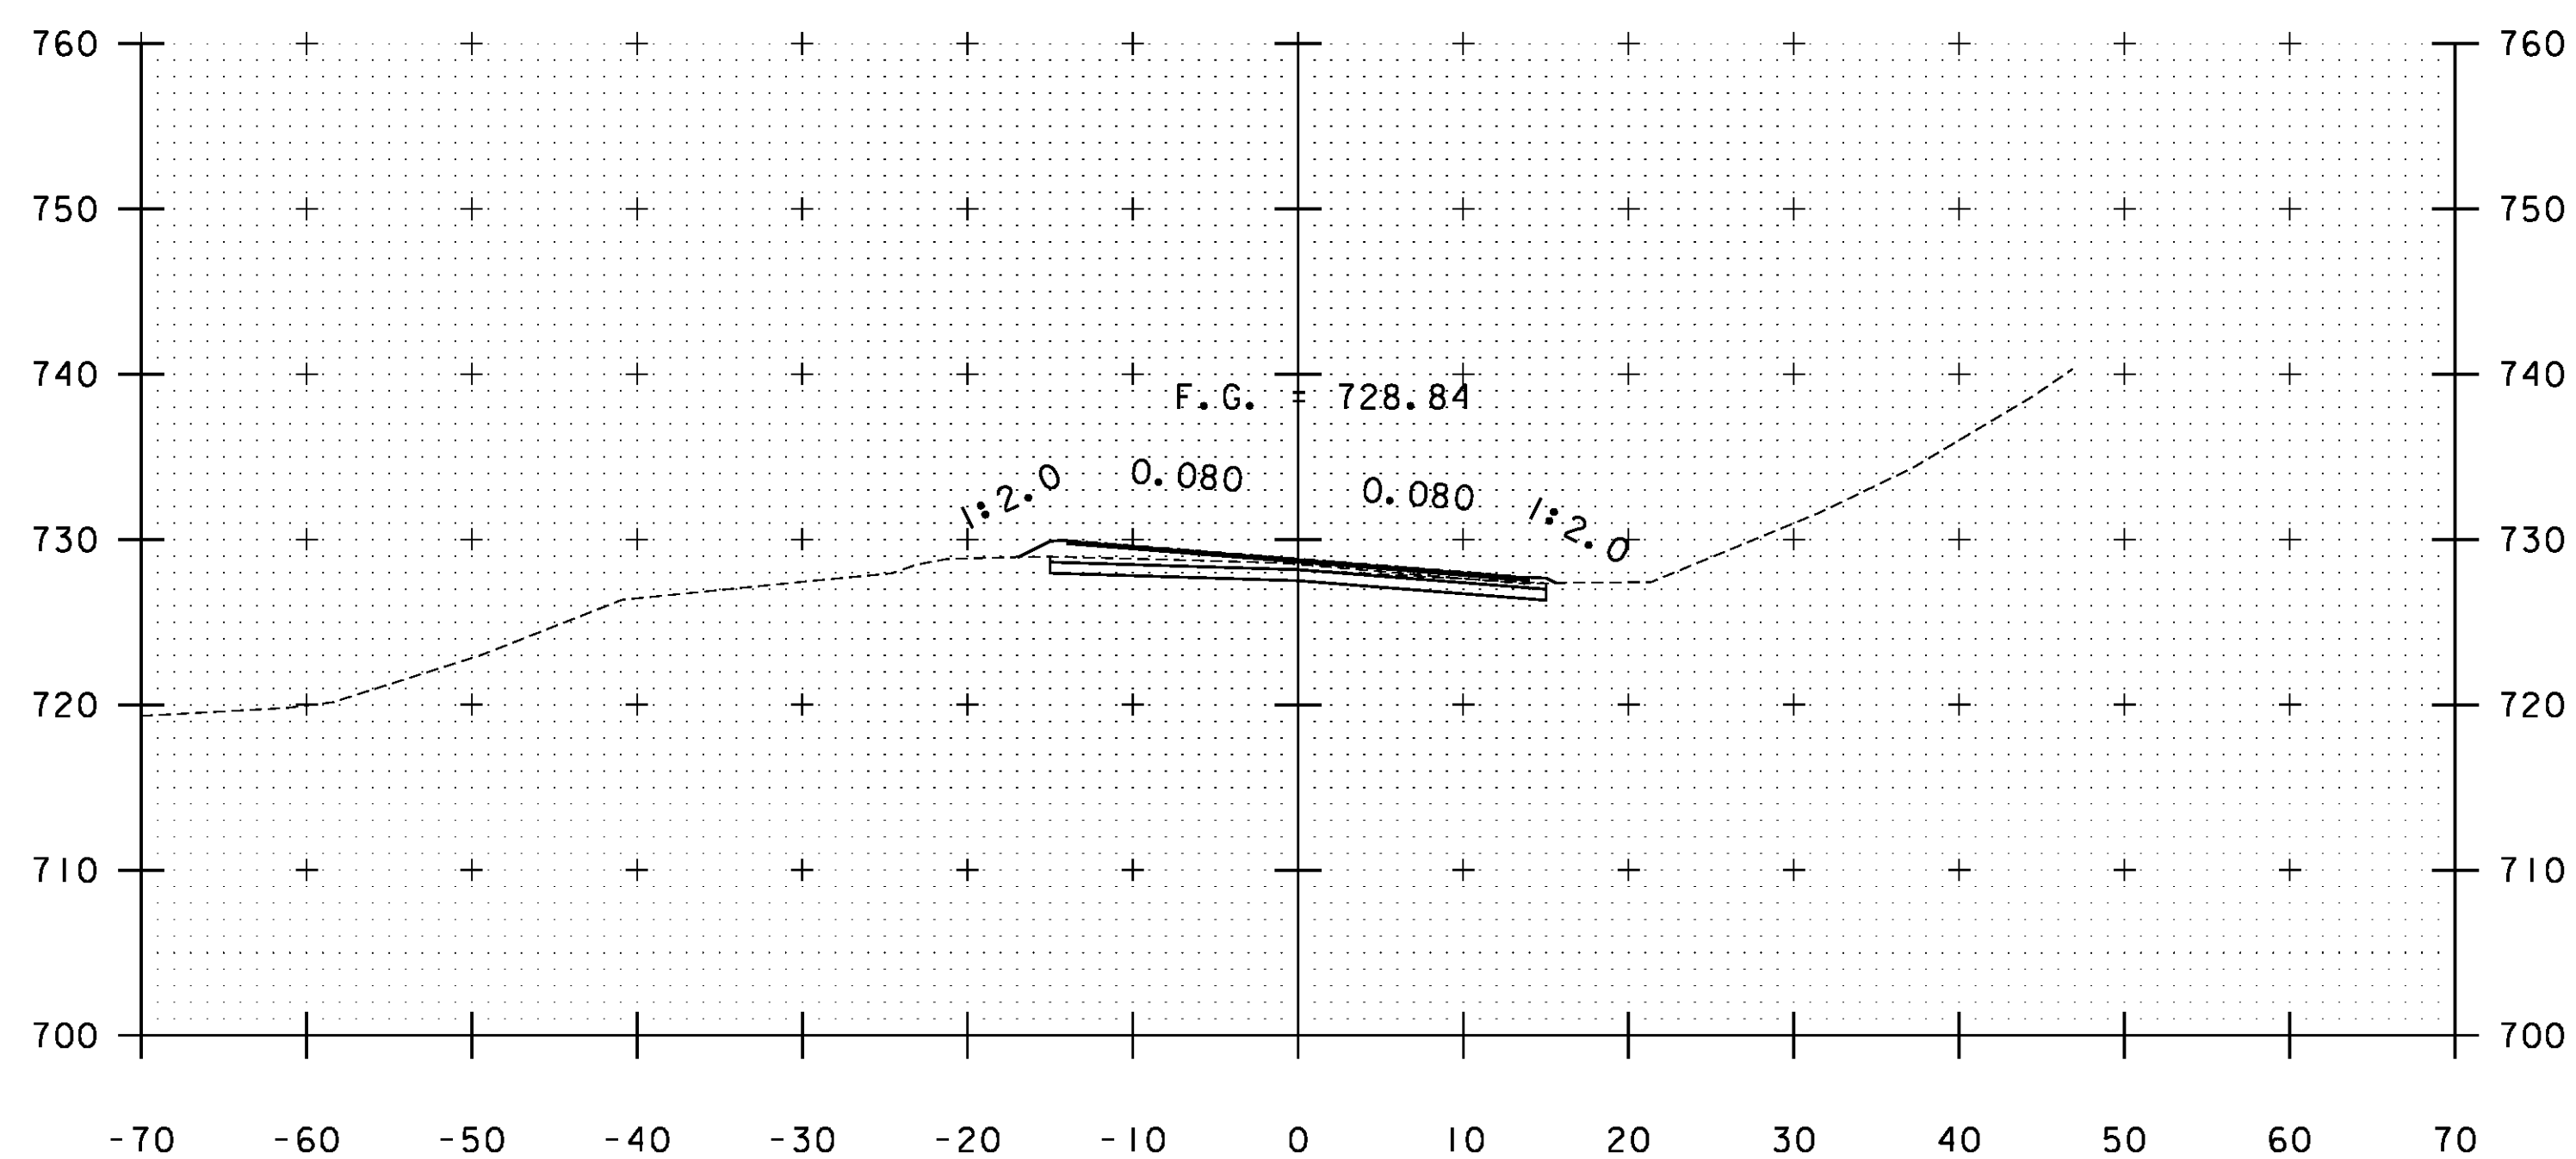


B 95+50

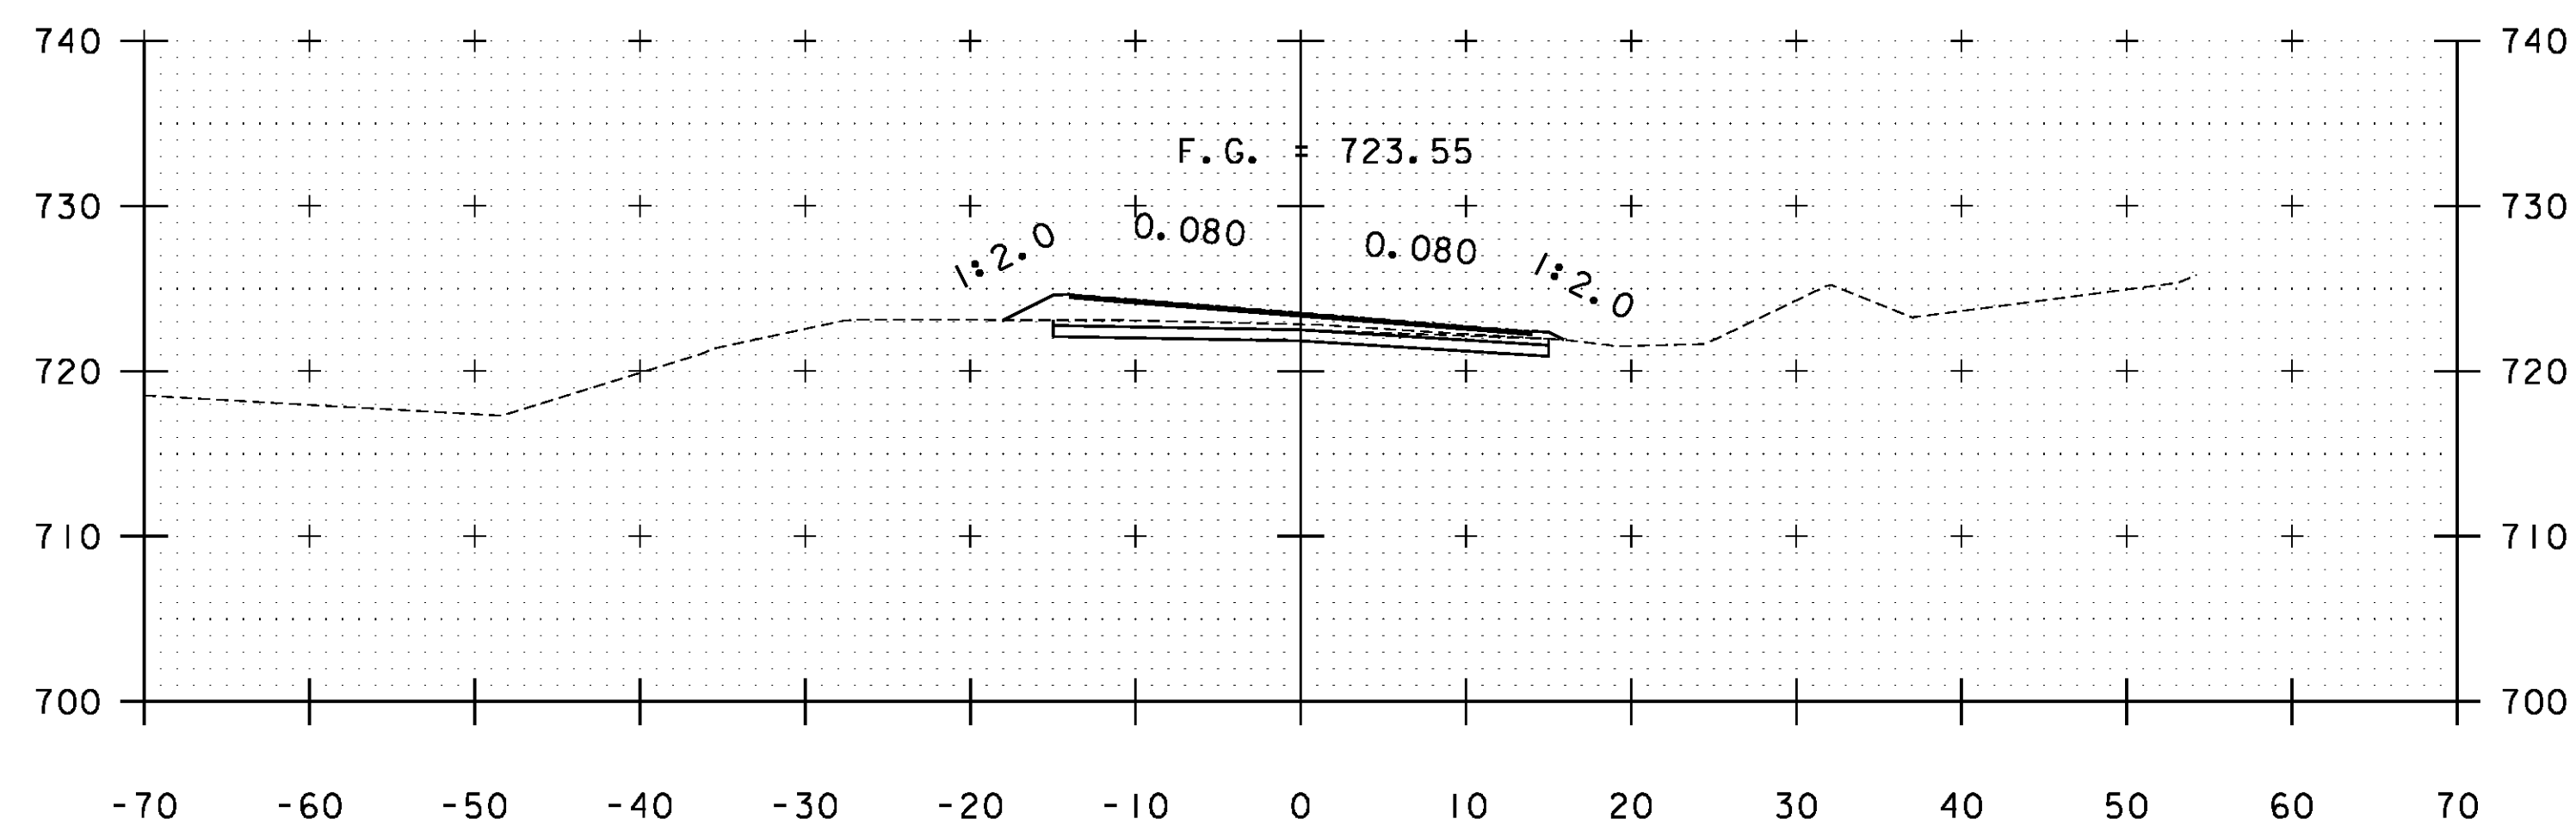

B 97+50

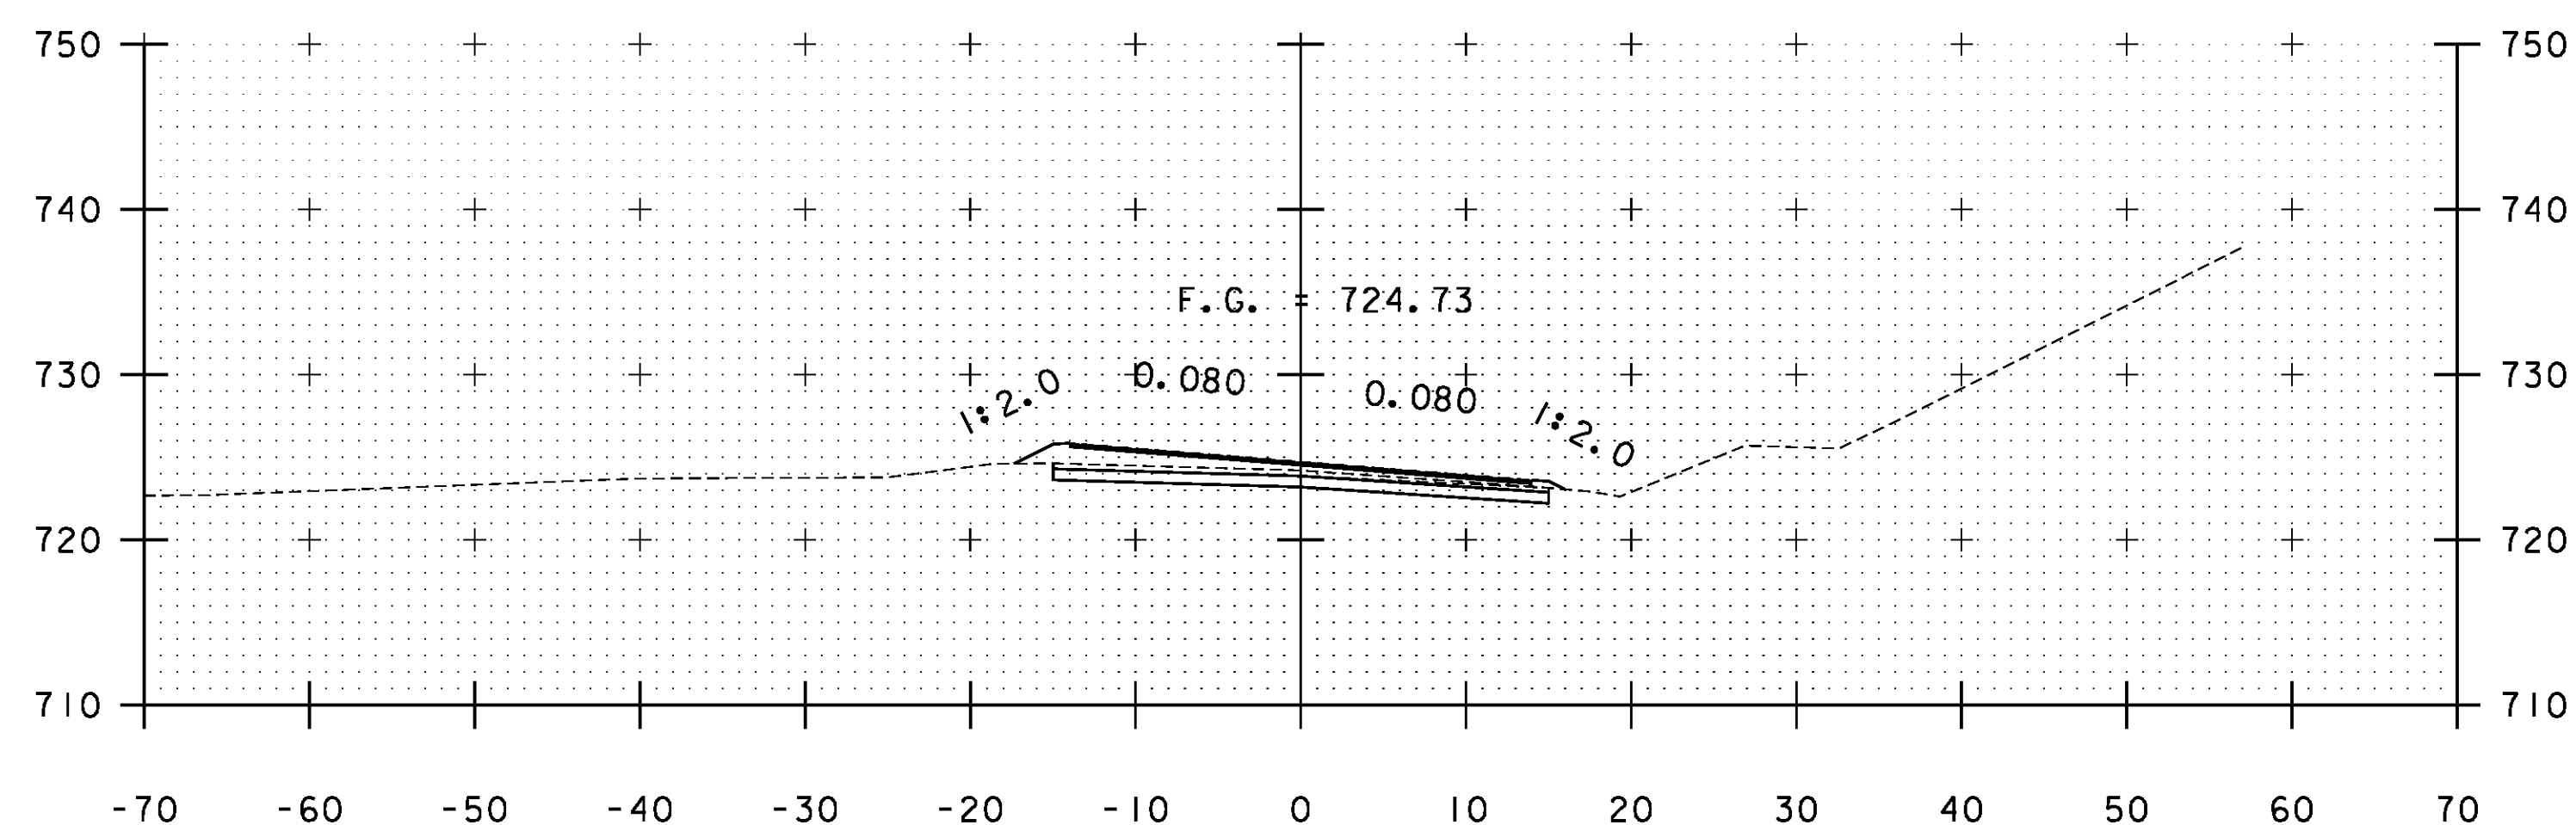

B 97+00

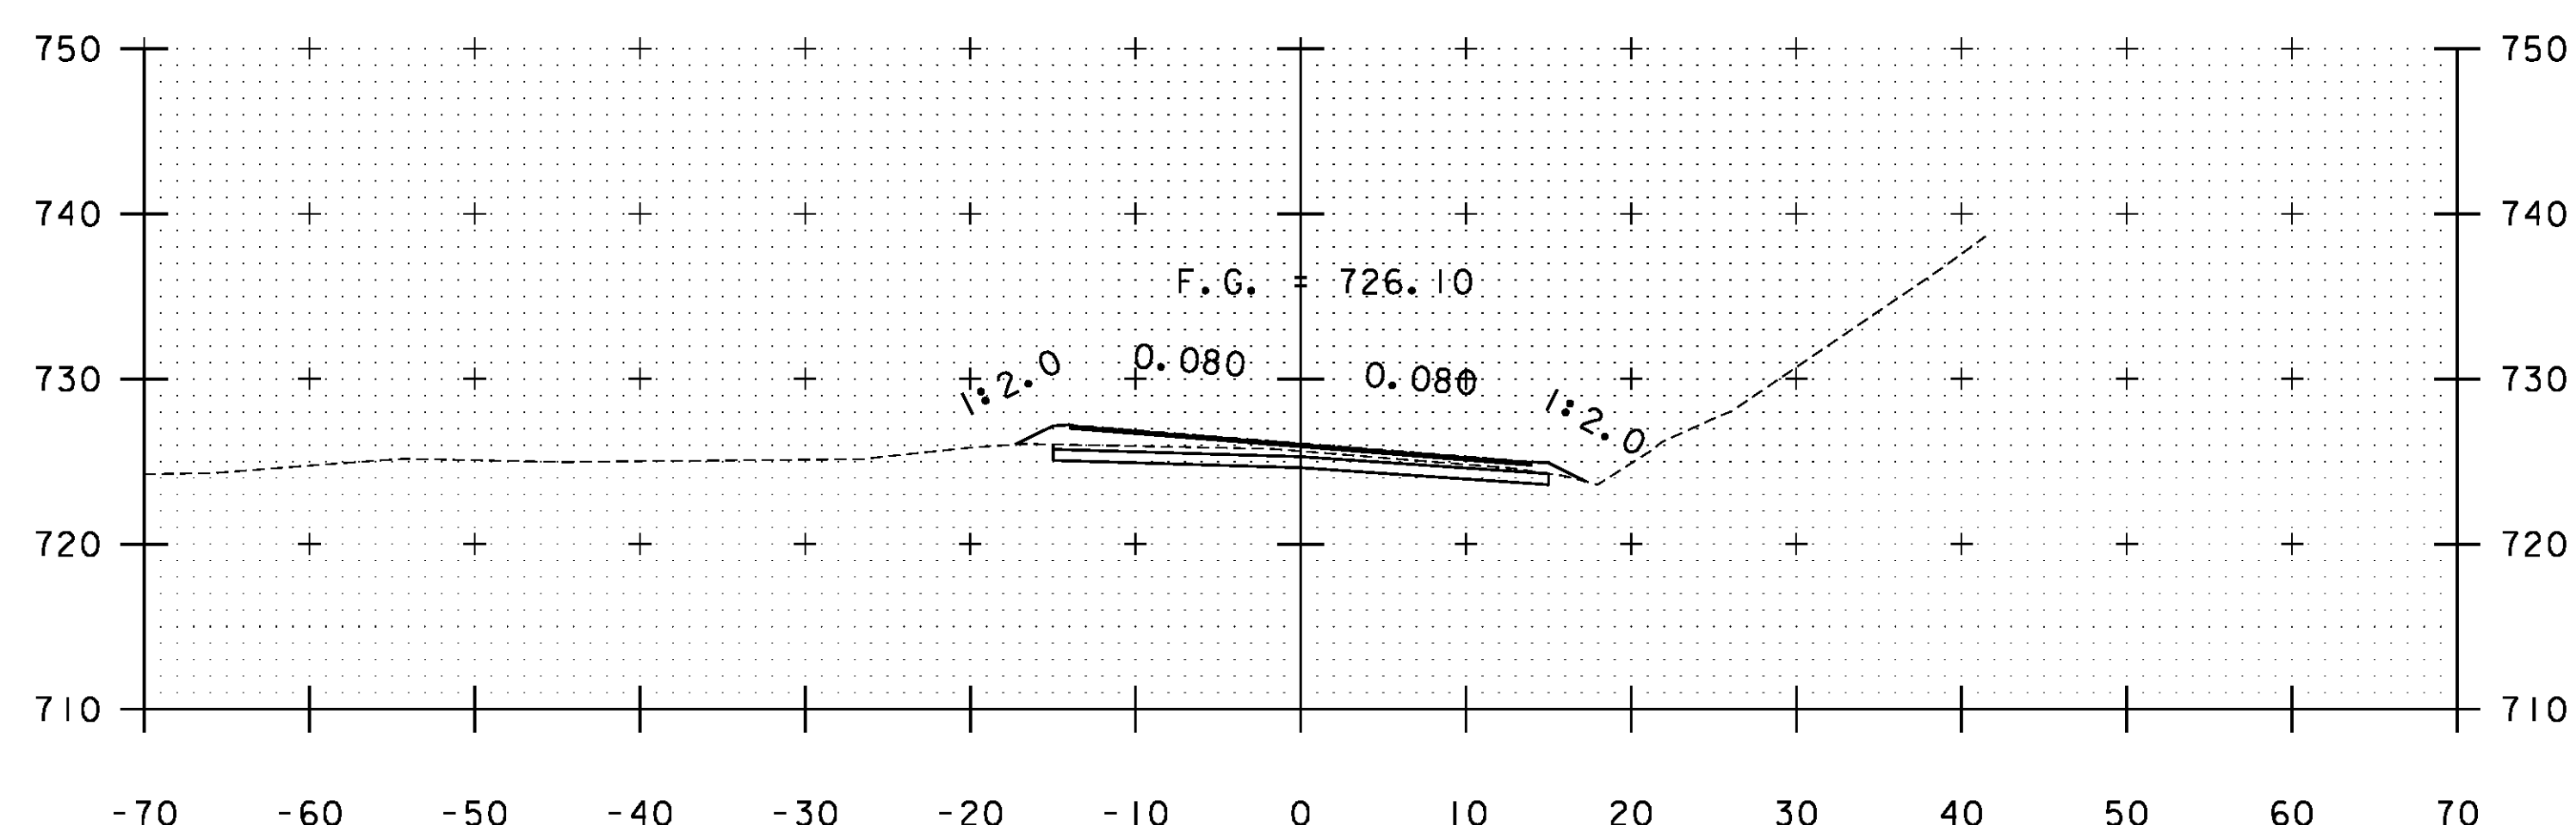

B 96+50

STA. B 95+50 TO STA. B 97+50

PROJECT NAME: WARDBORO-JAMAICA	PLOT DATE: 2/26/2014
PROJECT NUMBER: ER STP 013-1(17)	DRAWN BY: B. KIPP
FILE NAME: xs.dgn	CHECKED BY: HSD
PROJECT LEADER: K. UPMAL	SHEET 363 OF 444
DESIGNED BY: B. KIPP	
CROSS SECTIONS	