




B 99+00

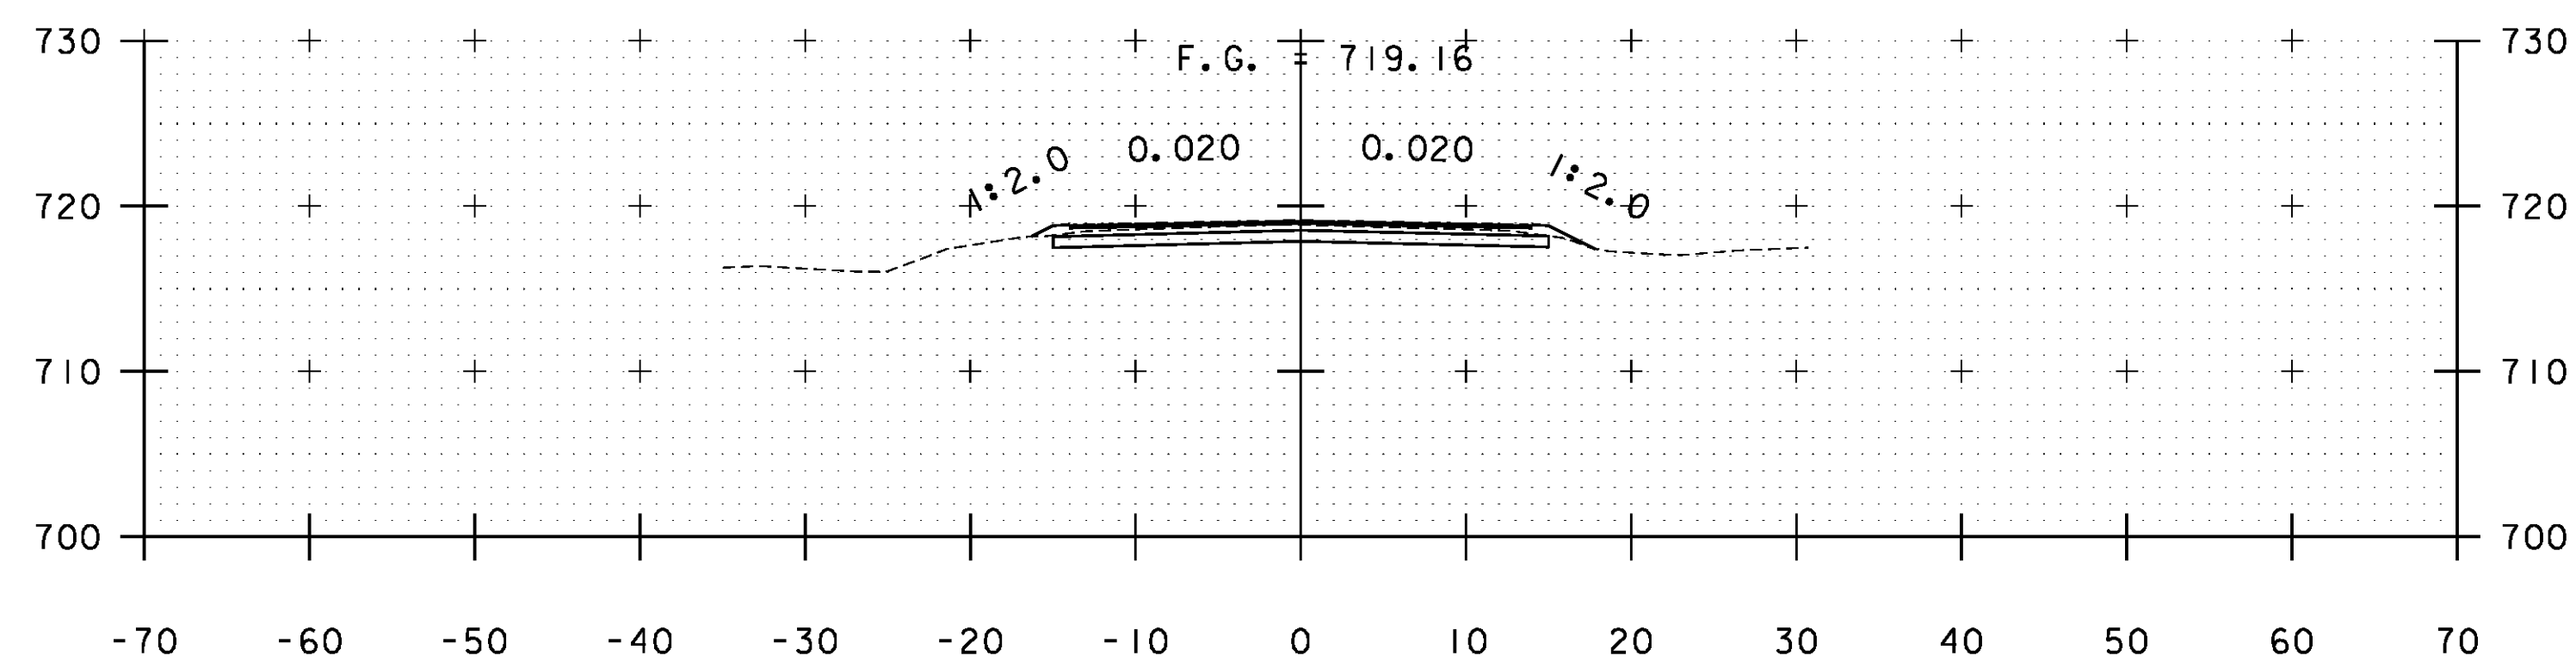


B 100+50

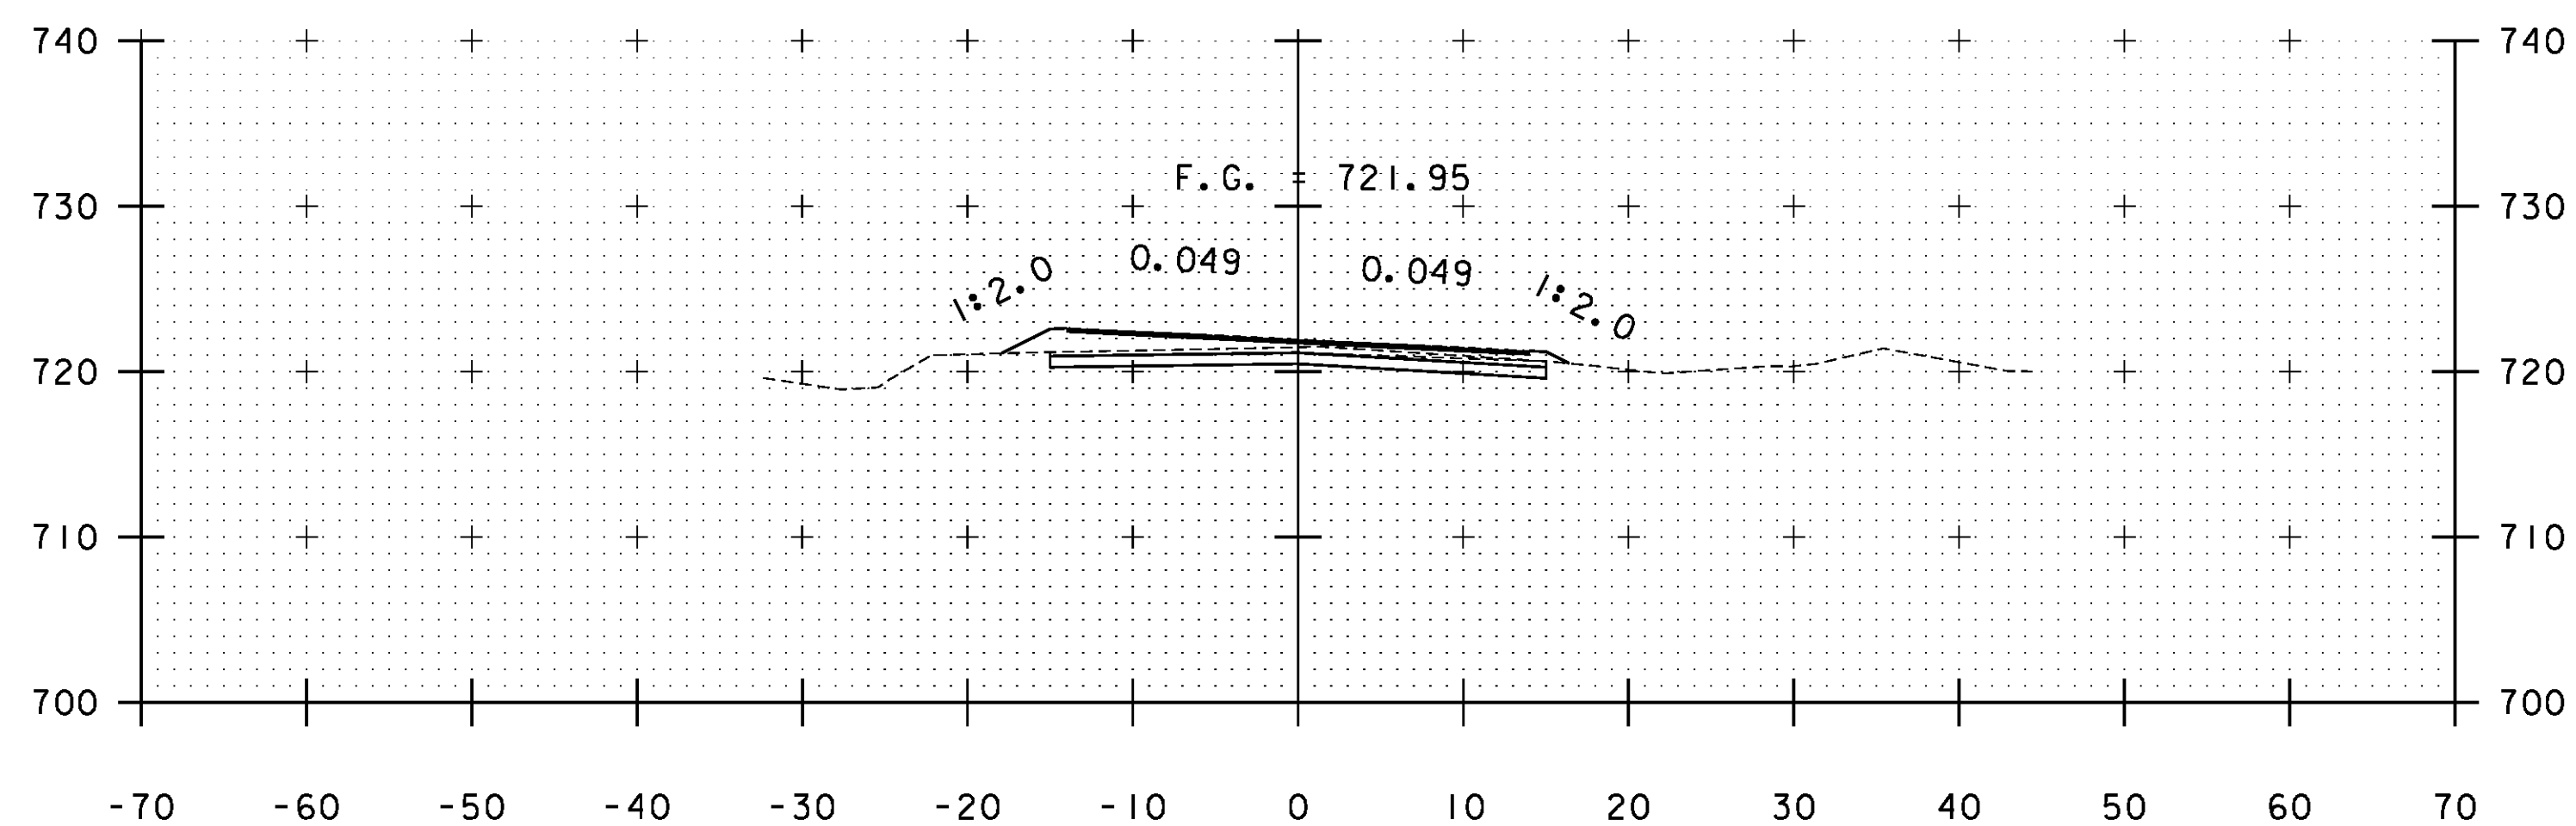


B 98+50

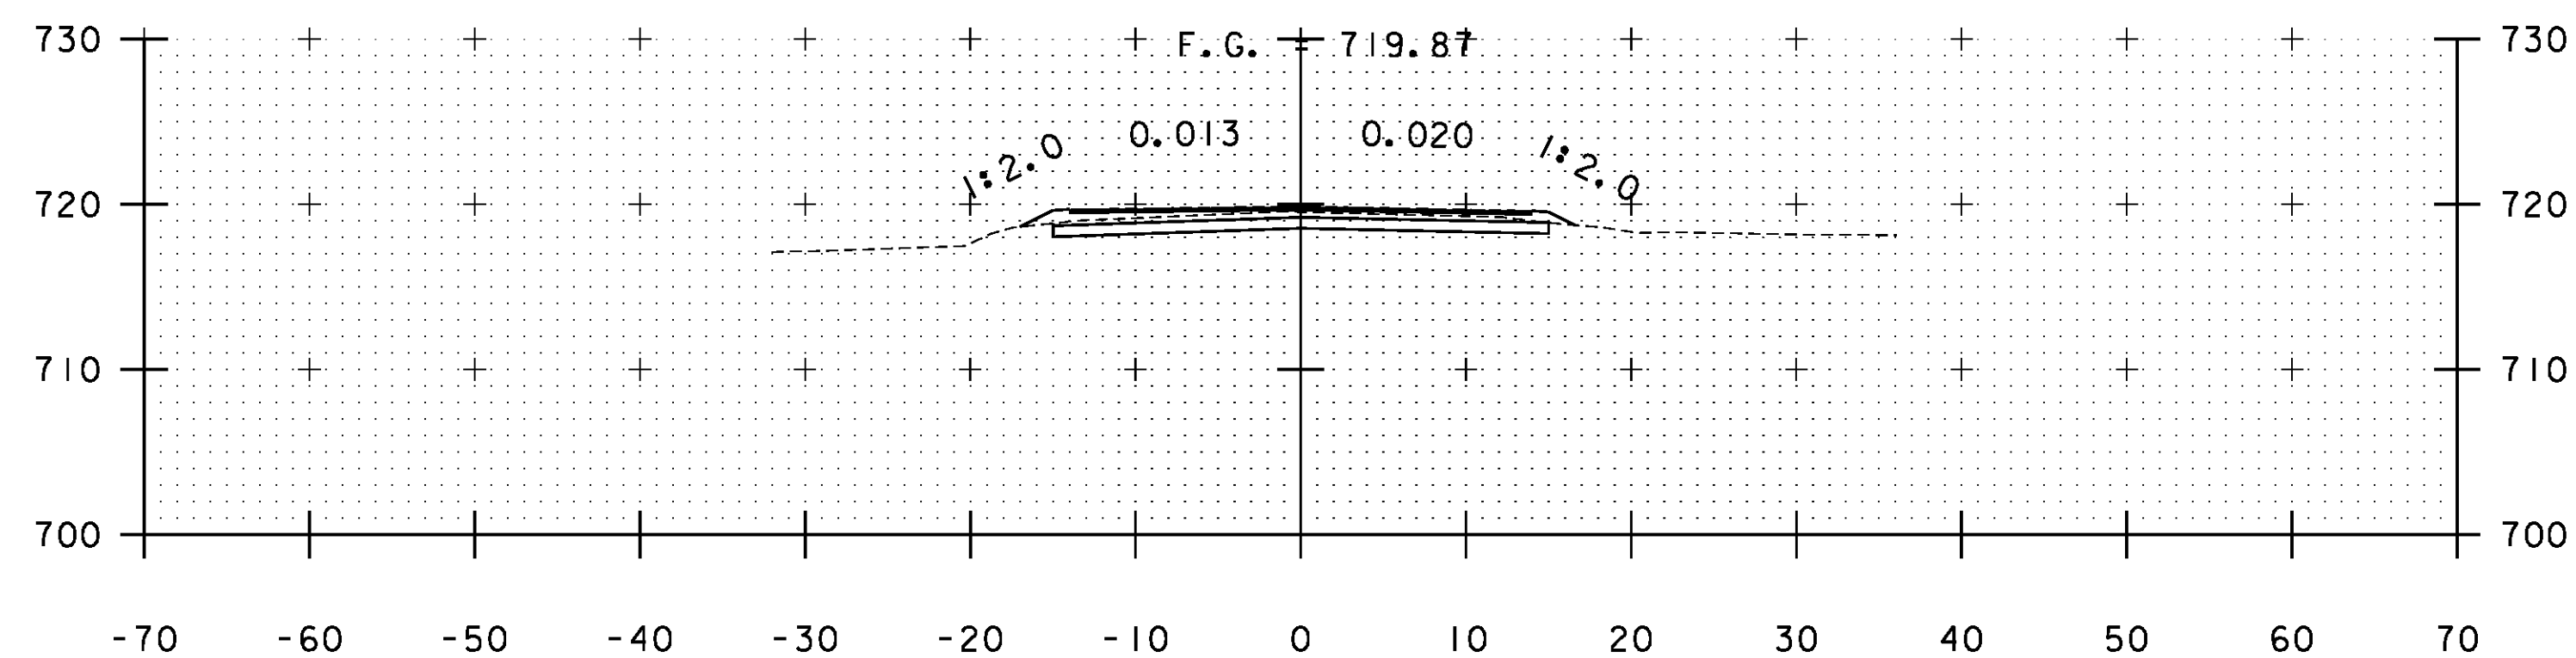

B 100+00

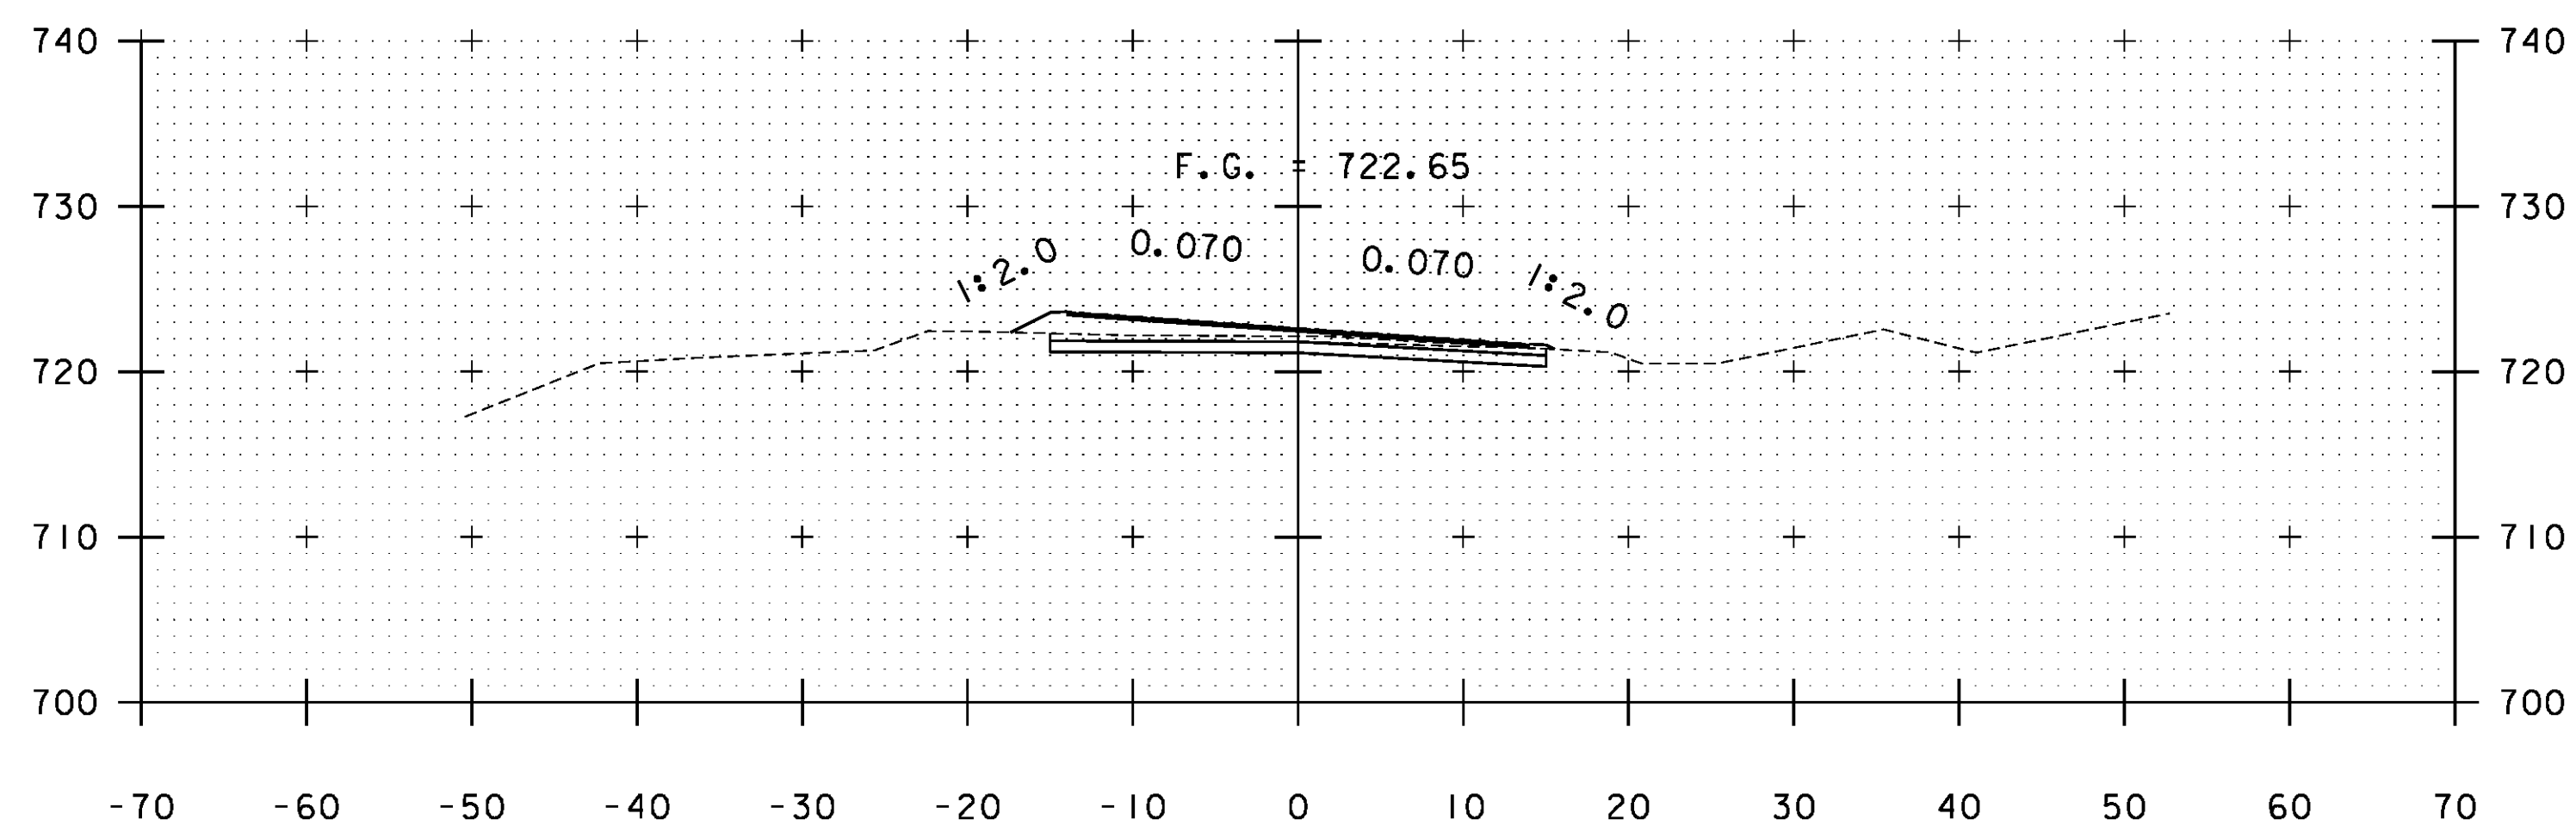

B 98+00

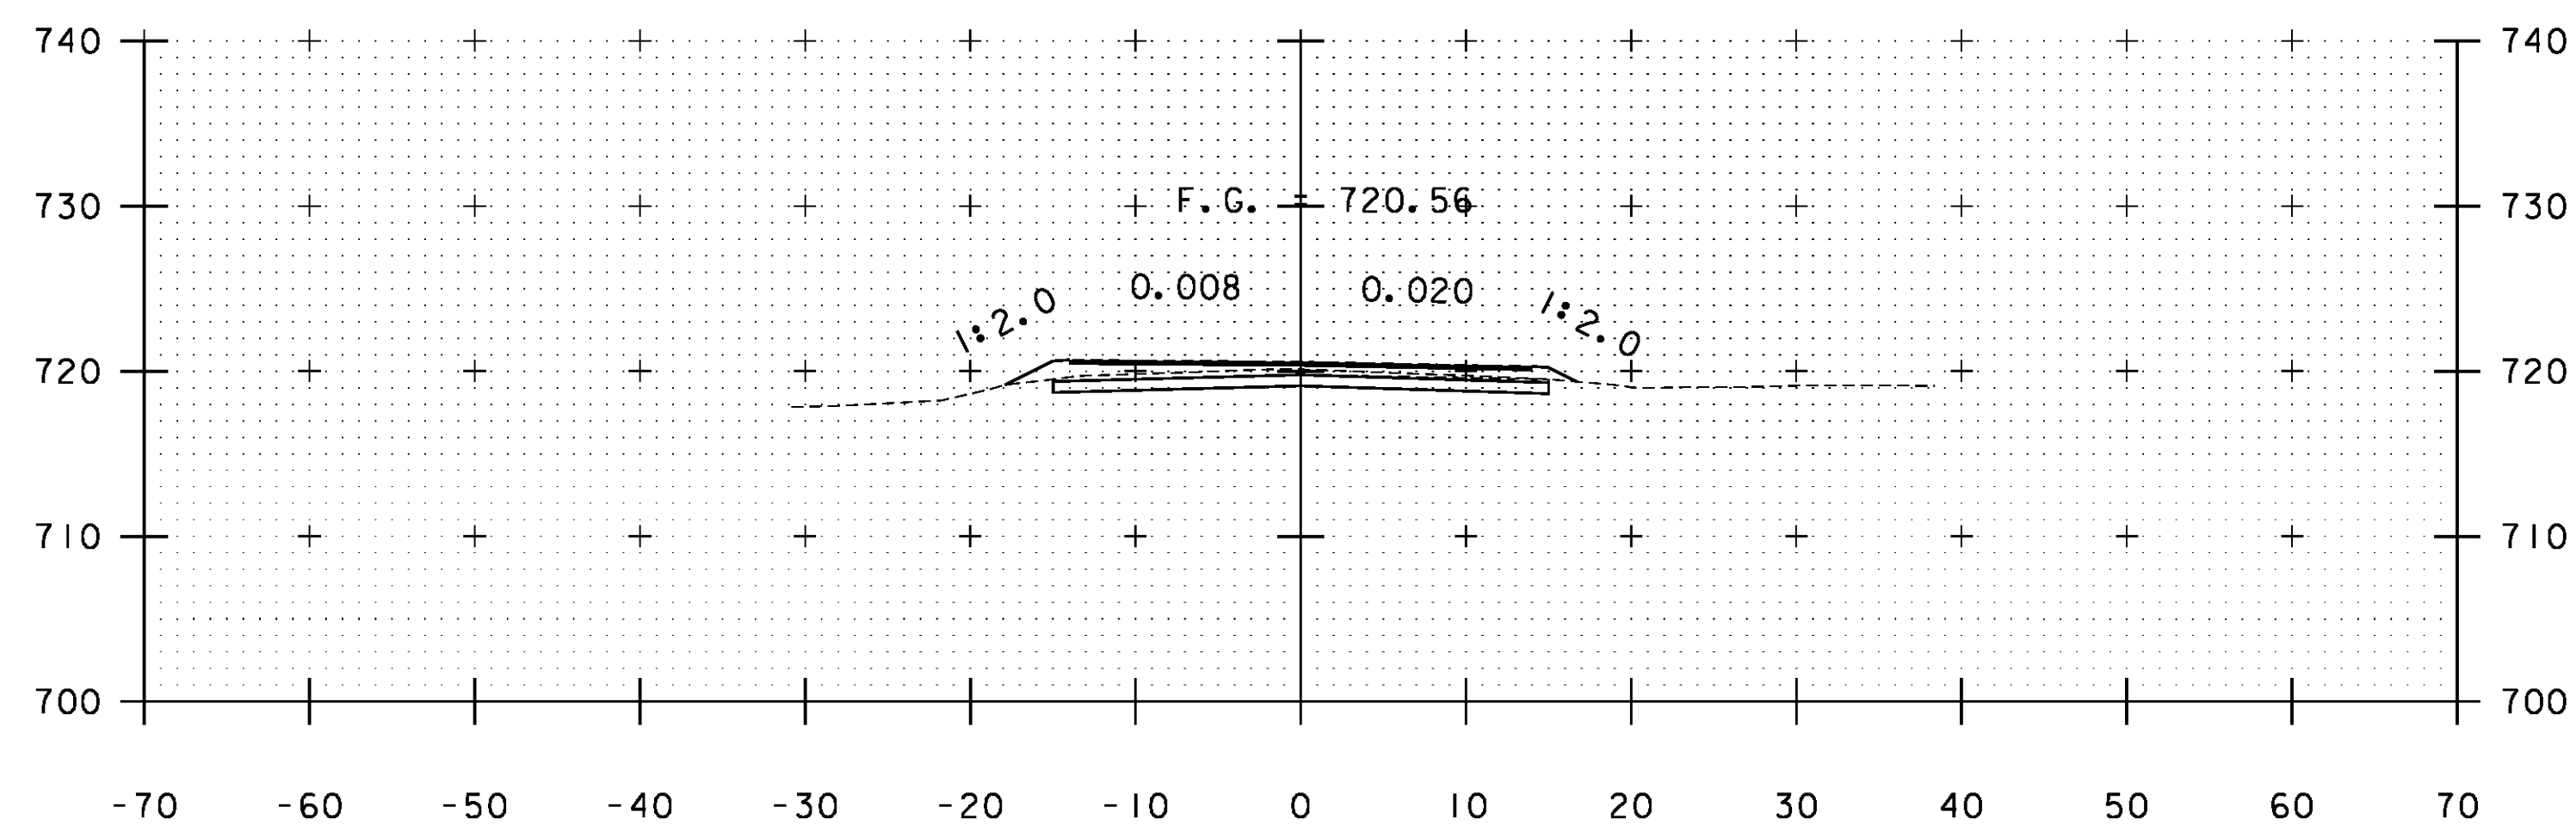

B 99+50

STA. B 98+00 TO STA. B 100+50

PROJECT NAME:	WARDSBORO-JAMAICA
PROJECT NUMBER:	ER STP 013-1(17)
FILE NAME:	xs.dgn
PROJECT LEADER:	K. UPMAL
DESIGNED BY:	B. KIPP
CROSS SECTIONS	
PLOT DATE:	2/26/2014
DRAWN BY:	B. KIPP
CHECKED BY:	HSD
SHEET	364 OF 444