




B 106+50

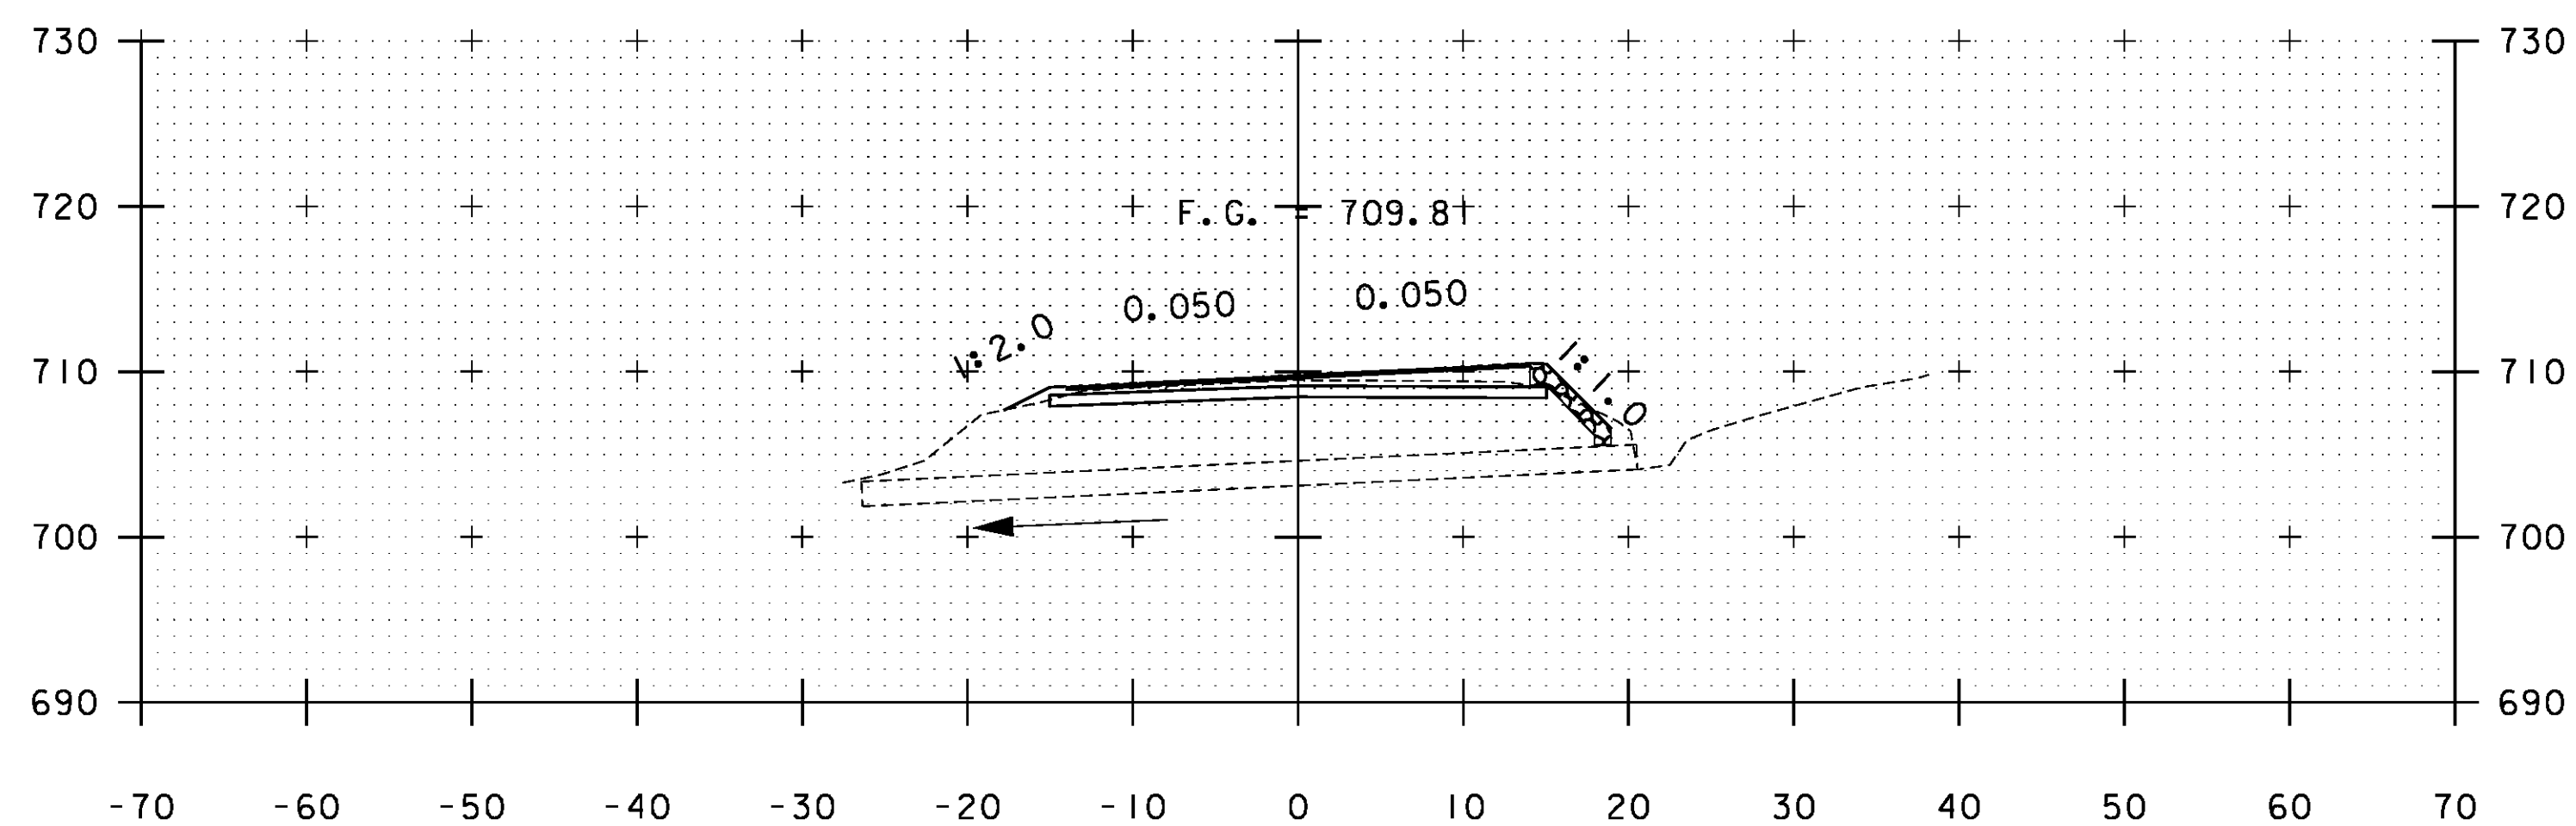

B 106+21

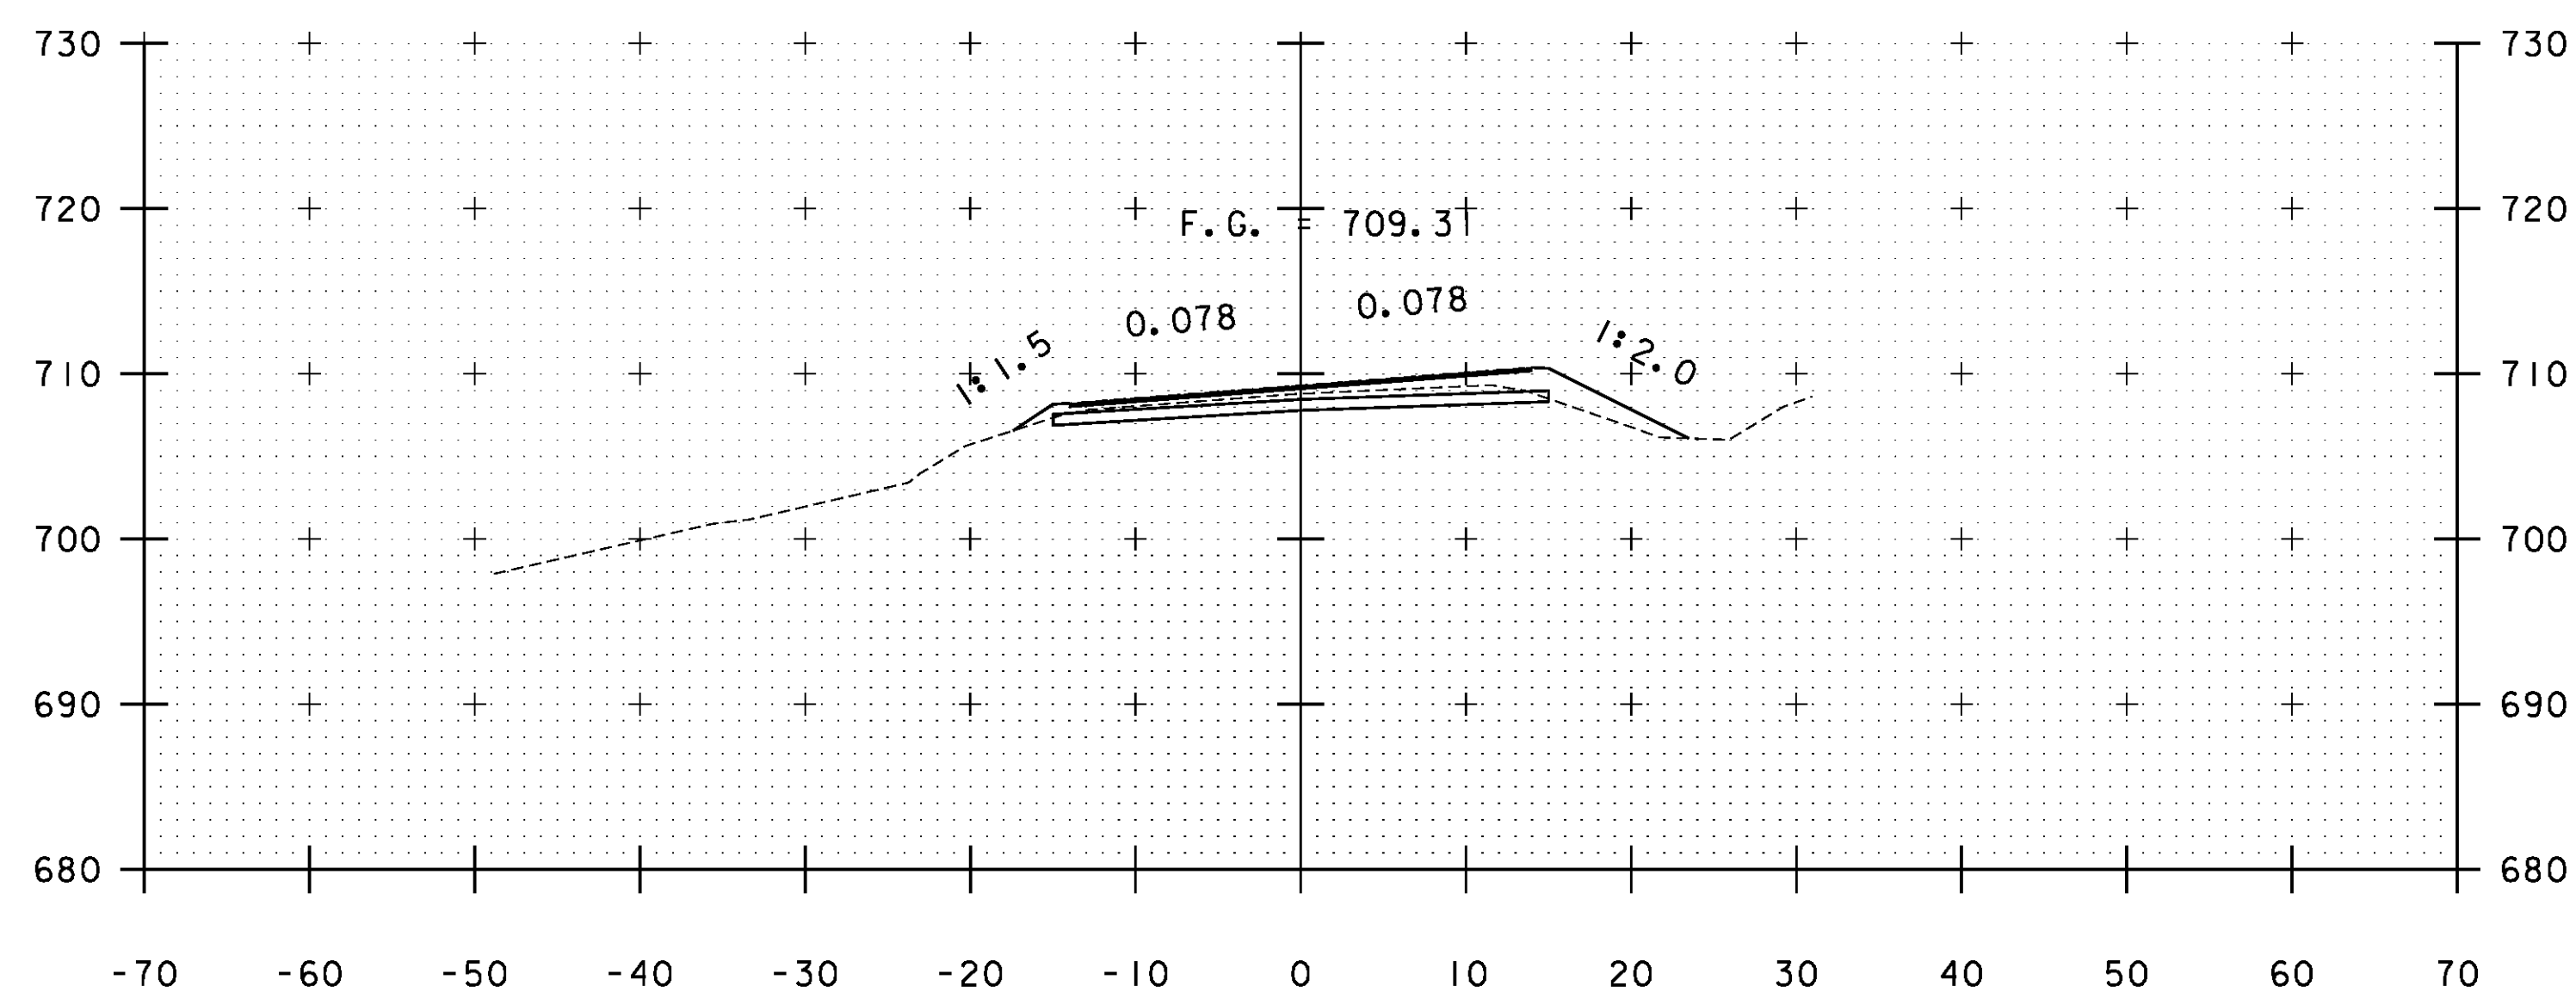

B 107+50

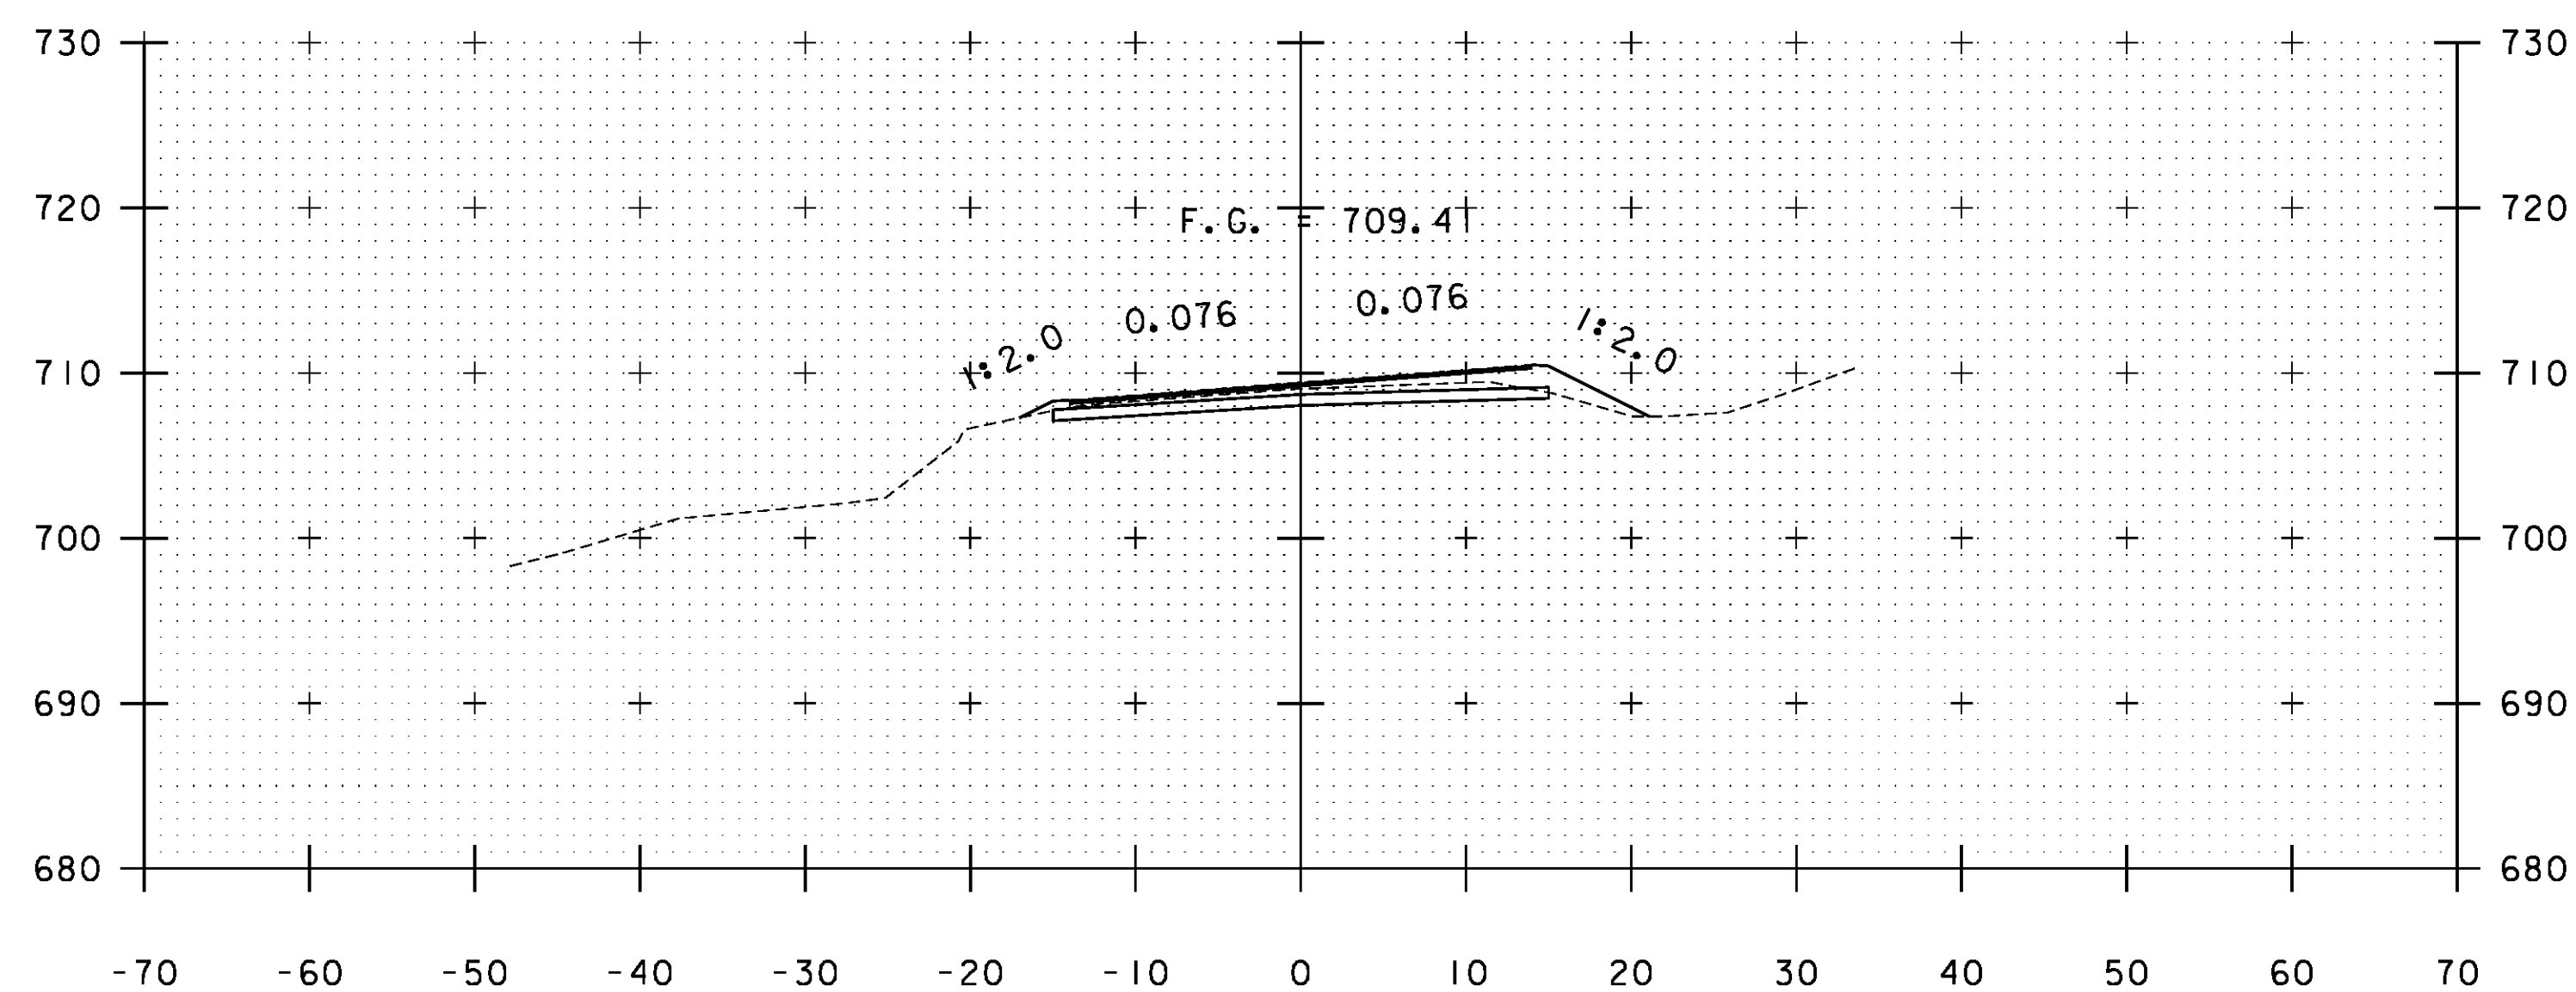

B 107+00

STA. B 106+21 TO STA. B 107+50

PROJECT NAME: WARDBORO-JAMAICA	PLOT DATE: 2/26/2014
PROJECT NUMBER: ER STP 013-1(17)	DRAWN BY: B. KIPP
FILE NAME: xs.dgn	CHECKED BY: HSD
PROJECT LEADER: K. UPMAL	SHEET 367 OF 444
DESIGNED BY: B. KIPP	
CROSS SECTIONS	