




B 108+50

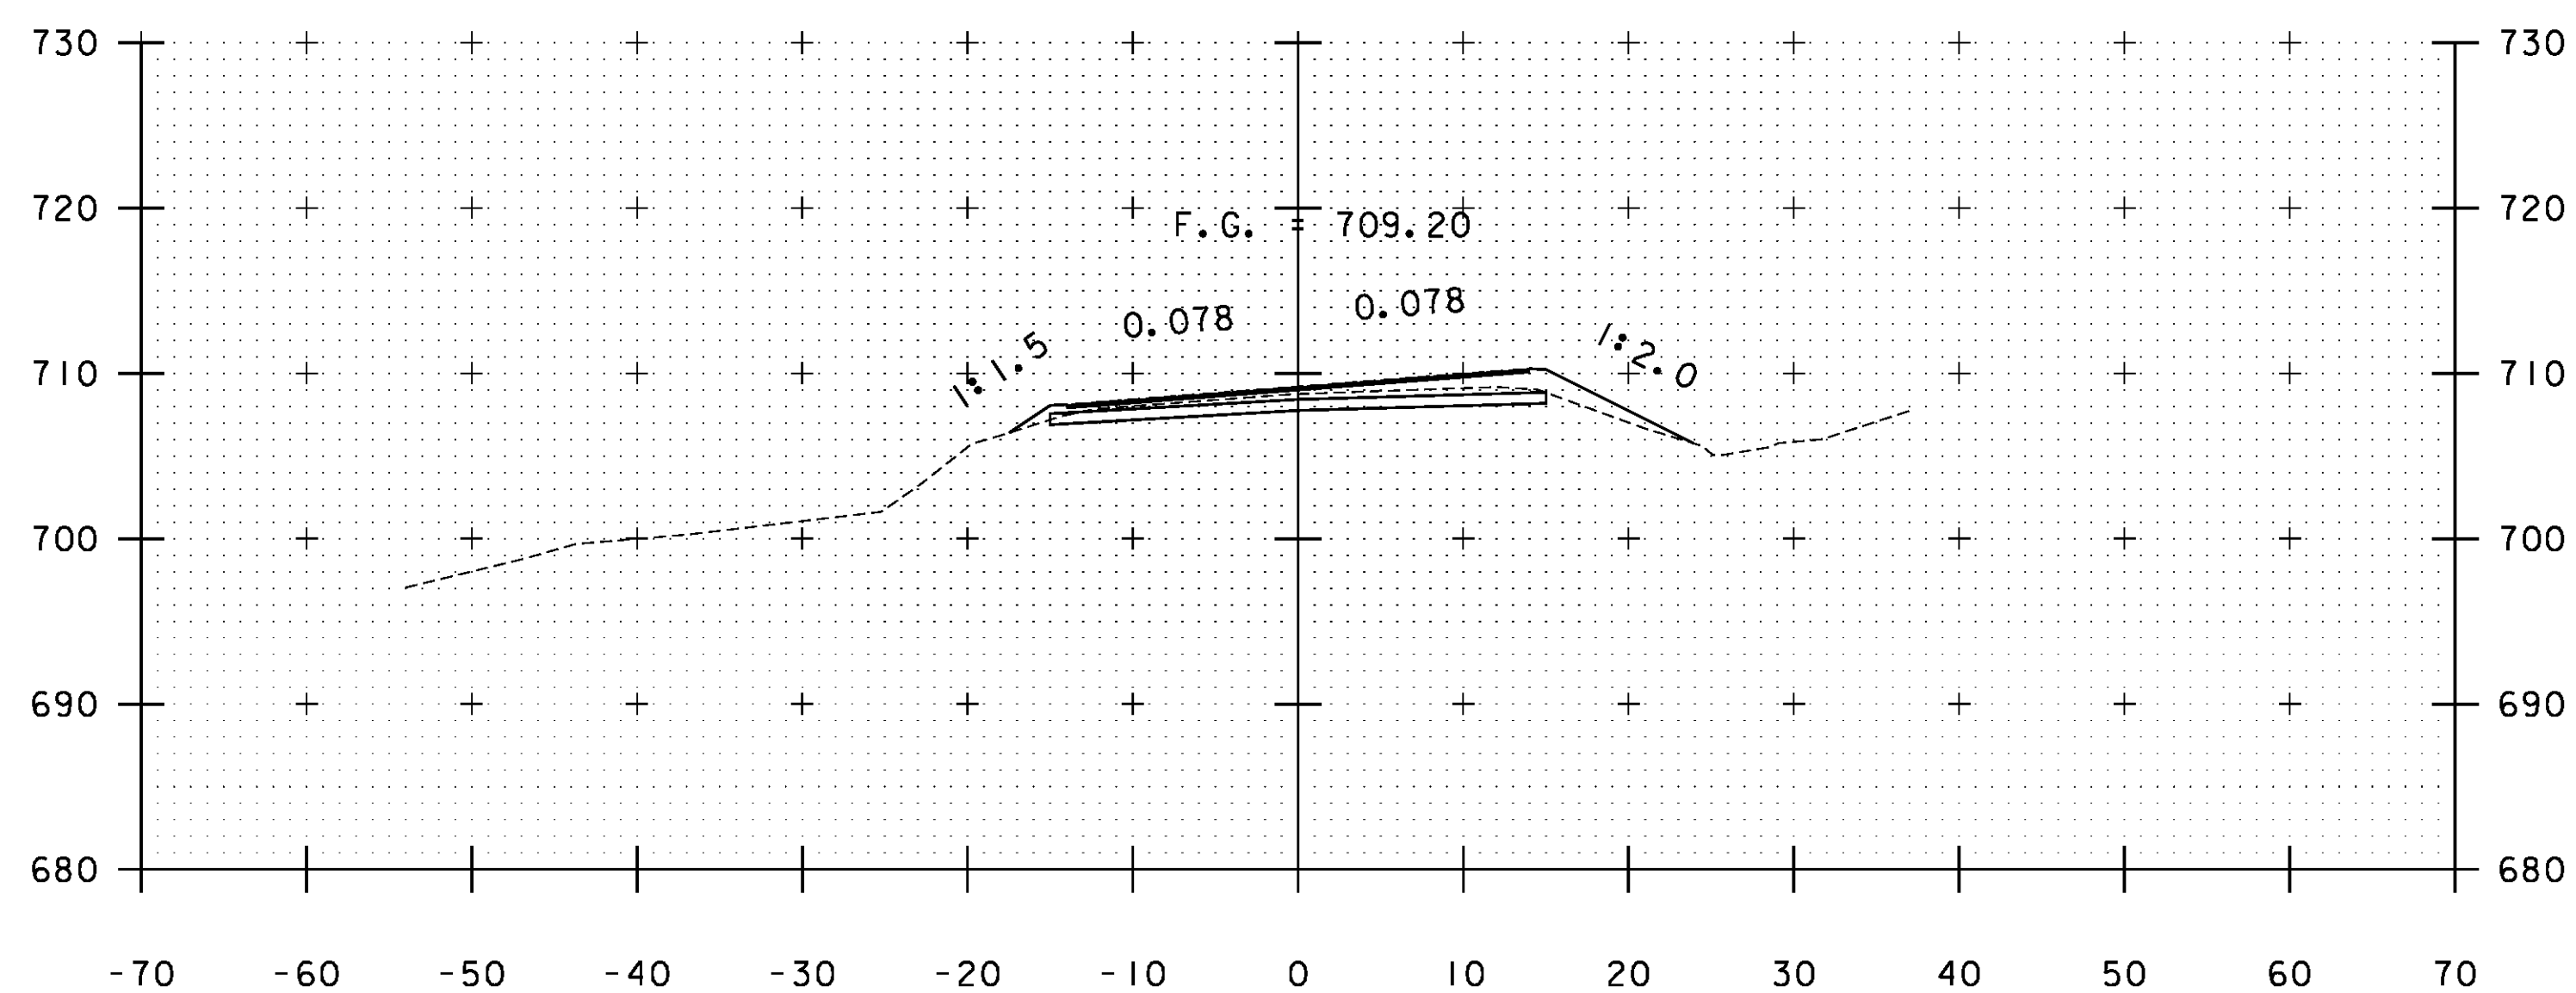

B 108+00

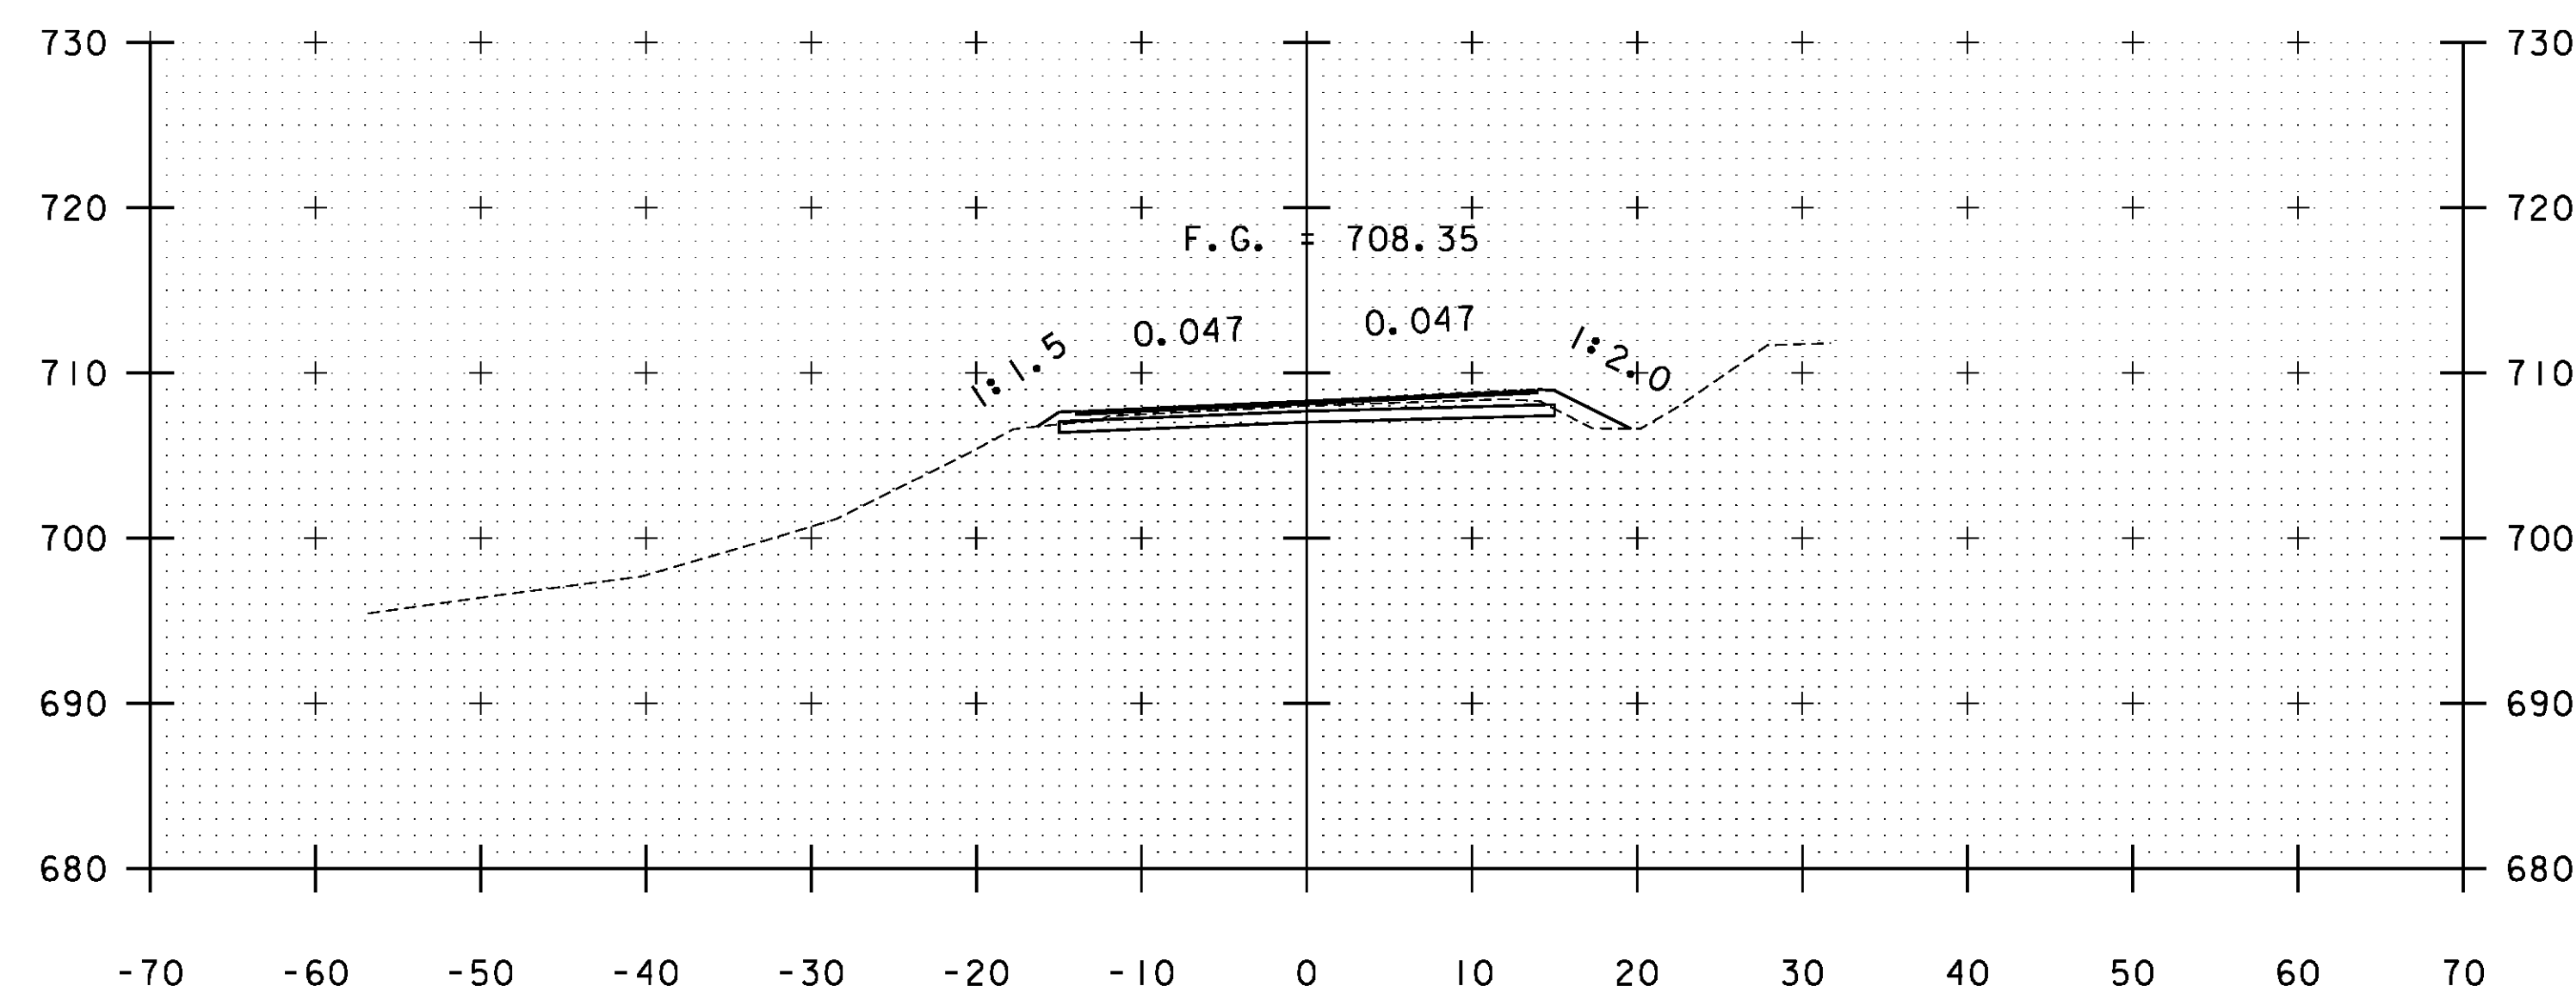

B 109+50

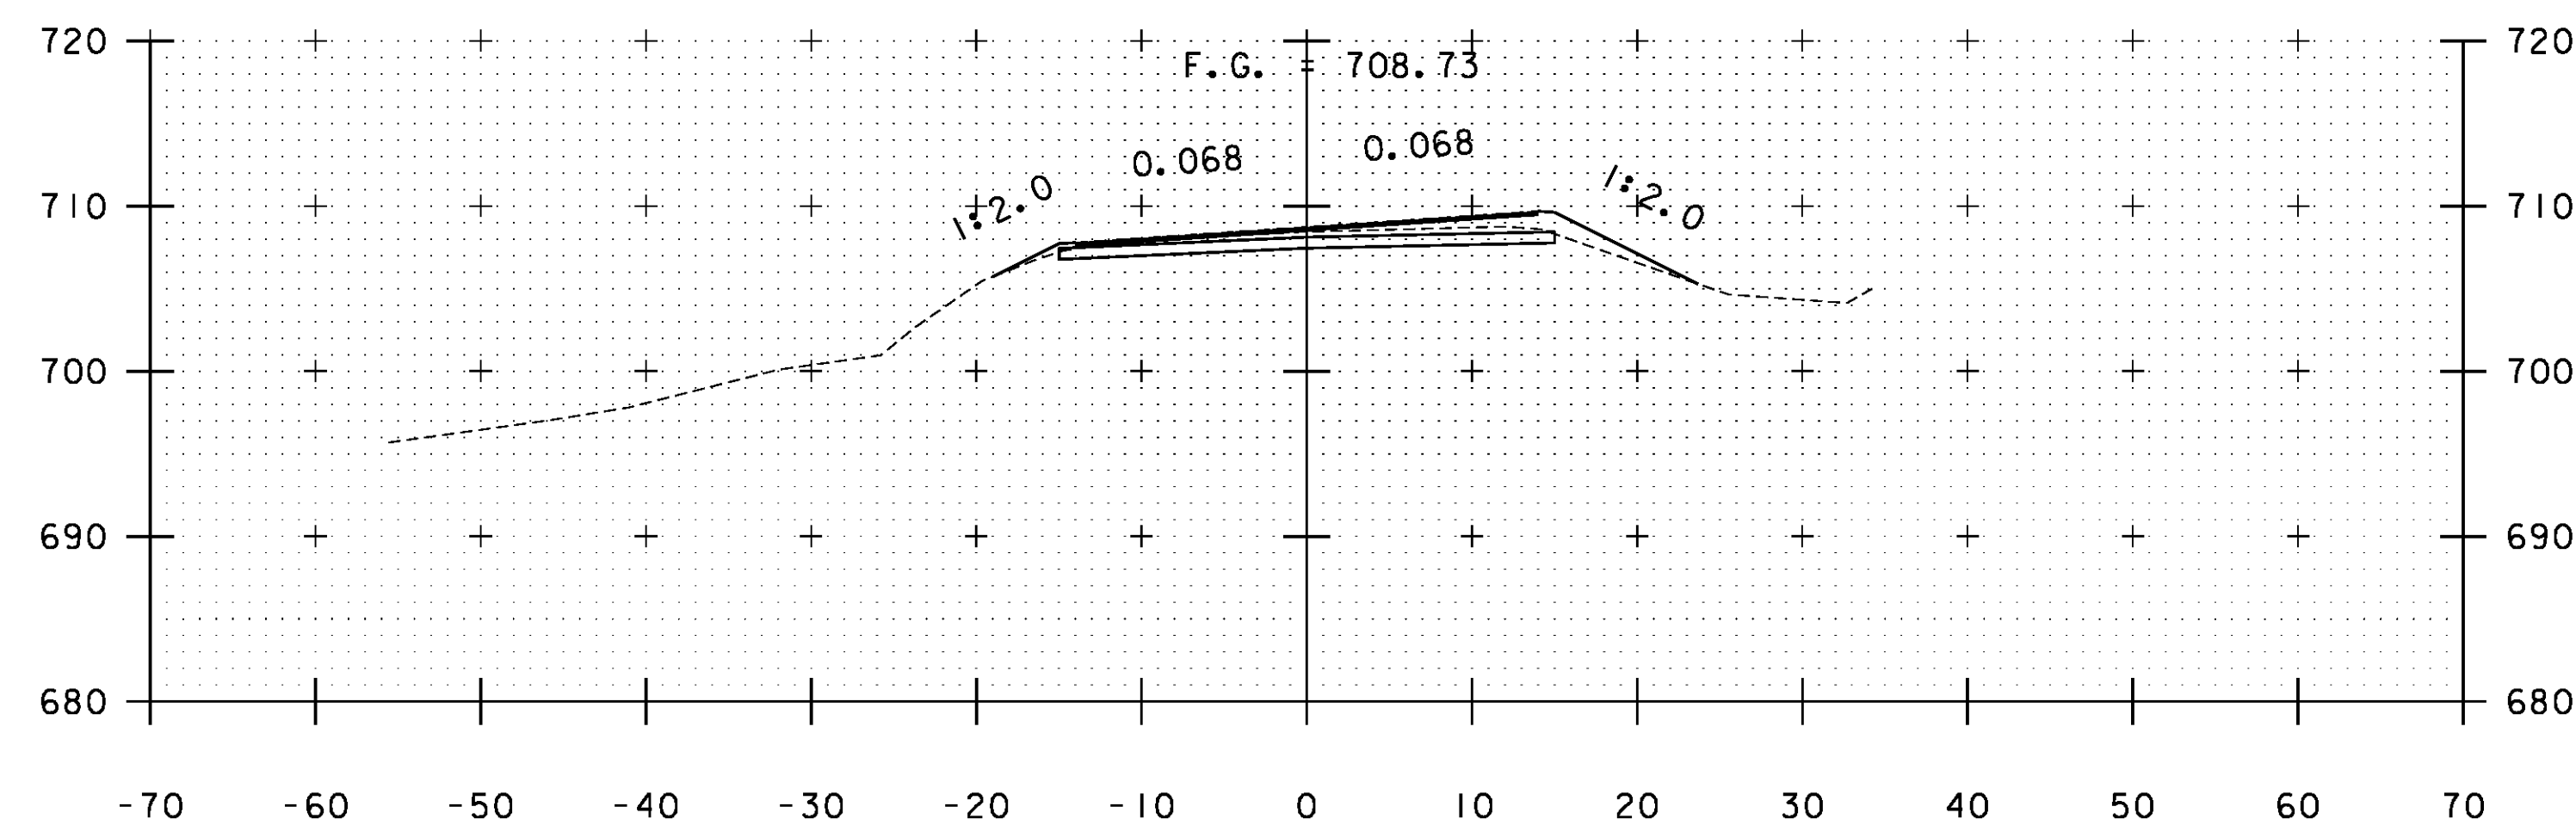

B 109+00

STA. B 108+00 TO STA. B 109+50

PROJECT NAME:	WARDSBORO-JAMAICA	PLOT DATE:	2/26/2014
PROJECT NUMBER:	ER STP 013-1(17)	DRAWN BY:	B. KIPP
FILE NAME:	xs.dgn	CHECKED BY:	HSD
PROJECT LEADER:	K. UPMAL	CROSS SECTIONS	SHEET 368 OF 444
DESIGNED BY:	B. KIPP		