




B 113+47

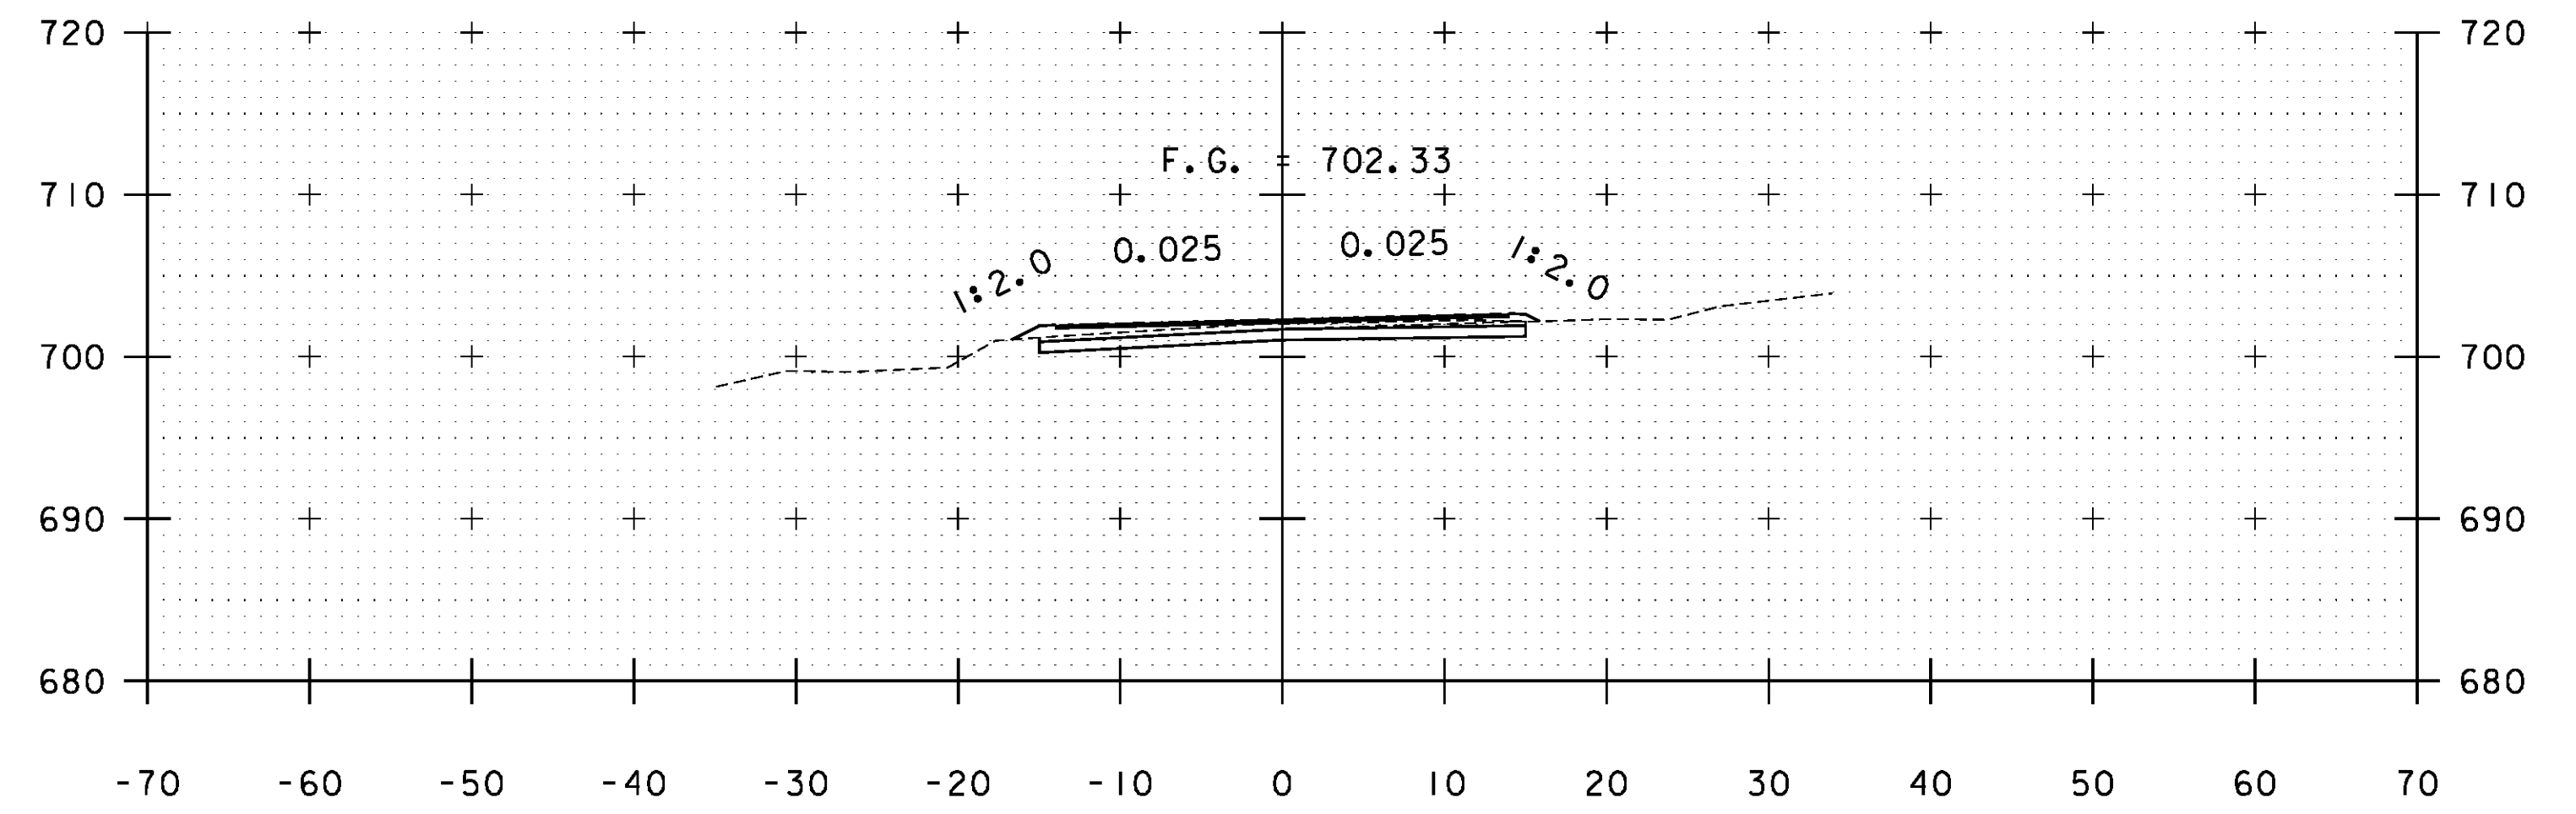


B 114+50

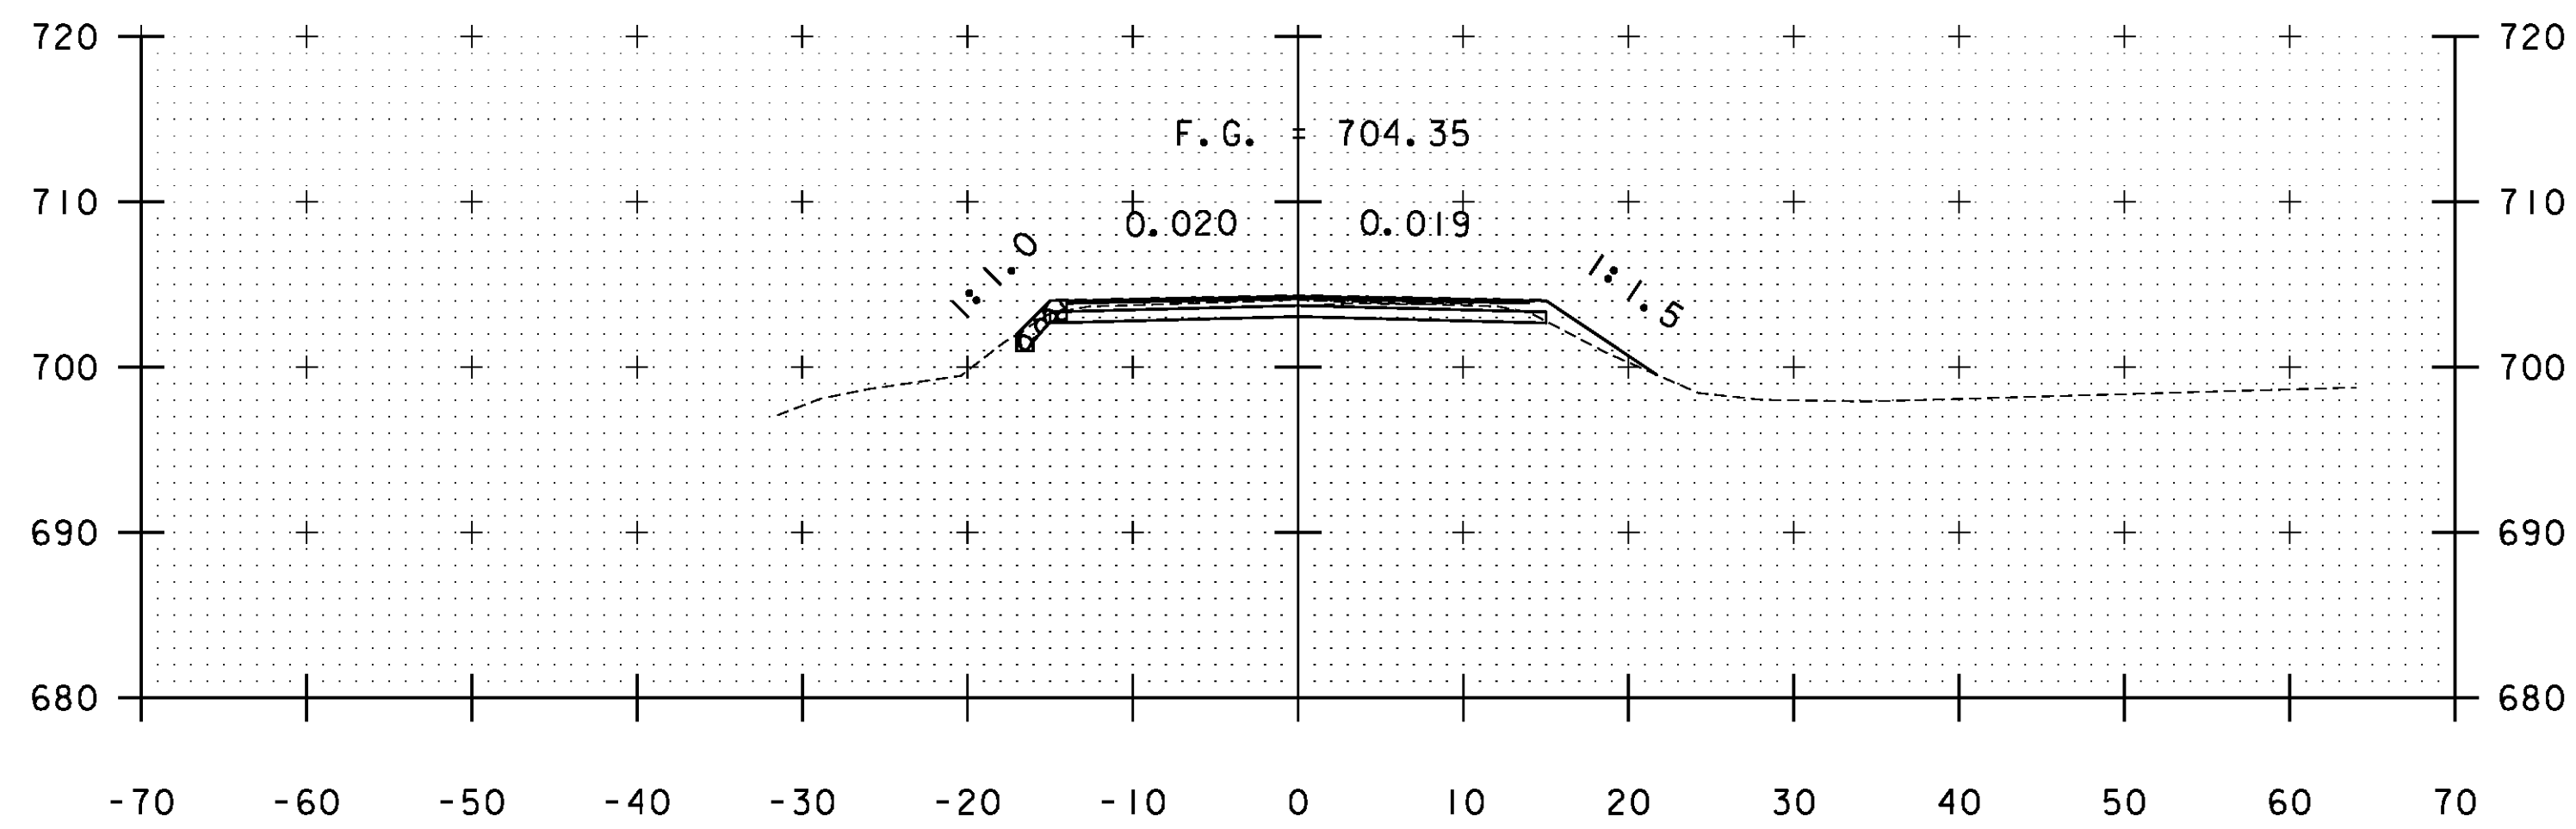


B 113+00

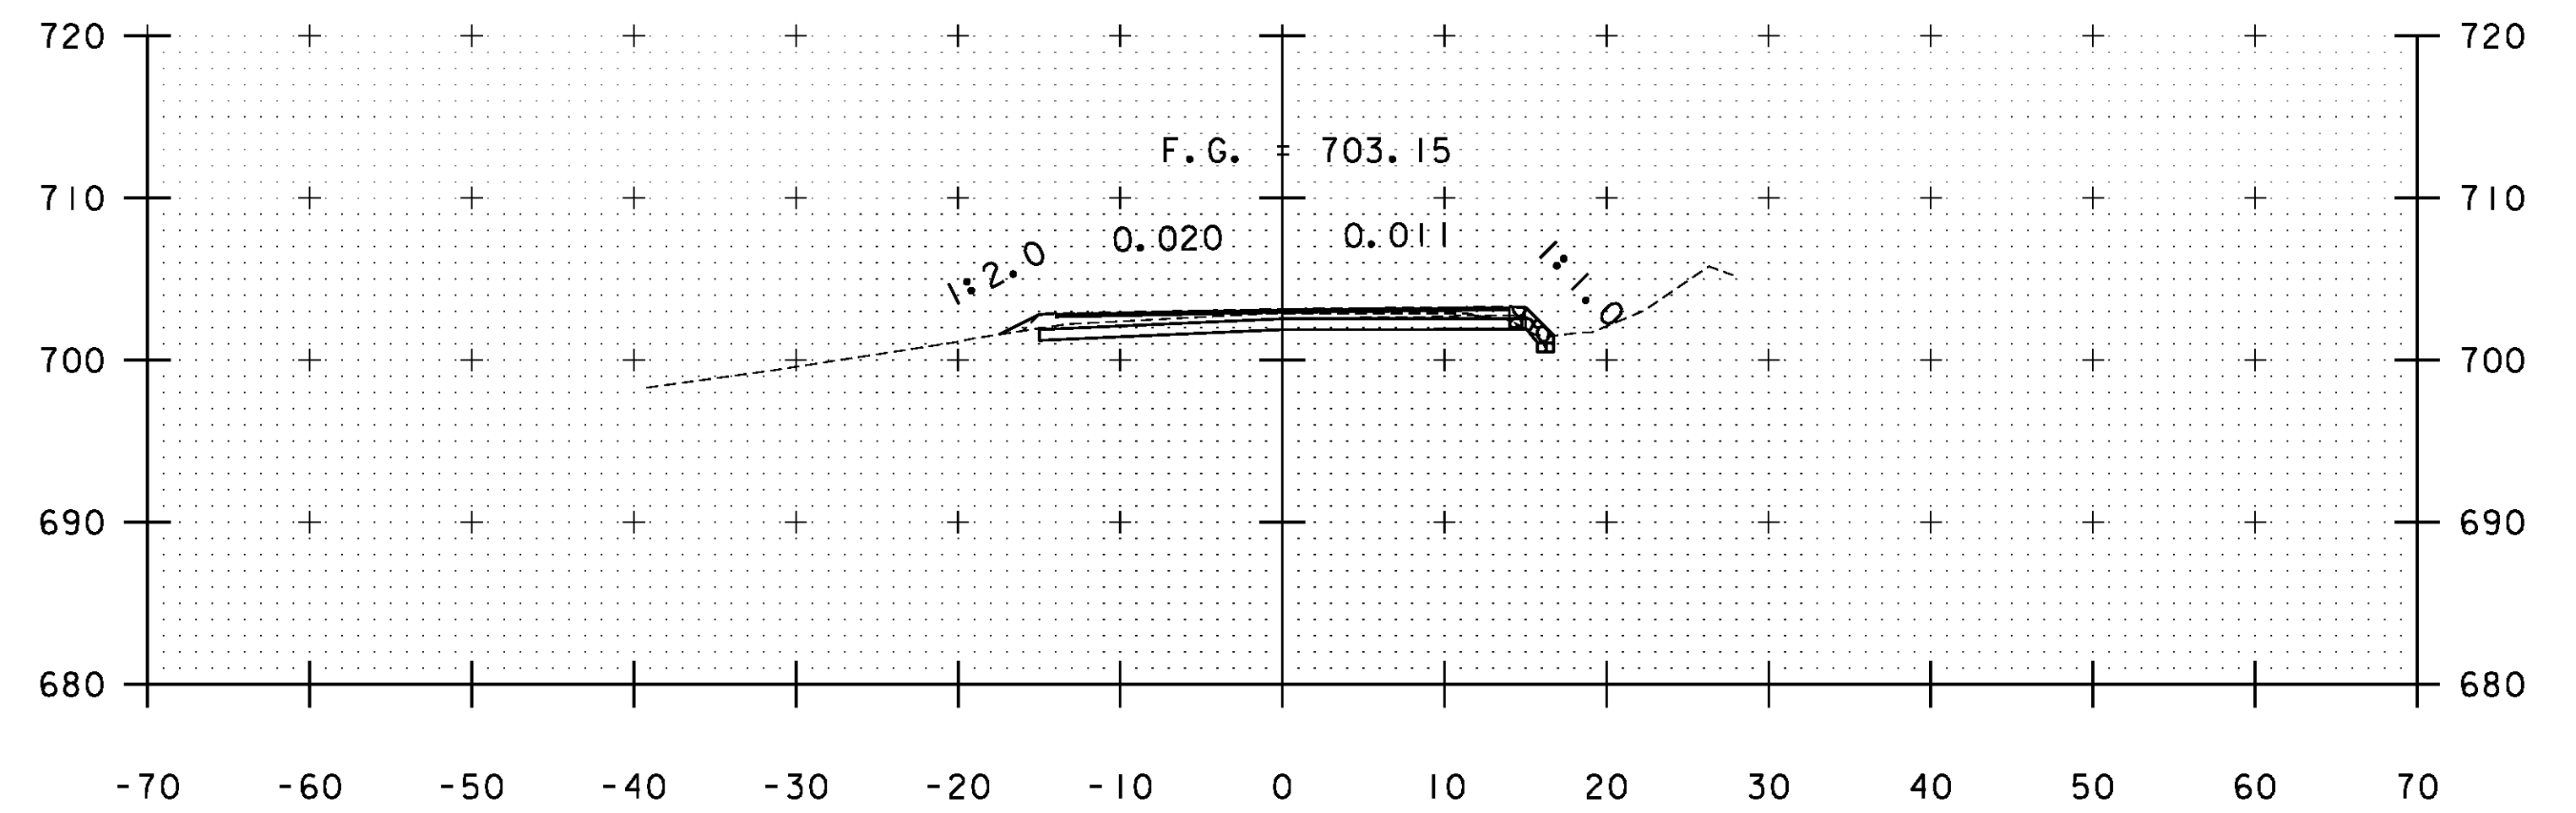

B 114+00

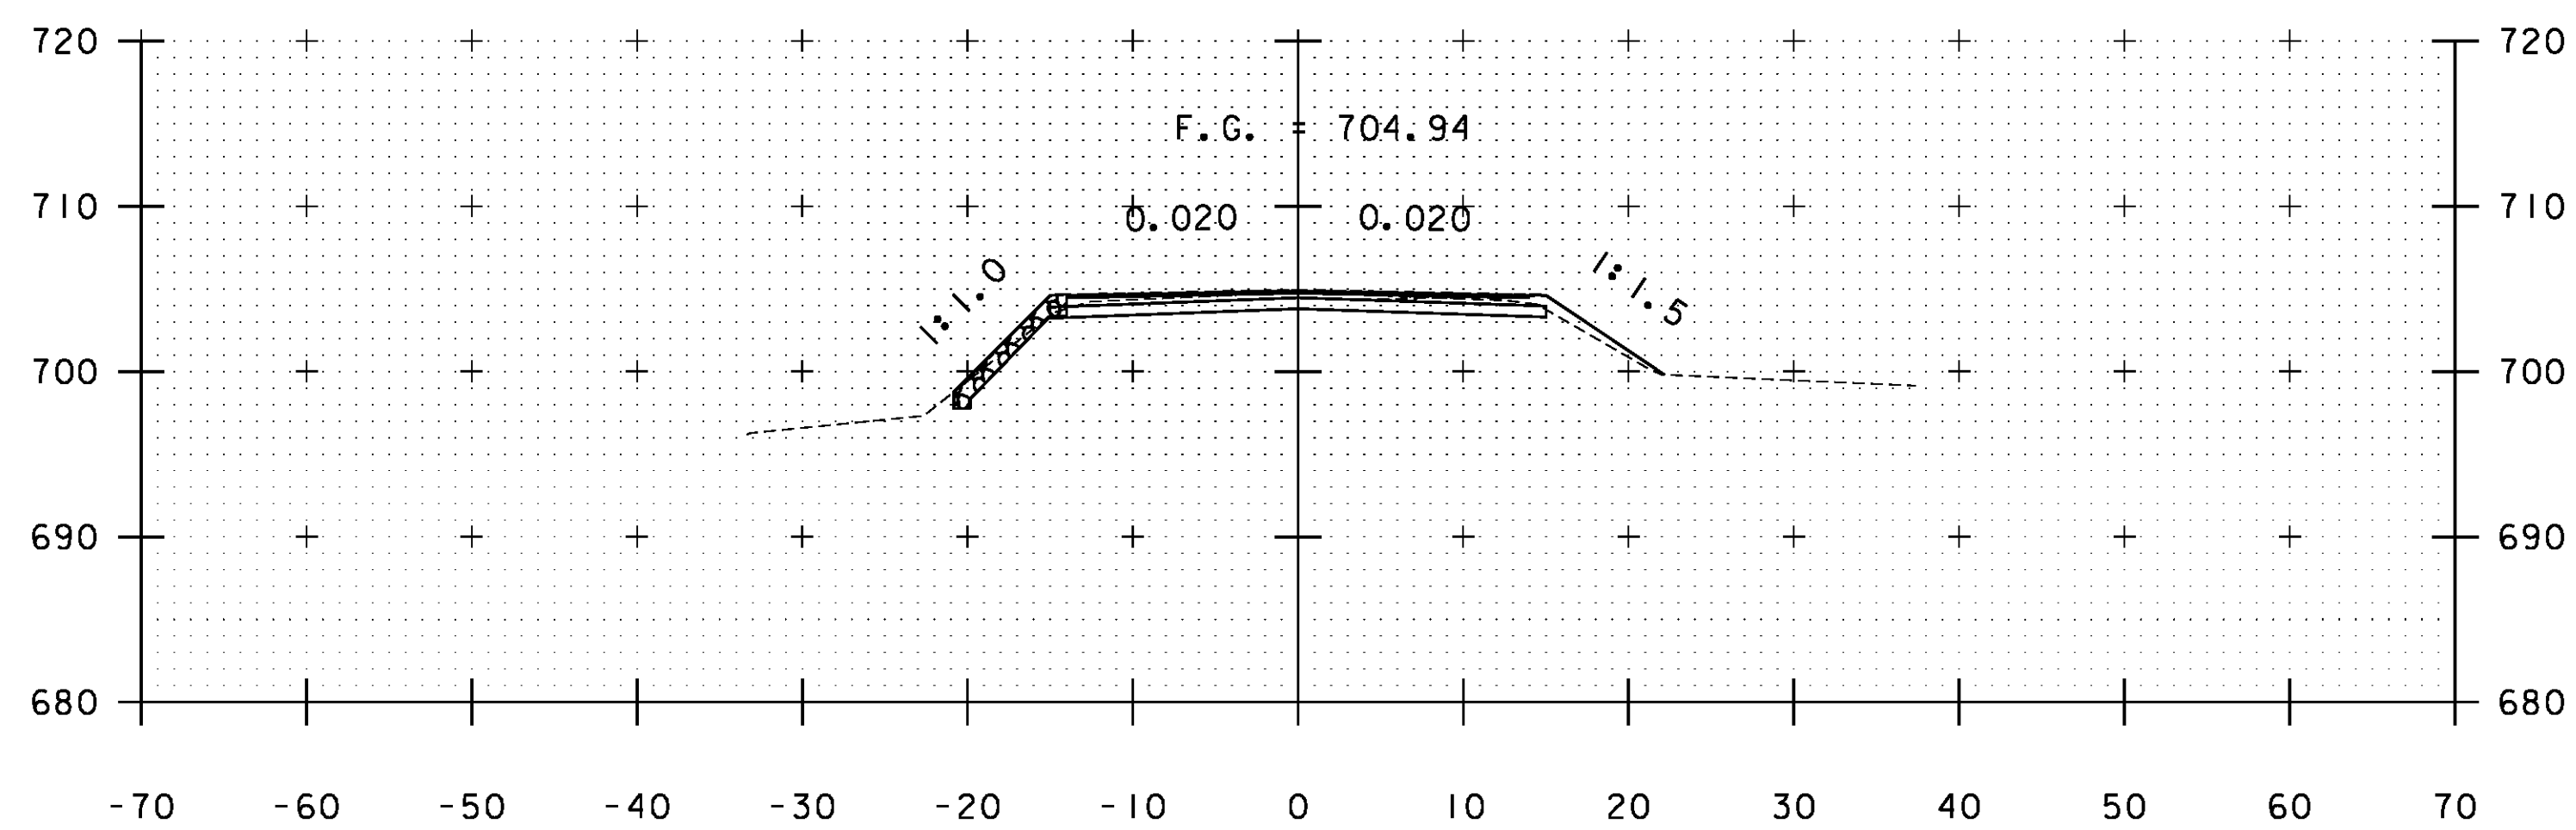

B 112+50

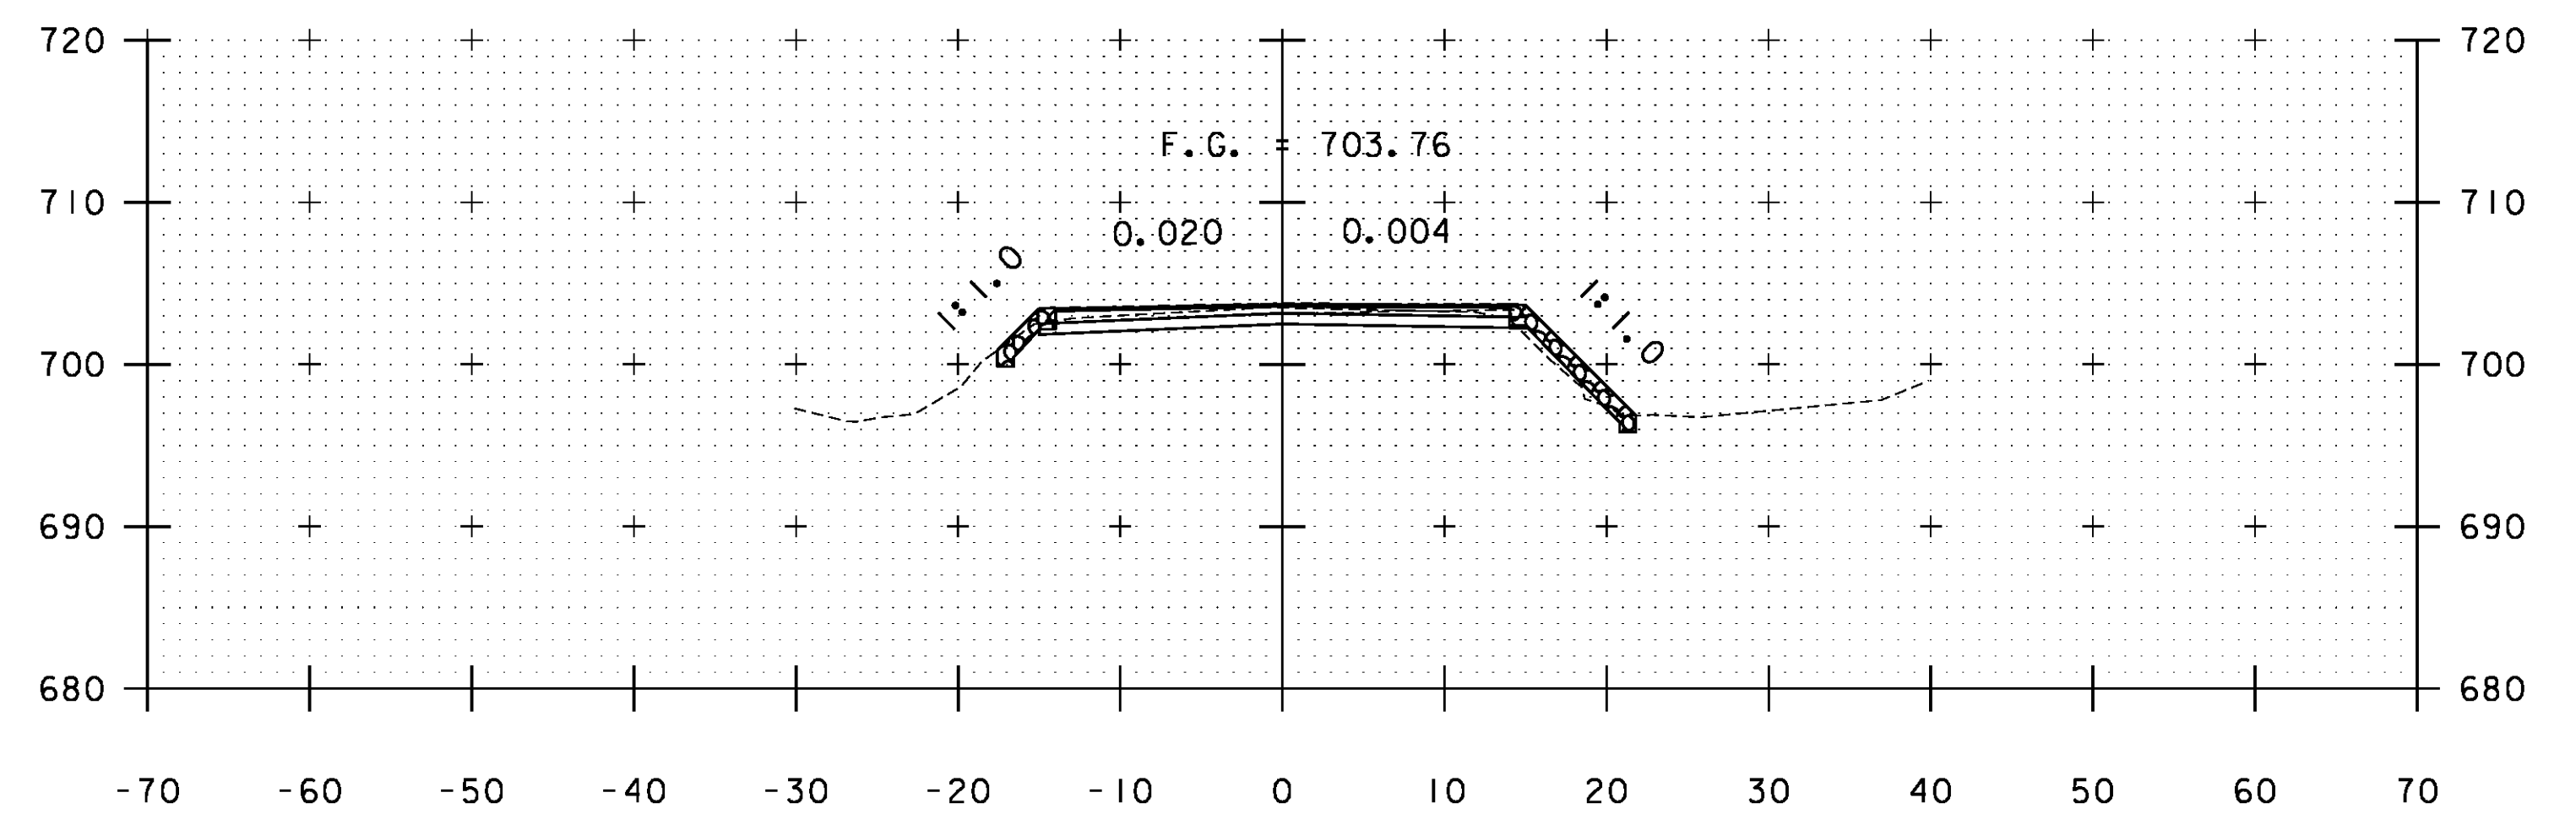

B 113+50

STA. B 112+50 TO STA. B 114+50

PROJECT NAME:	WARDSBORO-JAMAICA
PROJECT NUMBER:	ER STP 013-1(17)
FILE NAME:	xs.dgn
PROJECT LEADER:	K. UPMAL
DESIGNED BY:	B. KIPP
CROSS SECTIONS	
PLOT DATE:	2/26/2014
DRAWN BY:	B. KIPP
CHECKED BY:	HSD
SHEET	370 OF 444