




B 120+24

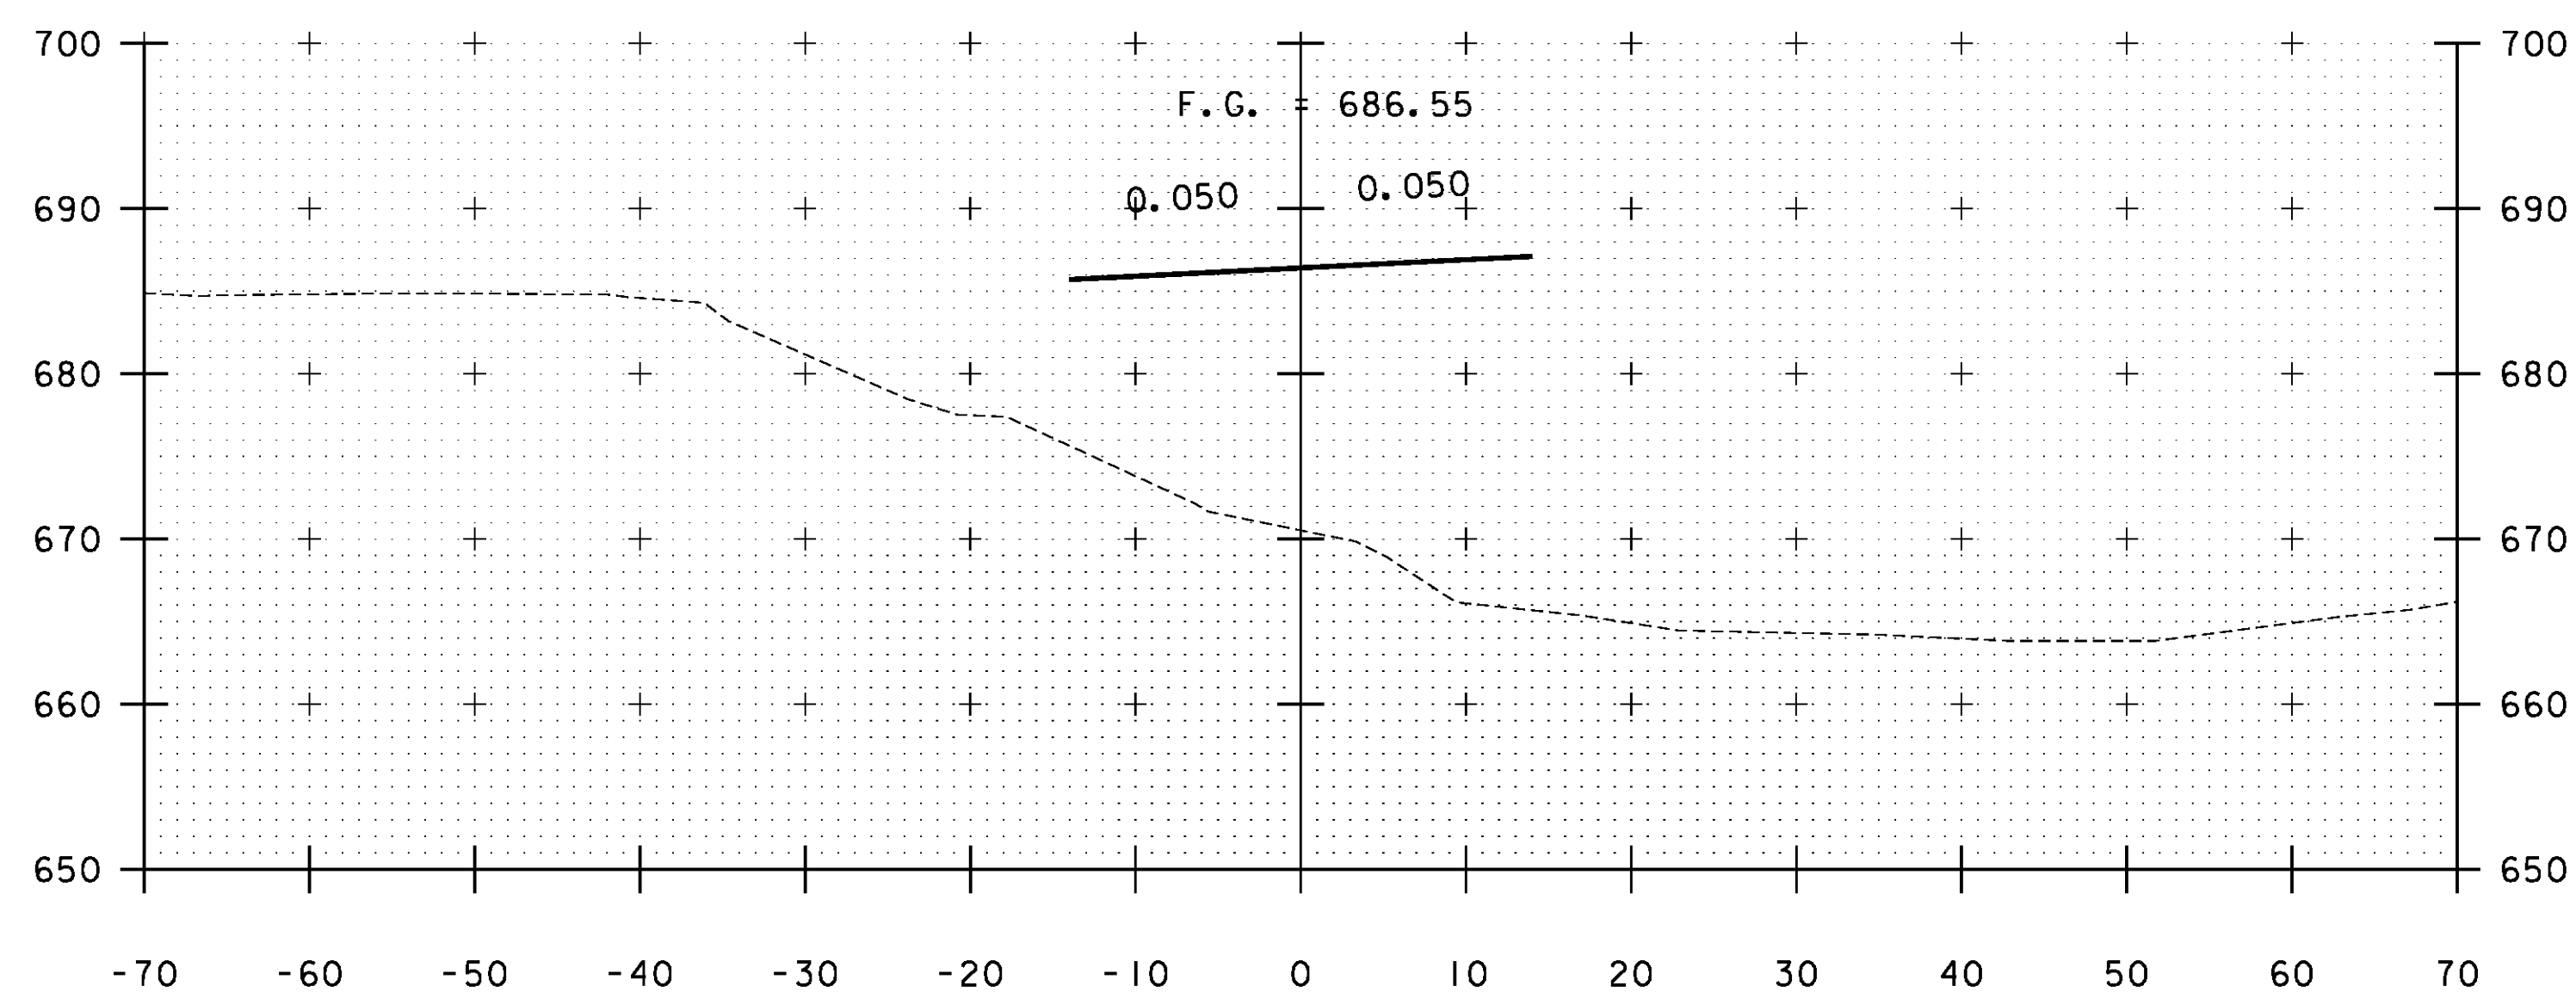

B 121+00

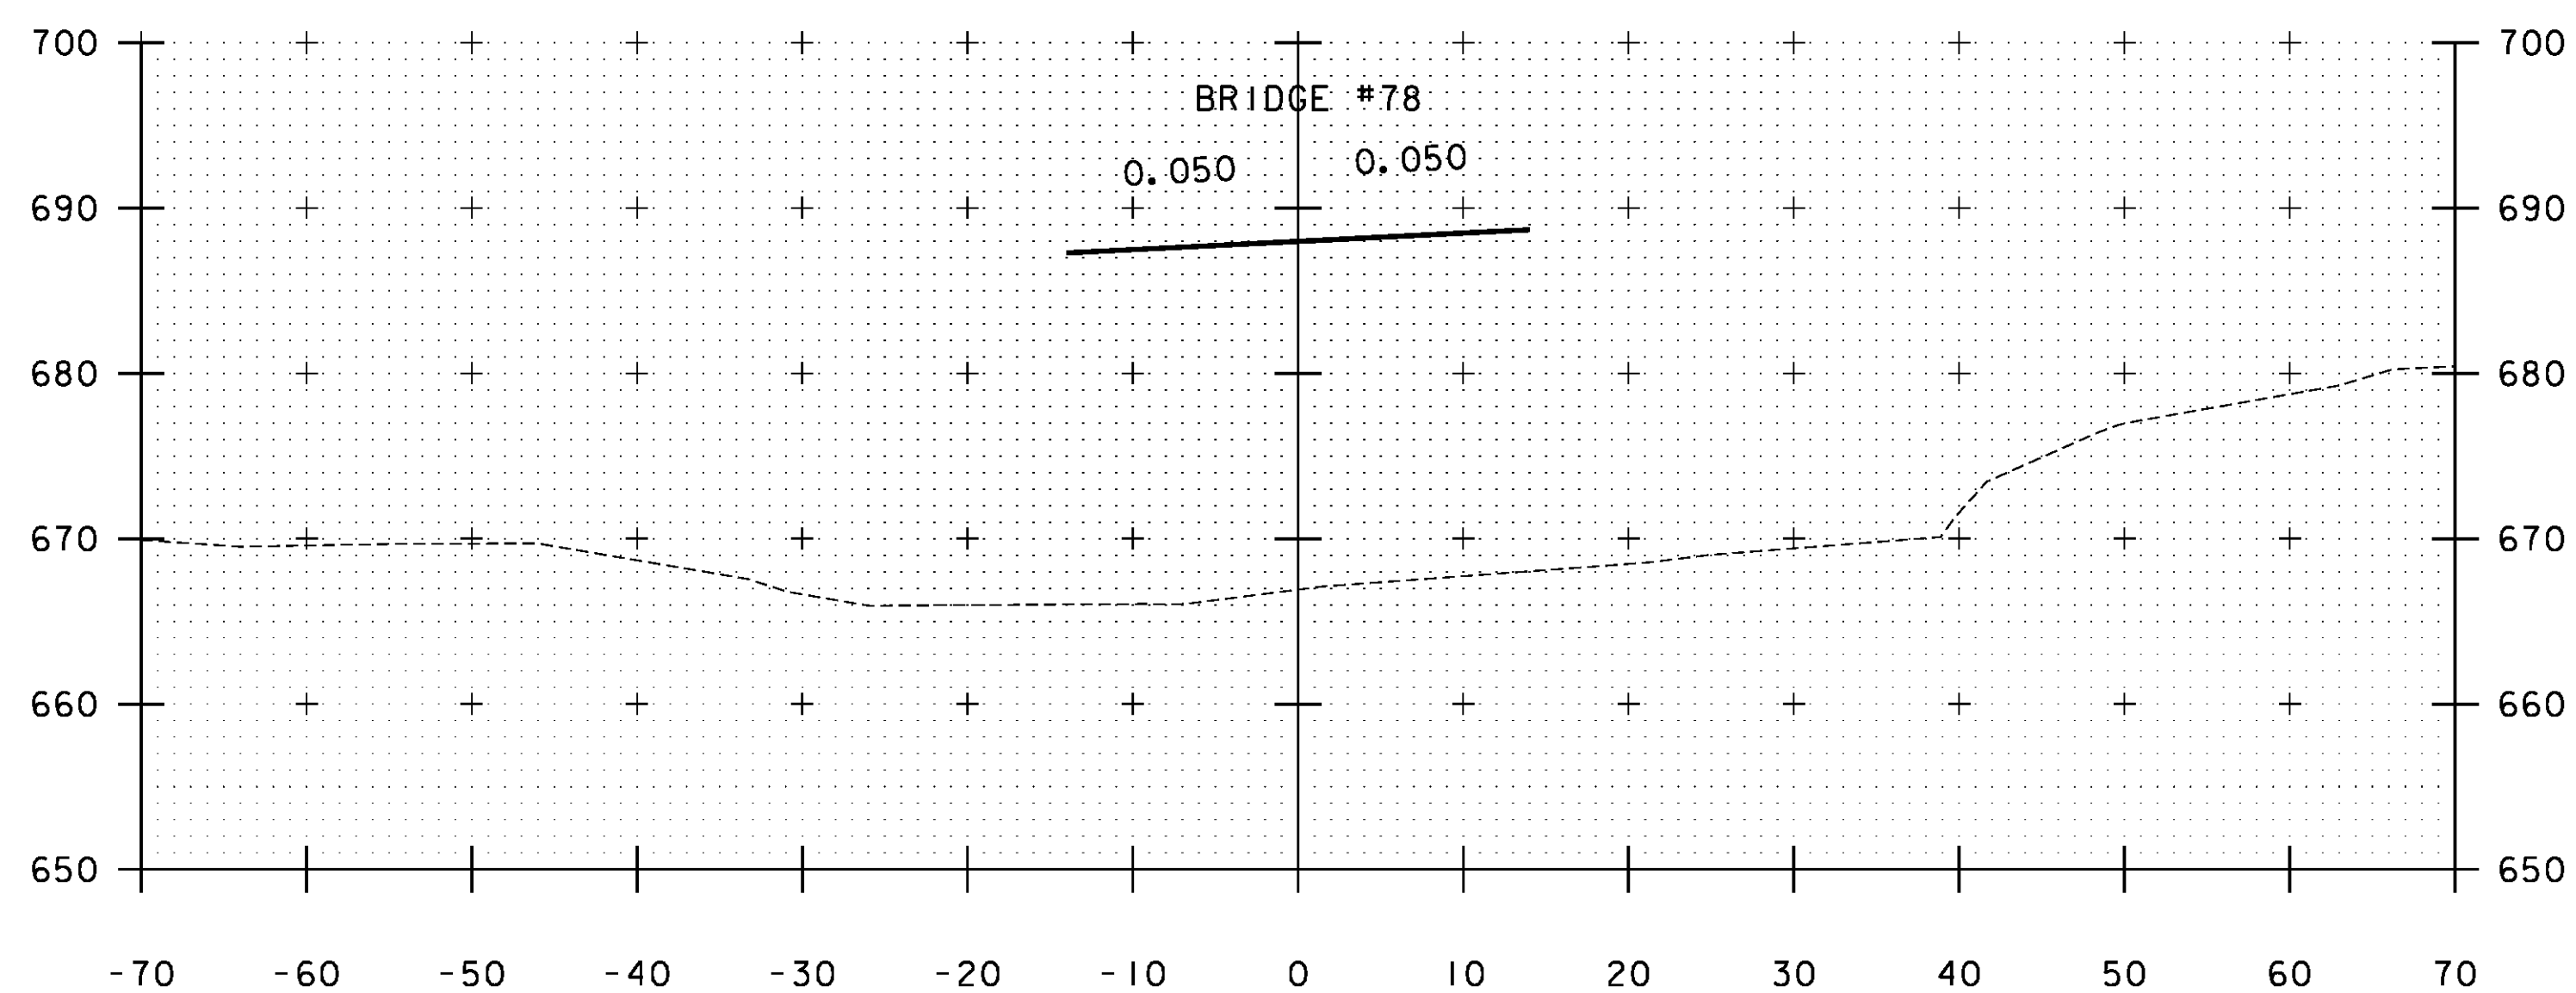

B 120+00

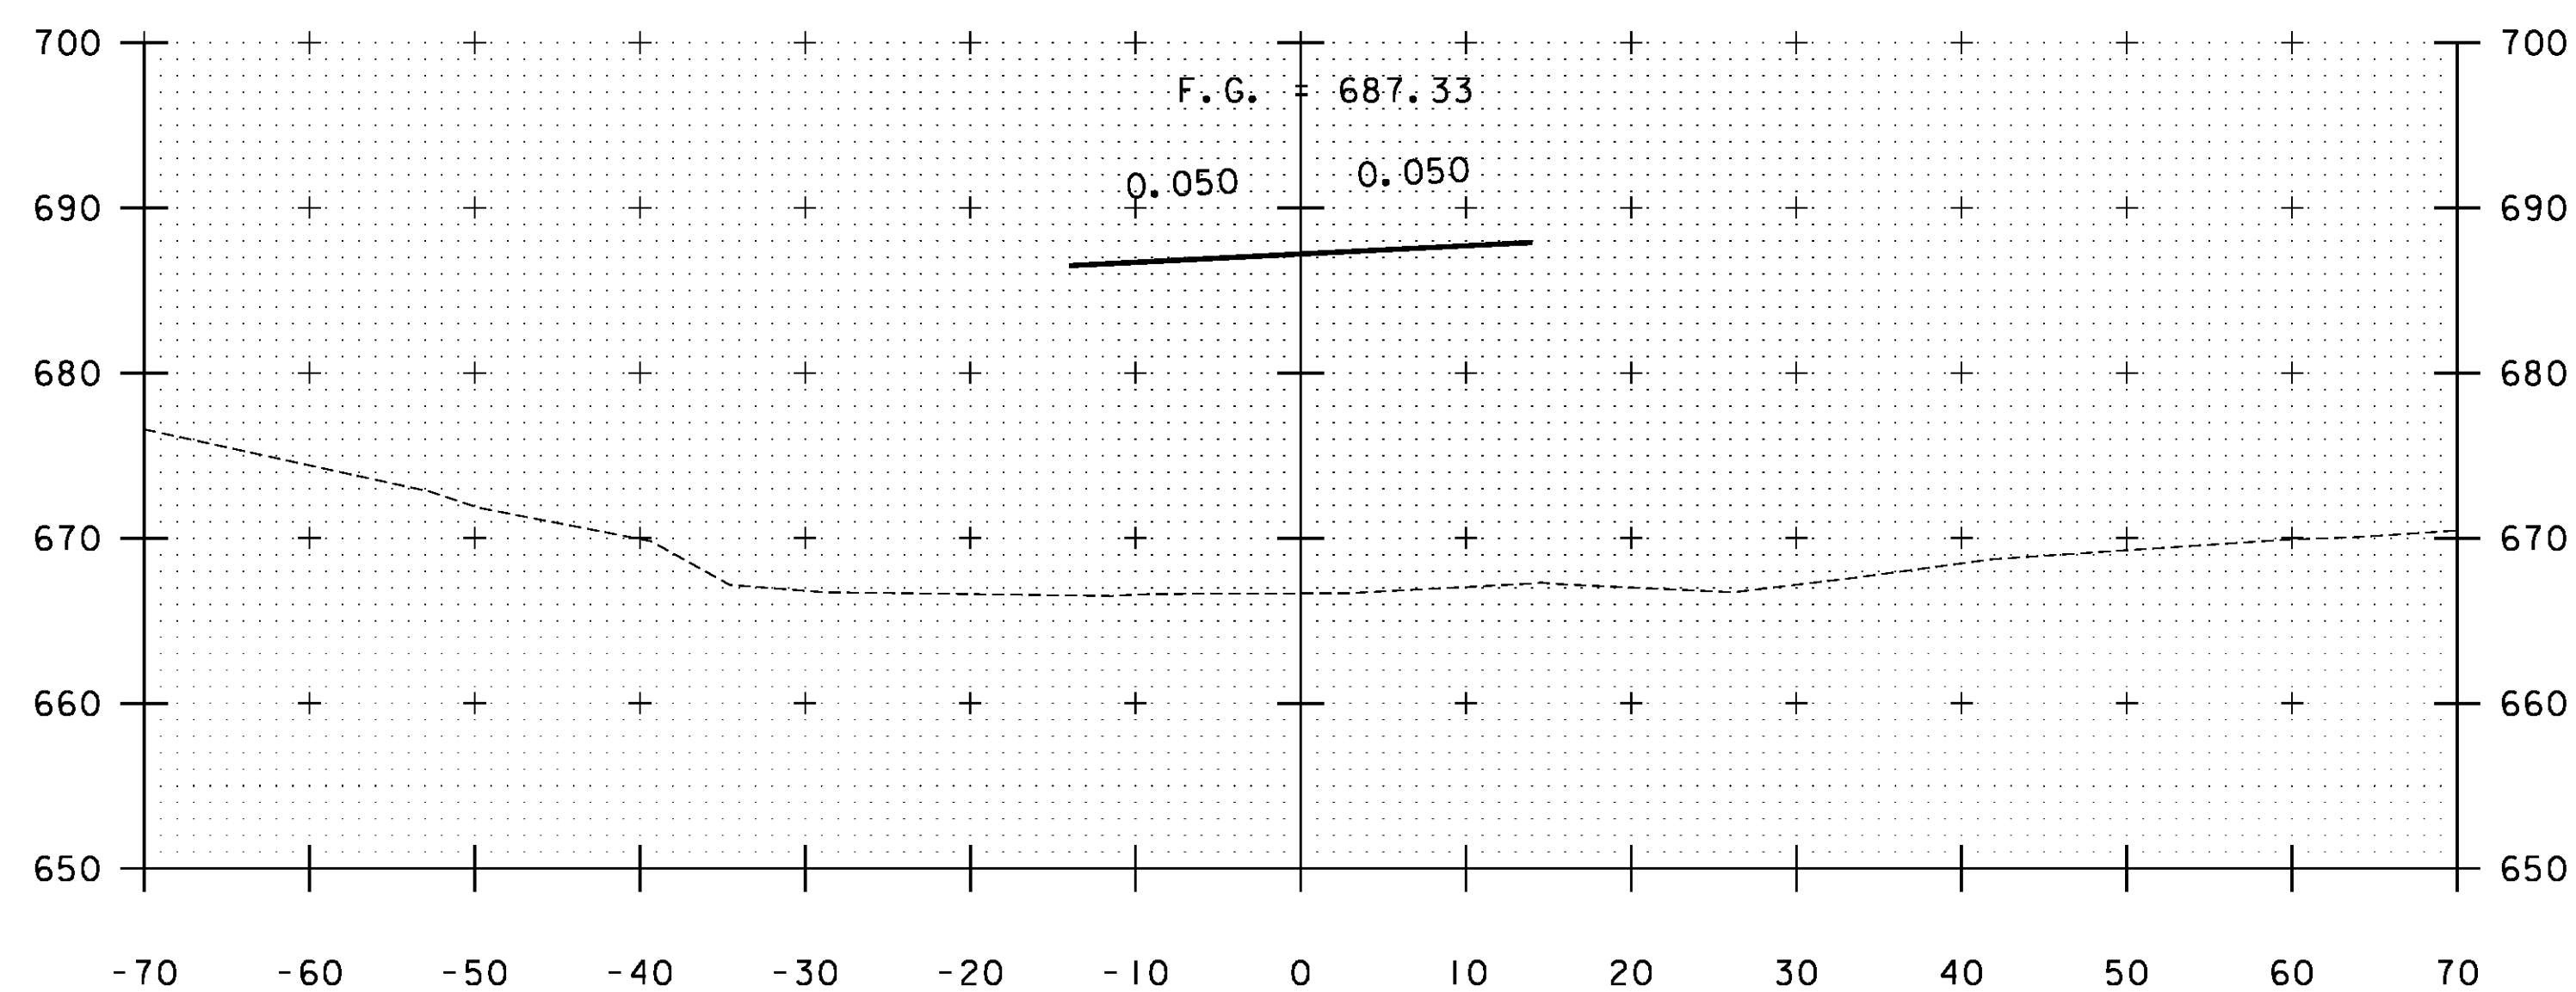

B 120+50

STA. B 120+00 TO STA. B 121+00

PROJECT NAME: WARDBORO-JAMAICA	PLOT DATE: 2/26/2014
PROJECT NUMBER: ER STP 013-1(17)	DRAWN BY: B. KIPP
FILE NAME: xs.dgn	CHECKED BY: HSD
PROJECT LEADER: K. UPMAL	SHEET 373 OF 444
DESIGNED BY: B. KIPP	
CROSS SECTIONS	