




B 124+50

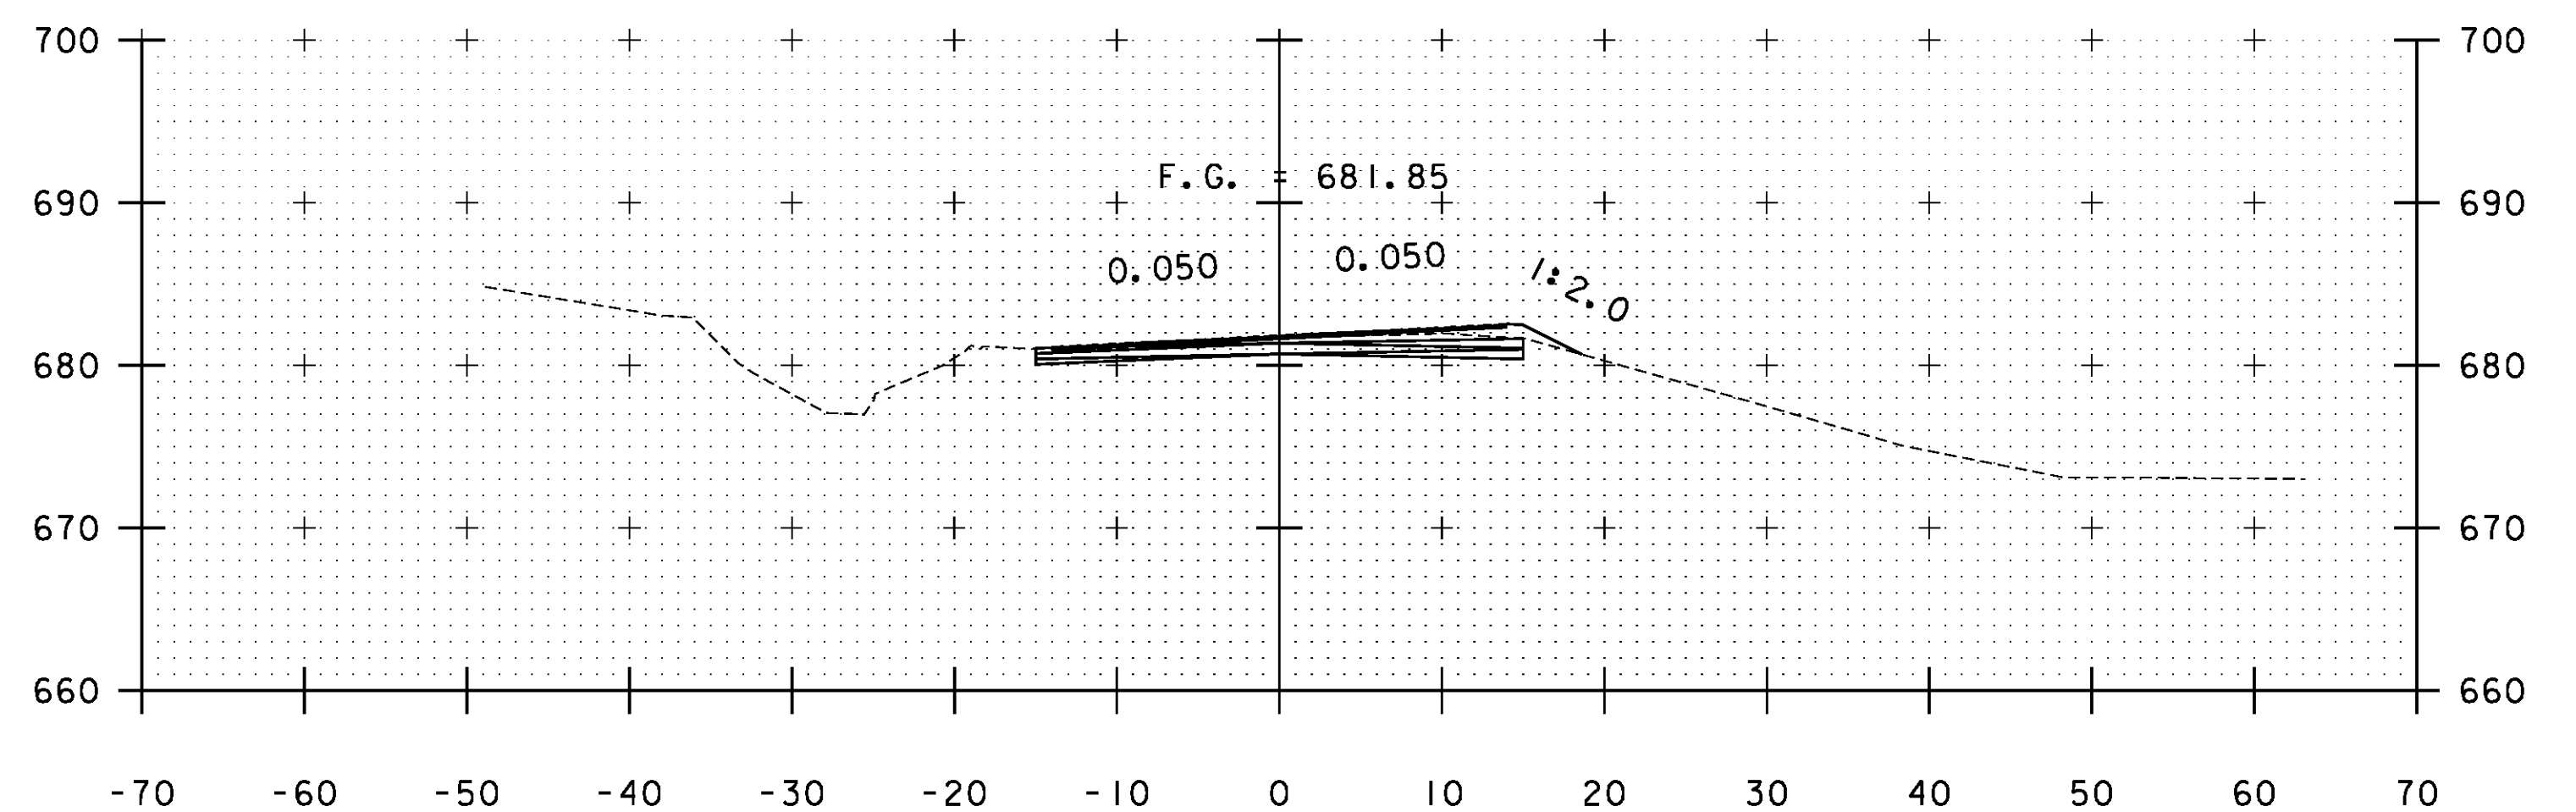


B 124+00

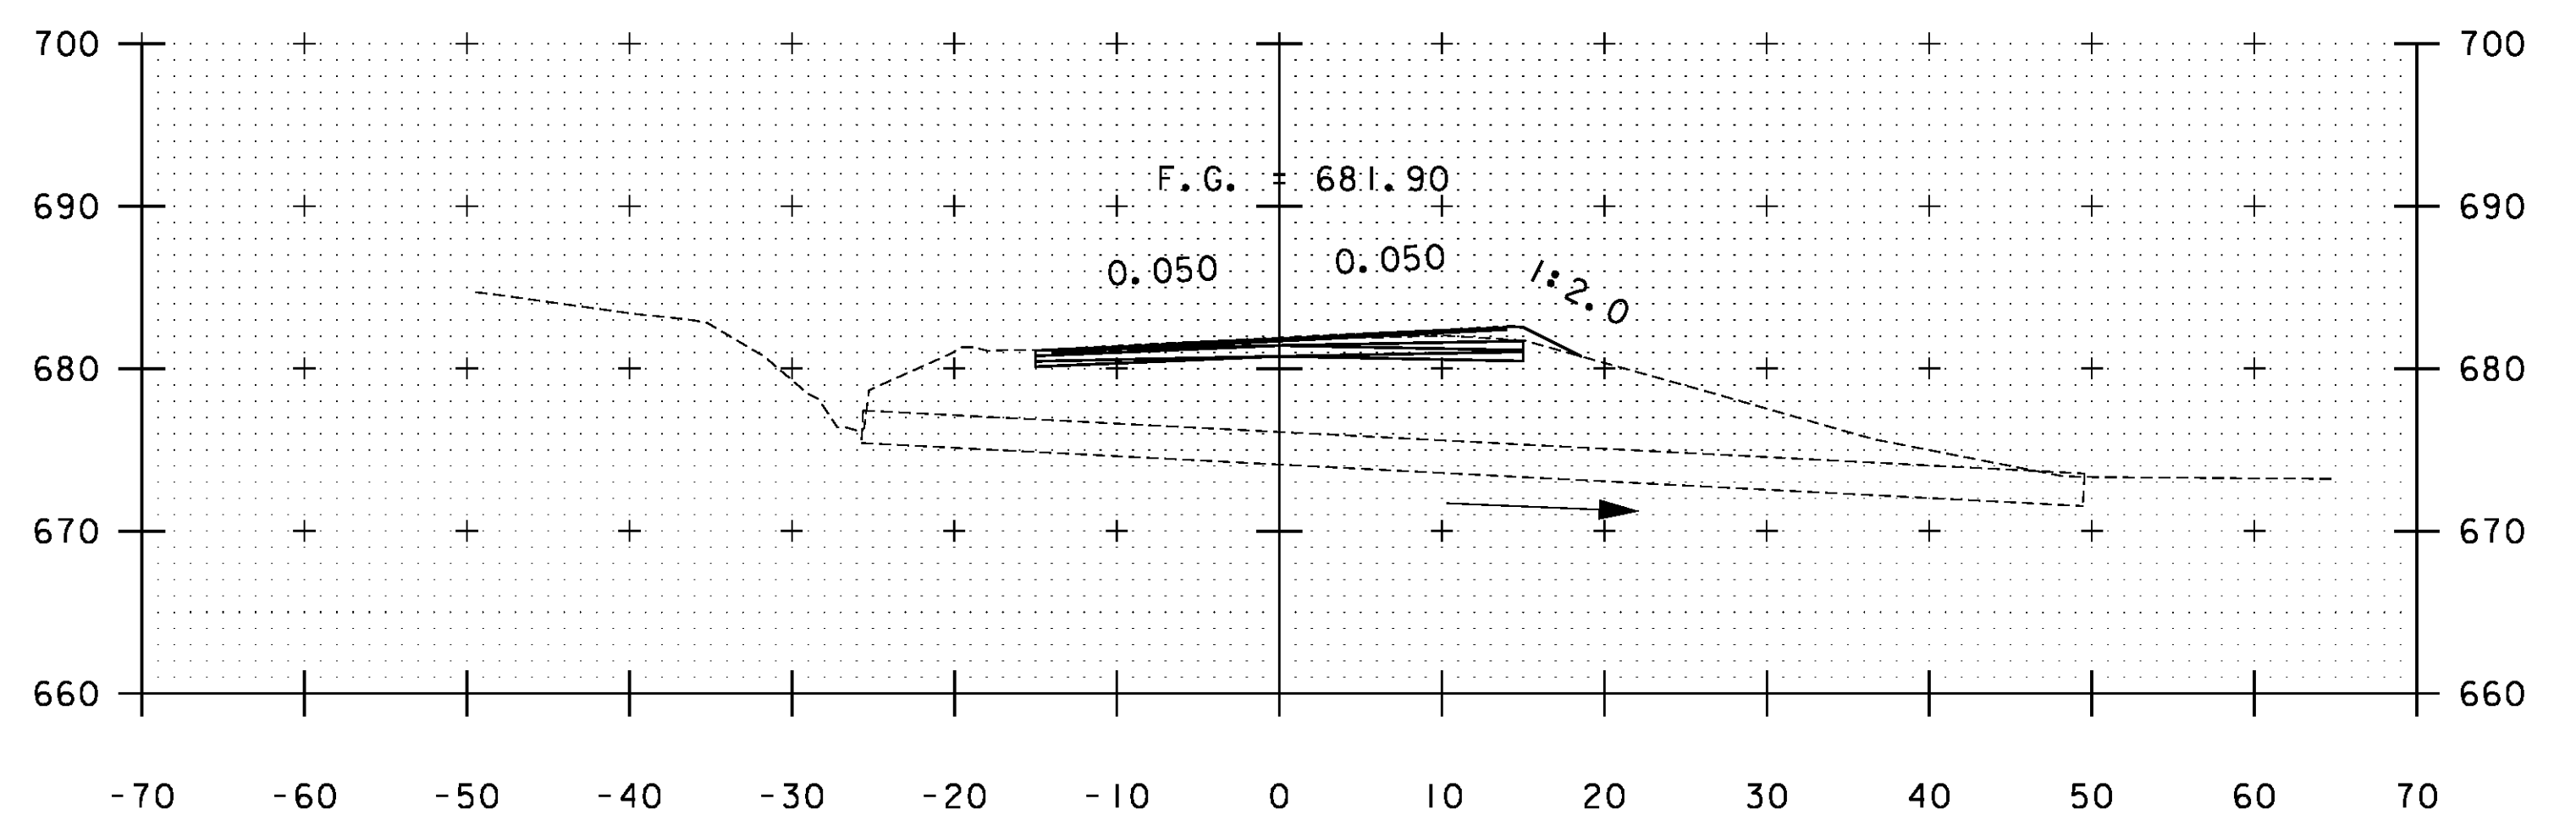

B 123+97

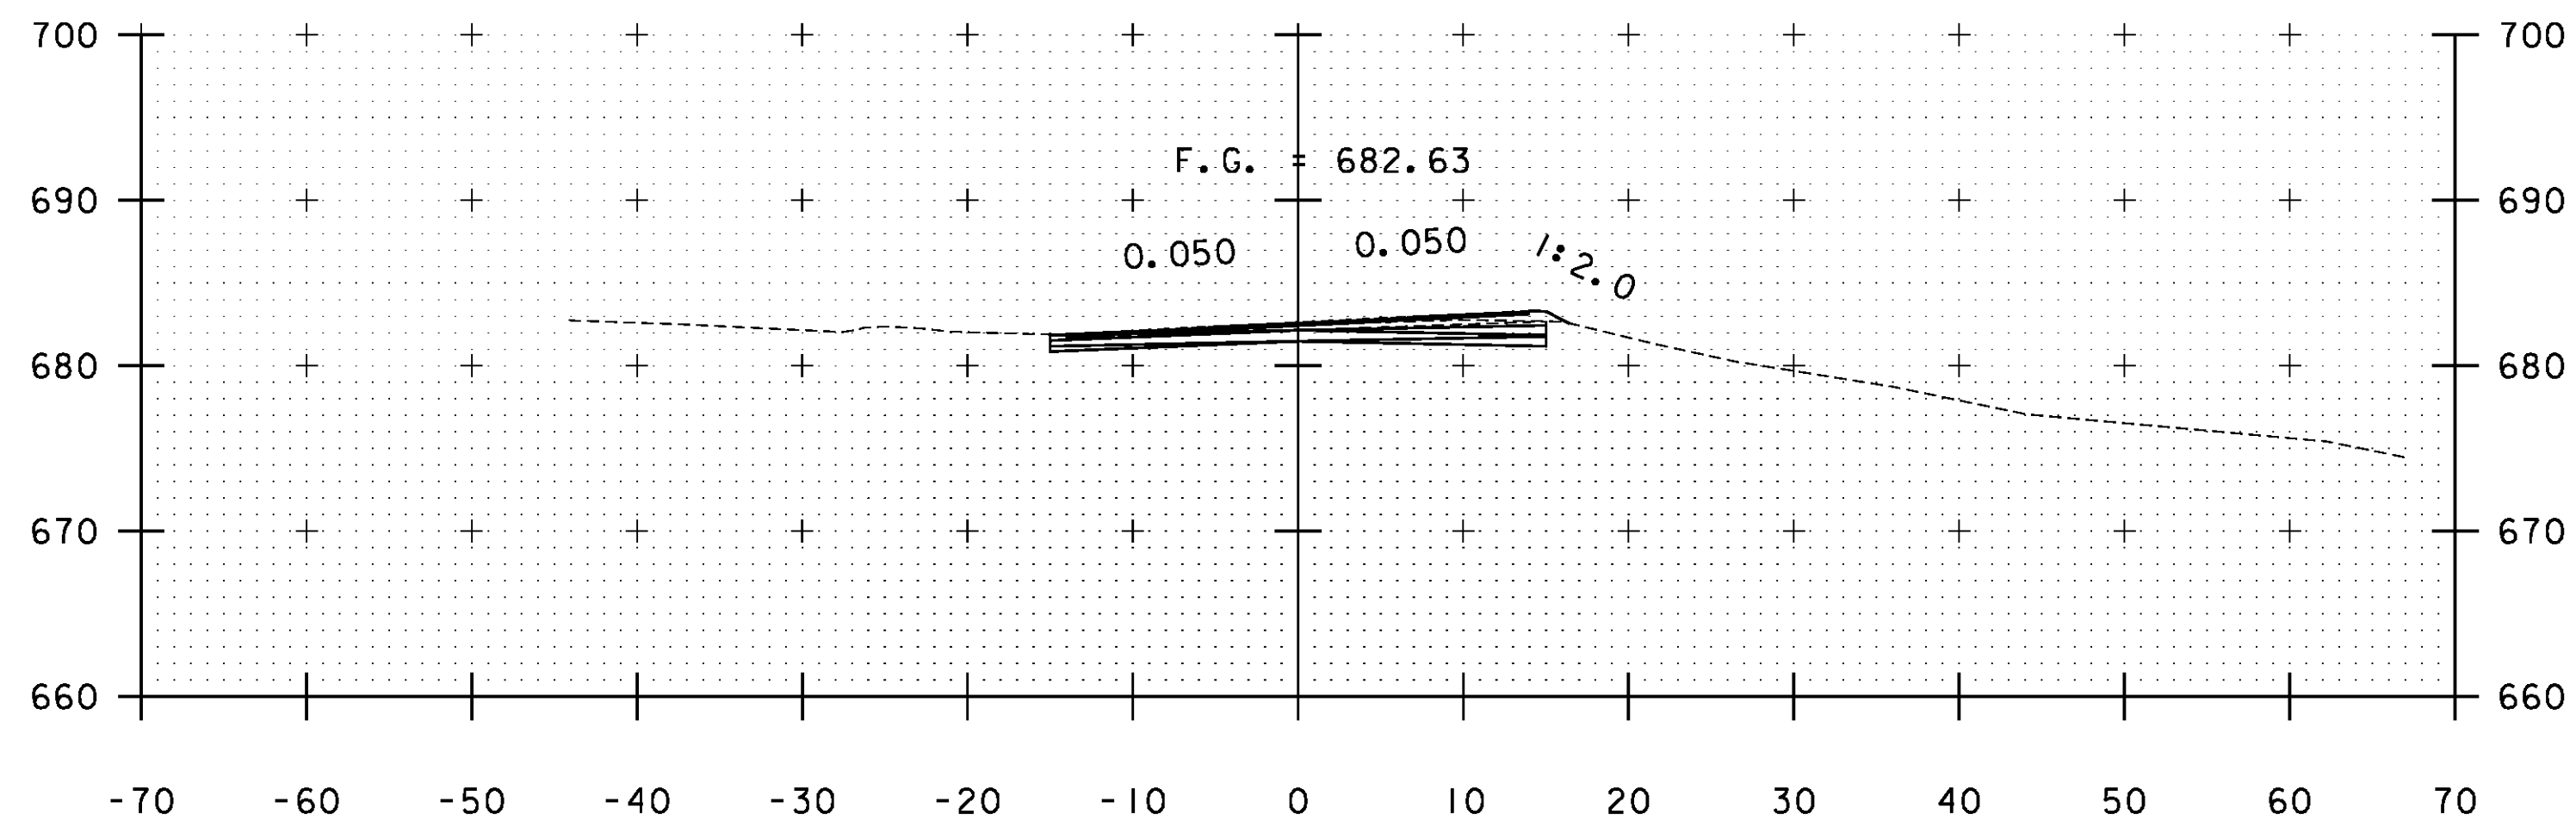

B 123+50

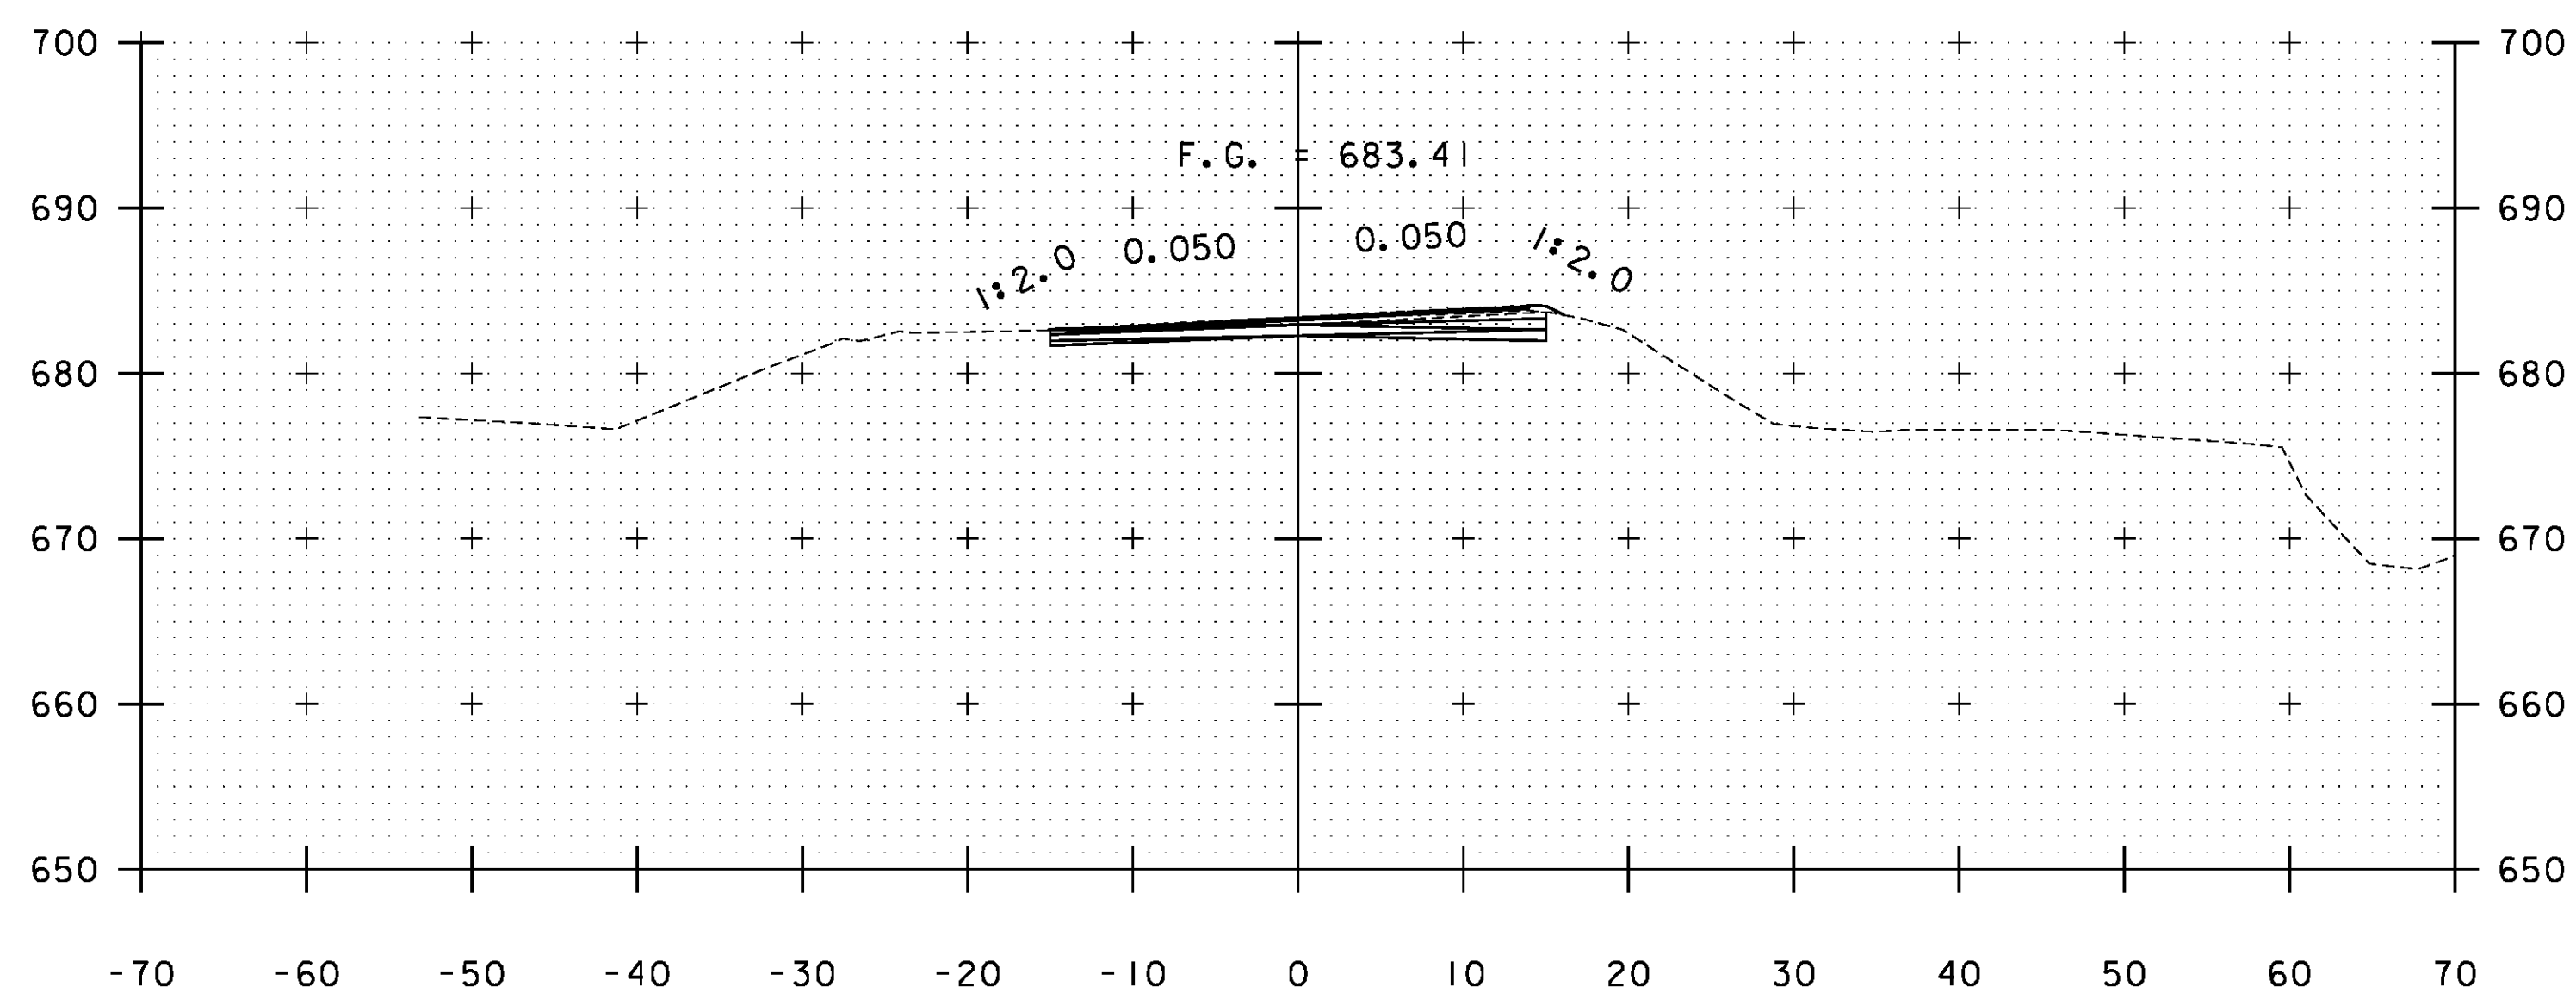

B 123+00

STA. B 123+00 TO STA. B 124+50

PROJECT NAME:	WARDSBORO-JAMAICA	PLOT DATE:	2/26/2014
PROJECT NUMBER:	ER STP 013-1(17)	DRAWN BY:	B. KIPP
FILE NAME:	xs.dgn	CHECKED BY:	HSD
PROJECT LEADER:	K. UPMAL	CROSS SECTIONS	SHEET 375 OF 444
DESIGNED BY:	B. KIPP		