




B 133+41

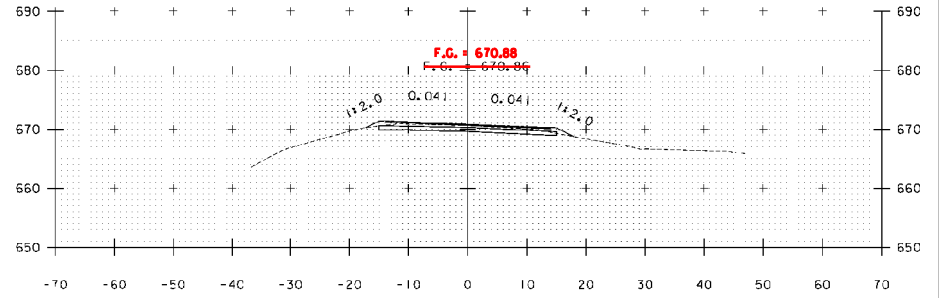


B 133+00

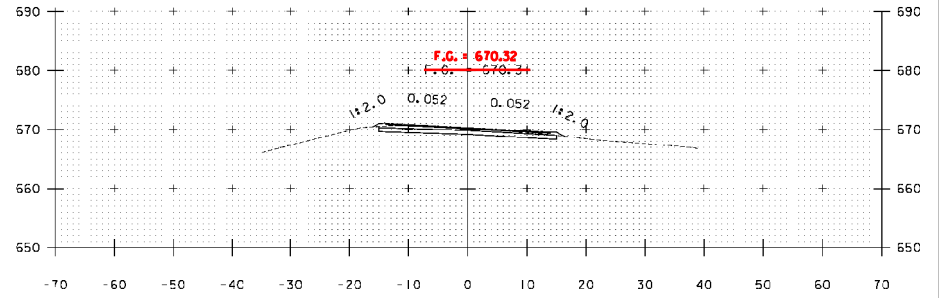

B 132+50

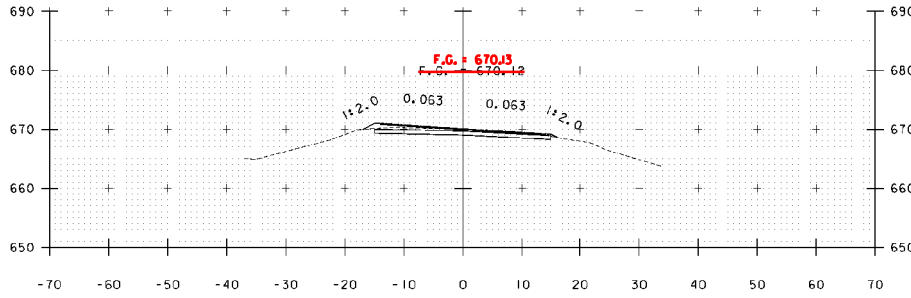

B 132+00

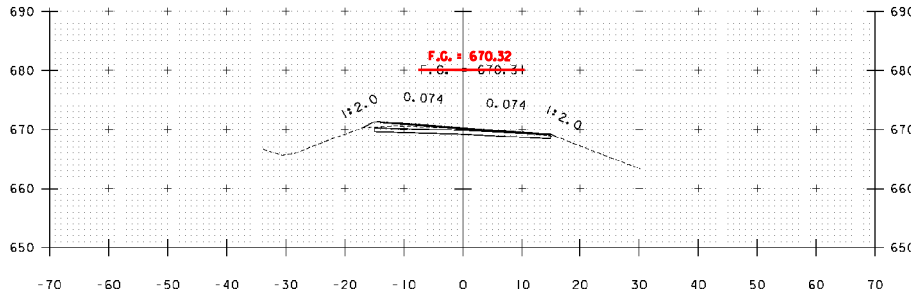

B 131+50

STA. B 131+50 TO STA. B 133+41

|                 |                   |
|-----------------|-------------------|
| PROJECT NAME:   | WARDSBORO-JAMAICA |
| PROJECT NUMBER: | ER STP 013-1(17)  |
| FILE NAME:      | xs.dgn            |
| PROJECT LEADER: | K. LPMAL          |
| DESIGNED BY:    | E. KIPP           |
| CROSS SECTIONS  |                   |
| PLLOT DATE:     | 2/26/2014         |
| DRAWN BY:       | B. KIPP           |
| CHECKED BY:     | HSD               |
| SHEET           | 379 OF 444        |