




B 136+00

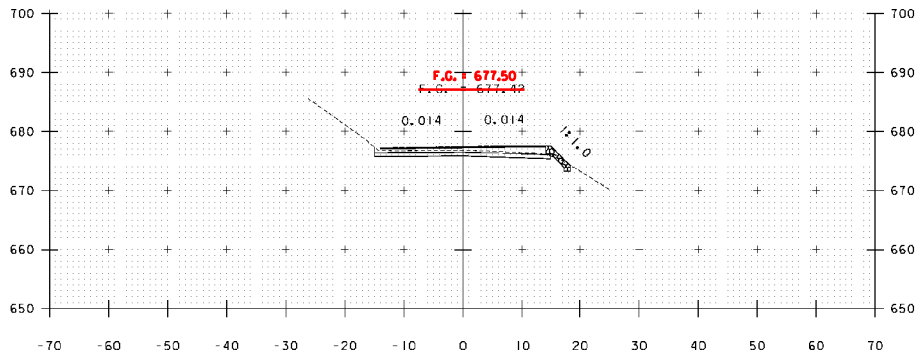


B 135+50

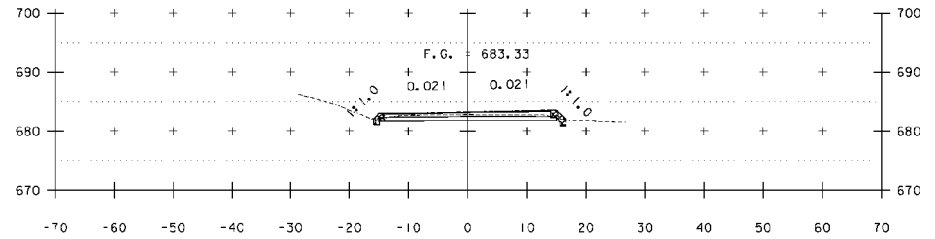

B 137+50

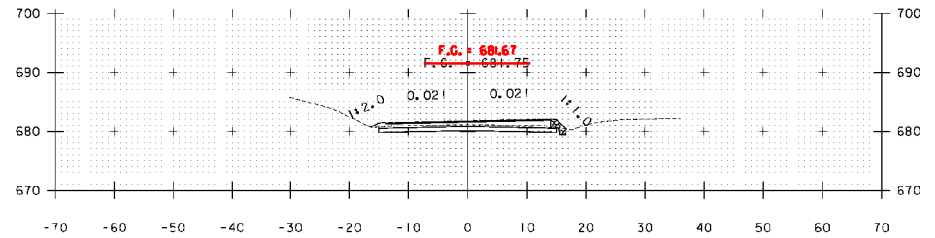

B 137+00

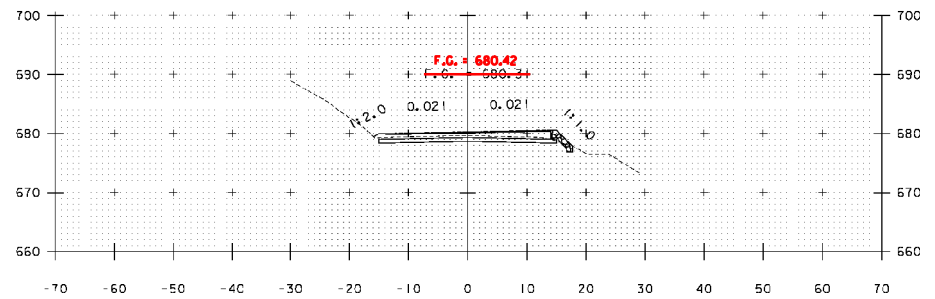

B 136+50

PROJECT NAME:	WARDSBORO-JAMAICA
PROJECT NUMBER:	ER STP 013-1(17)
FILE NAME:	xs.dgn
PROJECT LEADER:	K. LPMAL
DESIGNED BY:	E. KIPP
CROSS SECTIONS	
PLOT DATE:	2/26/2014
DRAWN BY:	B. KIPP
CHECKED BY:	HSD
SHEET	381 OF 444

STA. B 135+50 TO STA. B 137+50