




B 138+50

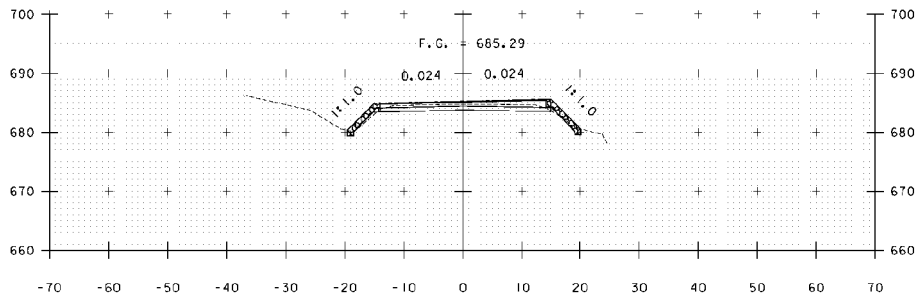


B 138+05

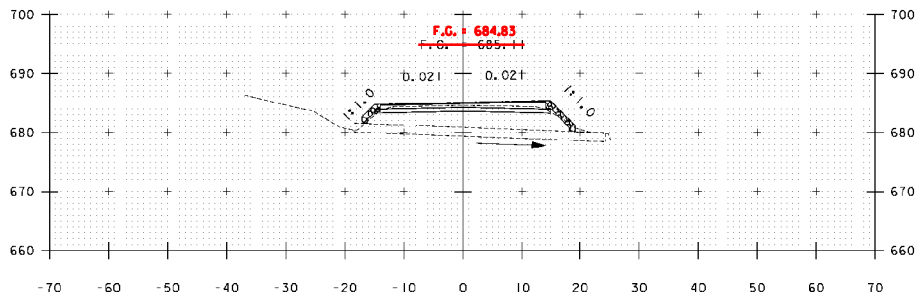

B 138+00

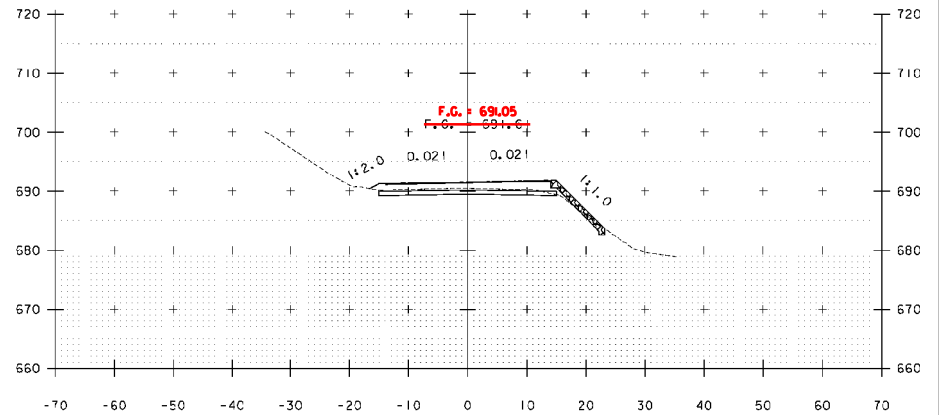

B 139+50

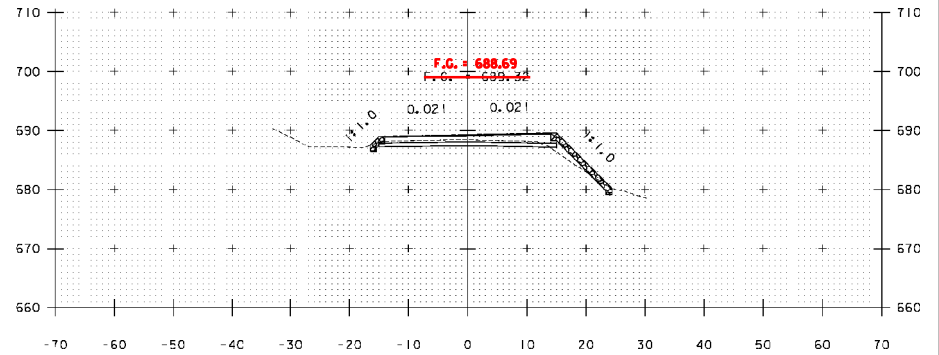

B 139+00

PROJECT NAME:	WARDSBORO-JAMAICA
PROJECT NUMBER:	ER STP 013-1(I7)
FILE NAME:	xs.dgn
PROJECT LEADER:	K. LIPWAL
DESIGNED BY:	E. KIPP
CROSS SECTIONS	
PLLOT DATE:	2/26/2014
DRAWN BY:	B. KIPP
CHECKED BY:	HSD
SHEET	382 OF 444

STA. B 138+00 TO STA. B 139+50