




B 141+00

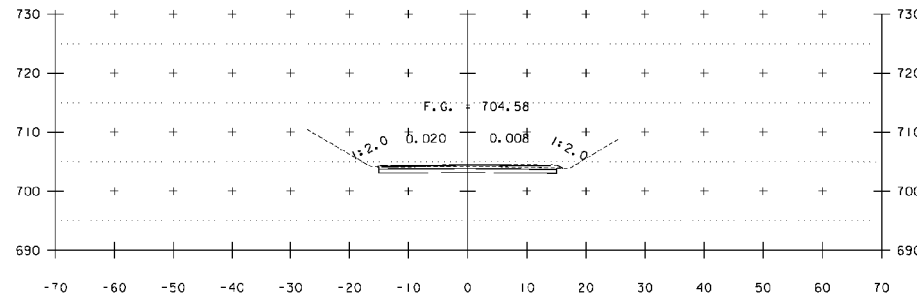


B 142+50

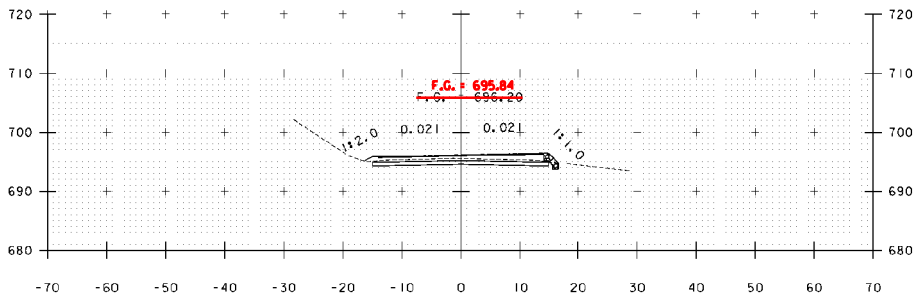


B 140+50

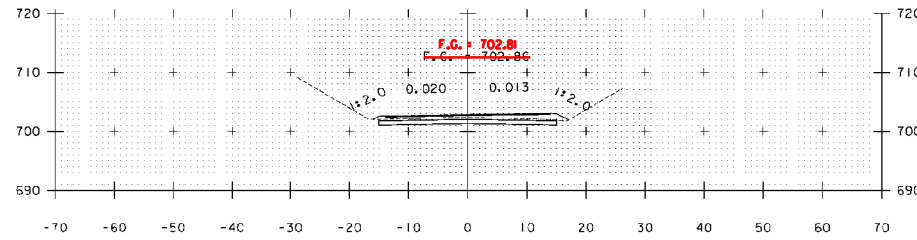

B 142+00

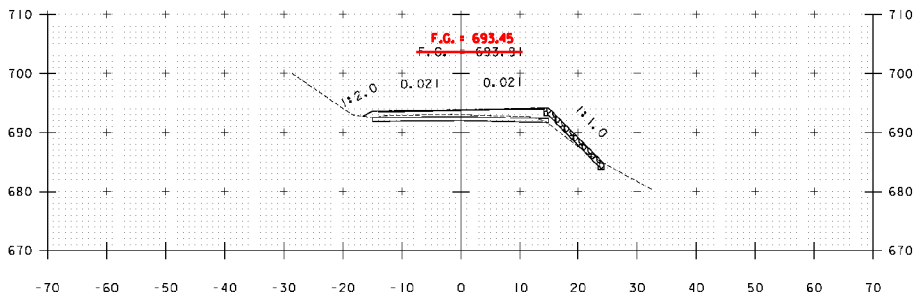

B 140+00

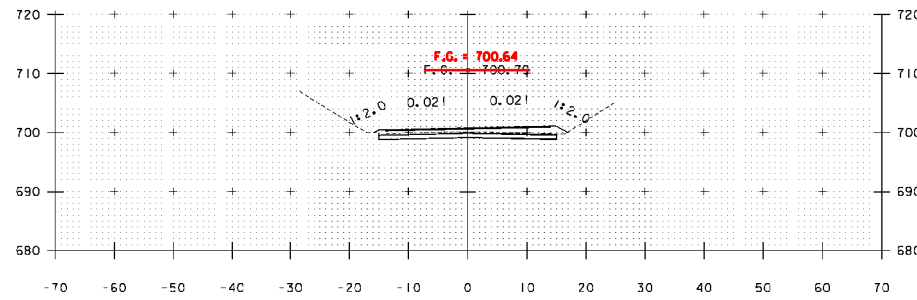

B 141+50

PROJECT NAME:	WARDSBORO-JAMAICA
PROJECT NUMBER:	ER STP 013-1(17)
FILE NAME:	xs.dgn
PROJECT LEADER:	K. LPMAL
DESIGNED BY:	E. KIPP
CHECKED BY:	HSD
CROSS SECTIONS	SHEET 383 OF 444

STA. B 140+00 TO STA. B 142+50