




B 146+50

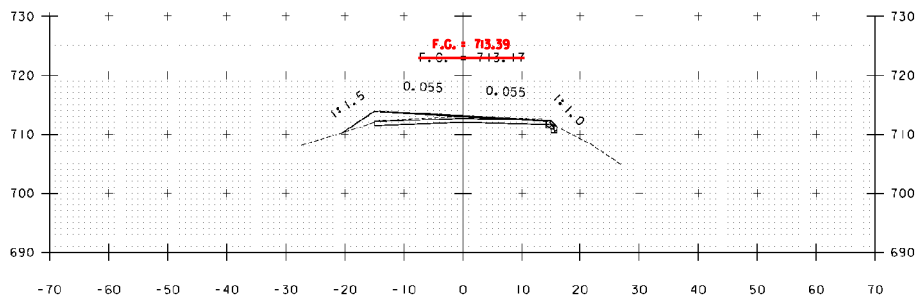


B 146+00

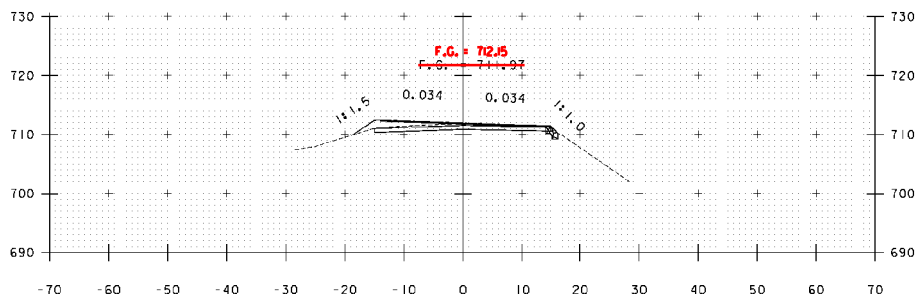

B 145+50

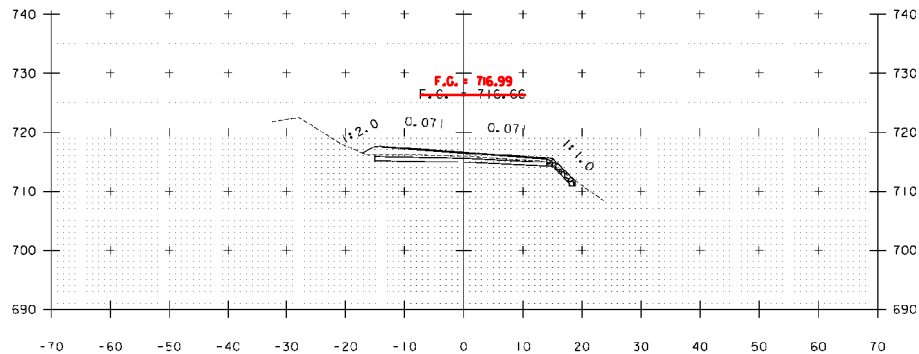

B 147+50

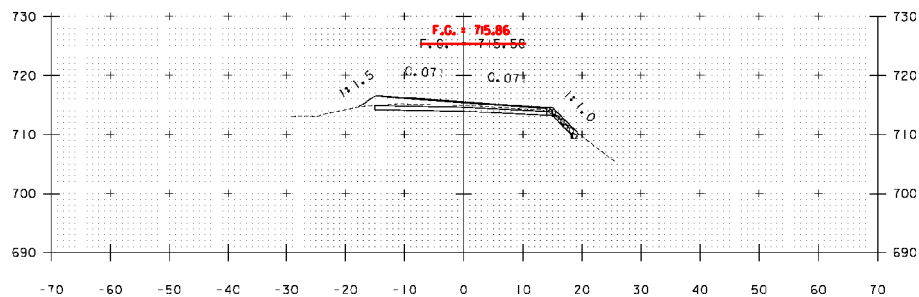

B 147+00

| | |
|-----------------|-------------------|
| PROJECT NAME: | WARDSBORO-JAMAICA |
| PROJECT NUMBER: | ER STP 013-1(17) |
| FILE NAME: | xs.dgn |
| PROJECT LEADER: | K. UPWAL |
| DESIGNED BY: | E. KIPP |
| CROSS SECTIONS | |
| PLLOT DATE: | 2/26/2014 |
| DRAWN BY: | B. KIPP |
| CHECKED BY: | HSD |
| SHEET | 385 OF 444 |

STA. B 145+50 TO STA. B 147+50