




B 151+50

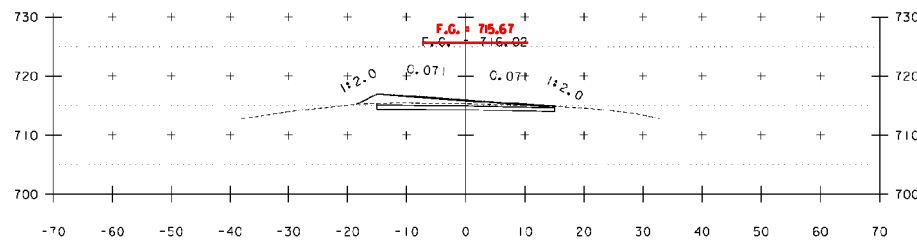


B 153+00

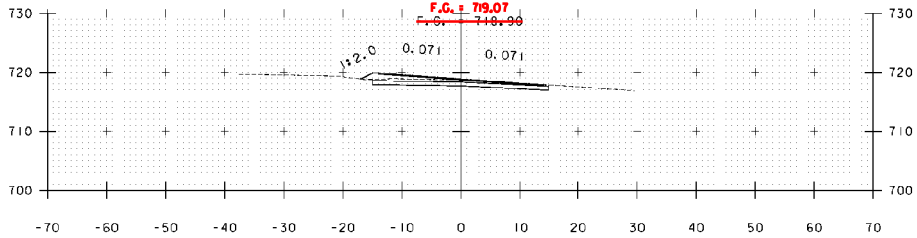


B 151+00

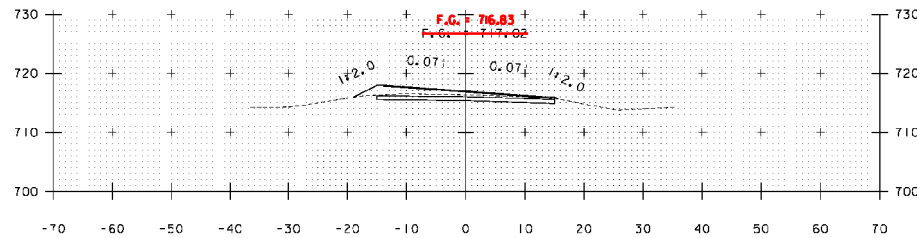

B 152+50

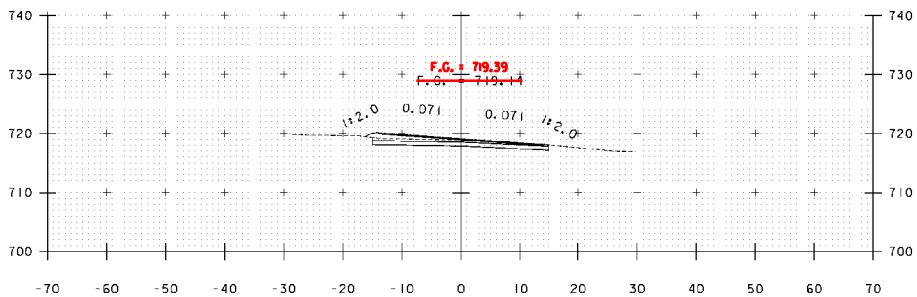

B 150+50

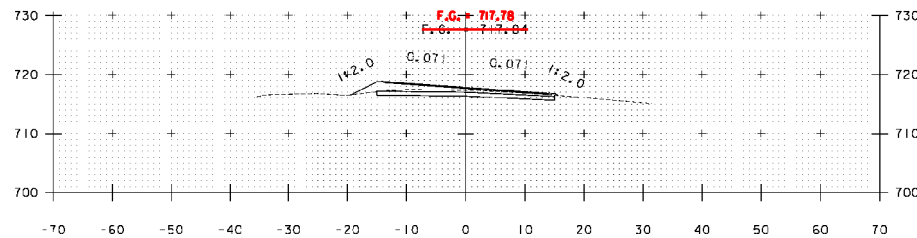

B 152+00

PROJECT NAME:	WARDSBORO-JAMAICA
PROJECT NUMBER:	ER STP 013-1(17)
FILE NAME:	xs.dgn
PROJECT LEADER:	K. LPWAL
DESIGNED BY:	E. KIPP
CROSS SECTIONS	
PLLOT DATE:	2/26/2014
DRAWN BY:	B. KIPP
CHECKED BY:	HSD
SHEET	387 OF 444

STA. B 150+50 TO STA. B 153+00