




B 154+00

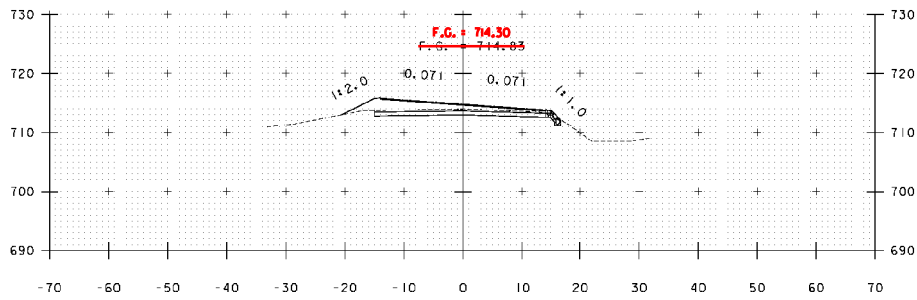

B 153+50

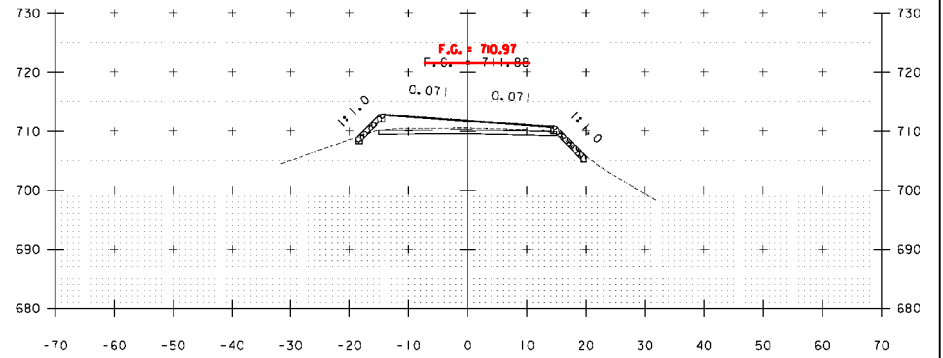

B 154+50

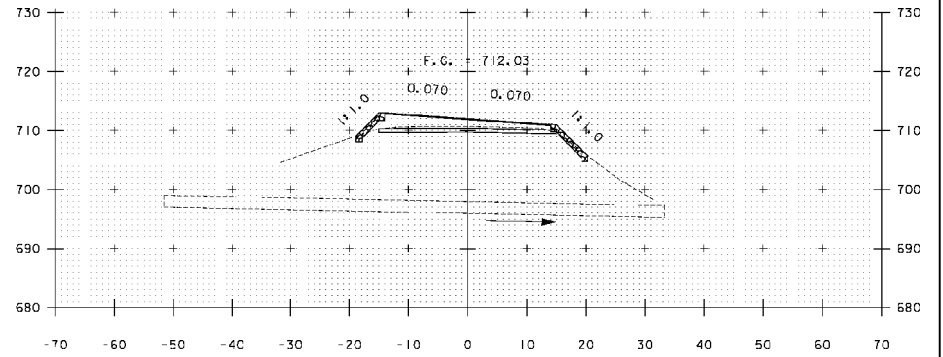

B 154+46

STA. B 153+50 TO STA. B 154+50

PROJECT NAME:	WARDSBORO-JAMAICA
PROJECT NUMBER:	ER STP 013-1(17)
FILE NAME:	xs.dgn
PROJECT LEADER:	K. UPWAL
DESIGNED BY:	E. KIPP
CROSS SECTIONS	
PLLOT DATE:	2/26/2014
DRAWN BY:	B. KIPP
CHECKED BY:	HSD
SHEET	388 OF 444