




B 155+50

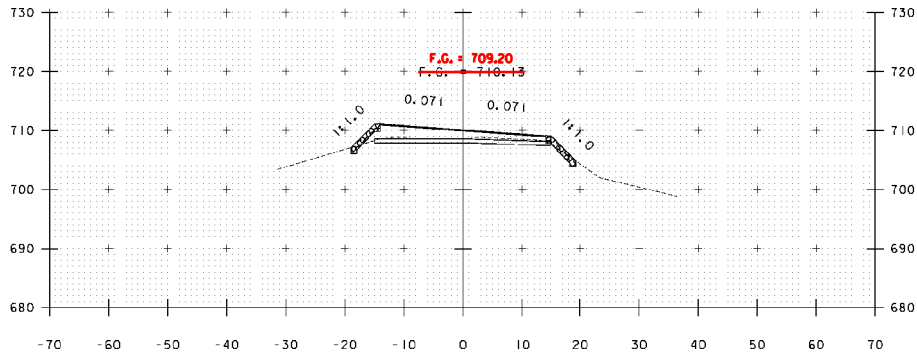


B 155+00

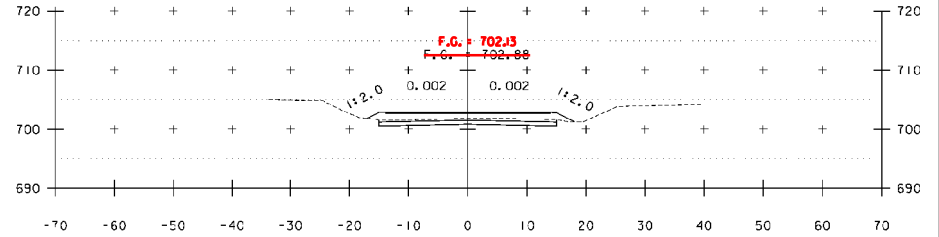

B 157+00

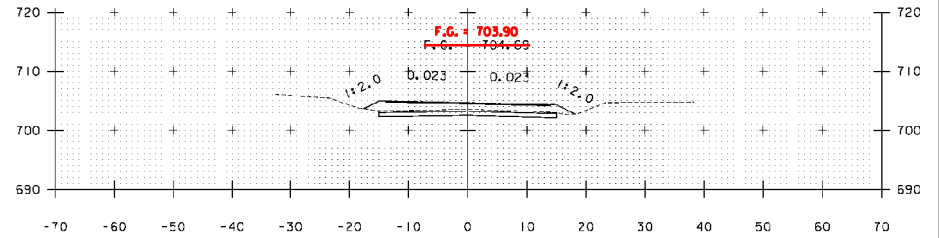

B 156+50

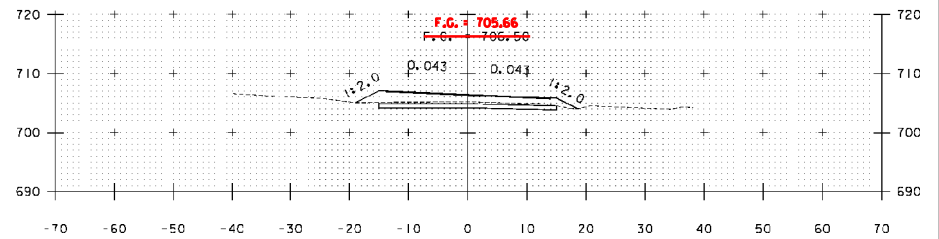

B 156+00

PROJECT NAME:	WARDSBORO-JAMAICA
PROJECT NUMBER:	ER STP 013-1(17)
FILE NAME:	xs.dgn
PROJECT LEADER:	K. UPWAL
DESIGNED BY:	E. KIPP
CROSS SECTIONS	
PLLOT DATE:	2/26/2014
DRAWN BY:	B. KIPP
CHECKED BY:	HSD
SHEET	389 OF 444

STA. B 155+00 TO STA. B 157+00