




B 158+50

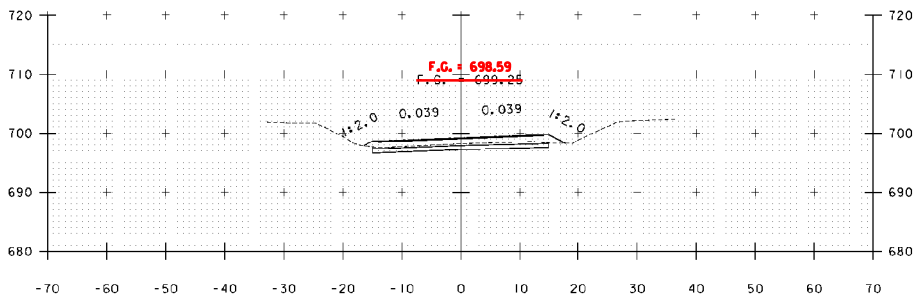


B 158+00

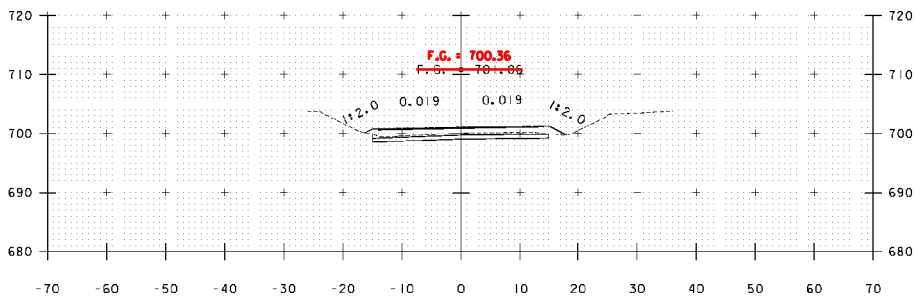


B 157+50

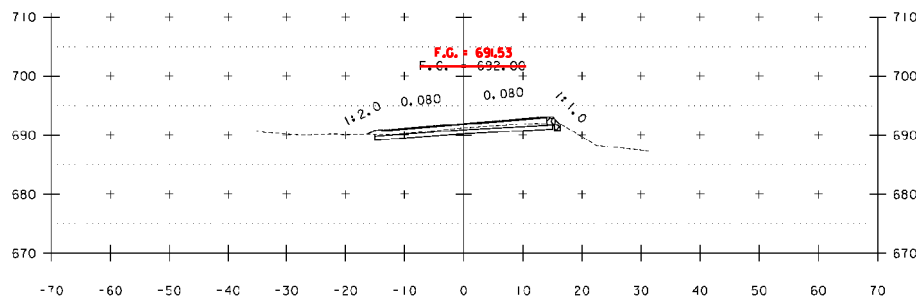

B 160+00

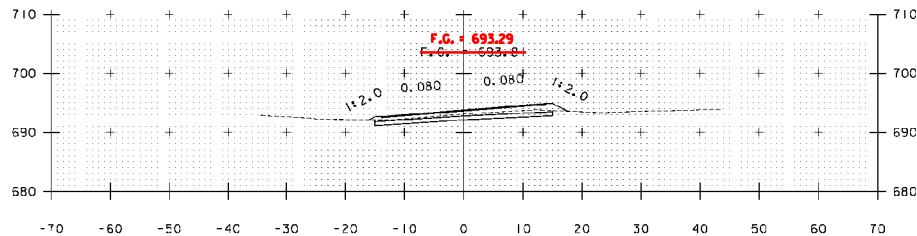

B 159+50

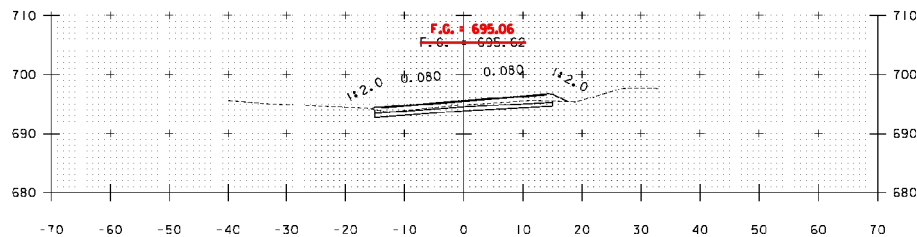

B 159+00

PROJECT NAME:	WARDSBORO-JAMAICA
PROJECT NUMBER:	ER STP 013-1(17)
FILE NAME:	xs.dgn
PROJECT LEADER:	K. LPWAL
DESIGNED BY:	E. KIPP
CROSS SECTIONS	
PLOT DATE:	2/26/2014
DRAWN BY:	B. KIPP
CHECKED BY:	HSD
SHEET	390 OF 444

STA. B 157+50 TO STA. B 160+00