




B 167+00

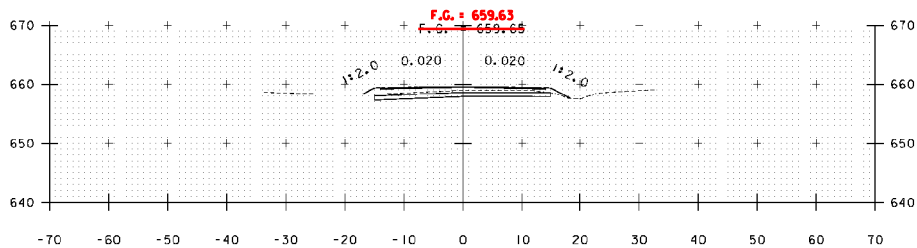


B 166+50

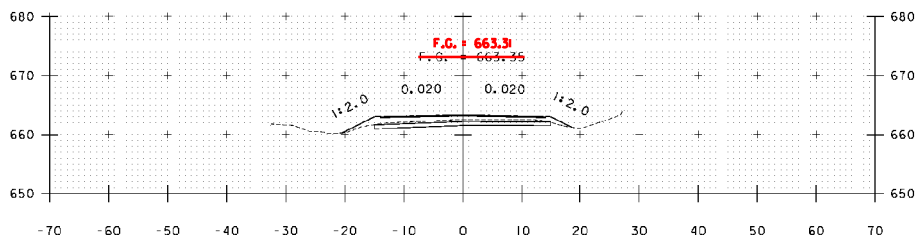


B 166+00

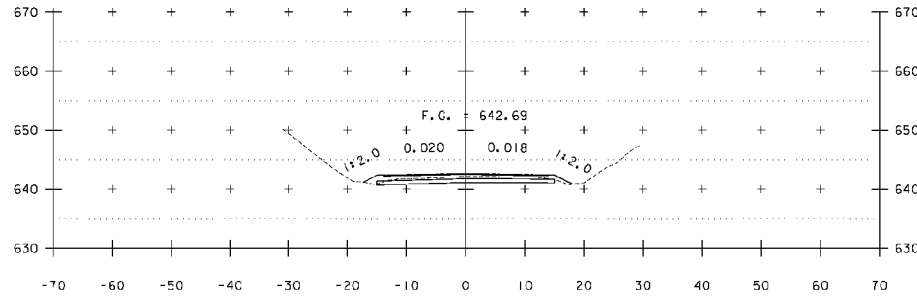

B 168+50

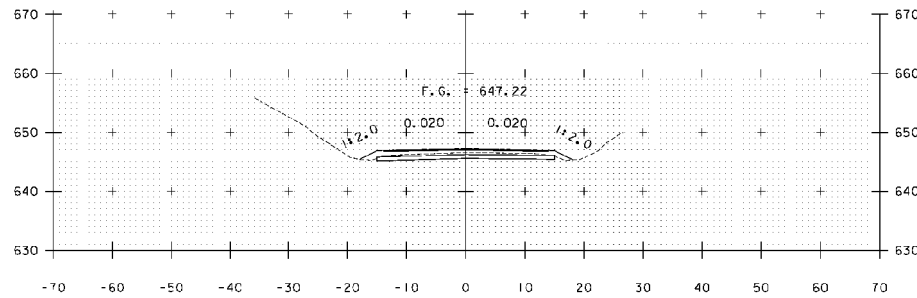

B 168+00

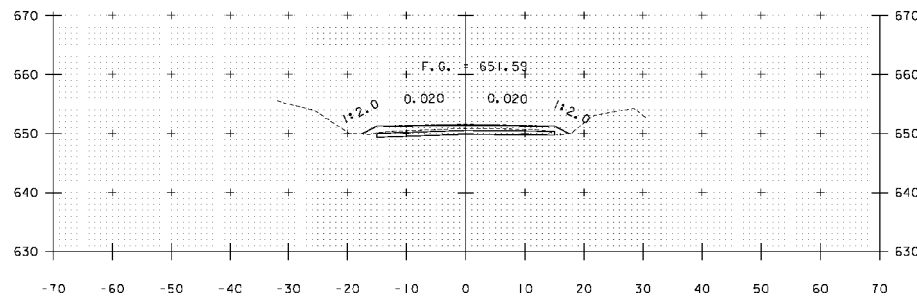

B 167+50

PROJECT NAME:	WARDSBORO-JAMAICA
PROJECT NUMBER:	ER STP 013-1(17)
FILE NAME:	xs.dgn
PROJECT LEADER:	K. UPWAL
DESIGNED BY:	E. KIPP
CROSS SECTIONS	
PLLOT DATE:	2/26/2014
DRAWN BY:	B. KIPP
CHECKED BY:	HSD
SHEET	393 OF 444

STA. B 166+00 TO STA. B 168+50