




B 170+00

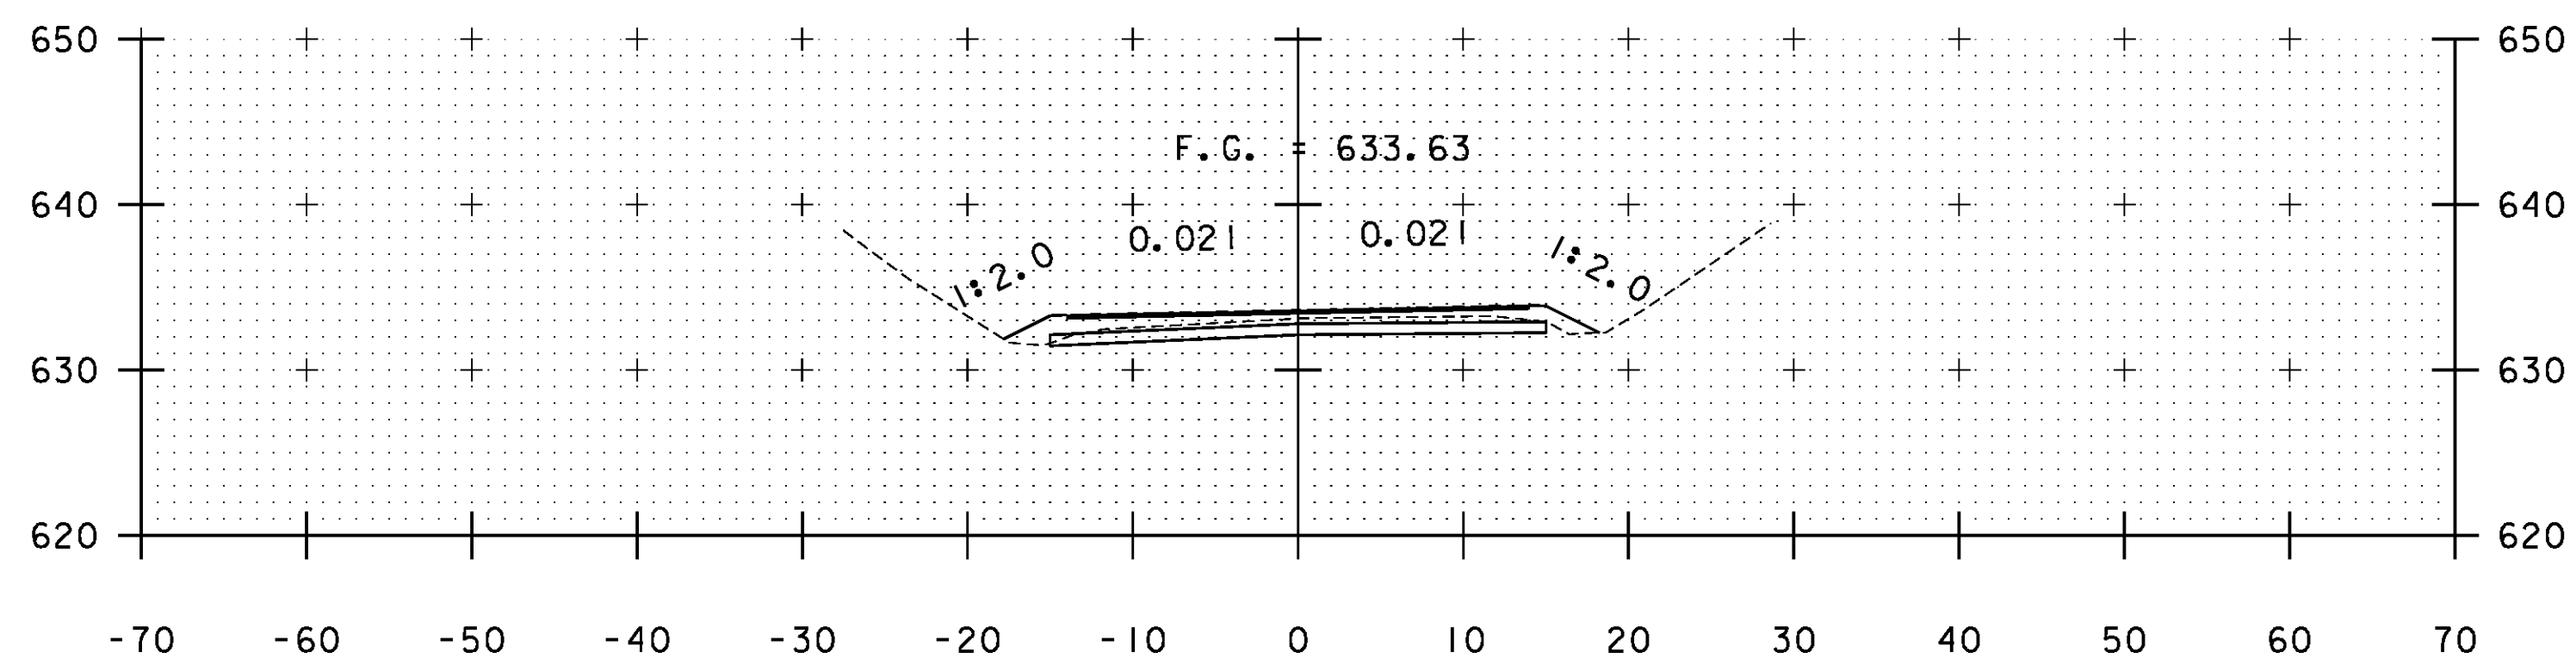


B 169+50

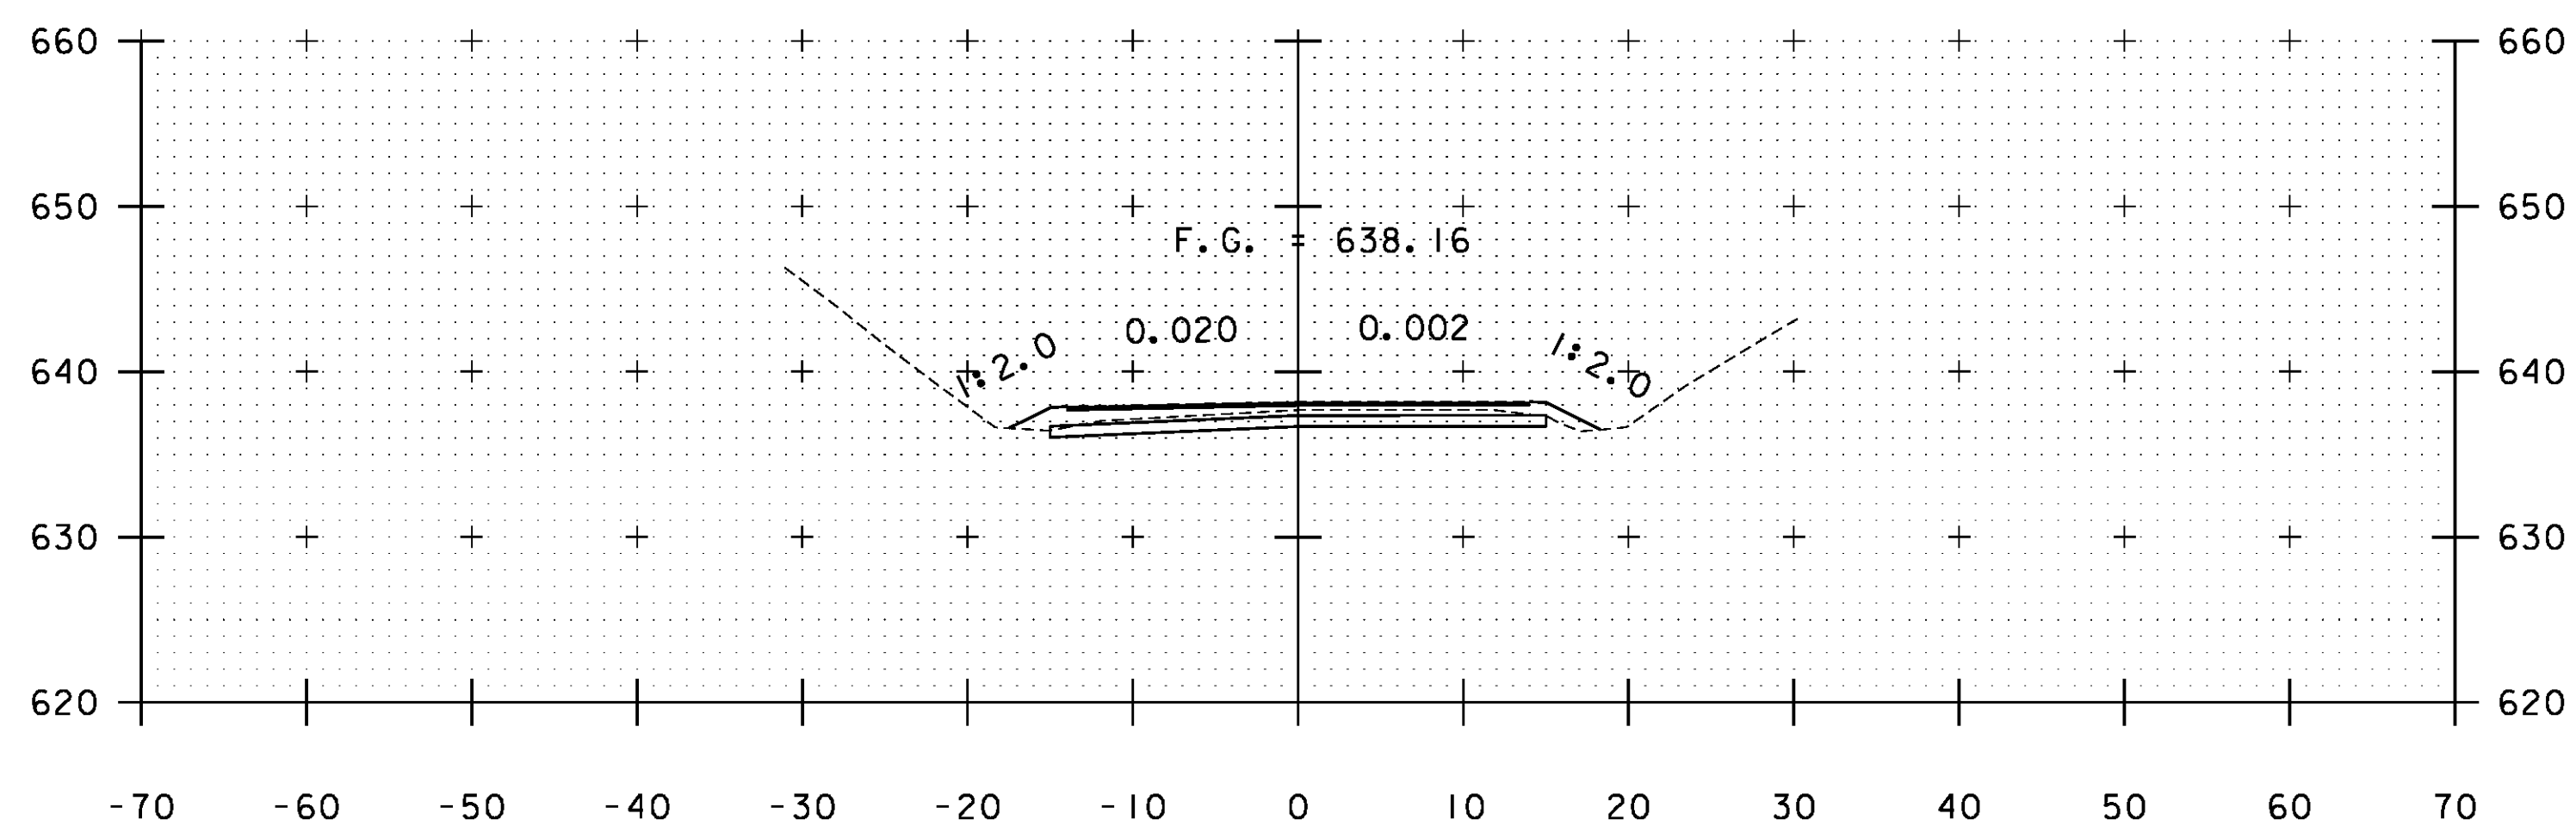


B 169+00

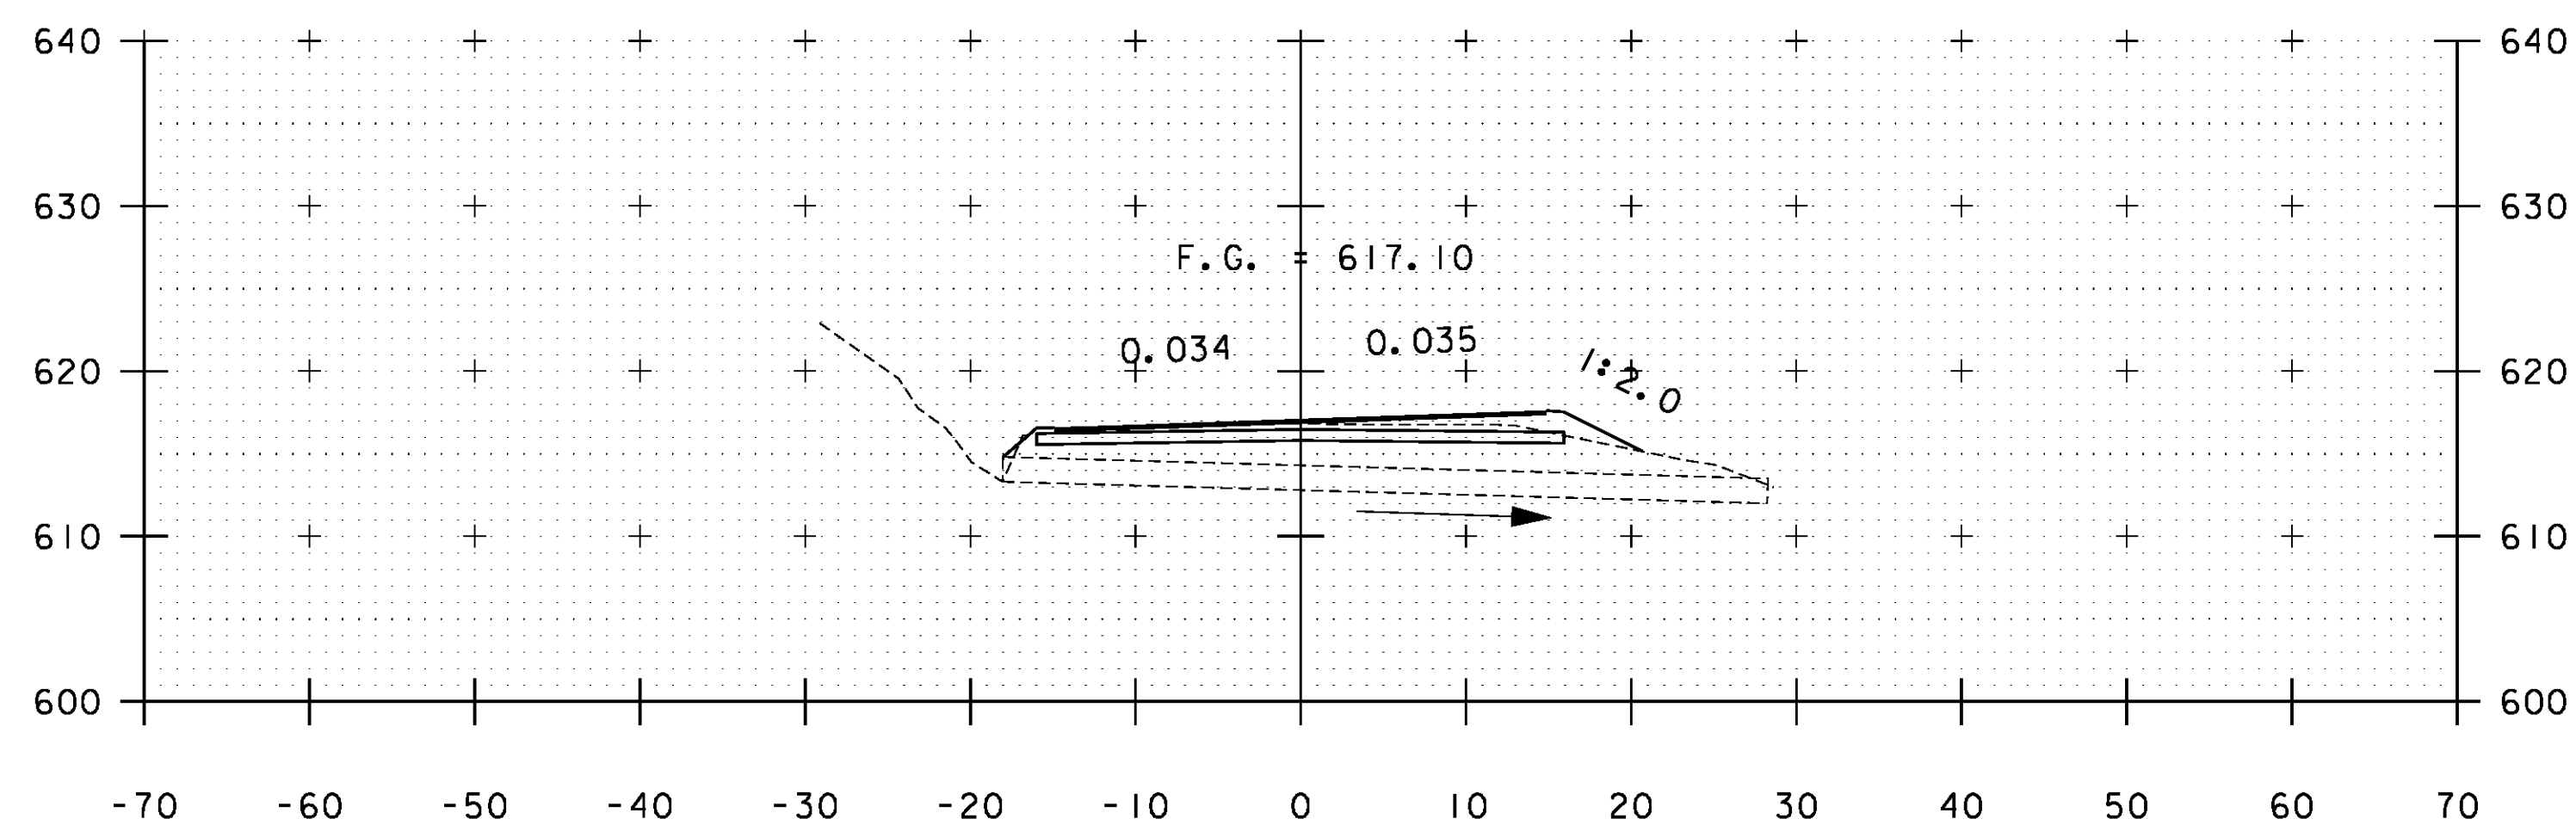

B 171+32

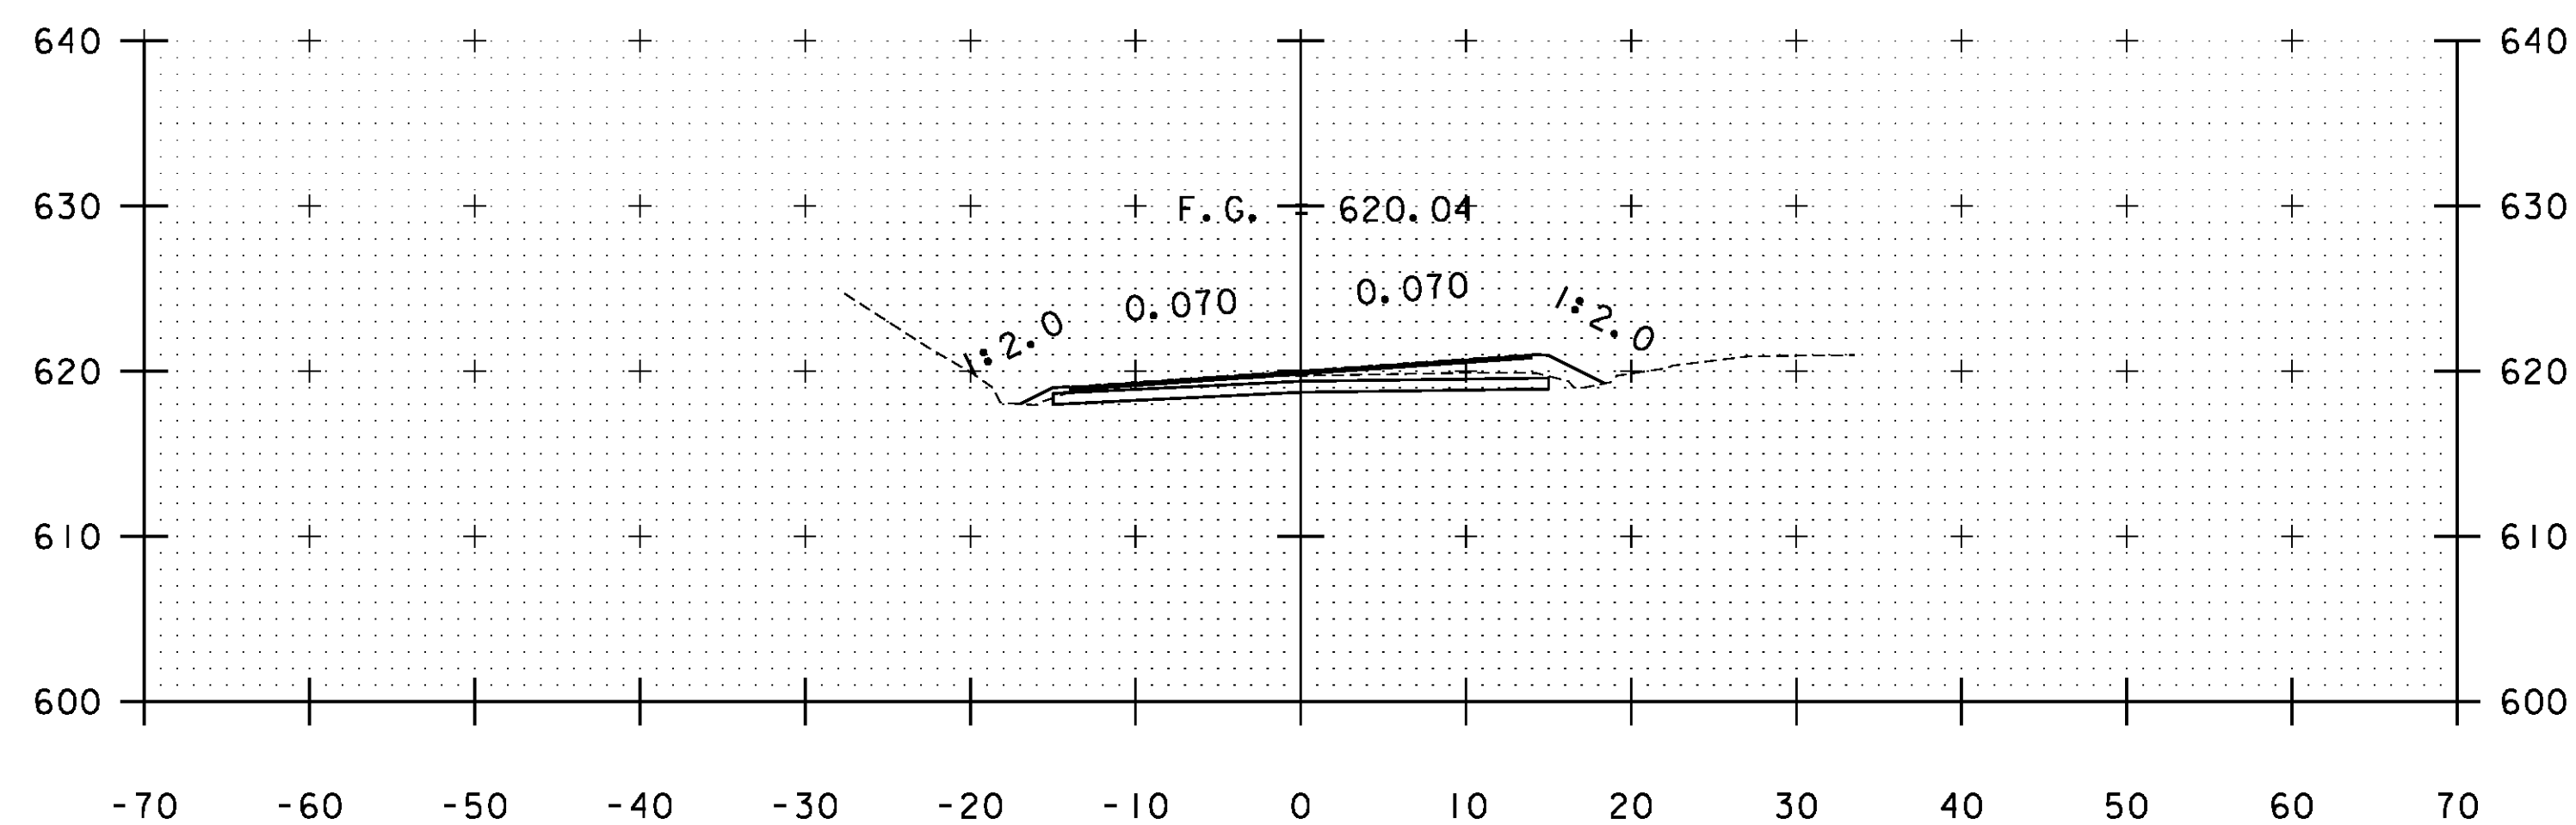

B 171+00

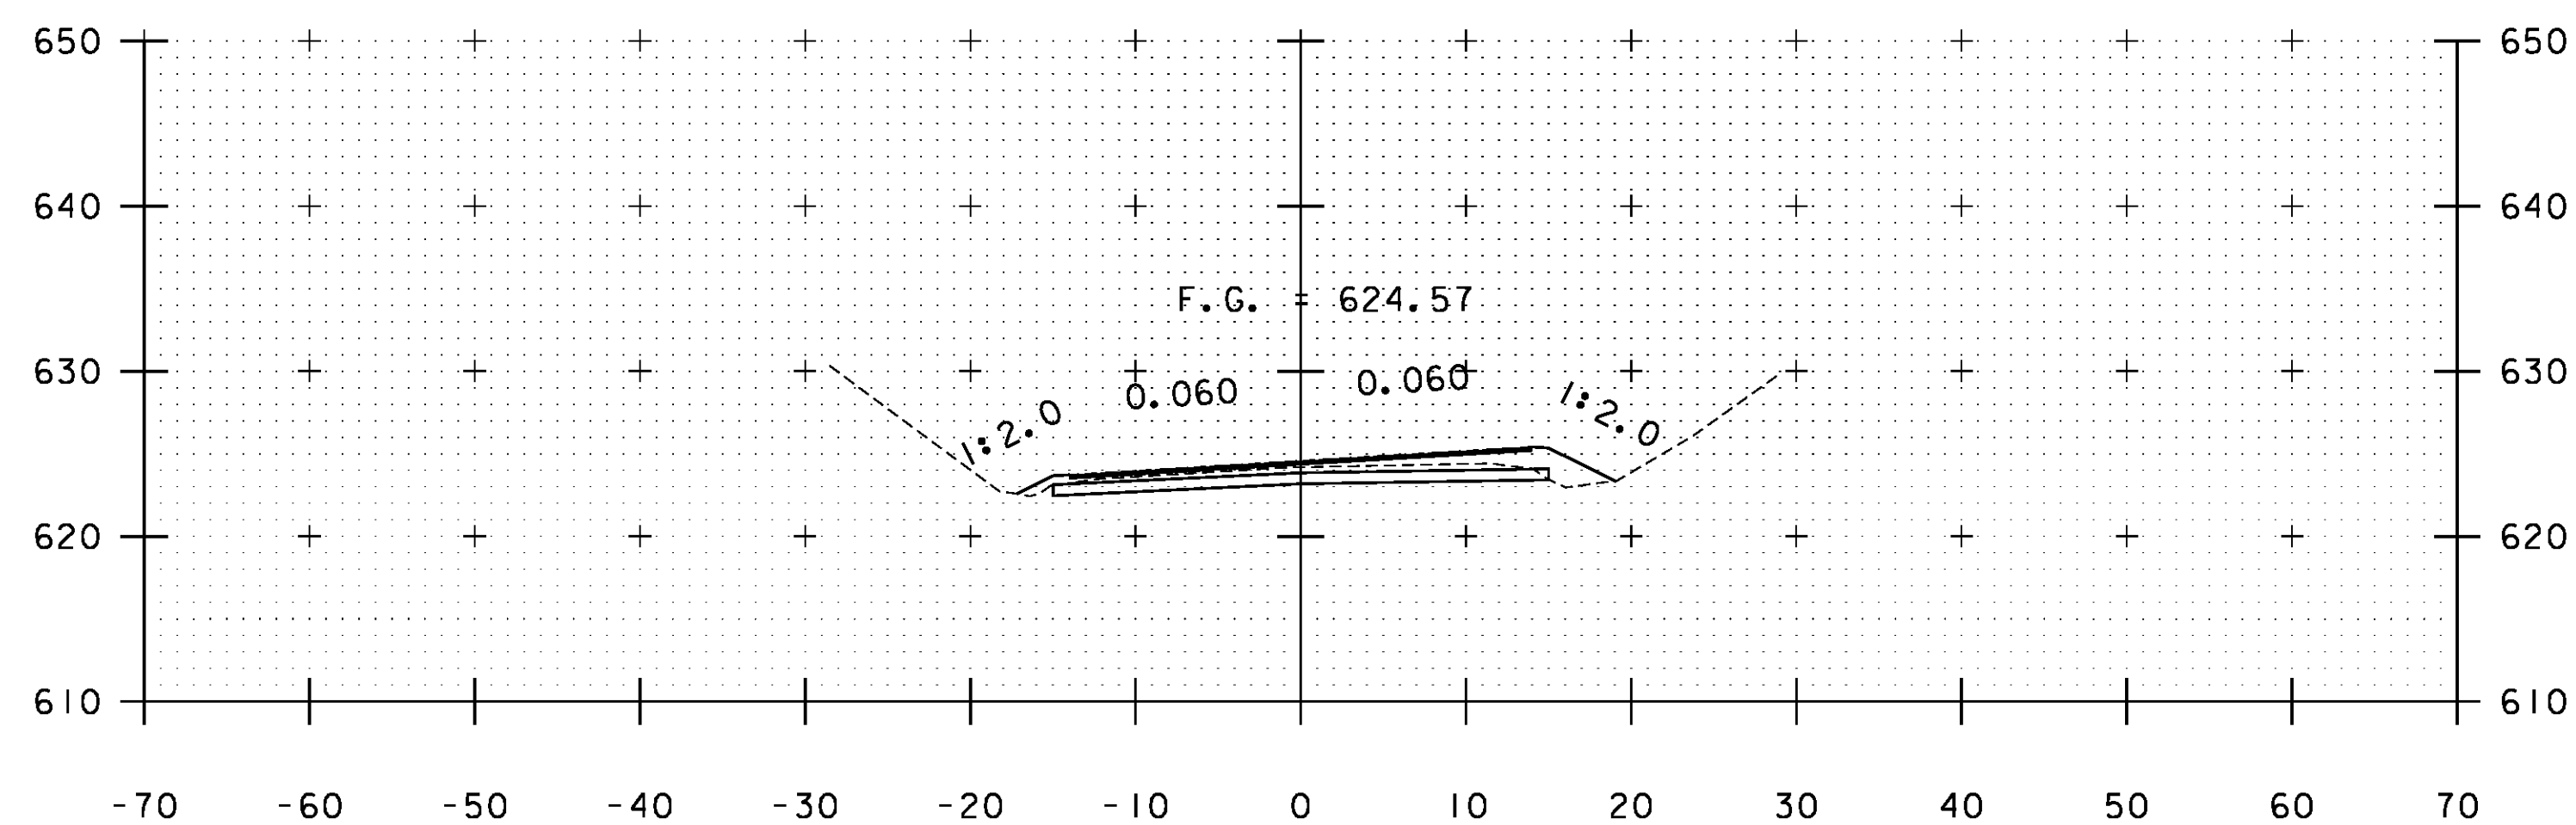

B 170+50

STA. B 169+00 TO STA. B 171+32

PROJECT NAME: WARDBORO-JAMAICA	
PROJECT NUMBER: ER STP 013-1(17)	
FILE NAME: xs.dgn	PLOT DATE: 2/26/2014
PROJECT LEADER: K. UPMAL	DRAWN BY: B. KIPP
DESIGNED BY: B. KIPP	CHECKED BY: HSD
CROSS SECTIONS	SHEET 394 OF 444