




B 179+00

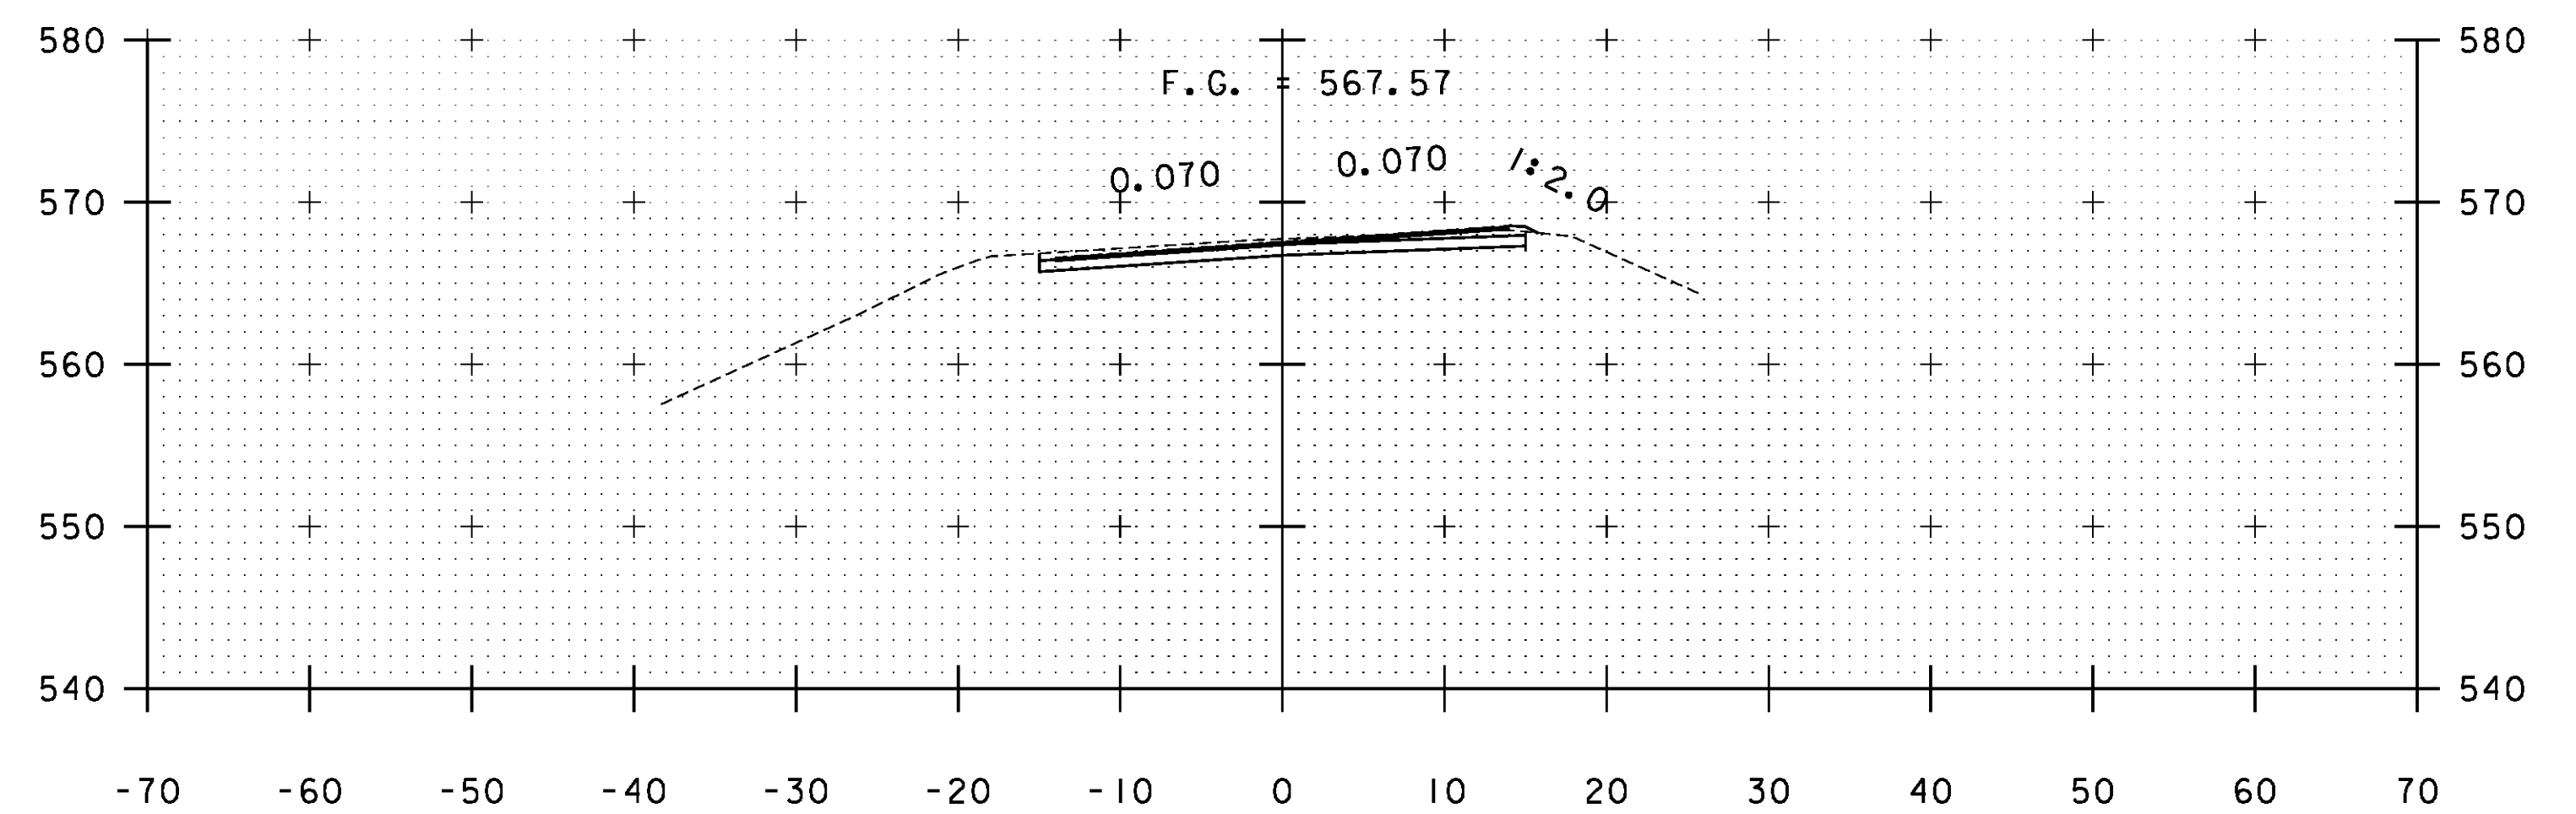


B 178+50

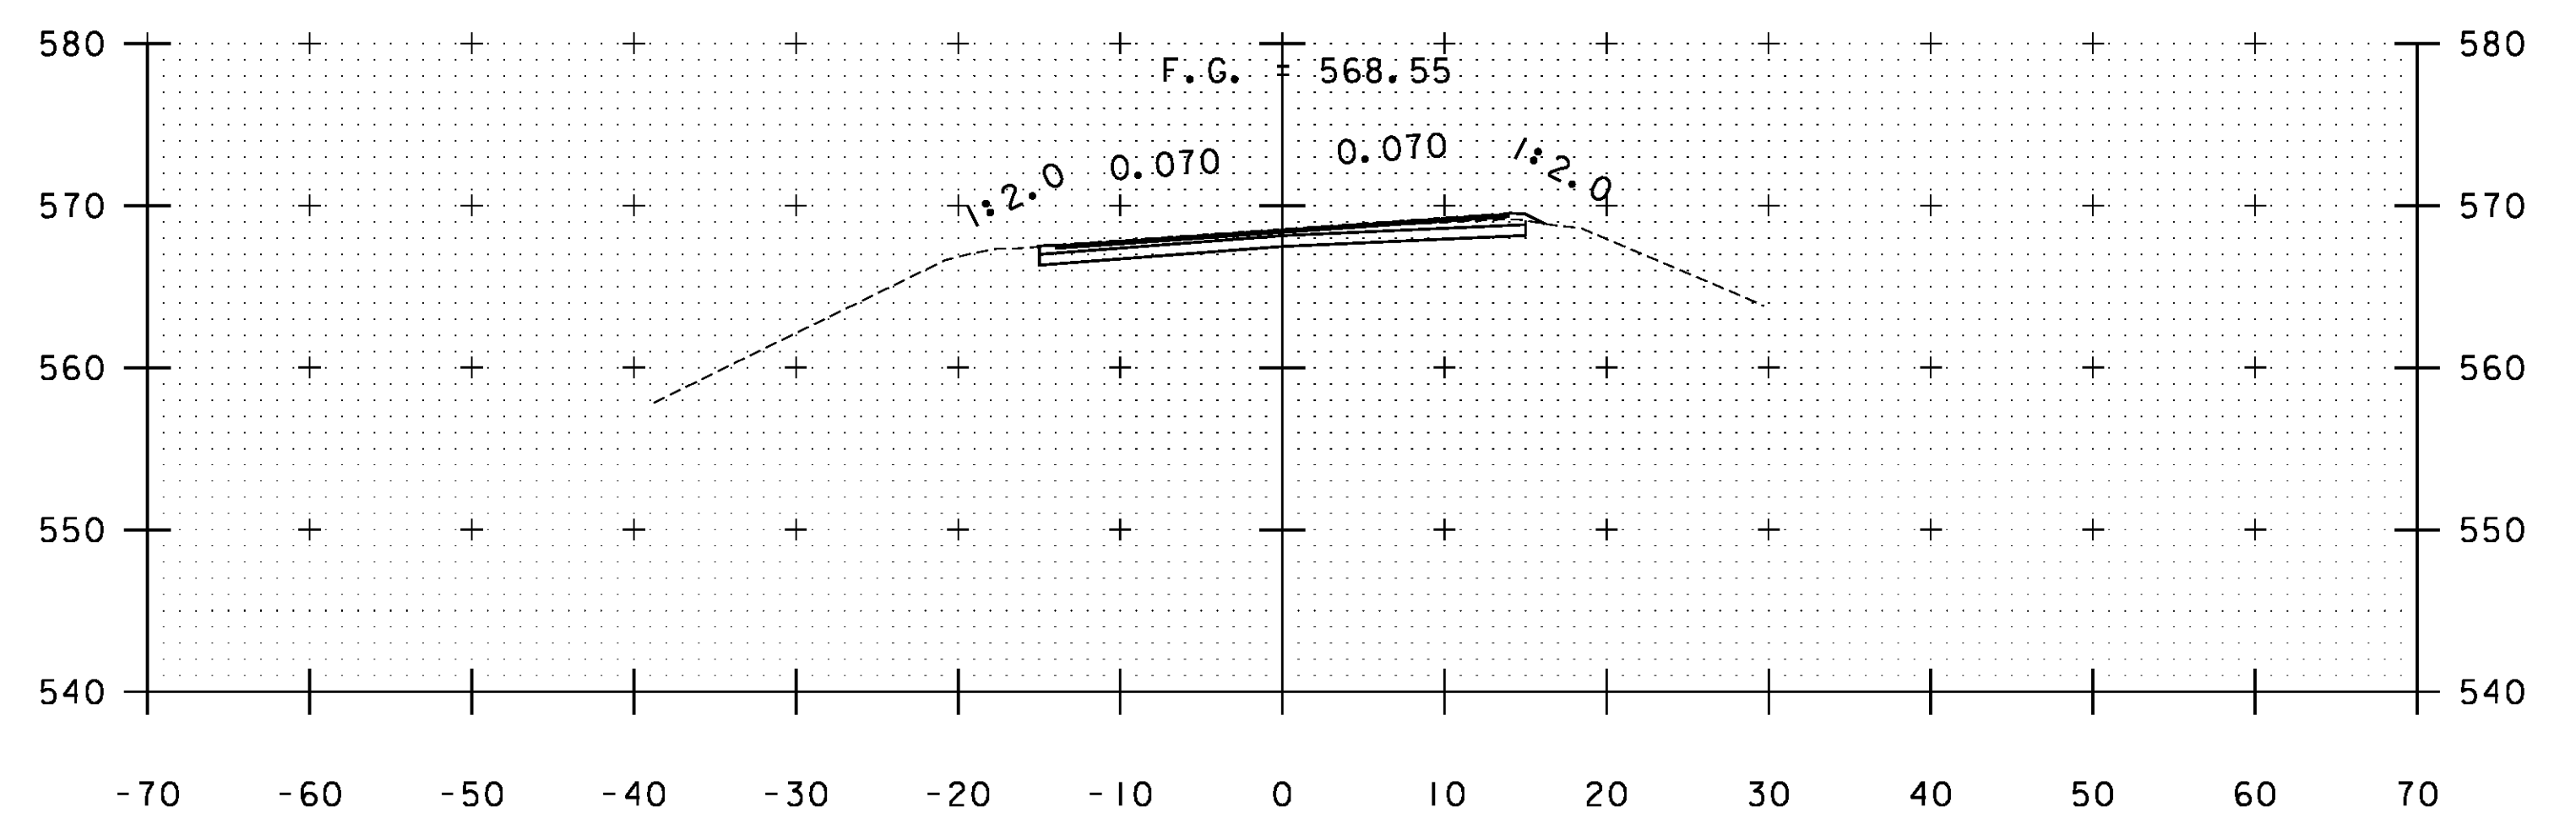

B 178+00

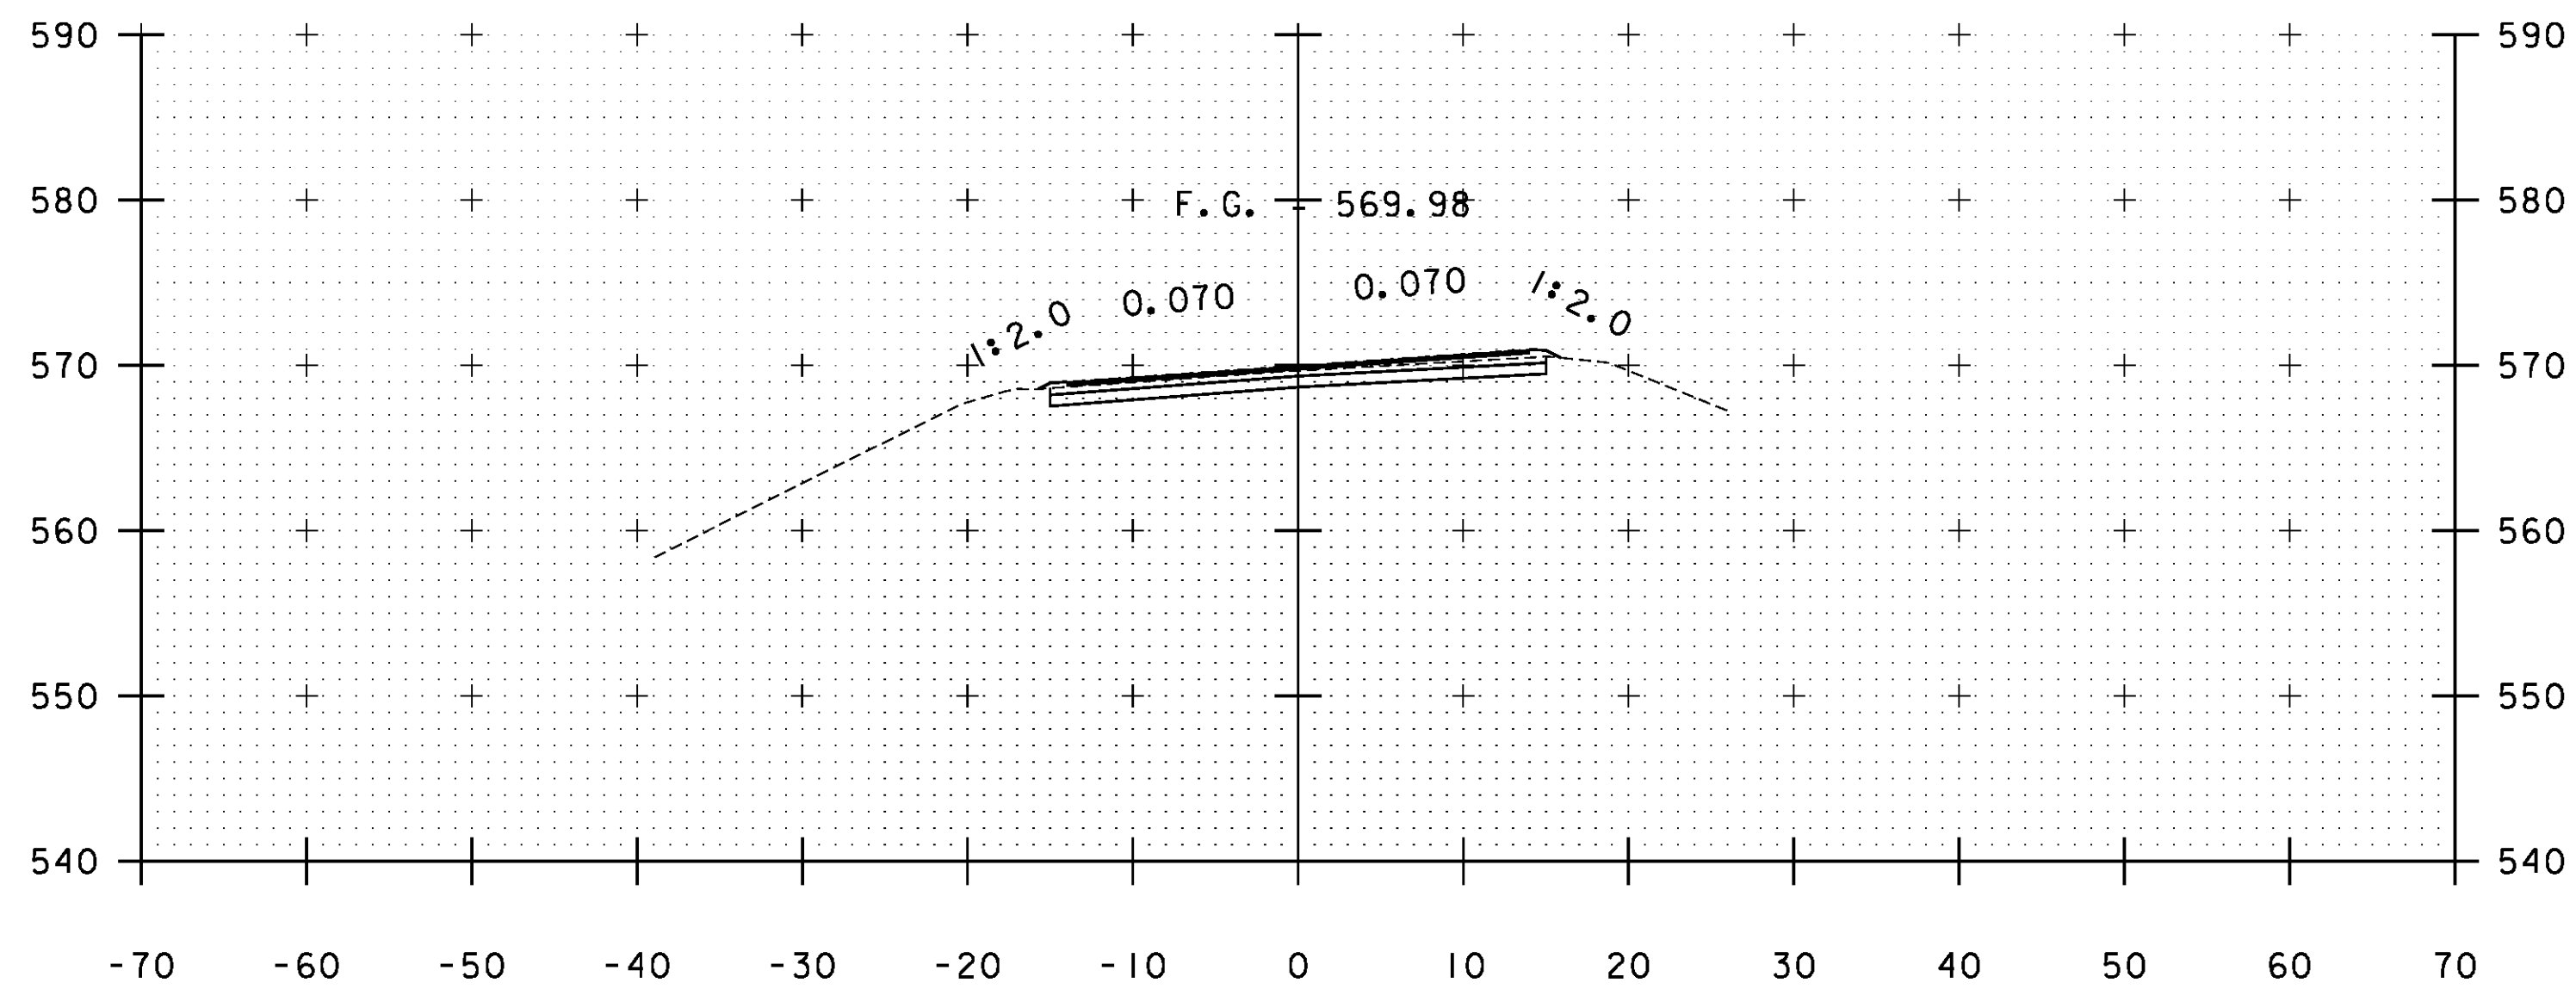

B 177+50

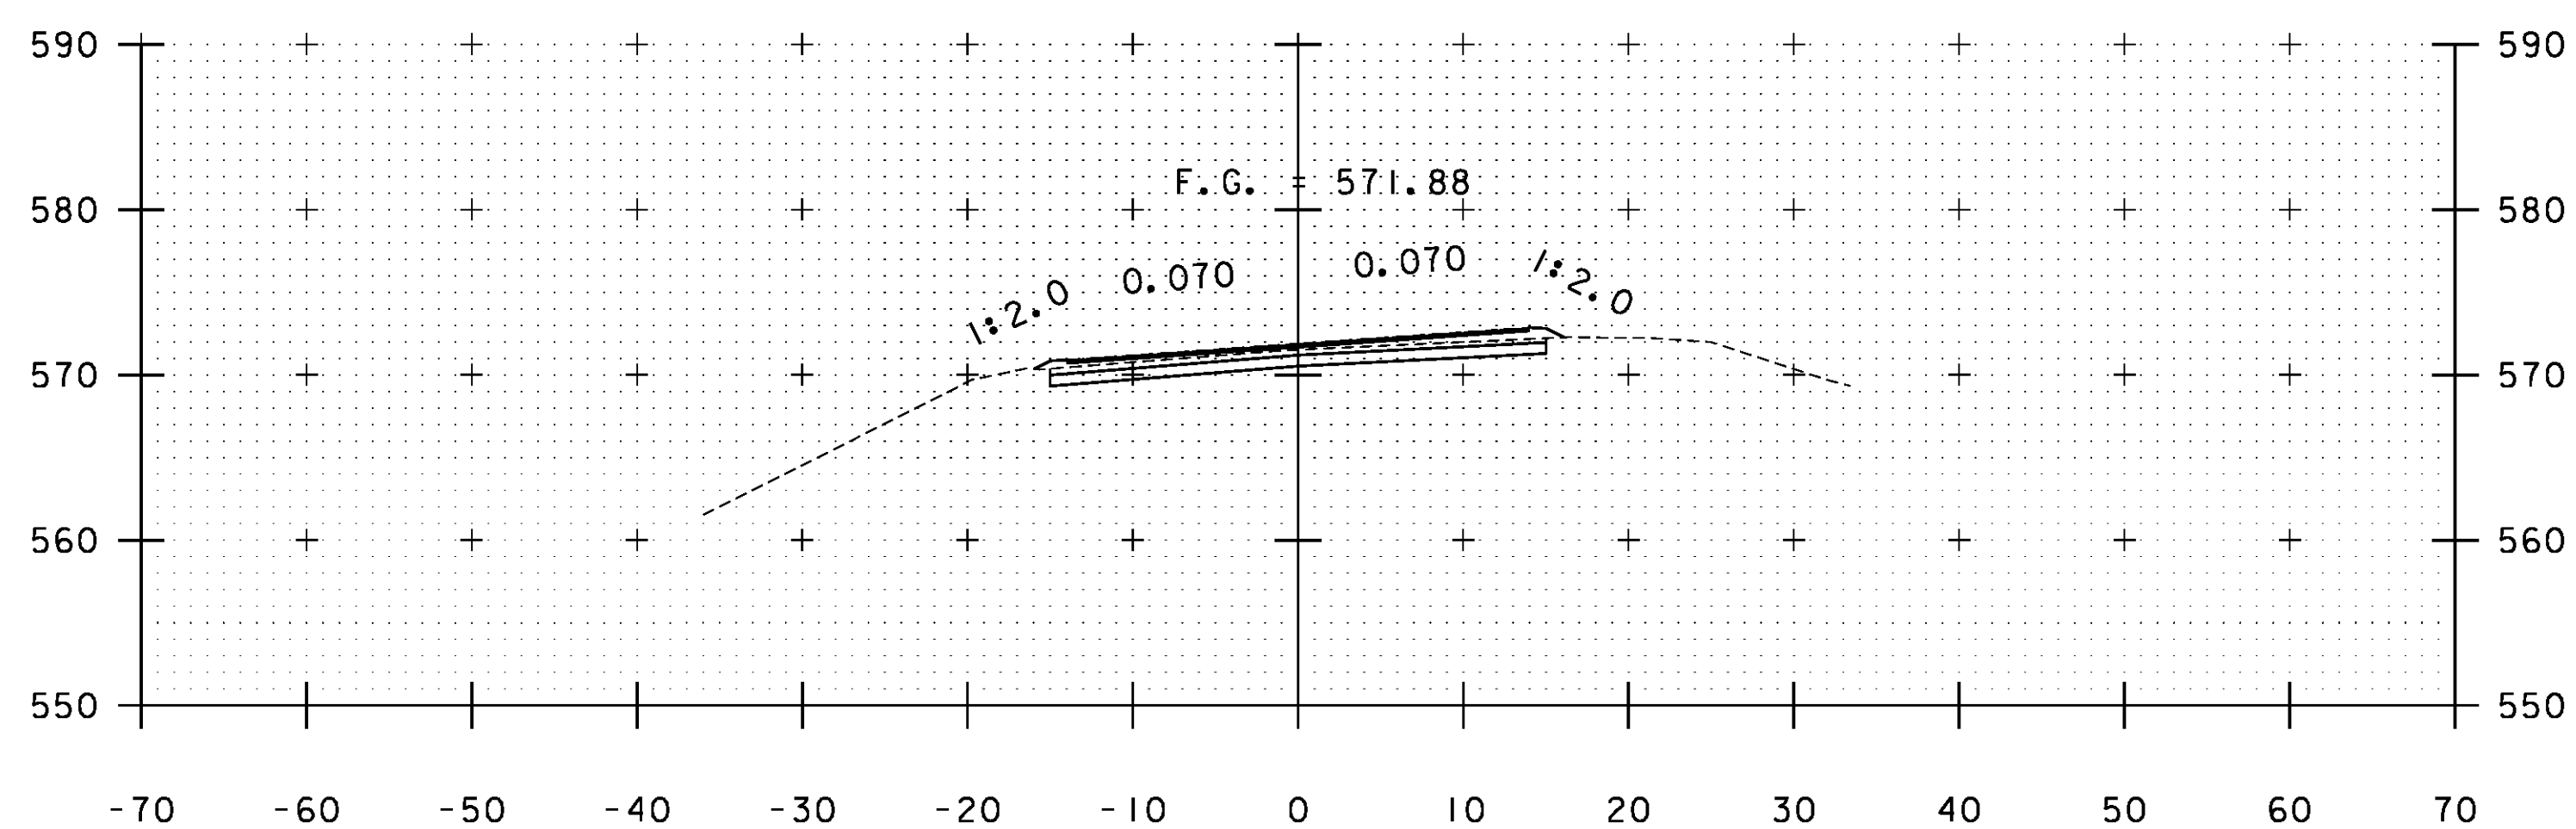

B 177+00

STA. B 177+00 TO STA. B 179+00

PROJECT NAME: WARDBORO-JAMAICA	PLOT DATE: 2/26/2014
PROJECT NUMBER: ER STP 013-1(17)	DRAWN BY: B. KIPP
FILE NAME: xs.dgn	CHECKED BY: HSD
PROJECT LEADER: K. UPMAL	SHEET 397 OF 444
DESIGNED BY: B. KIPP	
CROSS SECTIONS	