



STA 73+85.00
 END UNCLASSIFIED CHANNEL EXCAVATION
 END GEOTEXTILE UNDER STONE FILL
 END STONE FILL, TYPE III
 END GRUBBING MATERIAL

73+85

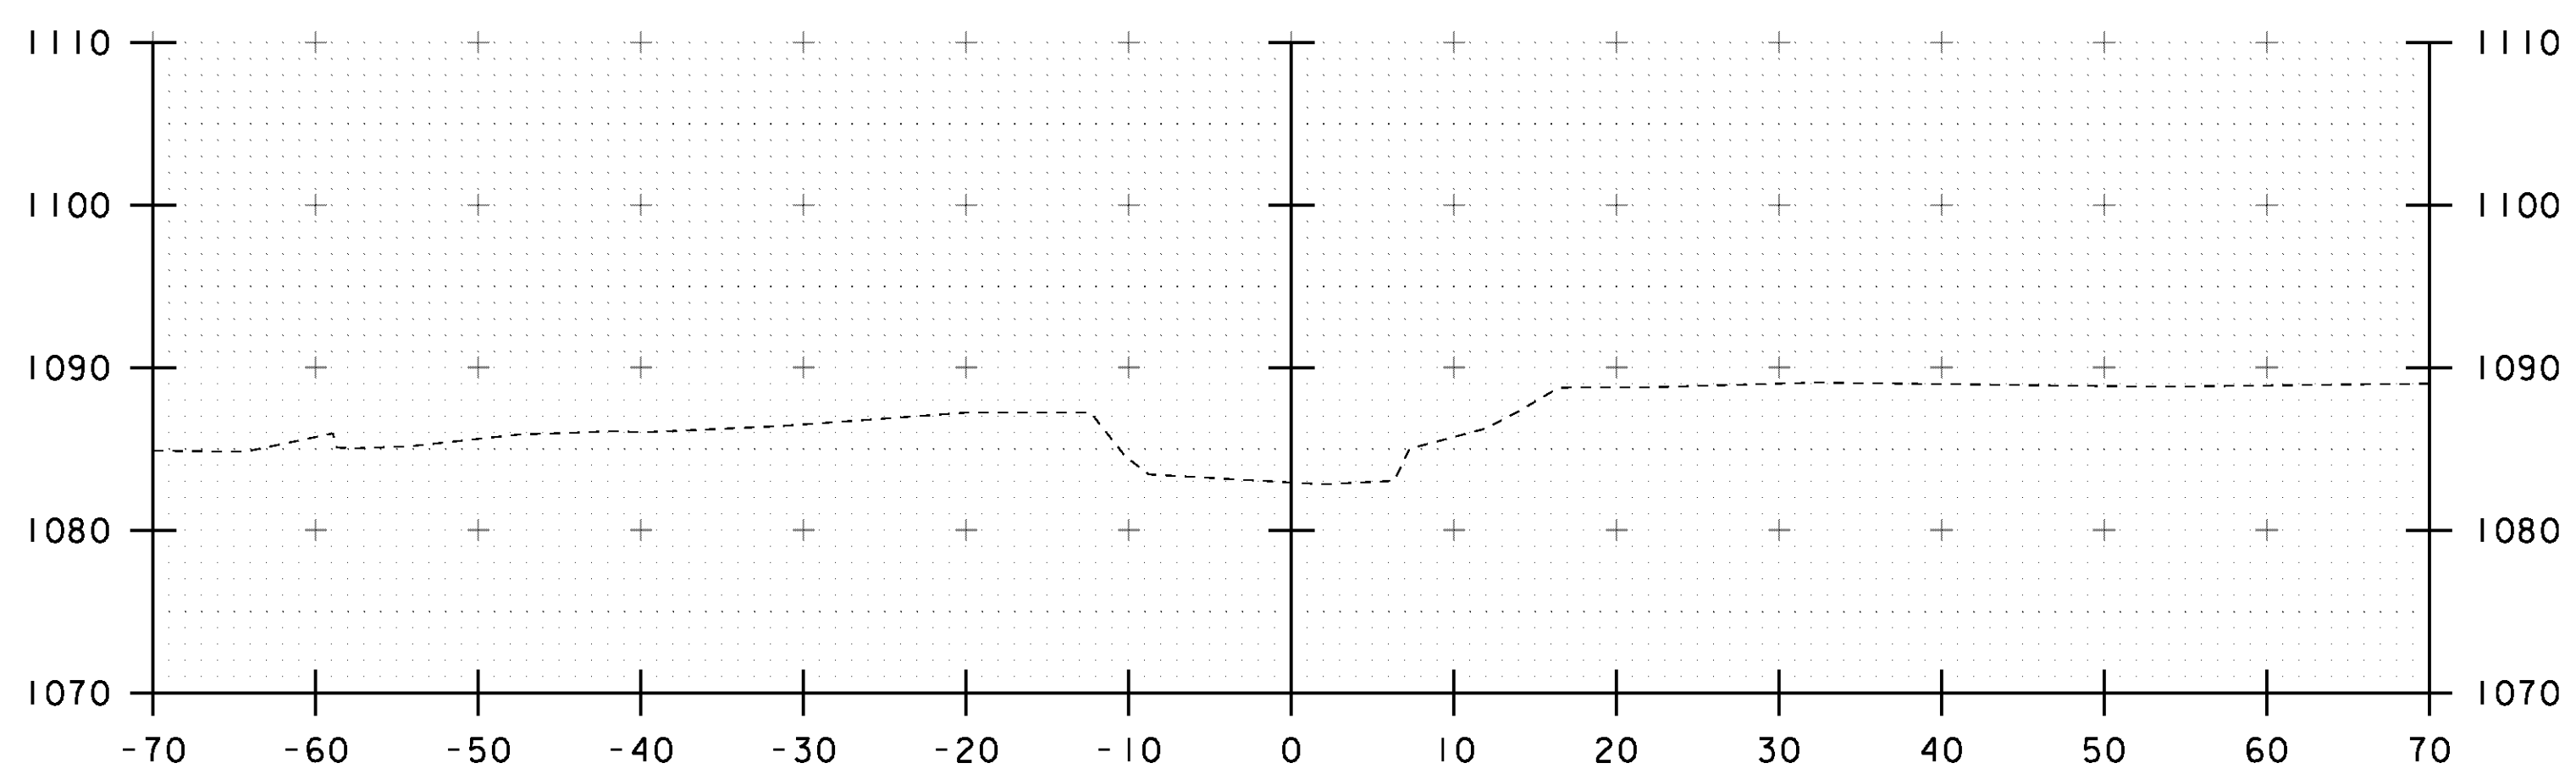


74+00

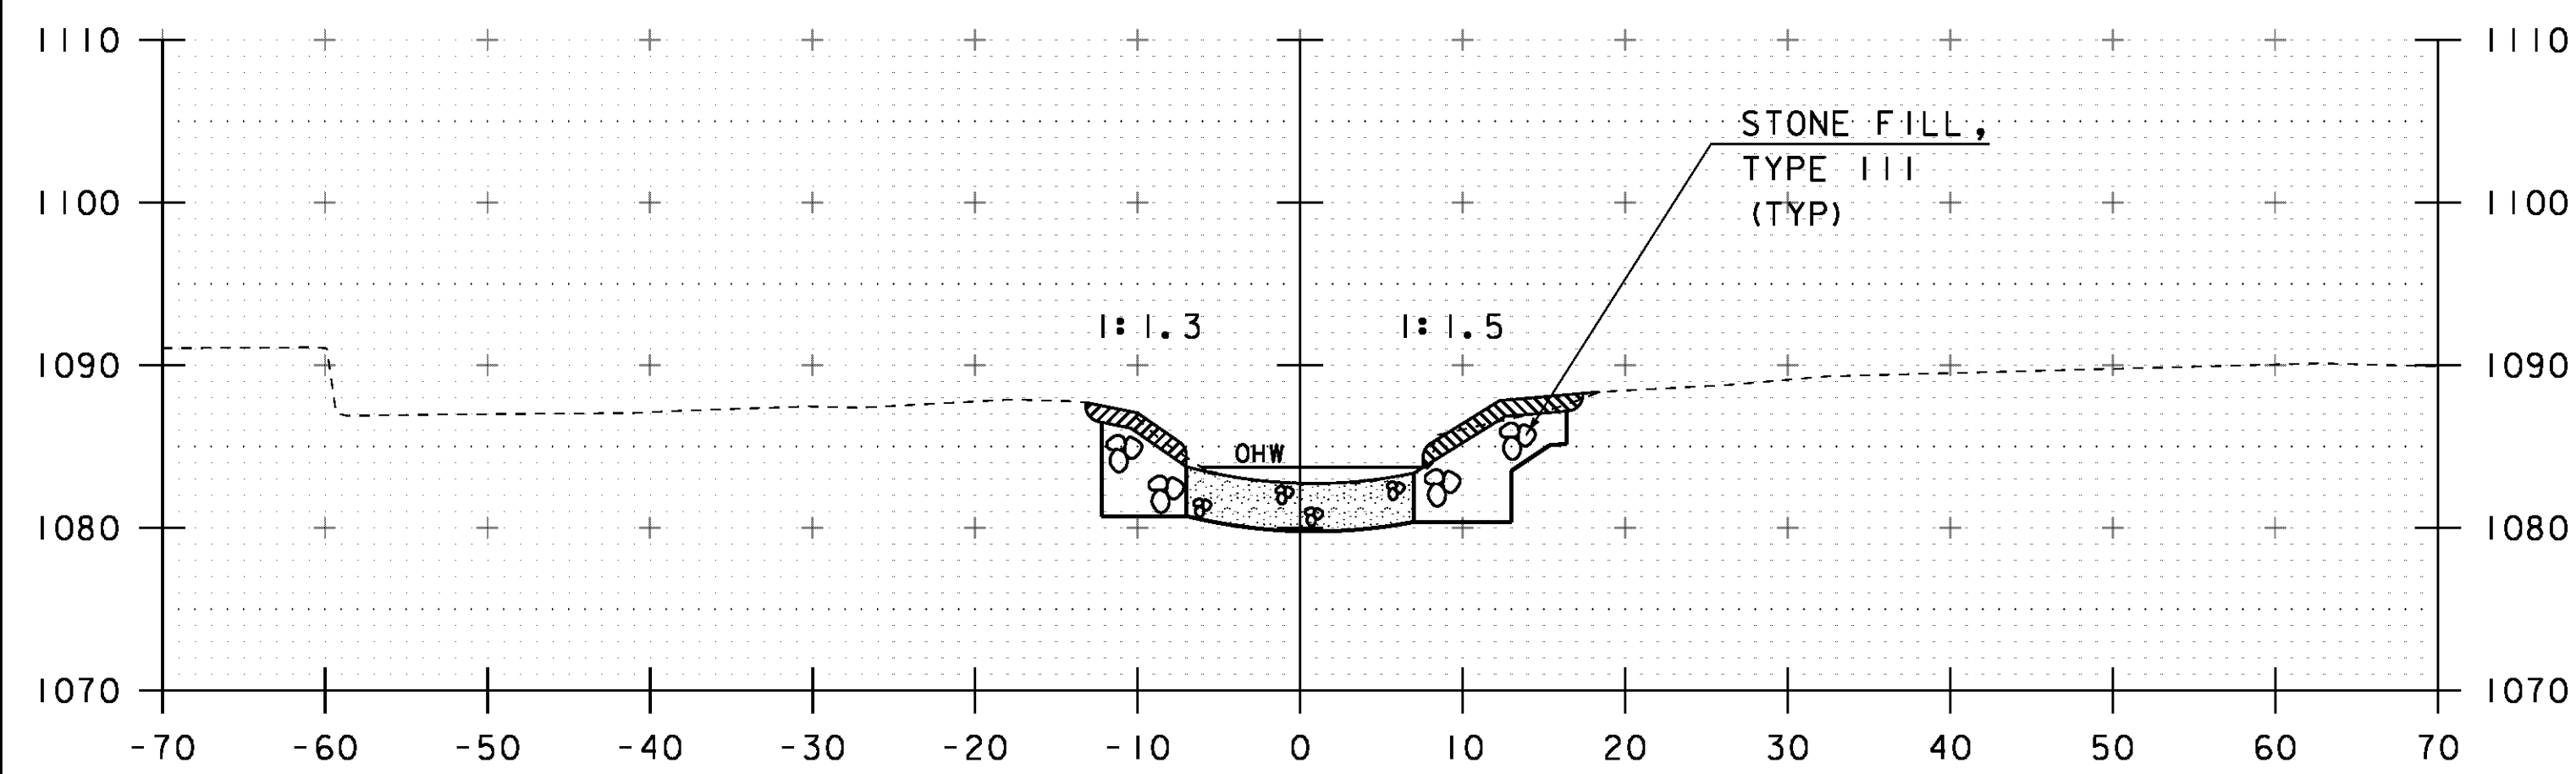

STA 73+72.50
 BEGIN UNCLASSIFIED CHANNEL EXCAVATION
 BEGIN GEOTEXTILE UNDER STONE FILL
 BEGIN STONE FILL, TYPE III
 BEGIN GRUBBING MATERIAL

73+80

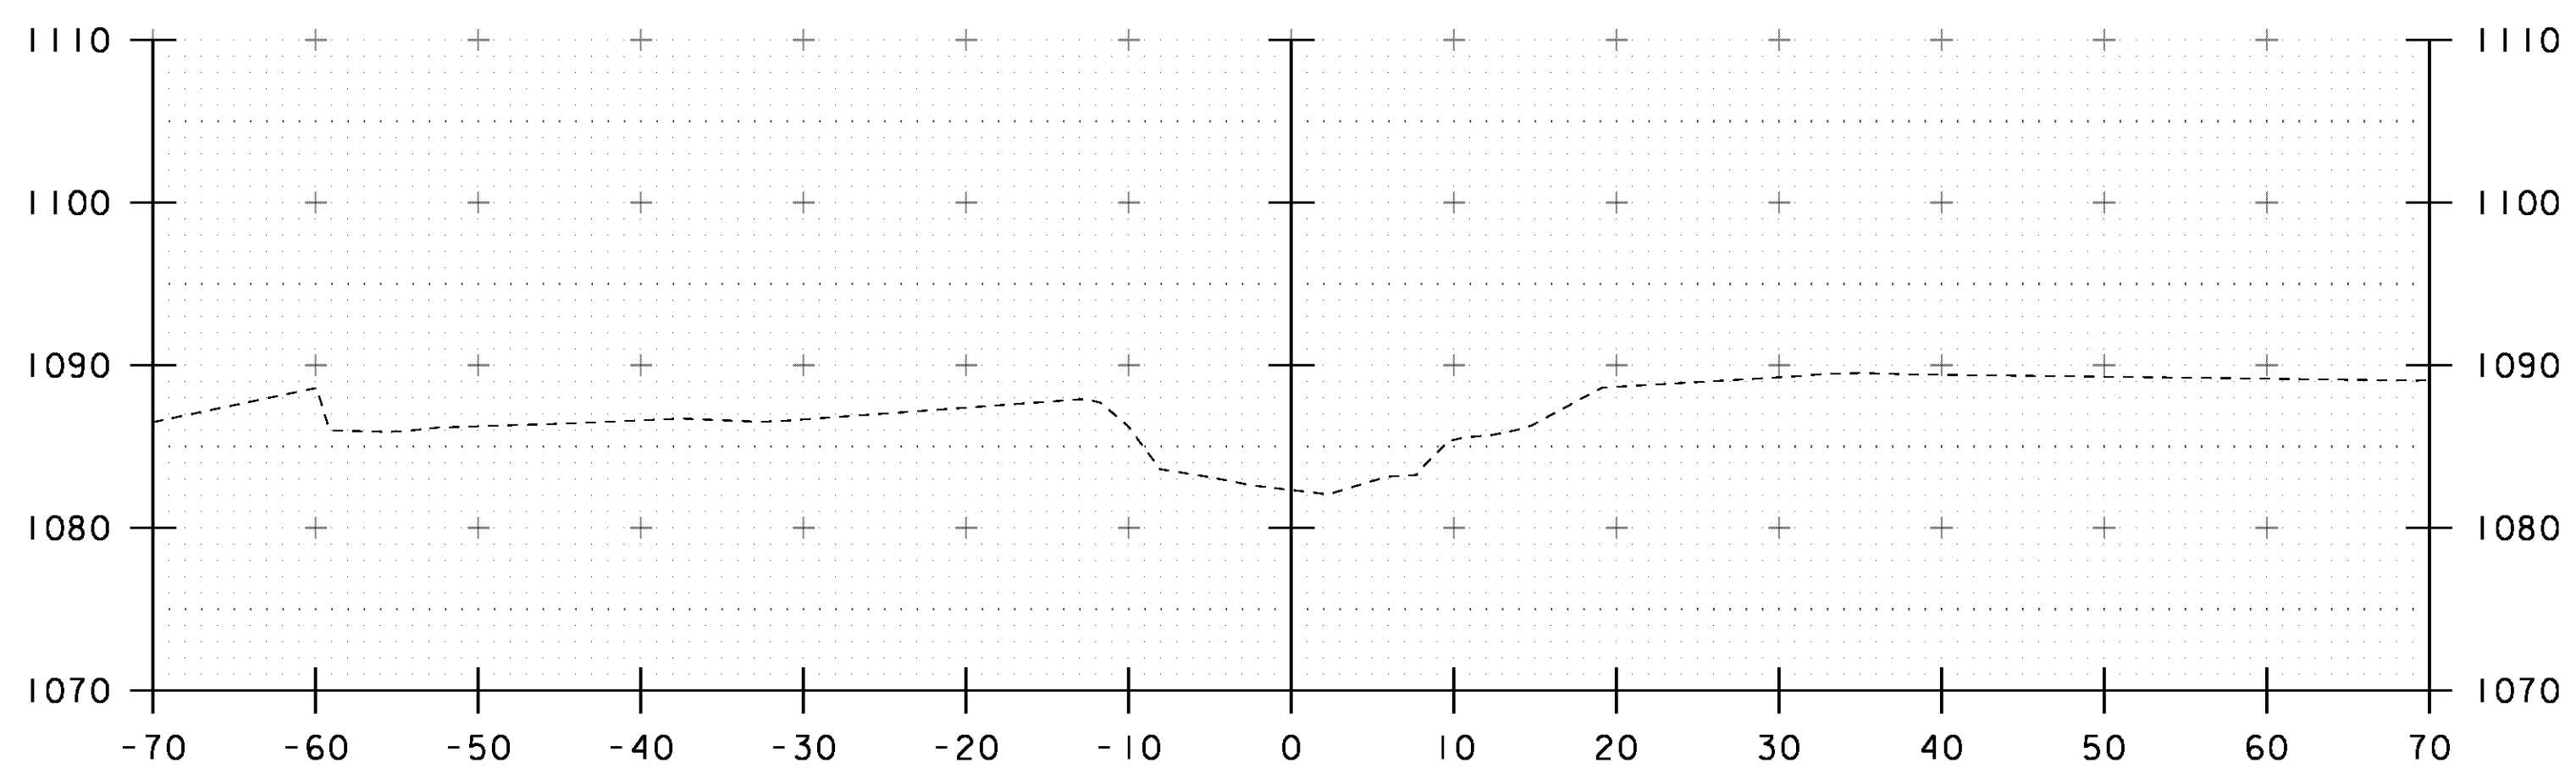

73+90

PROJECT NAME: WARDBORO	PLOT DATE: 26-FEB-2014
PROJECT NUMBER: BF 013-1(22)	DRAWN BY: J. SALVATORI
FILE NAME: sl3b074xs.dgn	CHECKED BY: G. LAROCHE
PROJECT LEADER: K. HIGGINS	SHEET 442 OF 444
DESIGNED BY: J. SALVATORI	
CHANNEL SECTIONS	

STA. 73+80 TO STA. 74+00