



FOR INDEX AND VAOT  
STANDARD SHEETS, REFER  
TO SHEET 2

# STATE OF VERMONT AGENCY OF TRANSPORTATION

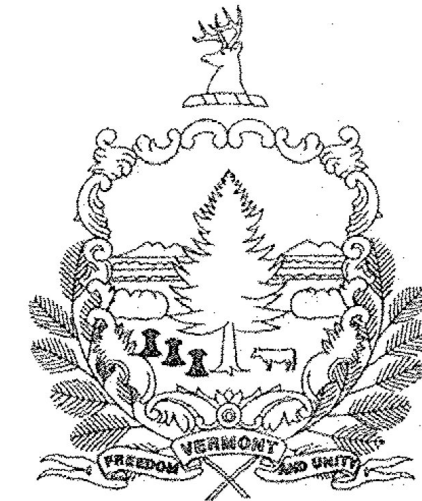


## PROPOSED IMPROVEMENT CULVERT REPLACEMENT PROJECT

### TOWN OF WALLINGFORD COUNTY OF RUTLAND BRIDGE NO.73A AND RR CULVERT C06470 WALLINGFORD ER CULV(39) U.S.ROUTE 7 (PRINCIPAL ARTERIAL)

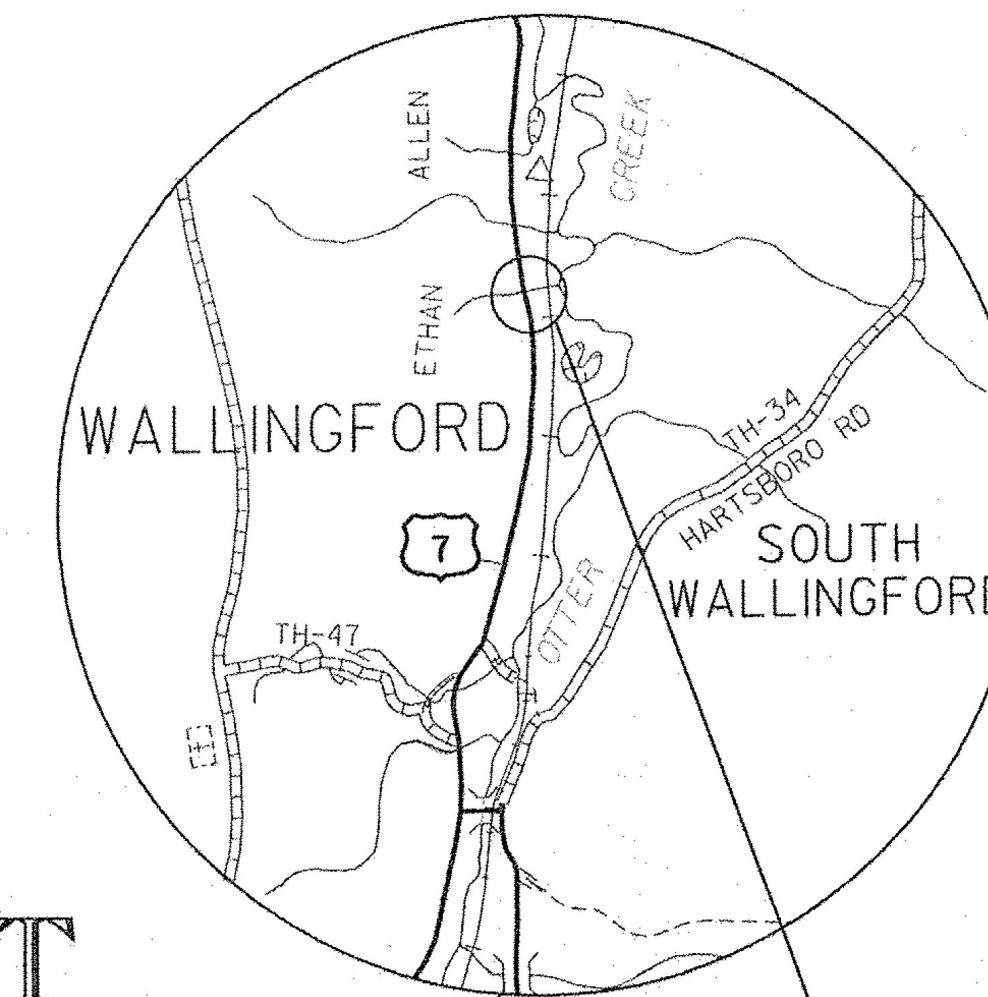

LOCATION MAP  
NOT TO SCALE

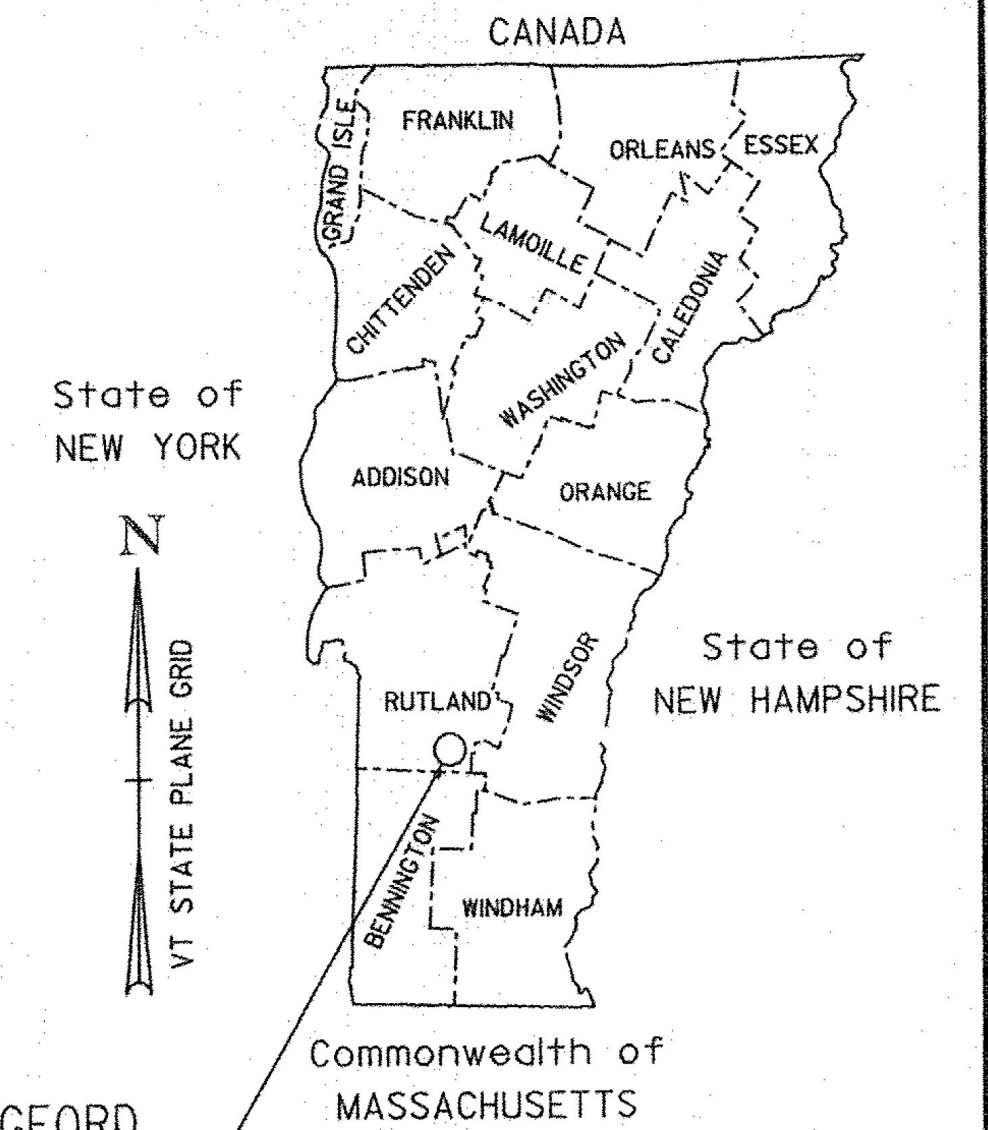

State of  
NEW YORK  
VT STATE PLANE GRID  
N

WALLINGFORD  
ER CULV(39)

PROJECT LOCATION: BRIDGE NO. 73A WALLINGFORD ER CULV(39) IS LOCATED AT MILE MARKER 2.12 ON U.S. ROUTE 7, 3.2 MILES SOUTH OF THE INTERSECTION OF U.S. ROUTE 7 AND VERMONT ROUTE 140. EXISTING RAILROAD CULVERT IS LOCATED DIRECTLY DOWNSTREAM FROM BRIDGE NO. 73A.


PROJECT DESCRIPTION: REPLACEMENT OF EXISTING 24" CPEP & 30" CMP PIPE CULVERTS BENEATH US ROUTE 7 WITH AN 8' x 6' PRECAST CONCRETE STRUCTURE. CONSTRUCTION OF AN 8' x 6' PRECAST BOX CULVERT JUST SOUTH OF EXISTING 3' x 4' STONE BOX CULVERT BENEATH THE RAILROAD.

LENGTH OF PROJECT: 51.00 FT = 0.0100 MI

LENGTH OF BRIDGE NO. 73A STRUCTURE: 9.46 FT = 0.0018 MI

LENGTH OF ROADWAY: 41.54 FT = 0.0079 MI

LENGTH OF RAILROAD STRUCTURE: 10.00 FT = 0.0019 MI

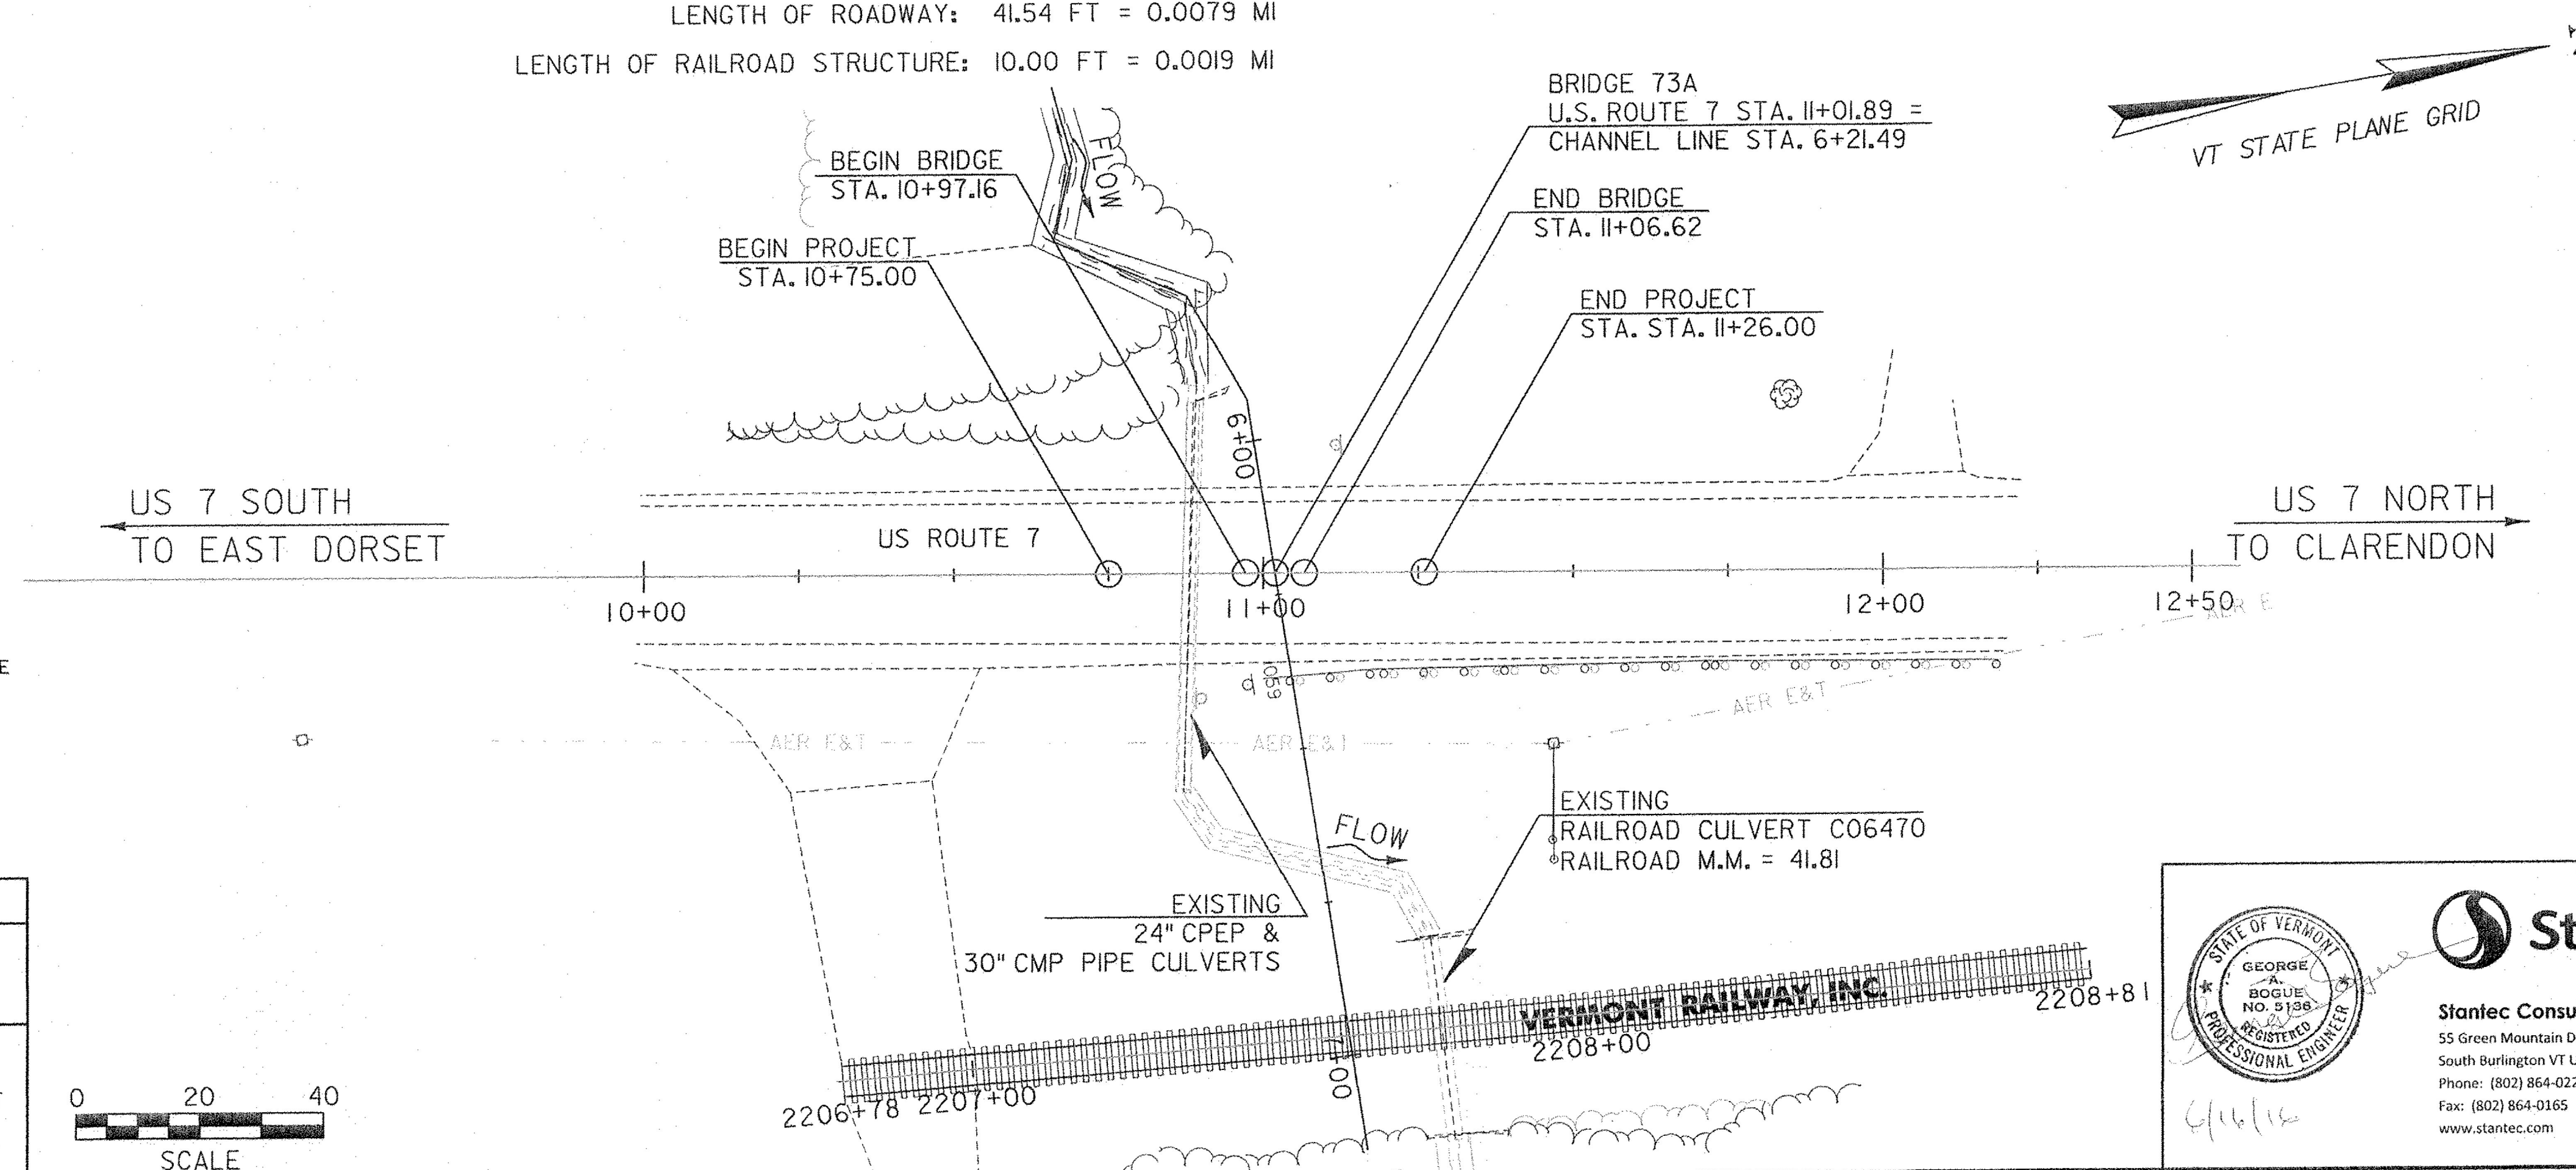

**Record Plans**

Contractor: THE BELDEN COMPANY, INC.  
Resident Engineer: CHRISTOPHER D WILLIAMS  
Construction Began: JULY 10, 2017  
Construction Complete: OCTOBER 15, 2018  
Record Plans By: PAUL KUEHN

I hereby certify that all construction required by this set of drawings has been accomplished as indicated herein.



BY: e-Signed by Christopher Williams on 2018-10-26 14:38:48 GMT Resident Engineer

Date: October 26, 2018

NOTE: Any further information concerning final quantities, amounts or other details relative to this project may be found at Central Files in the electronic archives.

CONSTRUCTION IS TO BE CARRIED ON IN ACCORDANCE WITH THESE PLANS AND THE STANDARD SPECIFICATIONS FOR CONSTRUCTION DATED 2011, AS APPROVED BY THE FEDERAL HIGHWAY ADMINISTRATION ON JULY 20, 2011 FOR USE ON THIS PROJECT, INCLUDING ALL SUBSEQUENT REVISIONS AND SUCH REVISED SPECIFICATIONS AND SPECIAL PROVISIONS AS ARE INCORPORATED IN THESE PLANS.

QUALITY ASSURANCE PROGRAM : LEVEL 2	
SURVEYED BY : VSE	
SURVEYED DATE : AUGUST 2012	
DATUM	
VERTICAL	NAVD 88 (GEOID12) FT
HORIZONTAL	NAD 83 (2011) SPC (4400 VT) sFT

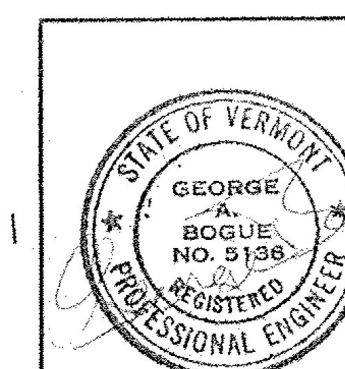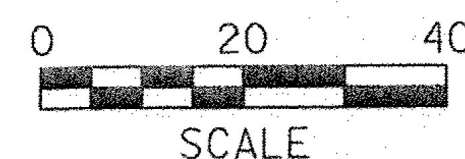

**Stantec**  
Stantec Consulting Services Inc.  
55 Green Mountain Drive  
South Burlington VT U.S.A. 05403  
Phone: (802) 864-0223  
Fax: (802) 864-0165  
www.stantec.com

DIRECTOR OF PROJECT DELIVERY	APPROVED	DATE: 7/19/2016
PROJECT MANAGER : KEN UPMAL, PE		
PROJECT NAME : WALLINGFORD		
PROJECT NUMBER : ER CULV (39)		
SHEET 1 OF 36 SHEETS		