

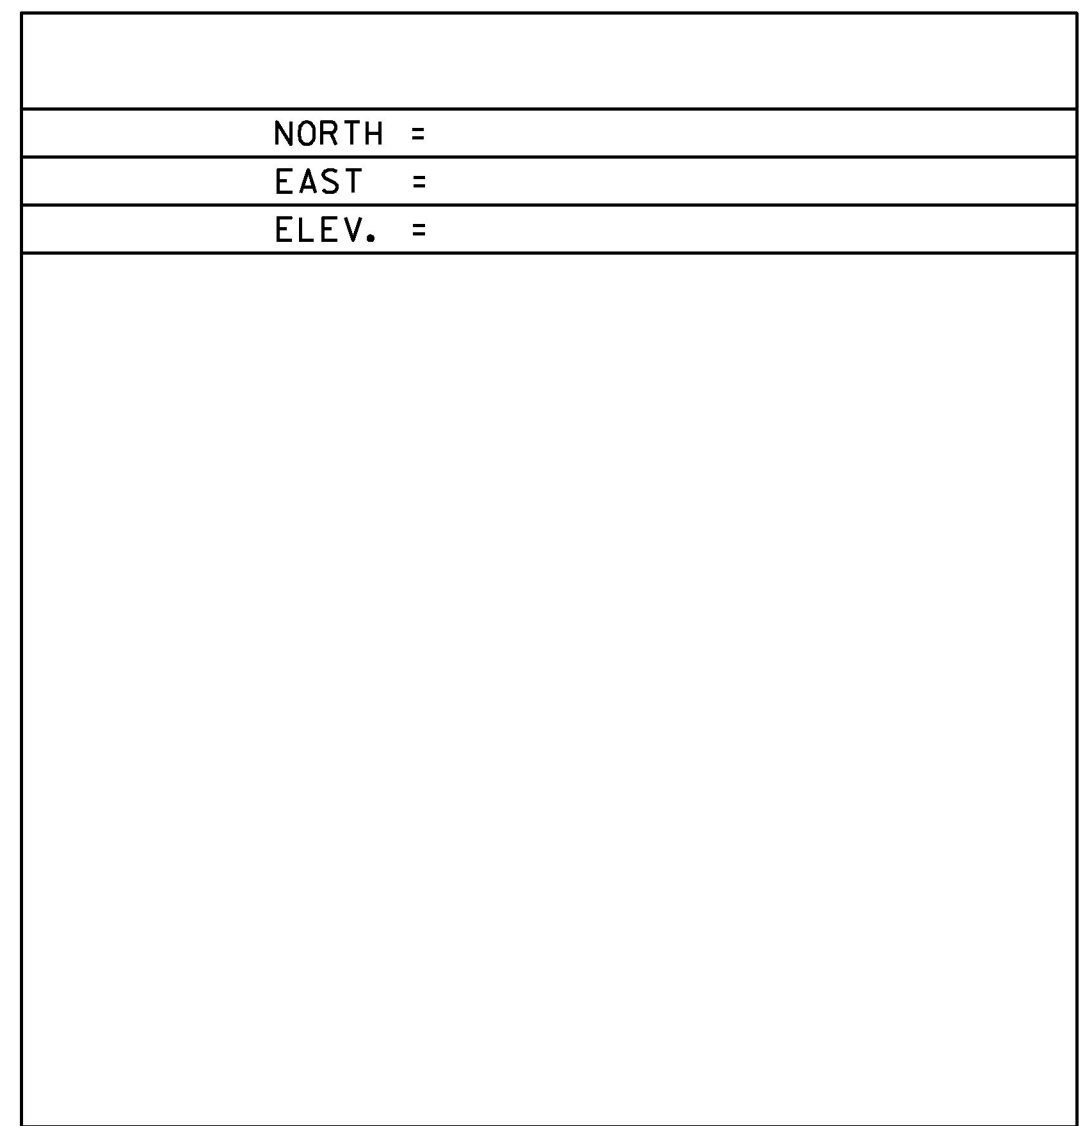
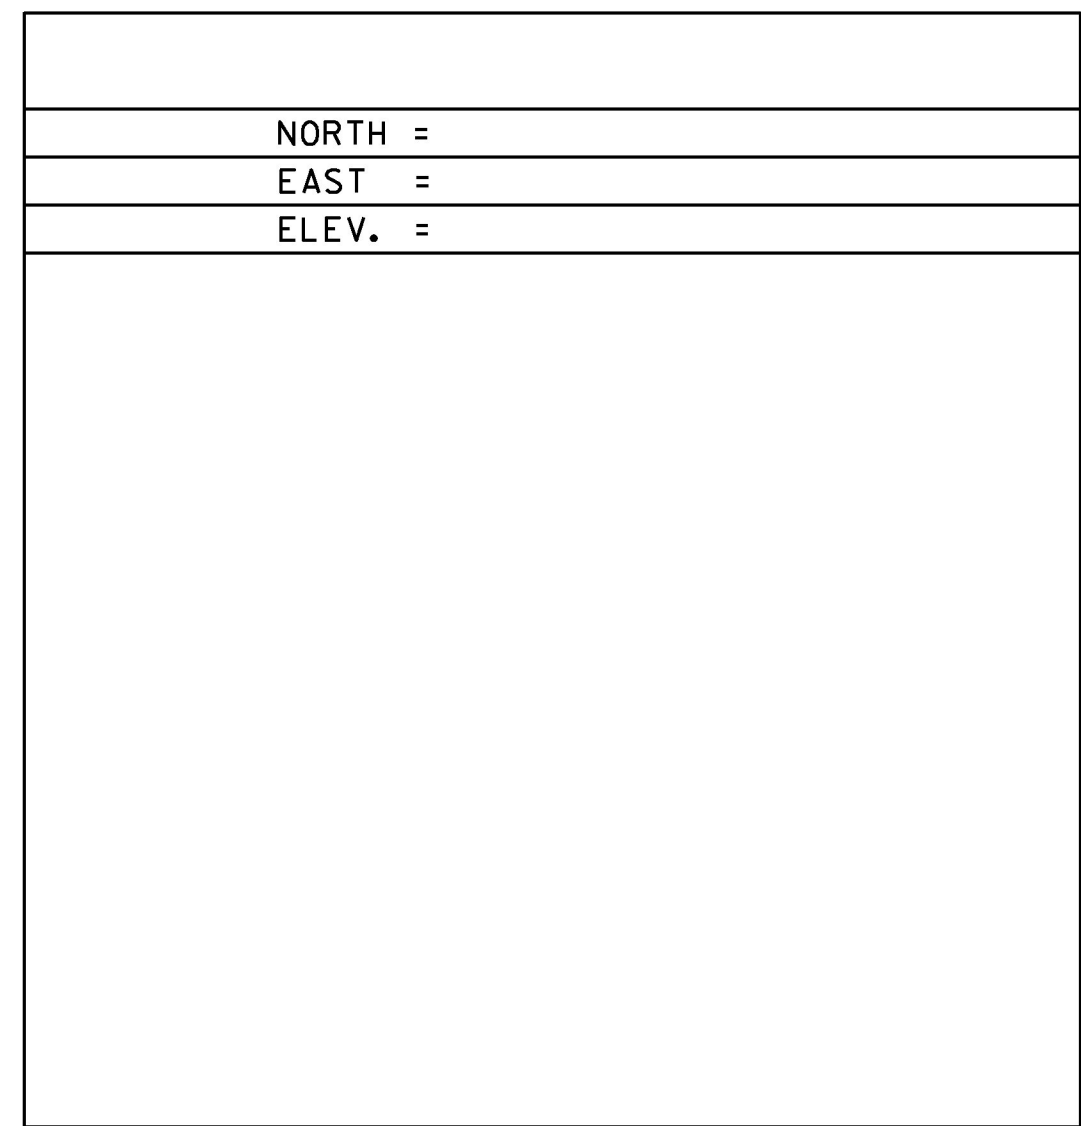
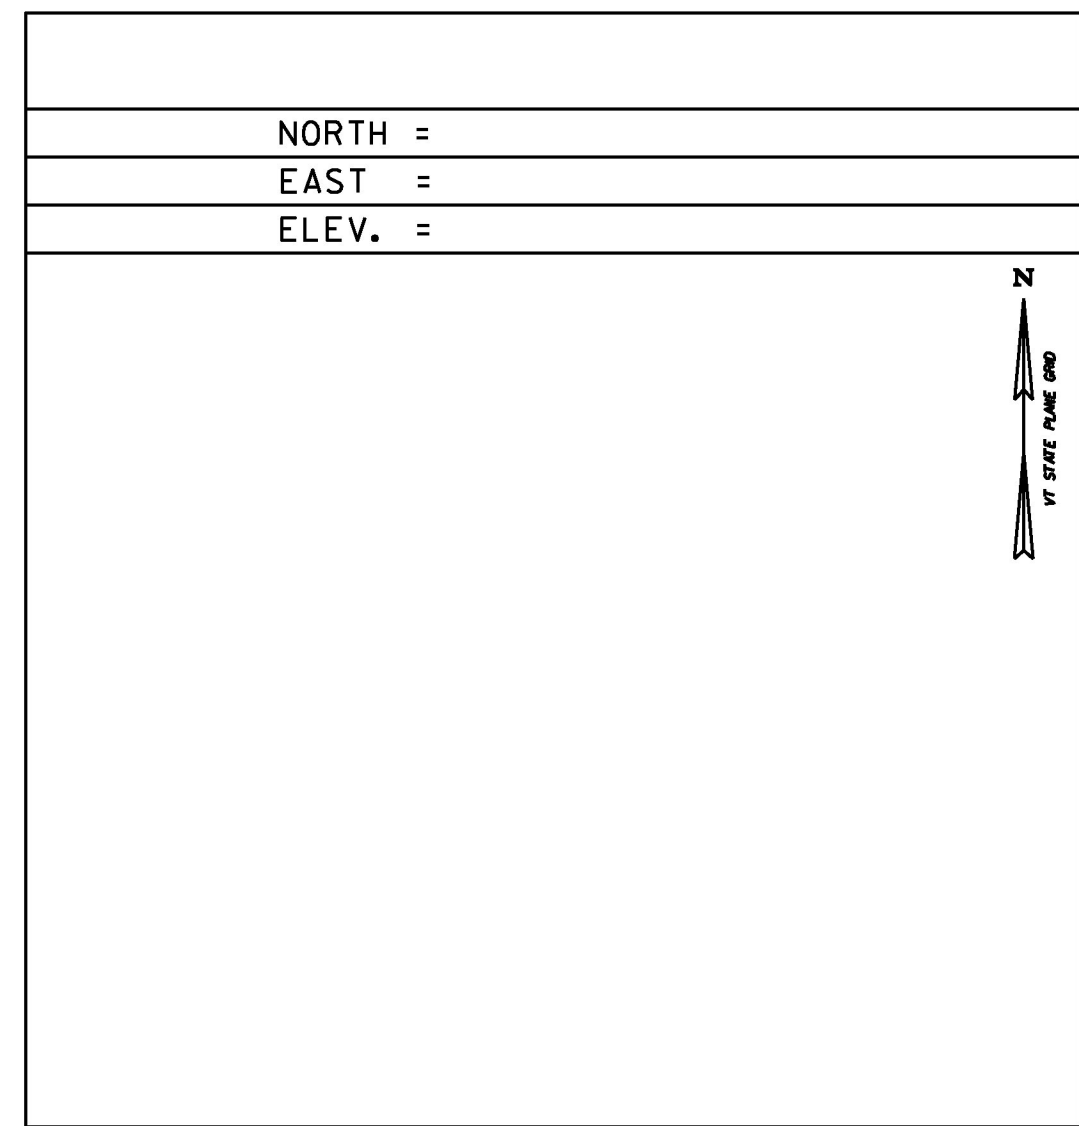
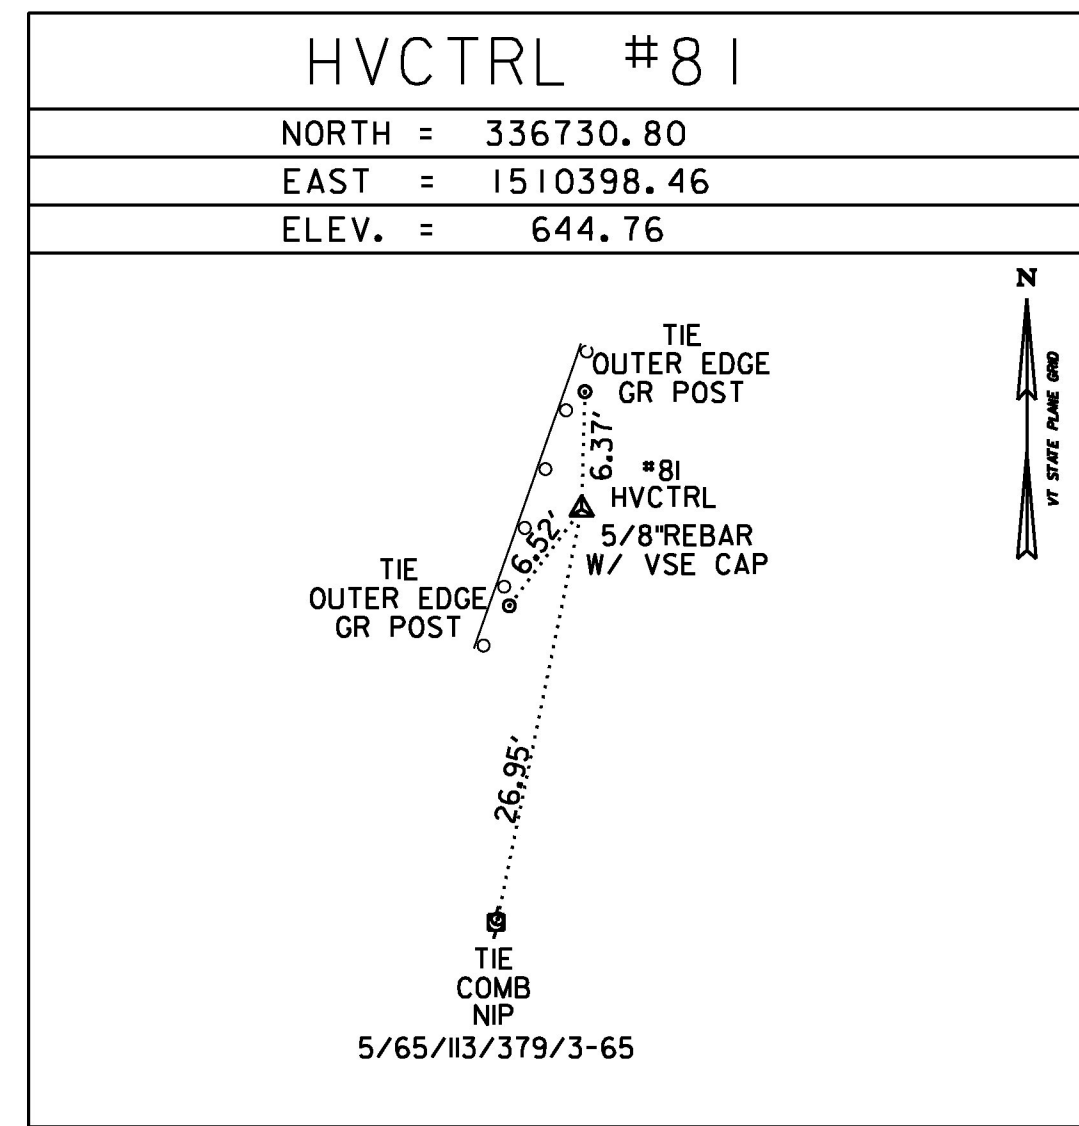
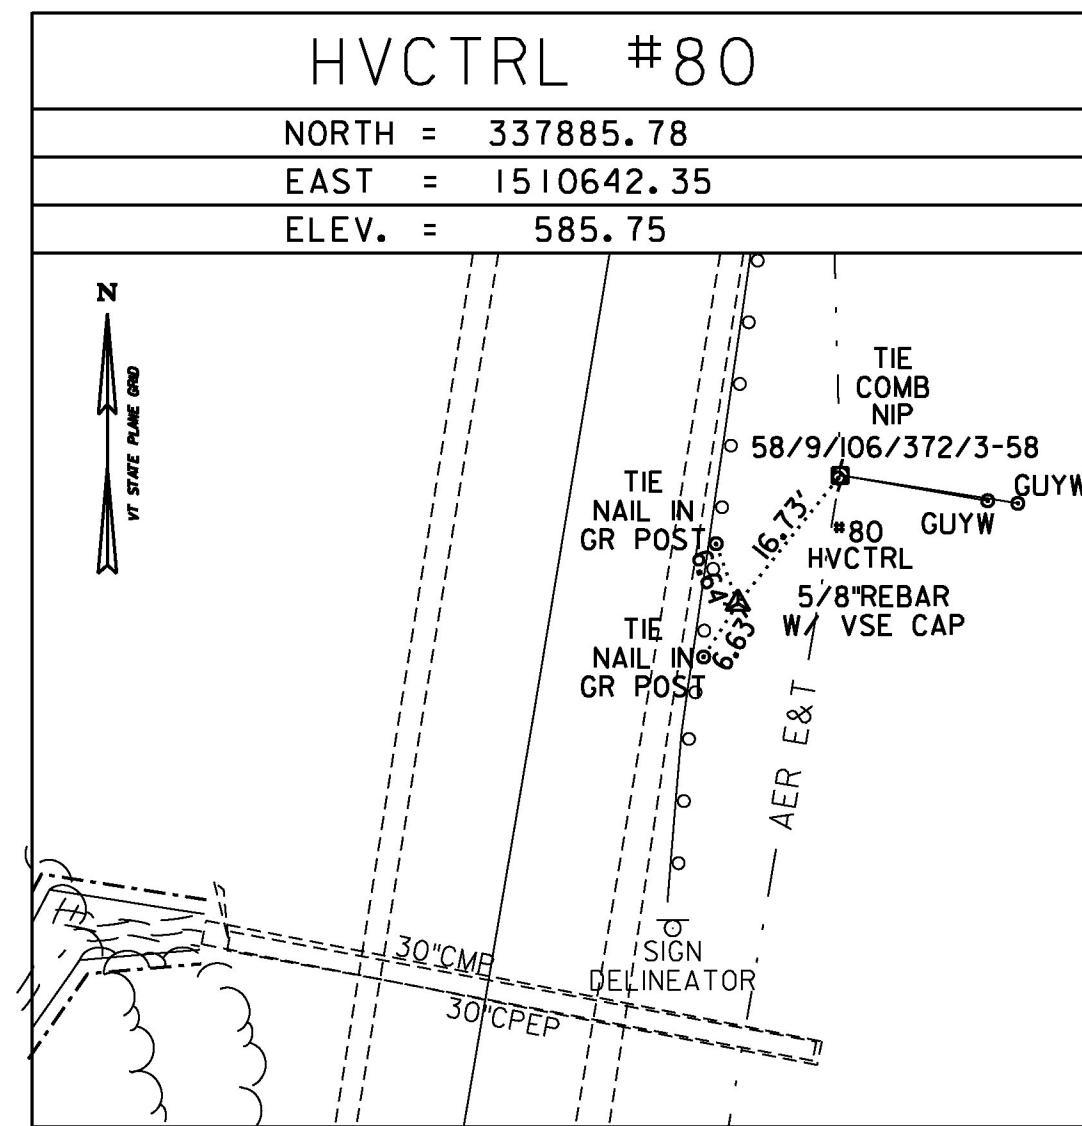
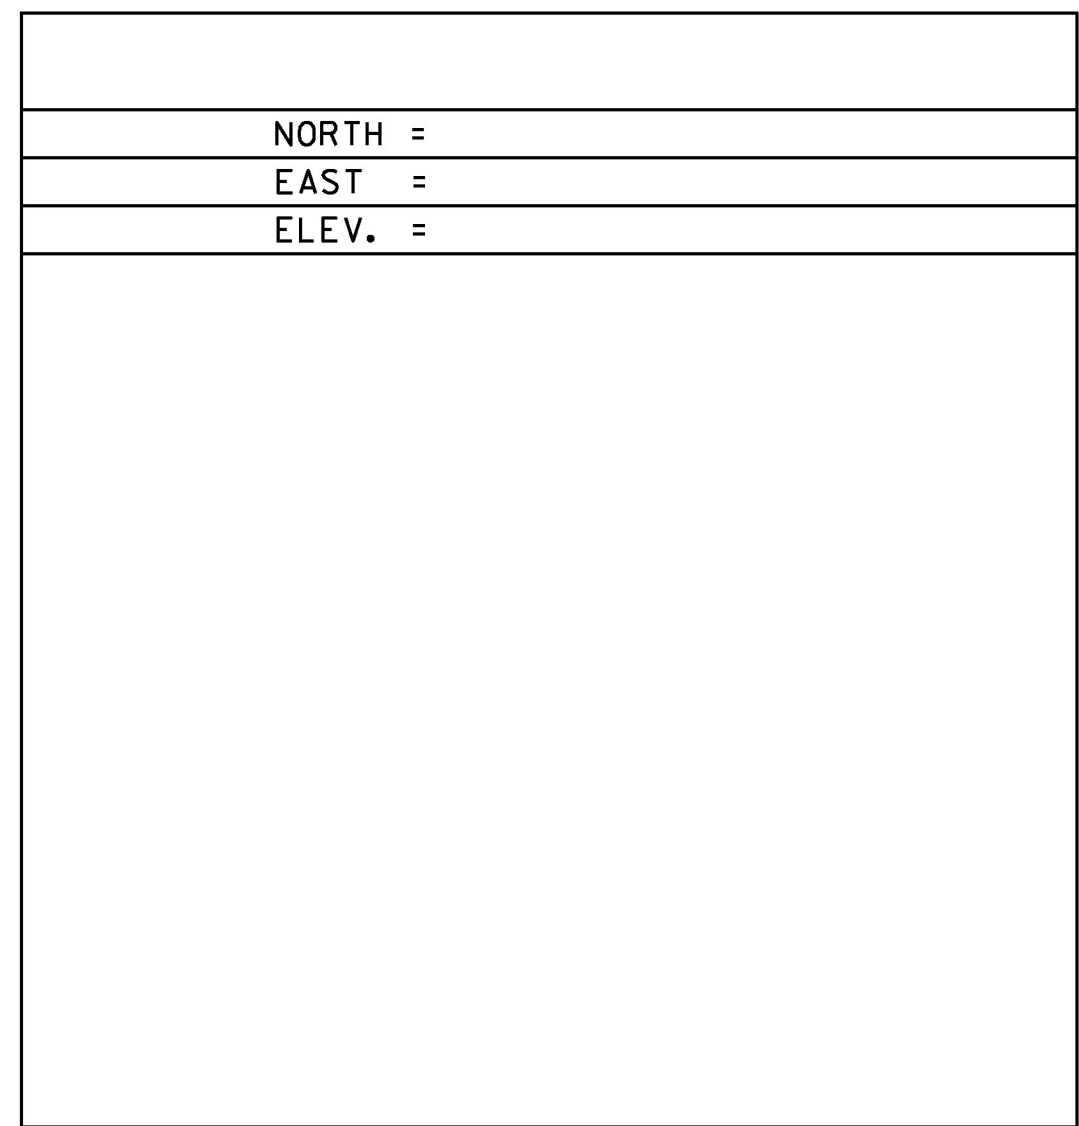
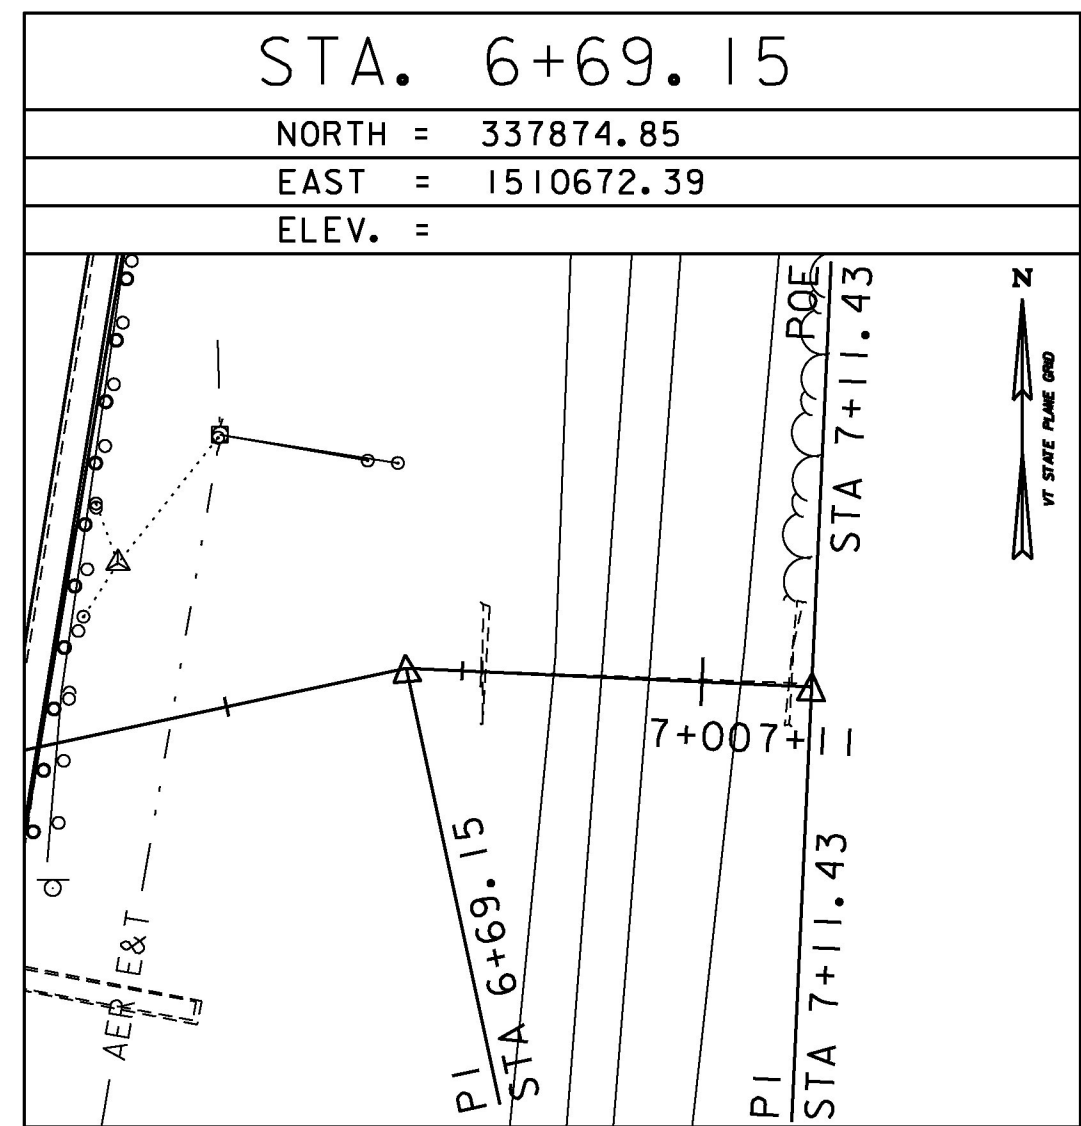
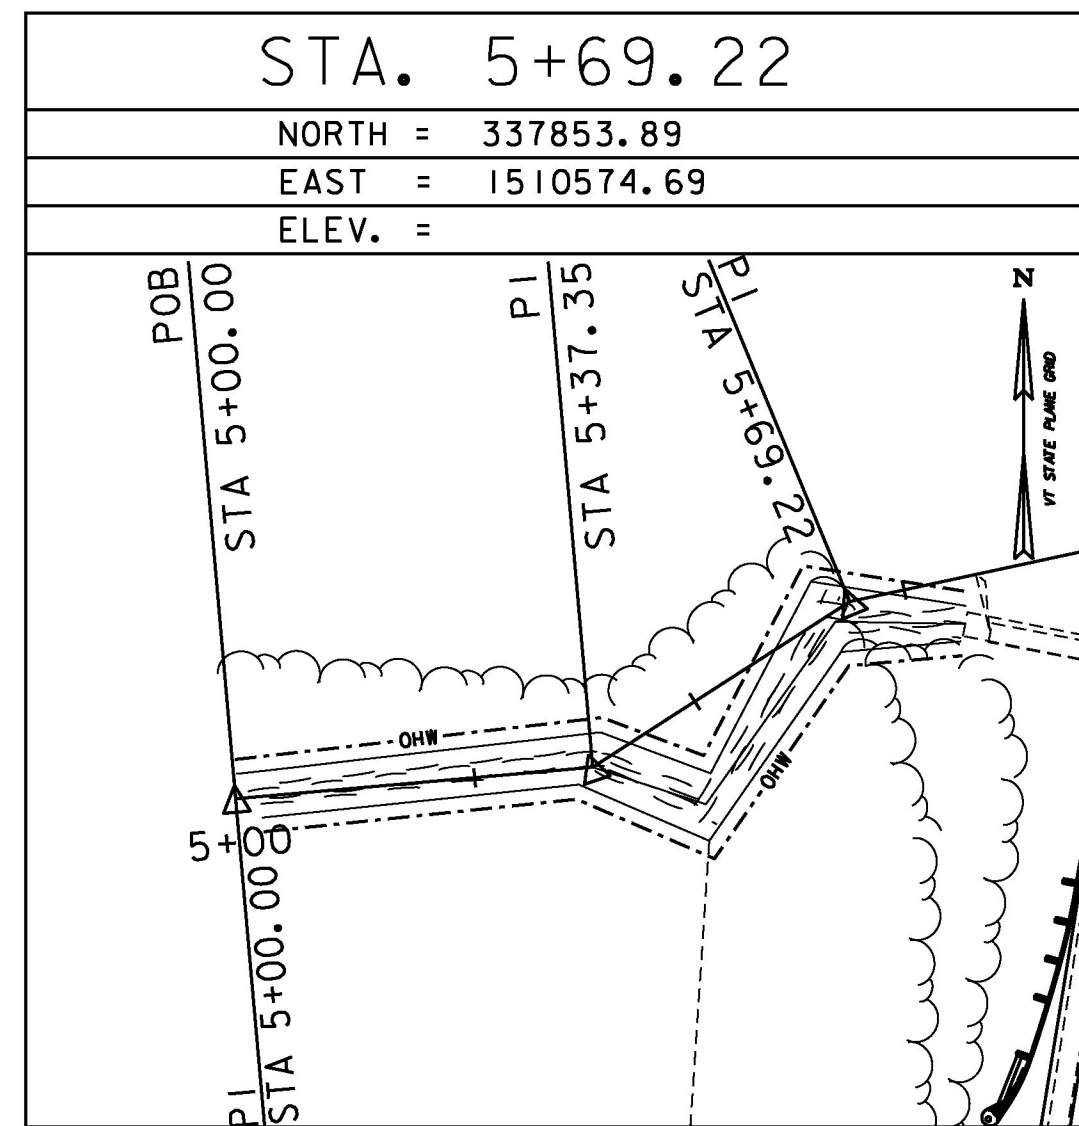


GPS CONTROL POINTS

TRAVERSE TIES

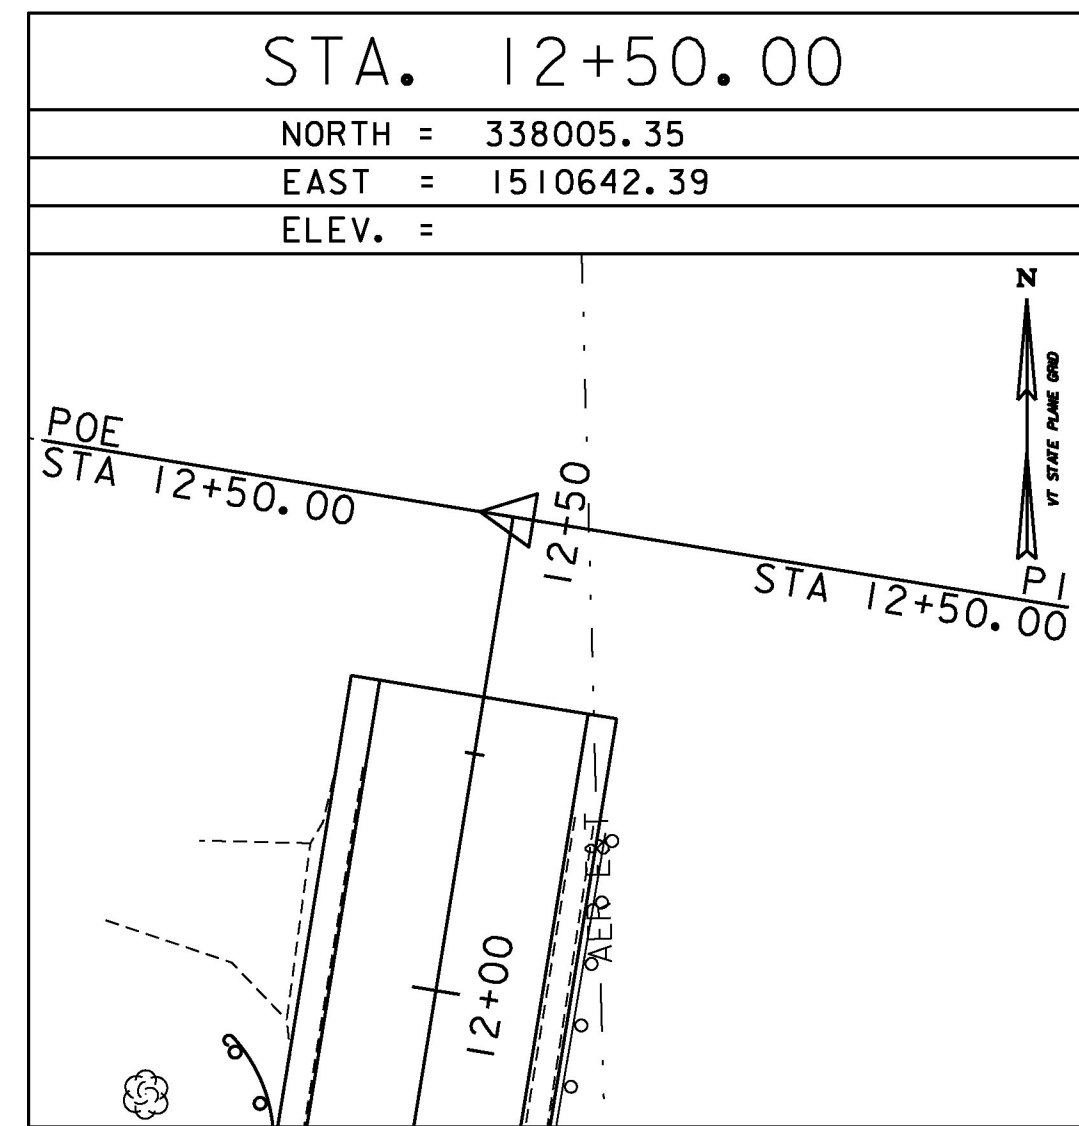

ALIGNMENT TIES

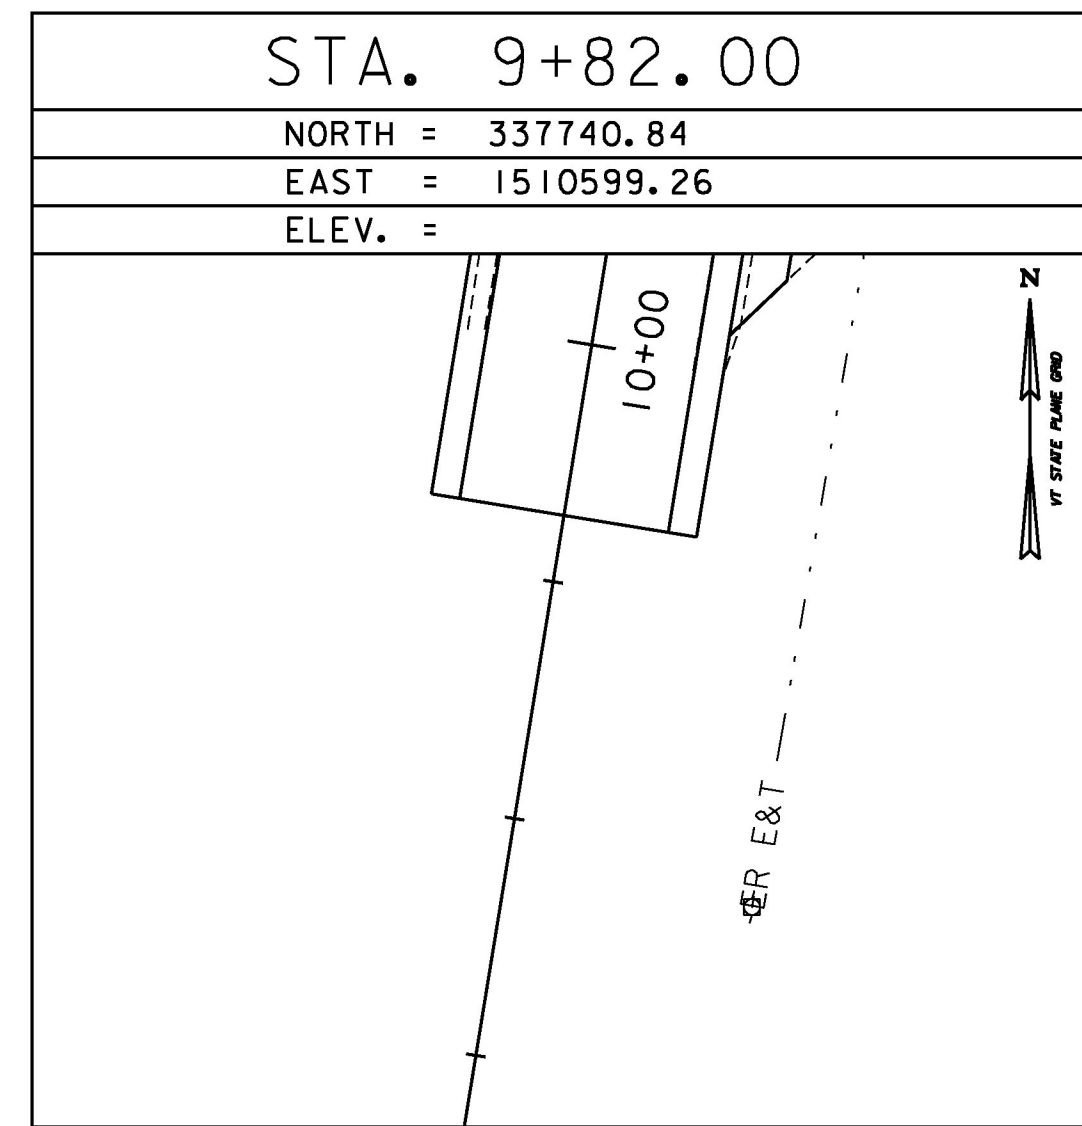

DATUM	
VERTICAL	NAVD 88
HORIZONTAL	NAD 83 (2011)
ADJUSTMENT	NONE

PROJECT NAME: WALLINGFORD	
PROJECT NUMBER: ER CULV(39)	
FILE NAME: z12b380_TIE_SHEET.dgn	PLOT DATE: 6/16/2016
PROJECT LEADER: G. BOGUE	DRAWN BY: J. SOTER
DESIGNED BY: I. MAYNARD	CHECKED BY: I. MAYNARD
SURVEY CONTROL AND TIES	SHEET 9 OF 36

