


SEE CONTRACTOR'S APPROVED EPSC PLAN IN JOB RECORDS.

ASSUMED 25' x 25' TEMPORARY WORK AREA FOR IMPOUNDMENT AND/OR STREAM DIVERSION.

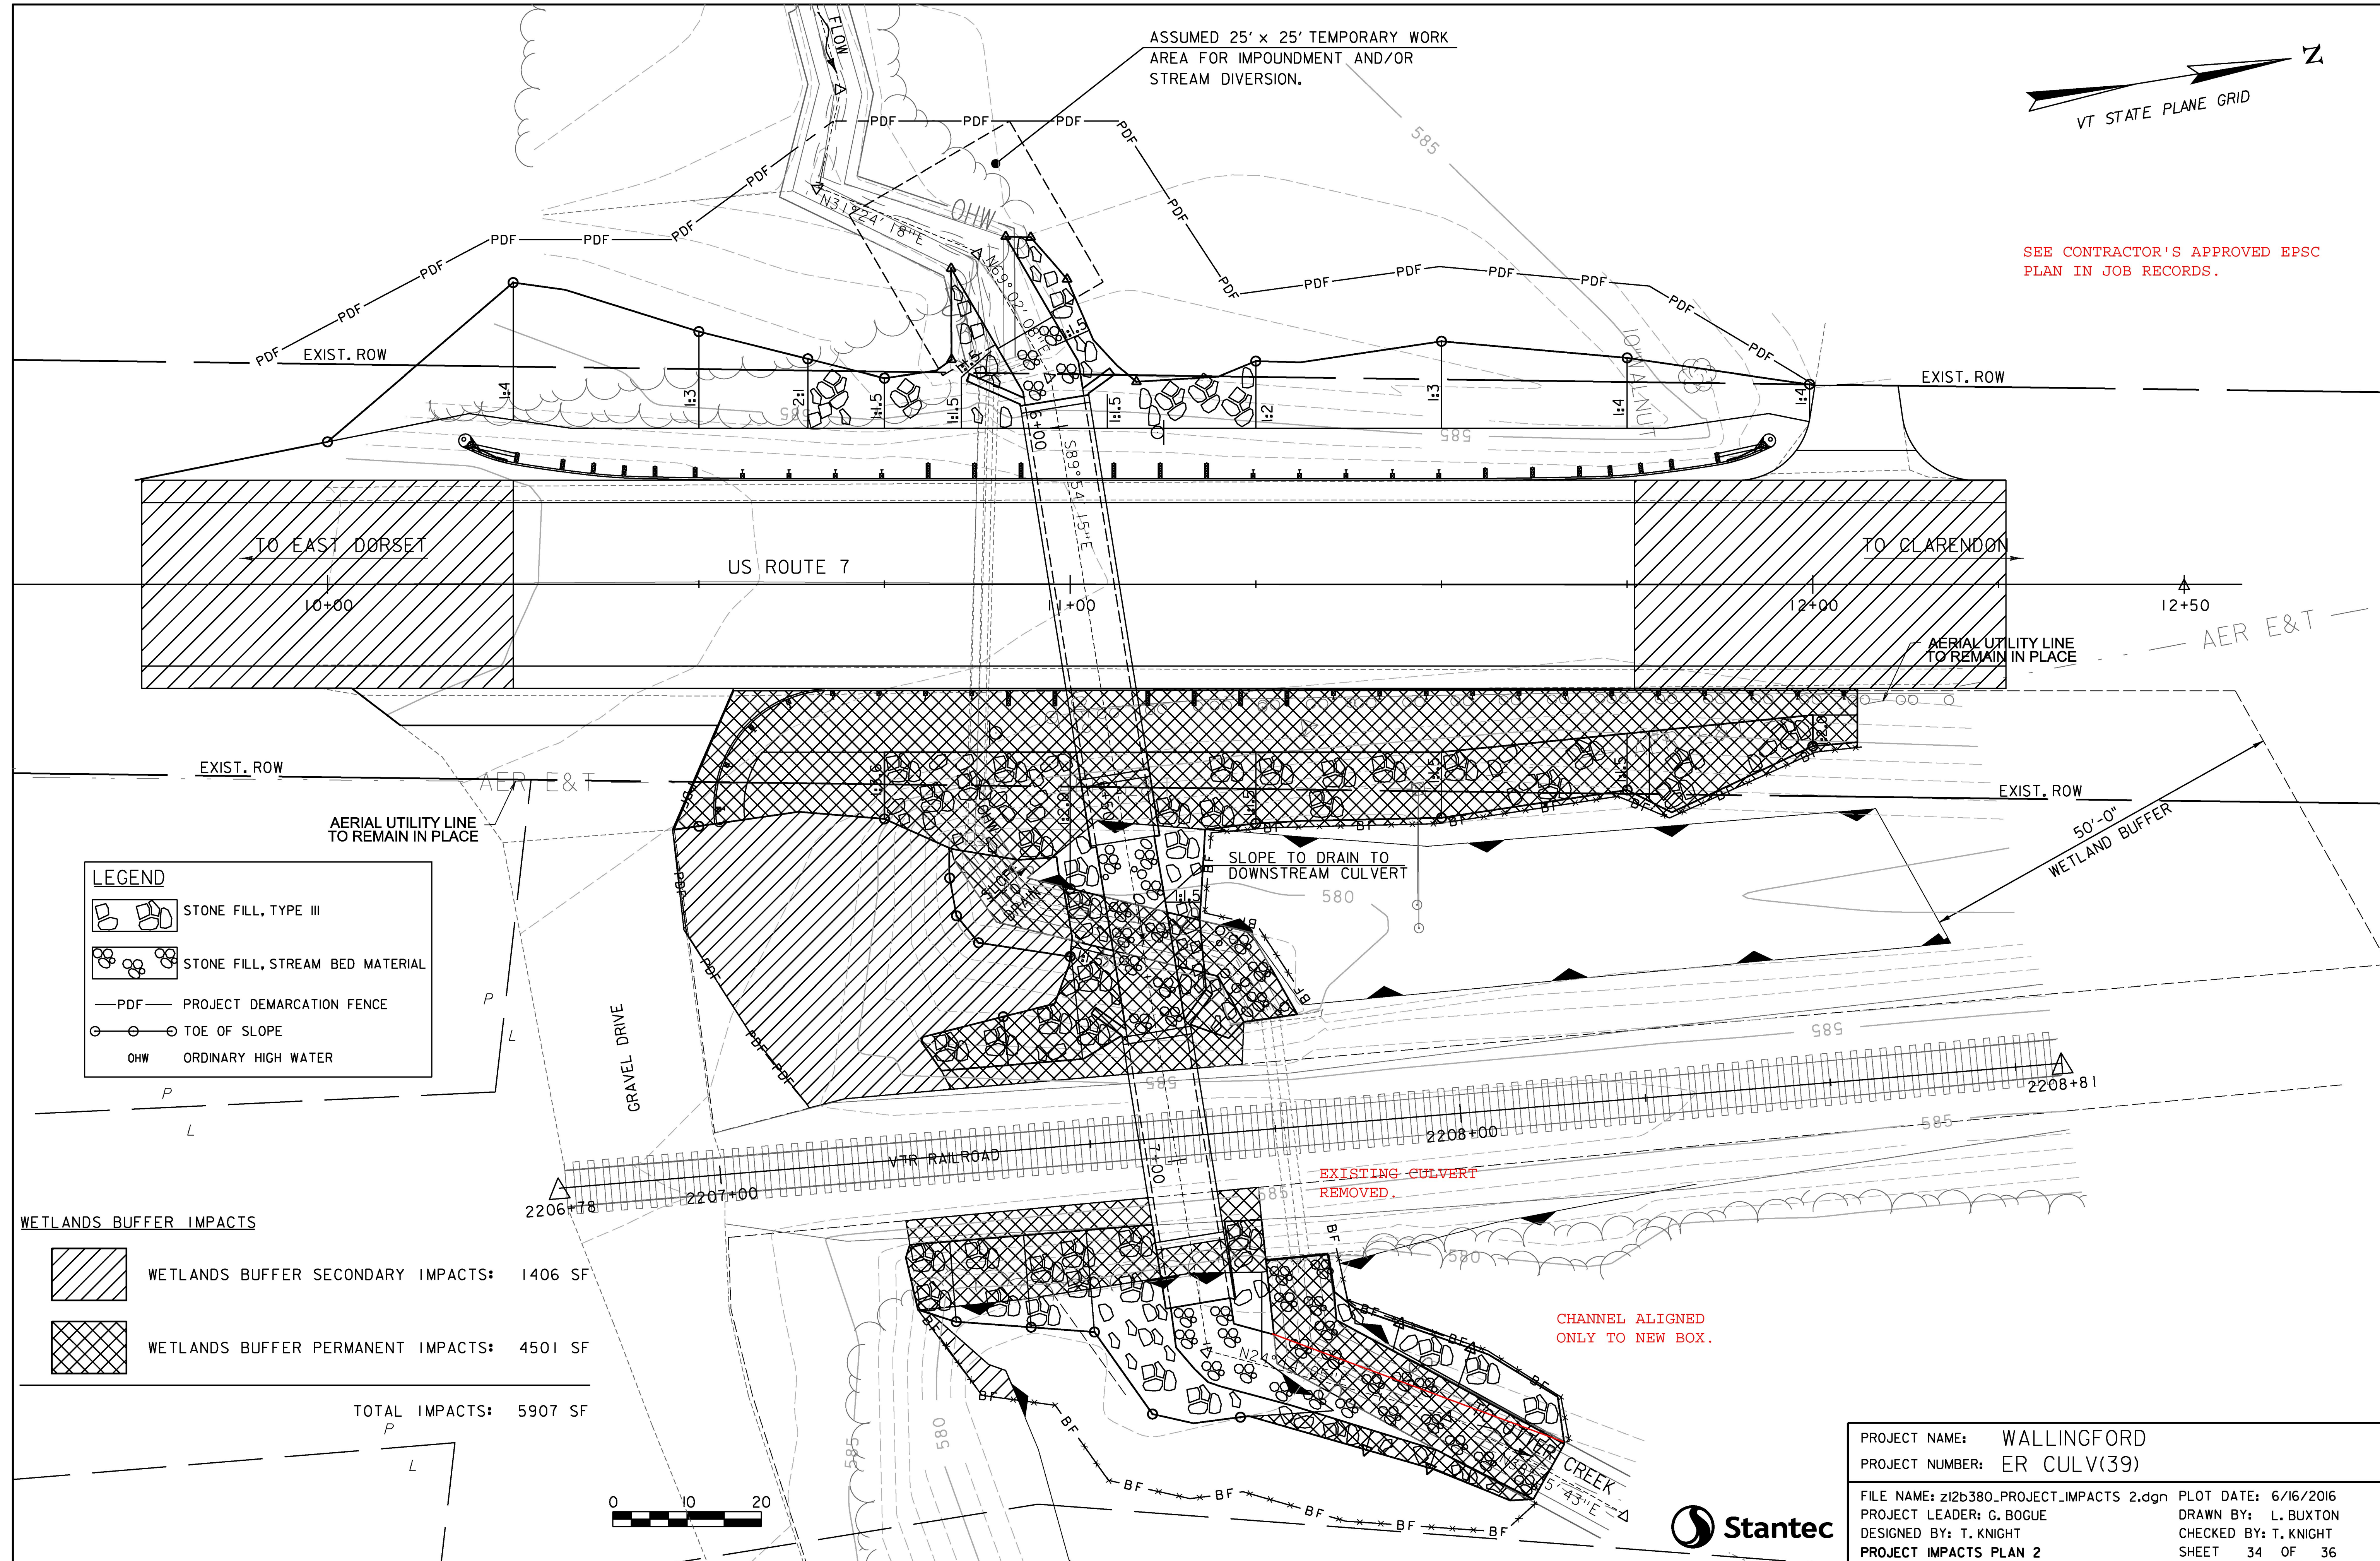


LEGEND

- STONE FILL, TYPE III
- STONE FILL, STREAM BED MATERIAL
- PROJECT DEMARCATION FENCE
- TOE OF SLOPE
- ORDINARY HIGH WATER

WETLANDS BUFFER IMPACTS

- WETLANDS BUFFER SECONDARY IMPACTS: 1406 SF
- WETLANDS BUFFER PERMANENT IMPACTS: 4501 SF

TOTAL IMPACTS: 5907 SF

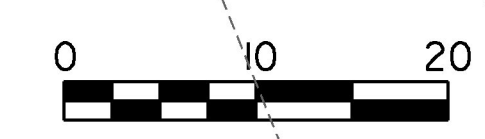

EXISTING CULVERT REMOVED.

CHANNEL ALIGNED ONLY TO NEW BOX.

PROJECT NAME:	WALLINGFORD
PROJECT NUMBER:	ER CULV(39)
FILE NAME: z12b380_PROJECT_IMPACTS 2.dgn	PLOT DATE: 6/16/2016
PROJECT LEADER: G. BOGUE	DRAWN BY: L. BUXTON
DESIGNED BY: T. KNIGHT	CHECKED BY: T. KNIGHT
PROJECT IMPACTS PLAN 2	SHEET 34 OF 36

