



# STATE OF VERMONT AGENCY OF TRANSPORTATION

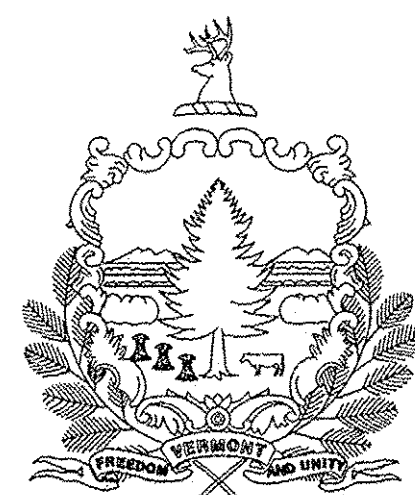


## PROPOSED IMPROVEMENT TOWN OF WOODFORD COUNTY OF BENNINGTON VT ROUTE 9 (PRINCIPAL ARTERIAL - NHS)

RECORD PLANS	
CONTRACTOR:	CASELLA CONSTRUCTION, INC. - MENDON, VT
RESIDENT ENGINEER:	RON LEMAIRE
CONSTRUCTION BEGAN:	JULY 6, 2015
CONSTRUCTION COMPLETE:	SEPTEMBER 25, 2015
RECORD PLANS BY:	RON LEMAIRE & AARON JAMES
I HEREBY CERTIFY THAT ALL THE CONSTRUCTION REQUIRED BY THIS SET OF DRAWINGS HAS BEEN ACCOMPLISHED AS INDICATED HEREIN.	
BY:	RESIDENT ENGINEER
DATE:	9/20/16
NOTE: Any further information concerning final quantities, amounts or other details relative to this project may be found at Central Files in the electronic archives.	

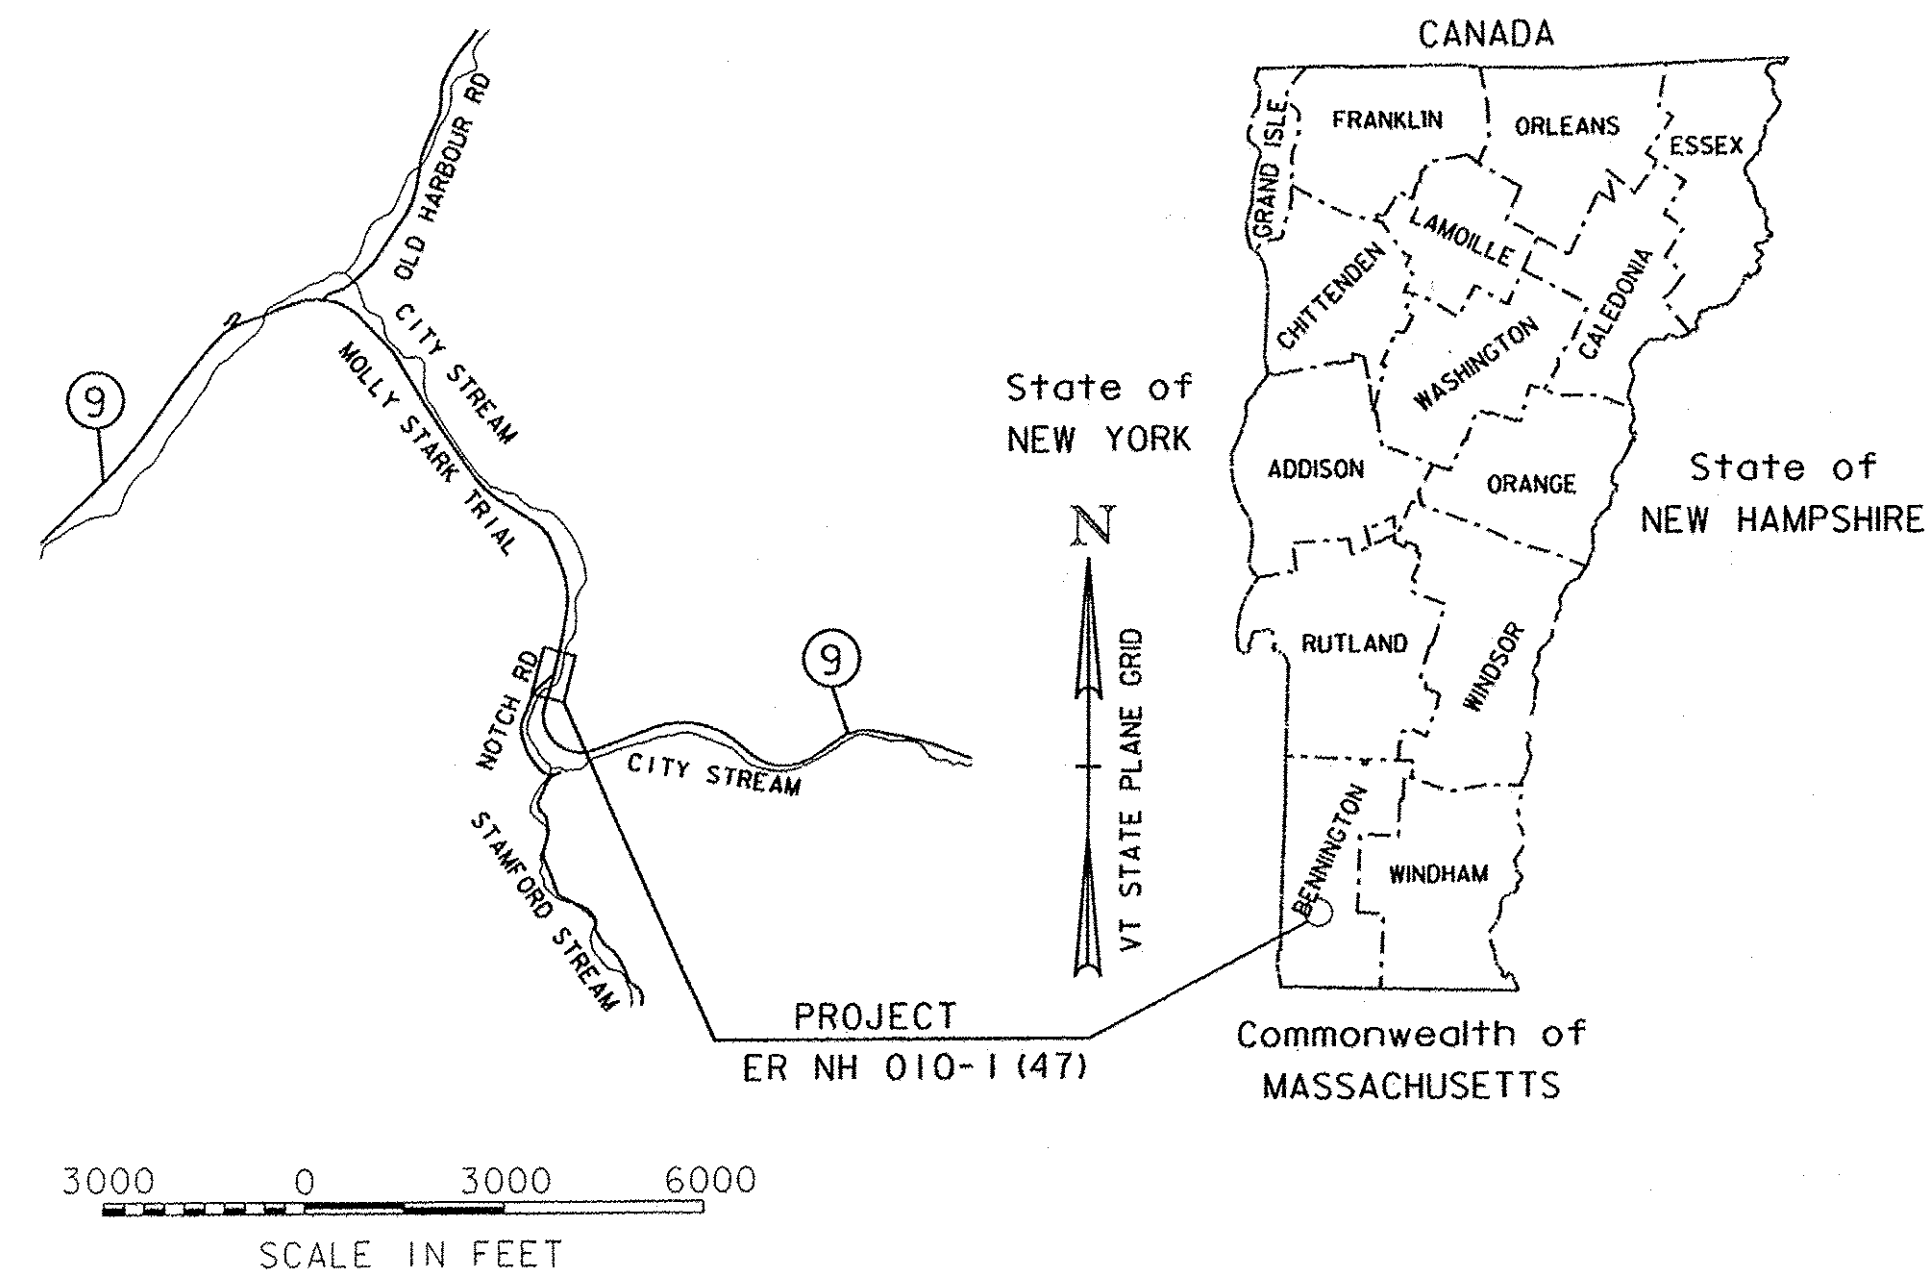


BEGINNING IN THE TOWN OF WOODFORD ALONG CITY STREAM AT A POINT APPROXIMATELY 338-FEET UPSTREAM OF THE UPSTREAM FACE OF BRIDGE #12 ON VT ROUTE 9 AND EXTENDING 525.13 FEET DOWNSTREAM  
LENGTH OF PROJECT = 525.13 FEET (0.099 MILES)  
THIS PROJECT CONSISTS OF EMBANKMENT RECONSTRUCTION, CHANNEL BOTTOM ARMORING, GUARDRAIL, INSTALLING STONE FILL AND EROSION PREVENTION AND SEDIMENT CONTROL

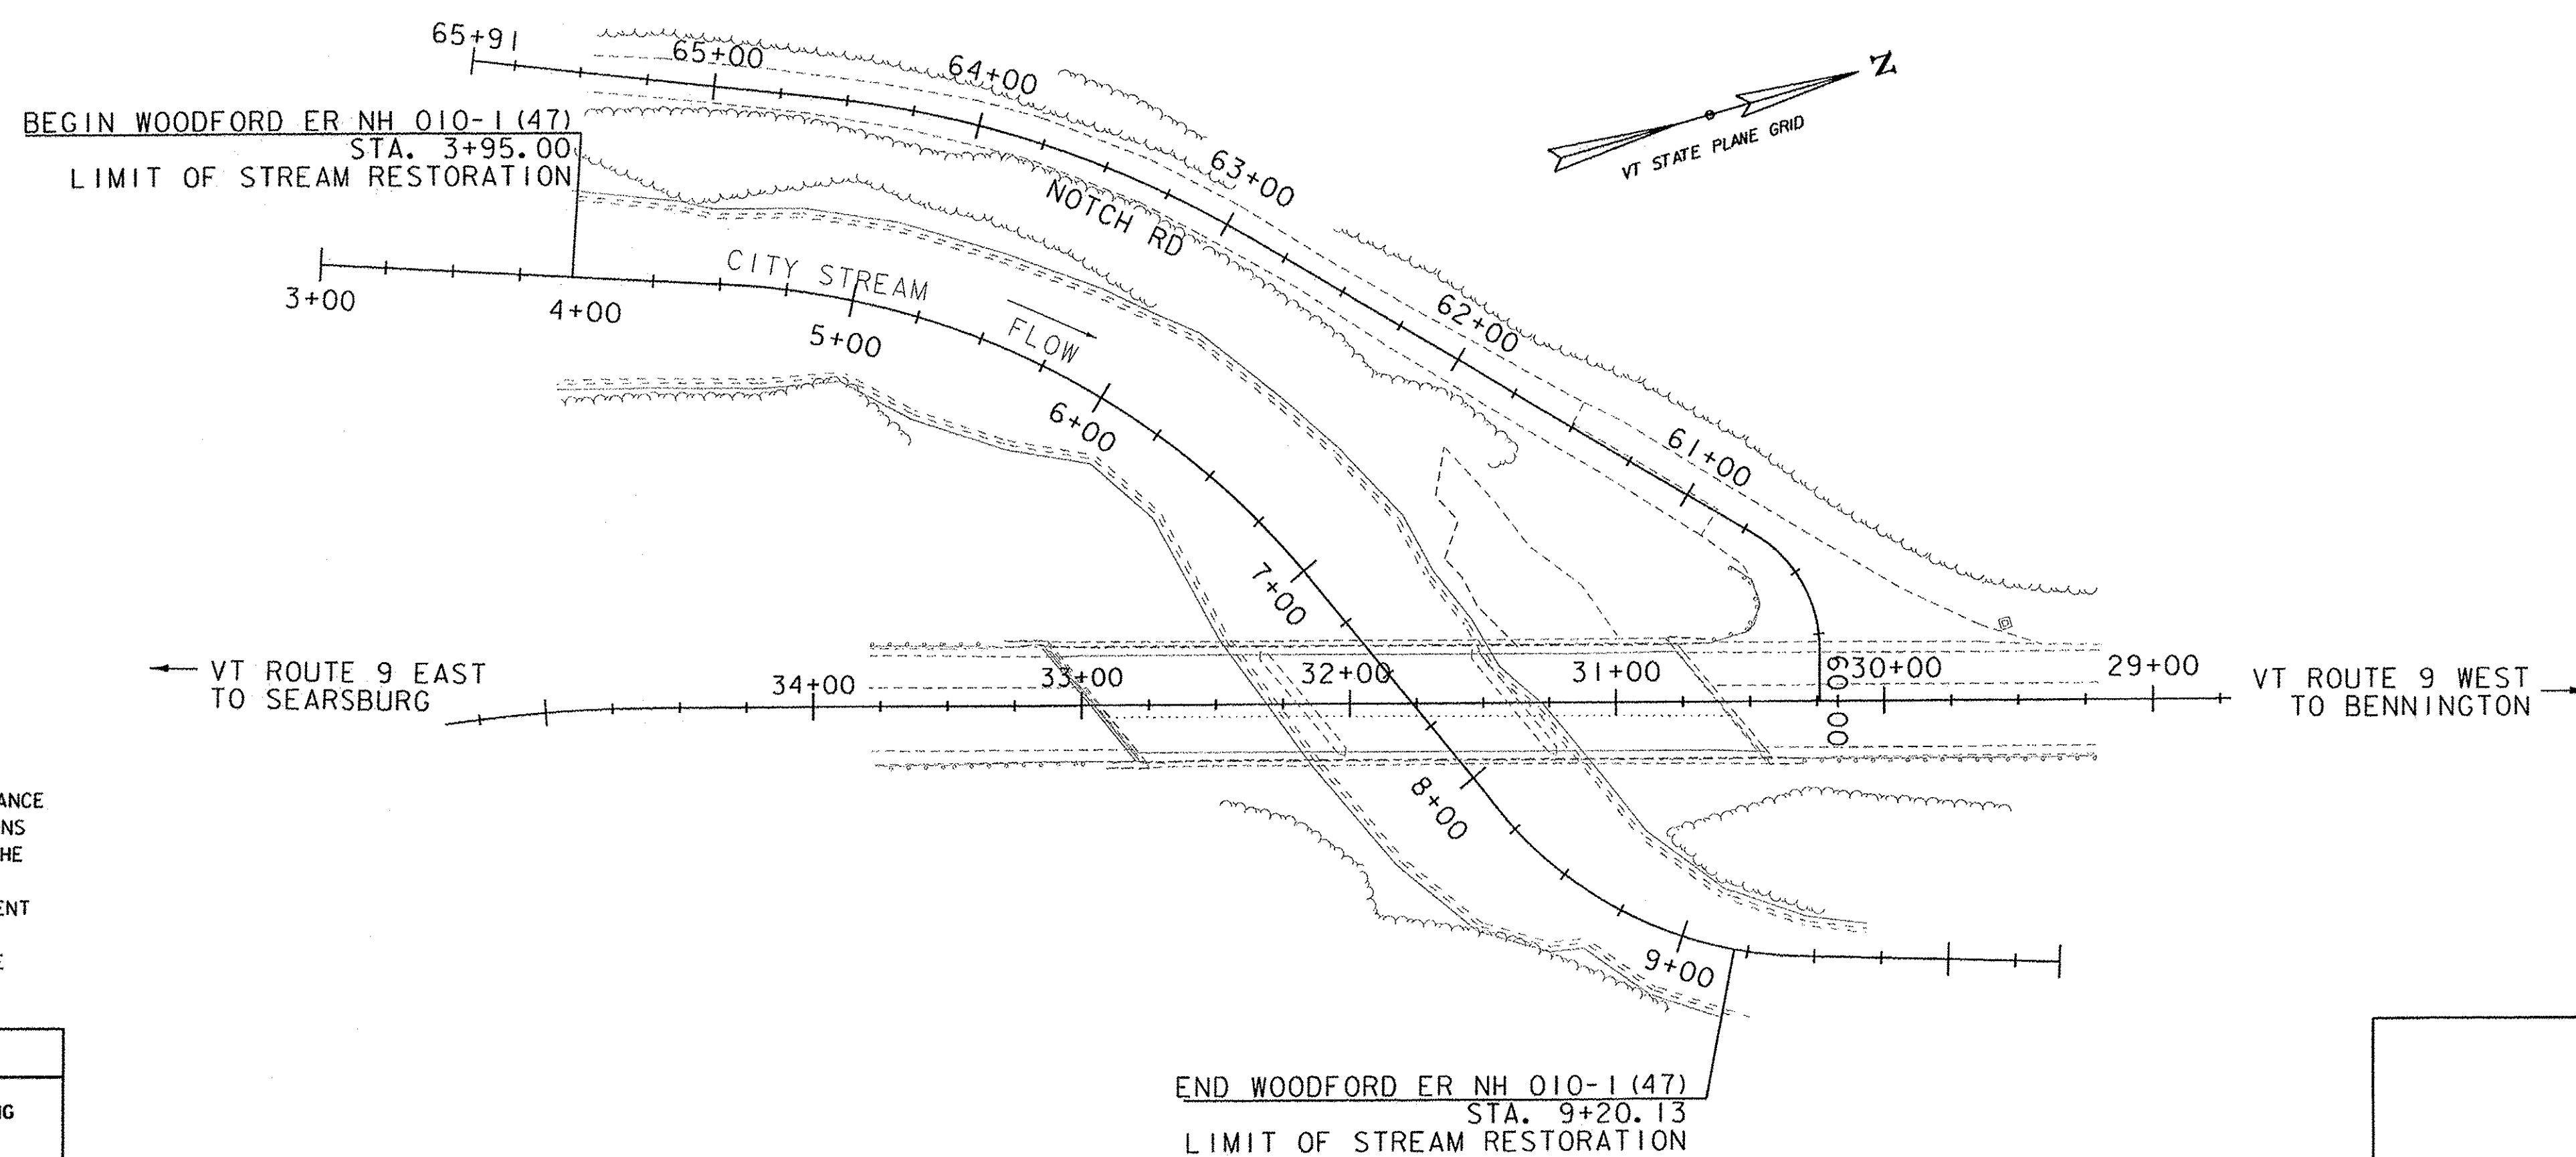

CONSTRUCTION IS TO BE CARRIED ON IN ACCORDANCE WITH THESE PLANS AND THE STANDARD SPECIFICATIONS FOR CONSTRUCTION DATED 2011, AS APPROVED BY THE FEDERAL HIGHWAY ADMINISTRATION ON JULY 20, 2011 FOR USE ON THIS PROJECT, INCLUDING ALL SUBSEQUENT REVISIONS AND SUCH REVISED SPECIFICATIONS AND SPECIAL PROVISIONS AS ARE INCORPORATED IN THESE PLANS.

QUALITY ASSURANCE PROGRAM : LEVEL I	
SURVEYED BY : VERMONT SURVEY & ENGINEERING	
SURVEYED DATE : 12/20/2012 & 4/26/2013	
DATUM	
VERTICAL	NAVD 88 FT
HORIZONTAL	NAD 83 (2011) sFT

END WOODFORD ER NH 010-1 (47)  
STA. 9+20.13  
LIMIT OF STREAM RESTORATION

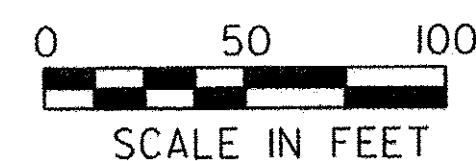

GREEN INTERNATIONAL AFFILIATES, INC.  
CIVIL AND STRUCTURAL ENGINEERS

DIRECTOR OF PROJECT DELIVERY	
APPROVED: <i>[Signature]</i>	DATE: 12/5/2014
PROJECT MANAGER : PAUL LIBBY	
PROJECT NAME : WOODFORD	
PROJECT NUMBER : ER NH 010-1 (47)	
SHEET 1 OF 35 SHEETS	