



**LOW FLOW CHANNEL DETAIL**  
NOT TO SCALE

**NOTES:**

- 1.) NATIVE RIVERBED MATERIAL SHALL BE EXISTING RIVER MATERIAL AND SHALL BE PLACED TO MIMIC THE NATURAL COBBLE RIVER BOTTOM AND ROUGHNESS THROUGHOUT THE PROJECT TO THE SATISFACTION OF THE ENGINEER.
- 2.) THE COST OF THIS MATERIAL SHALL BE INCIDENTAL TO ITEM 203.27 UNCLASSIFIED CHANNEL EXCAVATION.

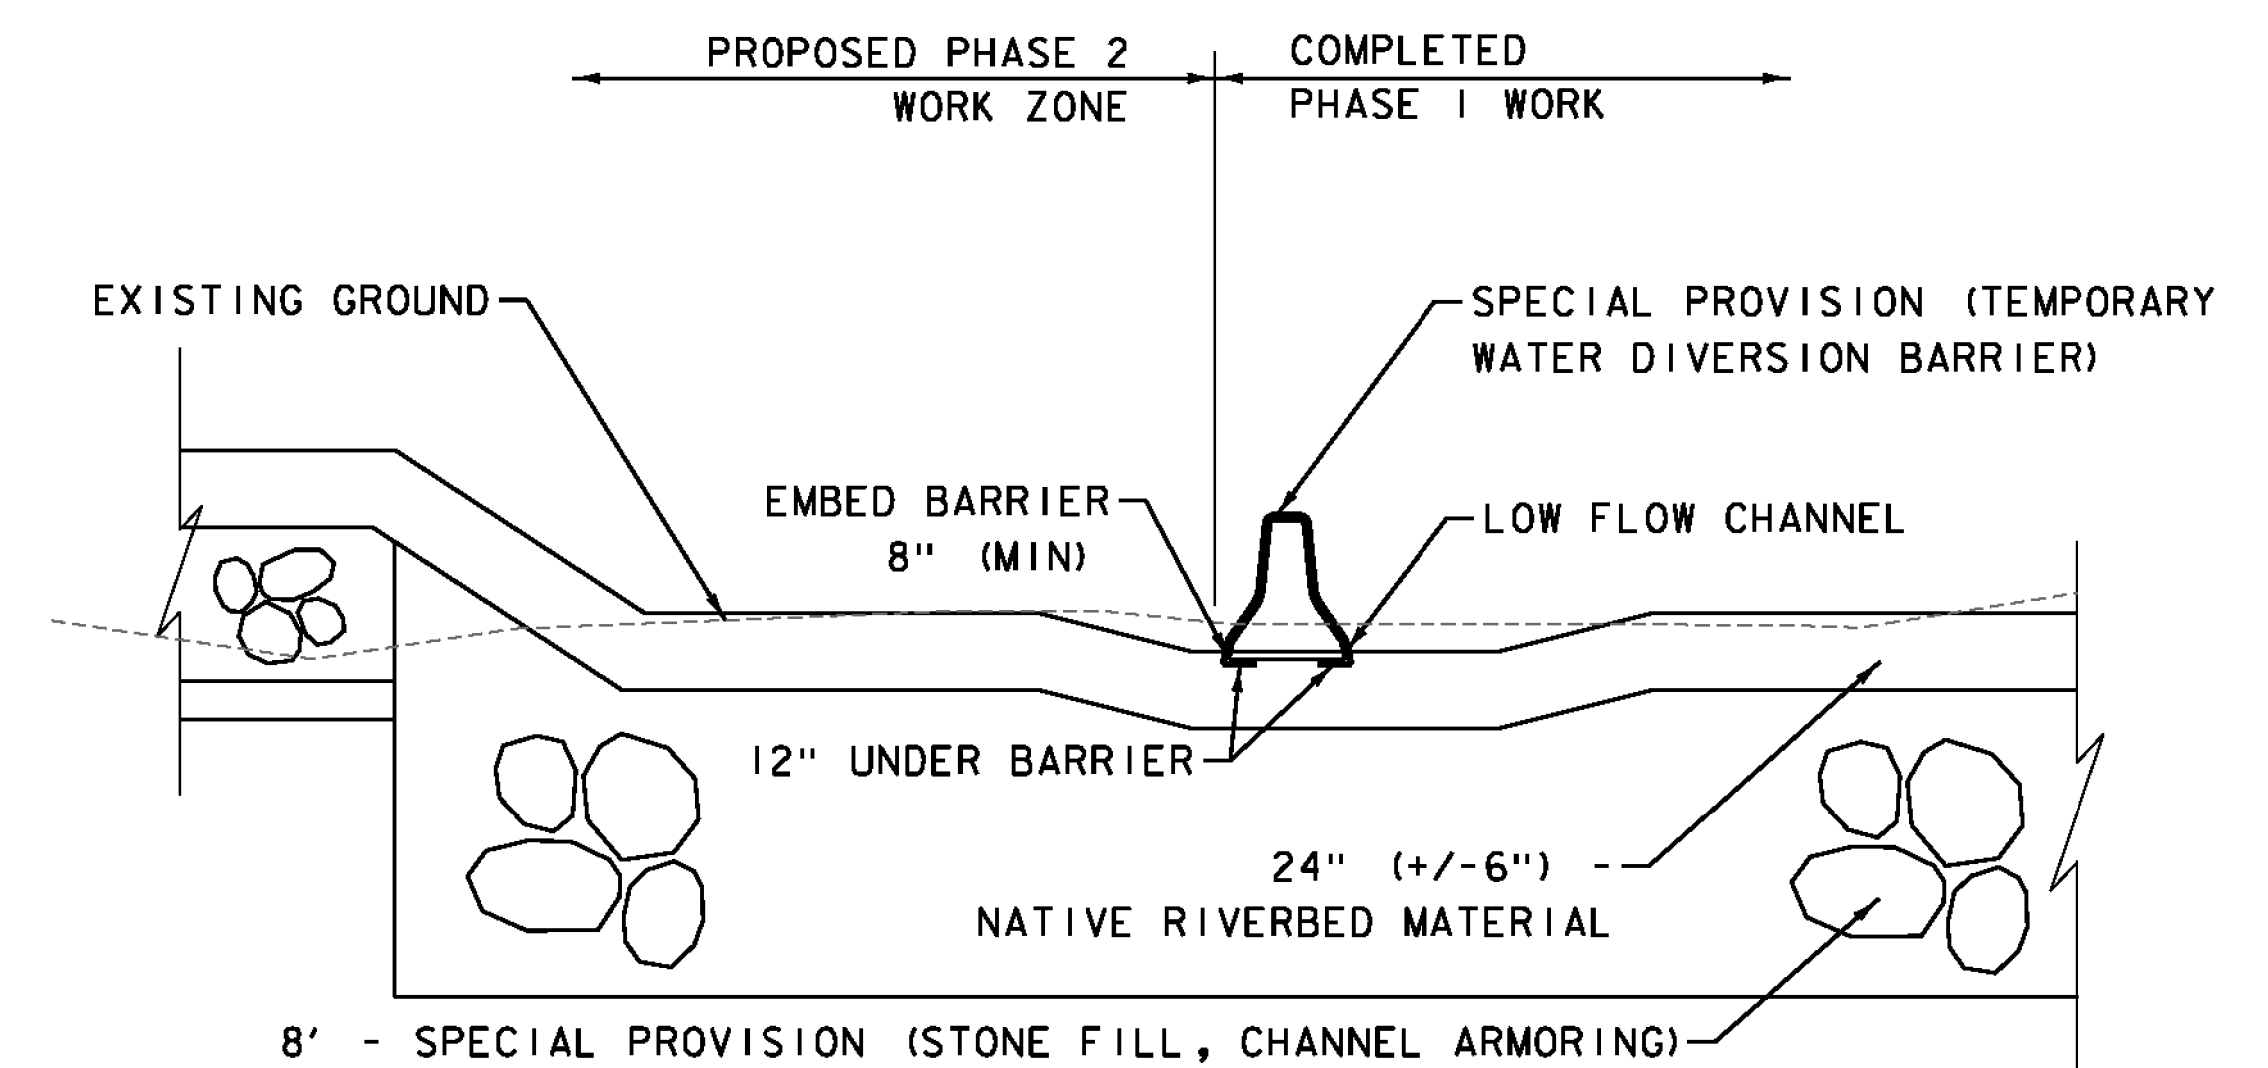


**PHASE 2**

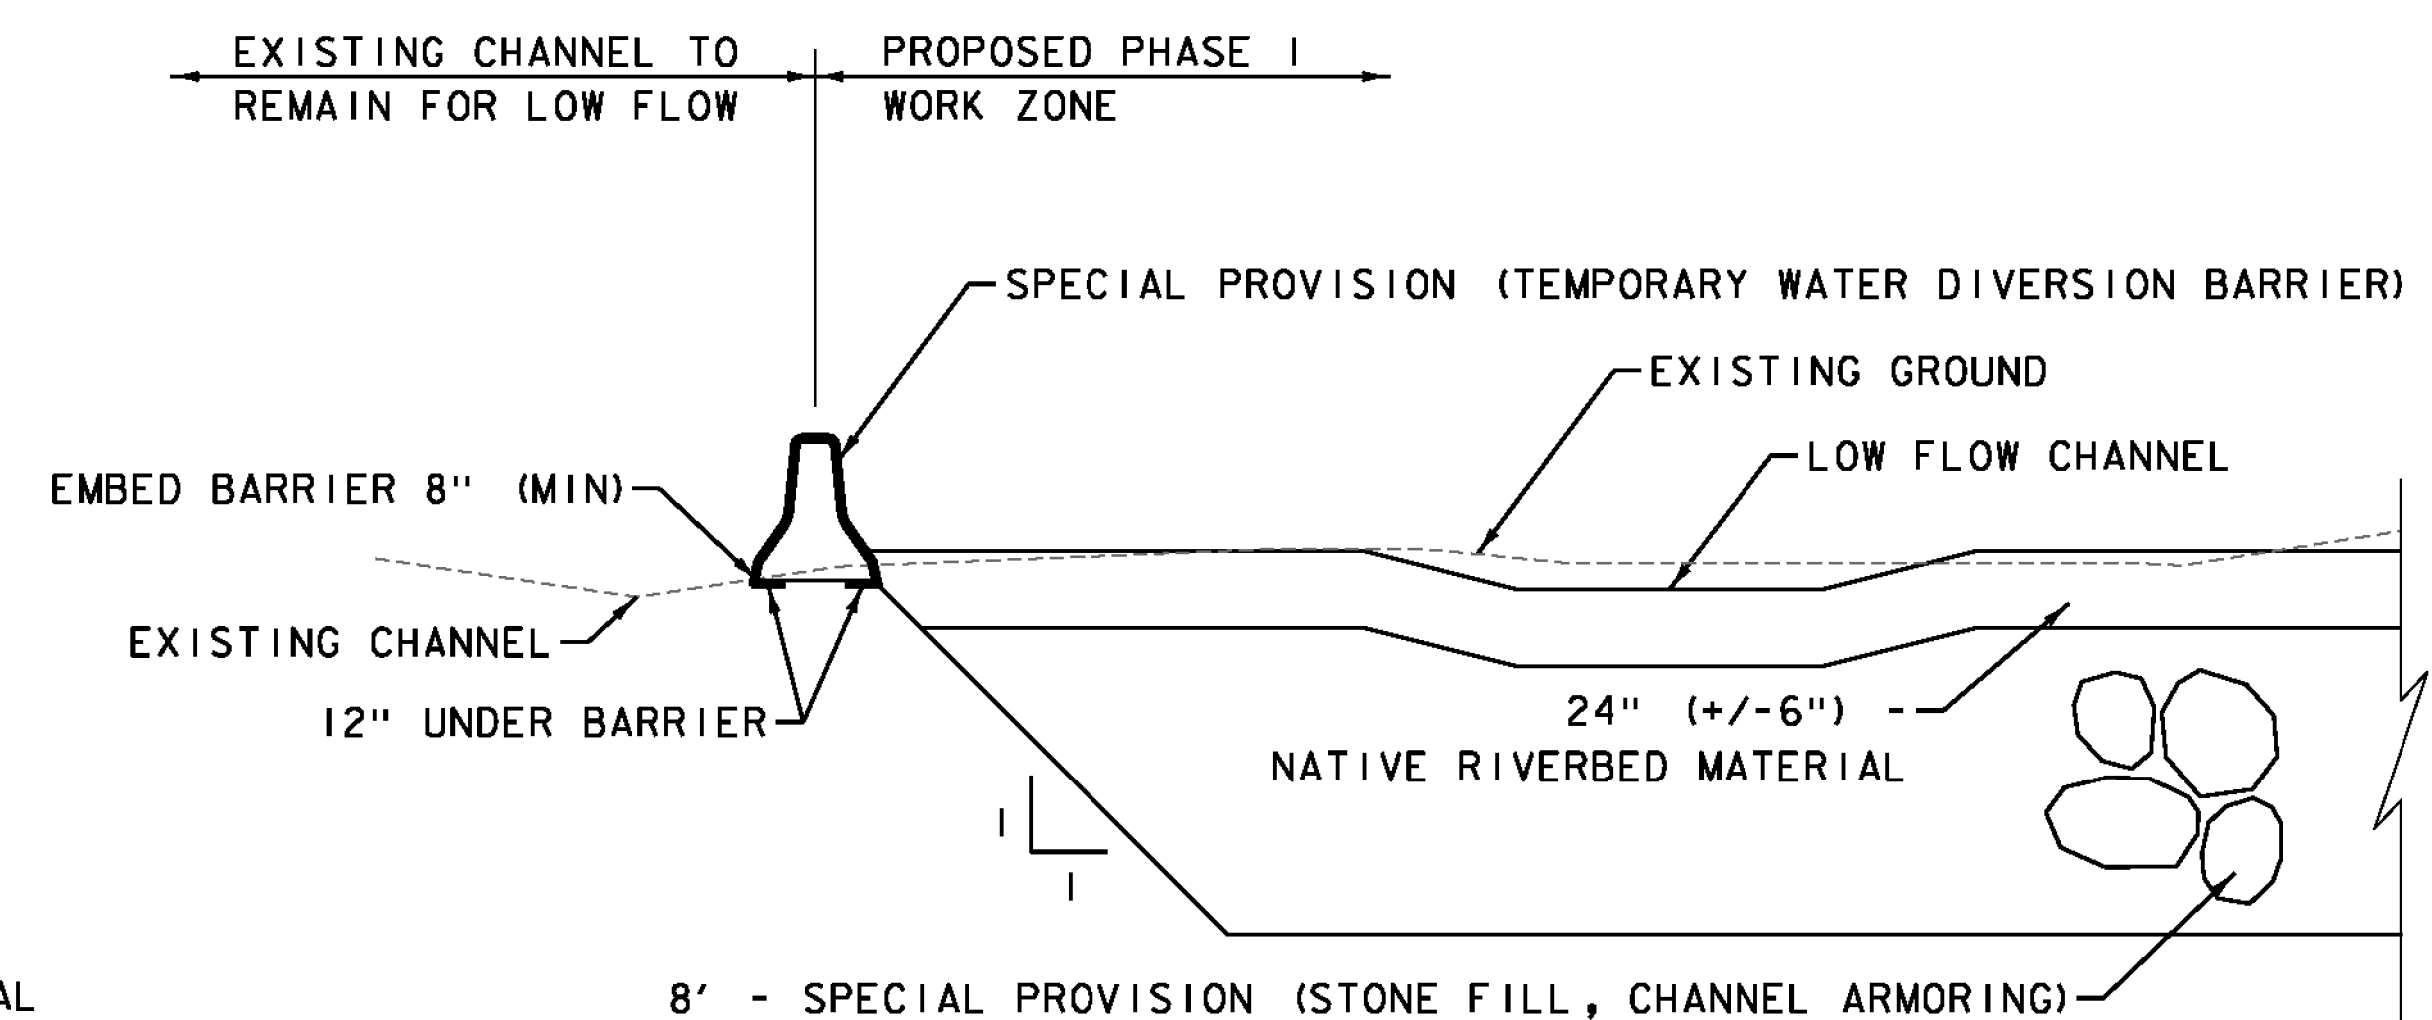

**PHASE 1**

**SPECIAL PROVISION (TEMPORARY WATER DIVERSION BARRIER) PLACEMENT DETAIL**  
NOT TO SCALE

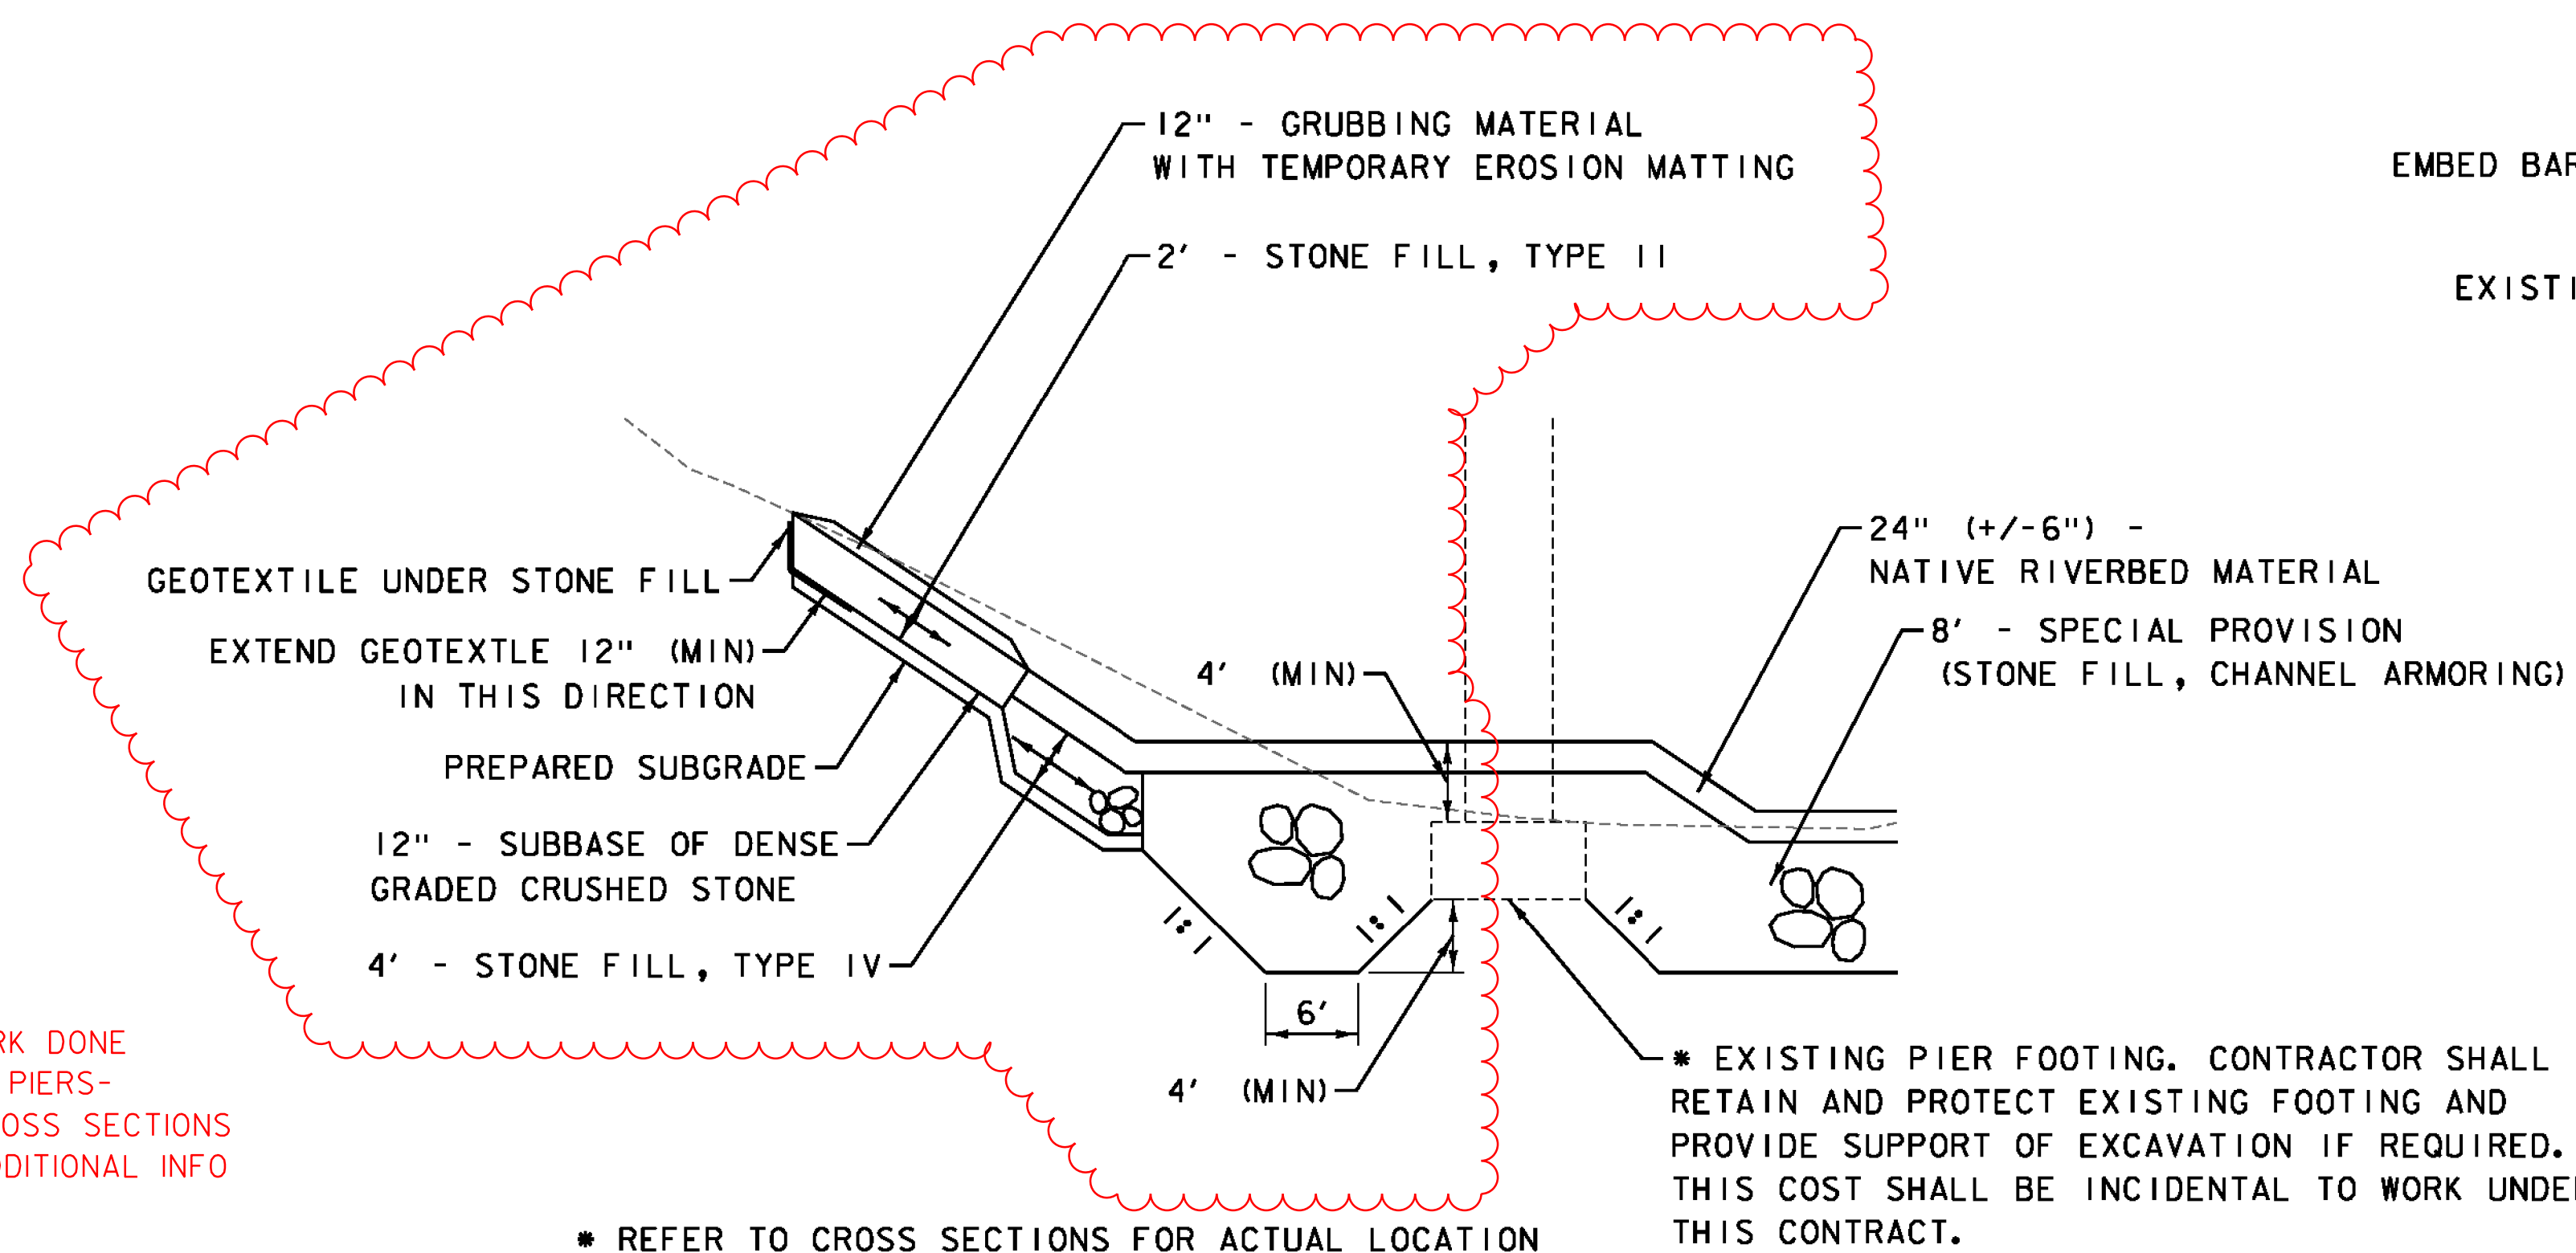

\* REFER TO CROSS SECTIONS FOR ACTUAL LOCATION

**TYPICAL STONE PLACEMENT AT PIERS DETAIL**  
PIER 1 SHOWN, PIER 2 SIMILAR  
NOT TO SCALE

NO WORK DONE  
BEHIND PIERS-  
SEE CROSS SECTIONS  
FOR ADDITIONAL INFO

\* EXISTING PIER FOOTING. CONTRACTOR SHALL  
RETAIN AND PROTECT EXISTING FOOTING AND  
PROVIDE SUPPORT OF EXCAVATION IF REQUIRED.  
THIS COST SHALL BE INCIDENTAL TO WORK UNDER  
THIS CONTRACT.

PROJECT NAME: WOODFORD  
PROJECT NUMBER: ER NH 010-1(47)

FILE NAME: z12b402de+.dgn  
PROJECT LEADER: E. ATKINS  
DESIGNED BY: M. BRADLEY  
TYPICAL DETAILS SHEET

PLOT DATE: 12/03/2014  
DRAWN BY: C. MORIN  
CHECKED BY: E. ATKINS  
SHEET 5 OF 35