

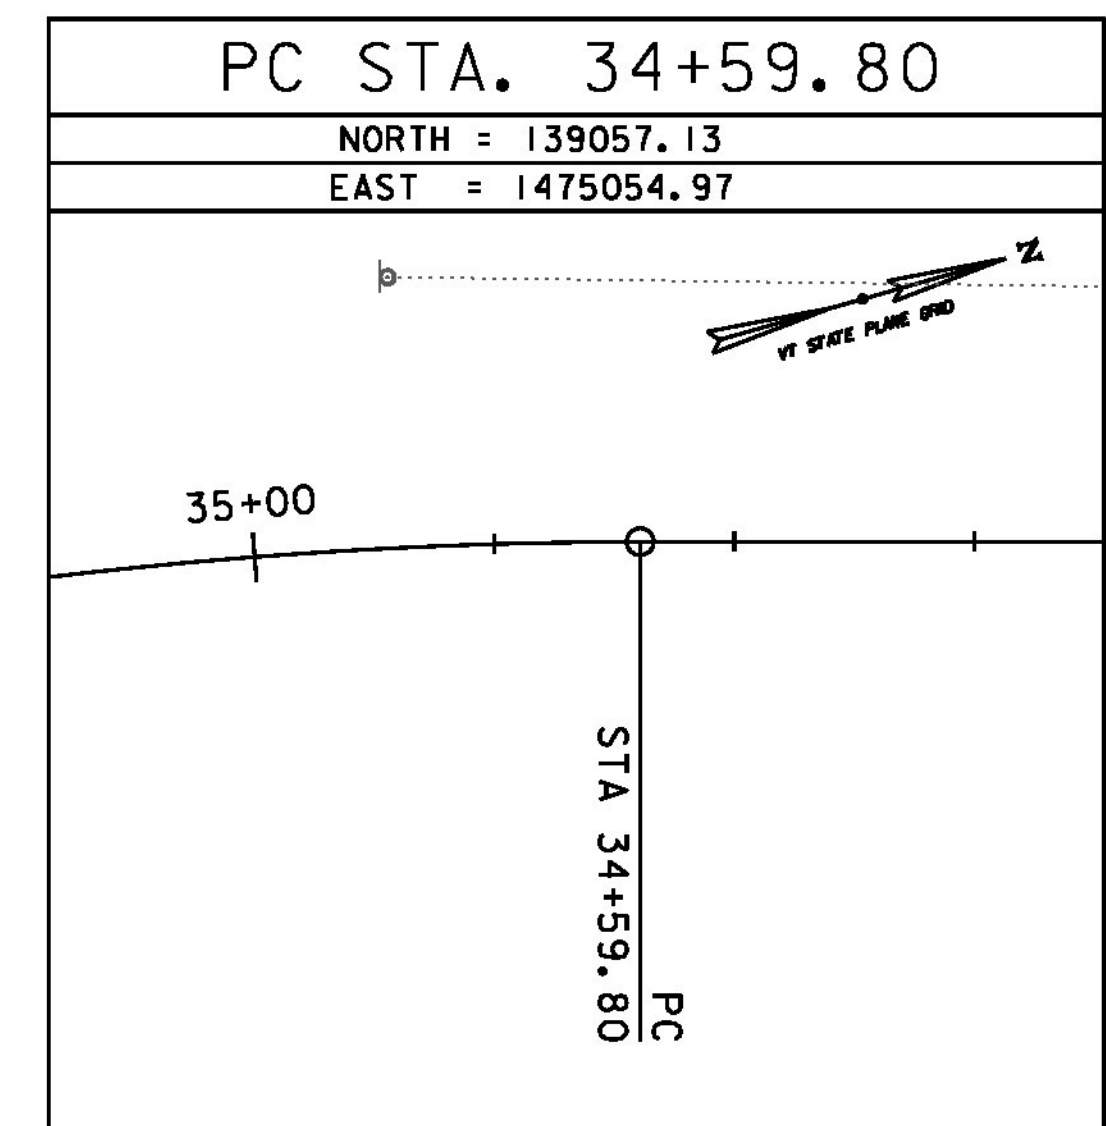
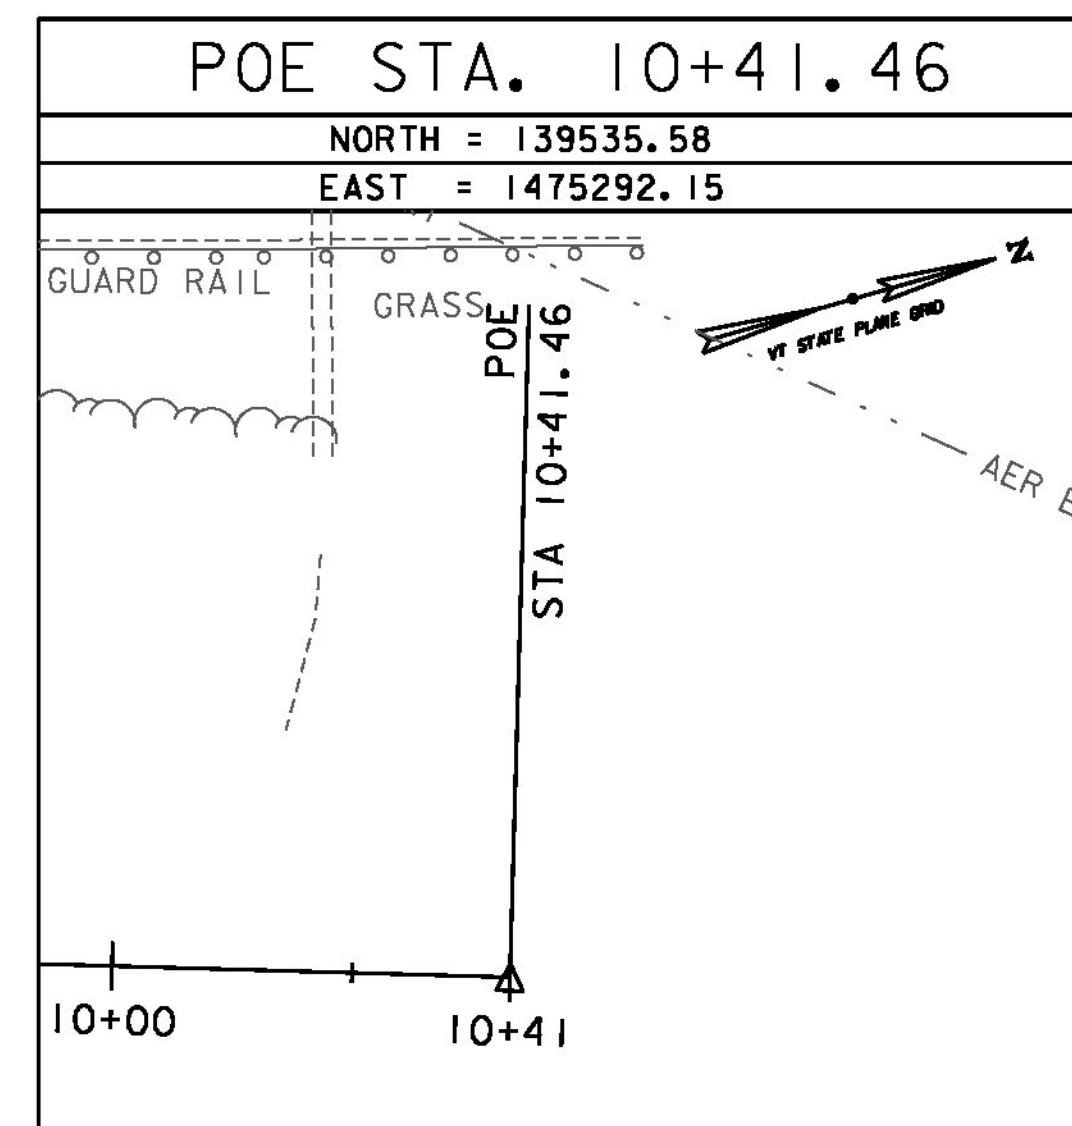
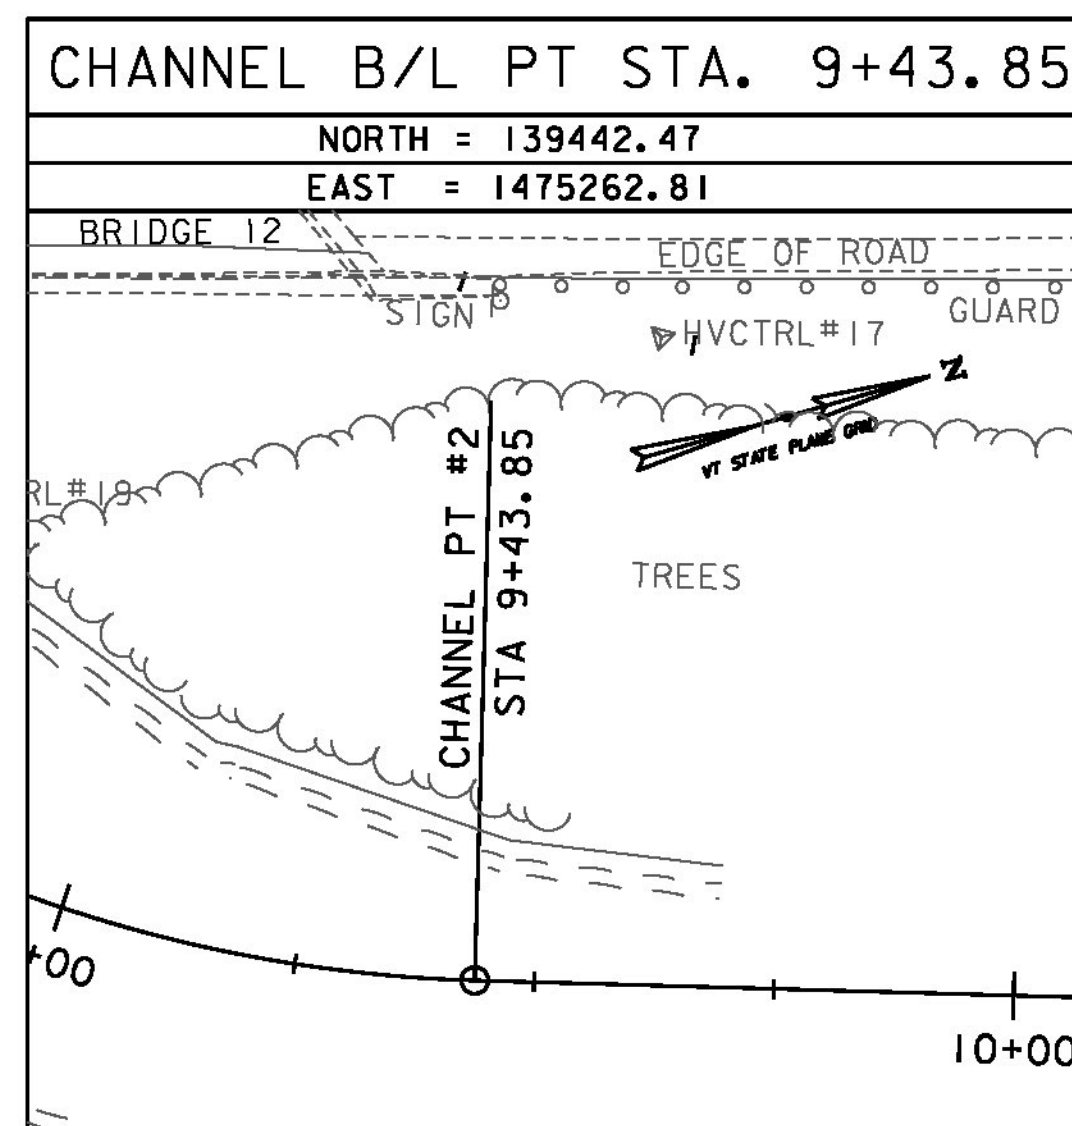
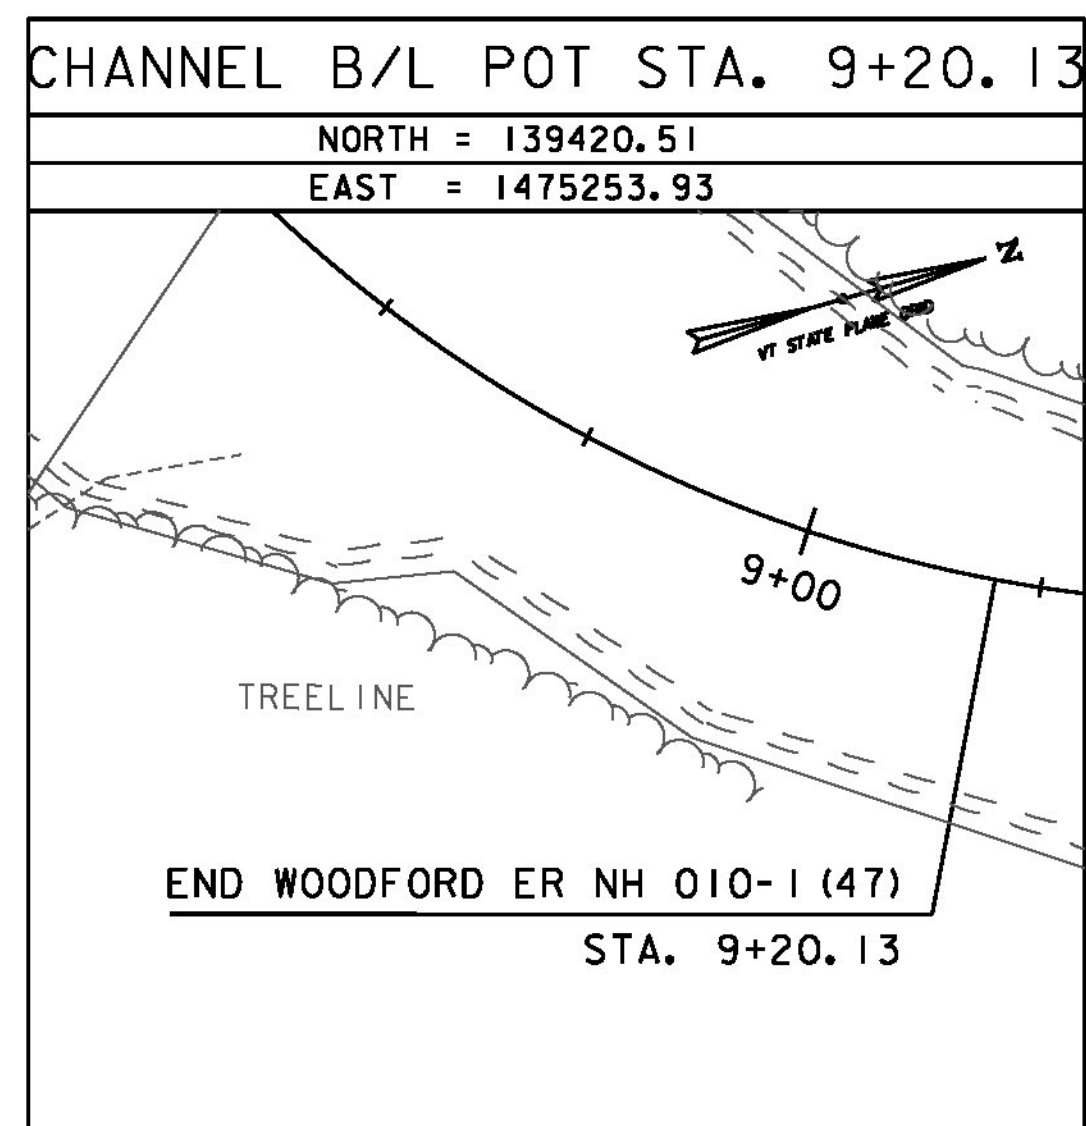
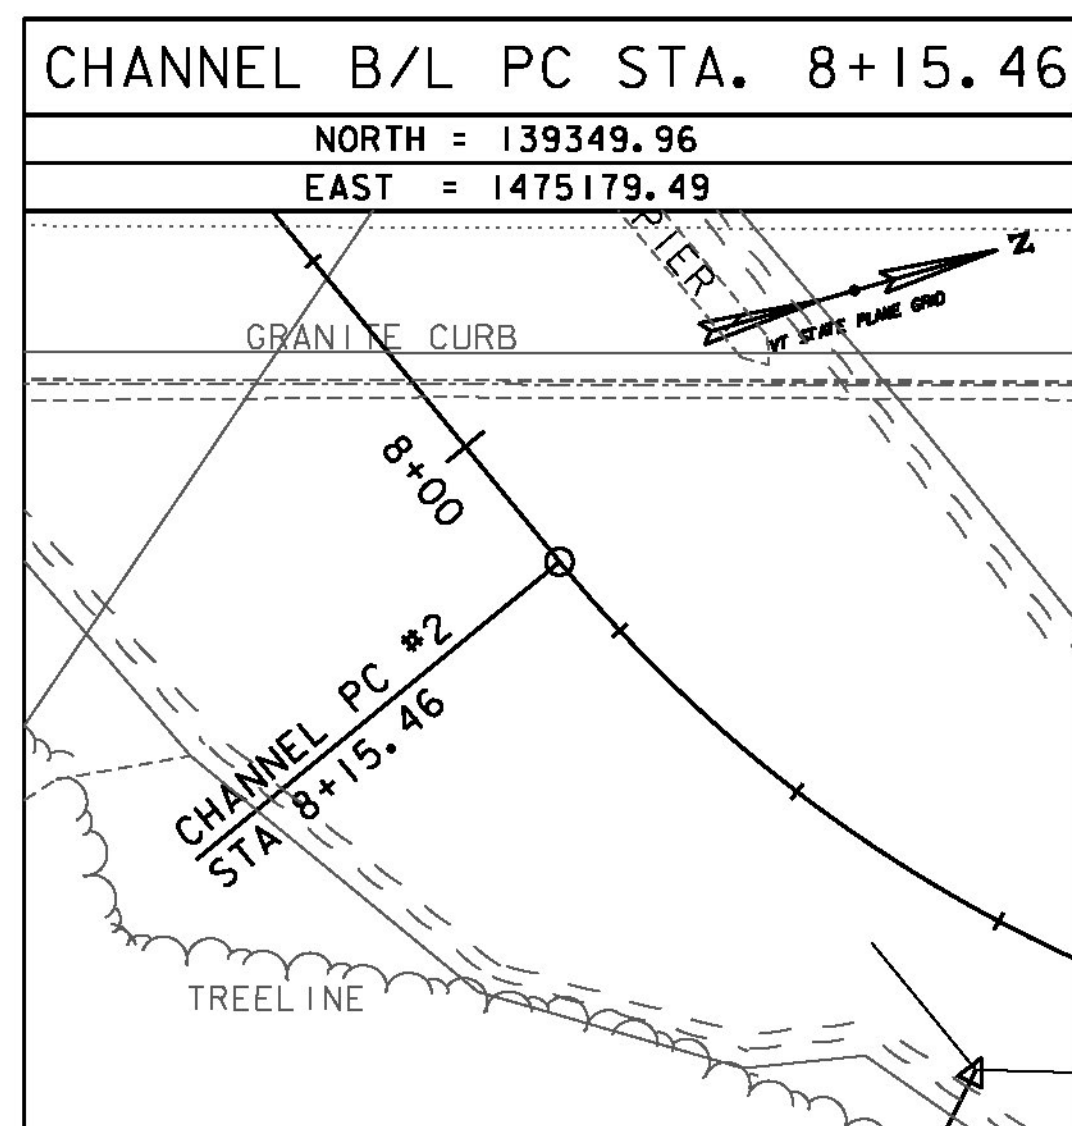
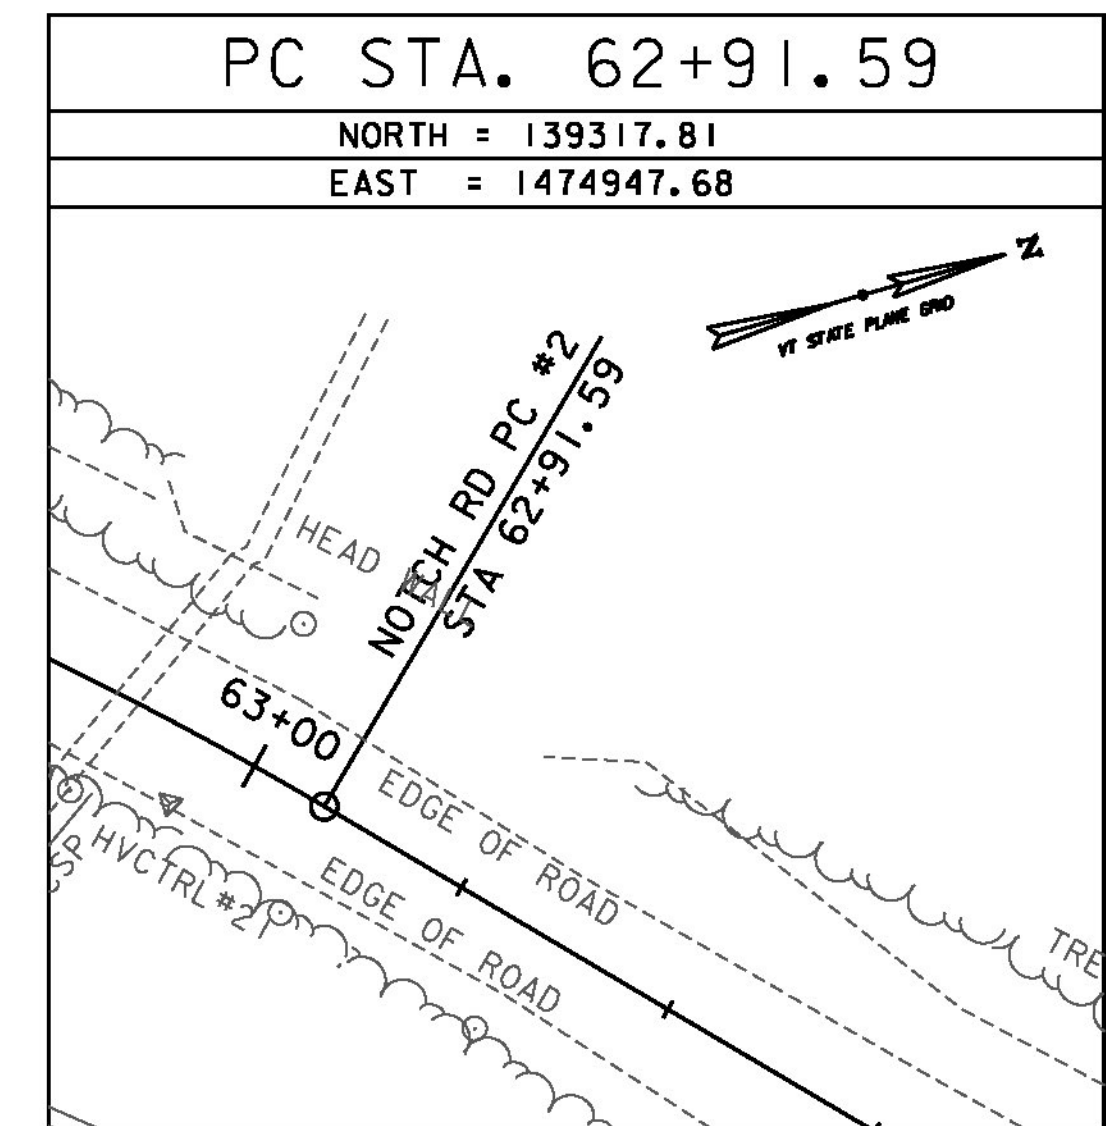
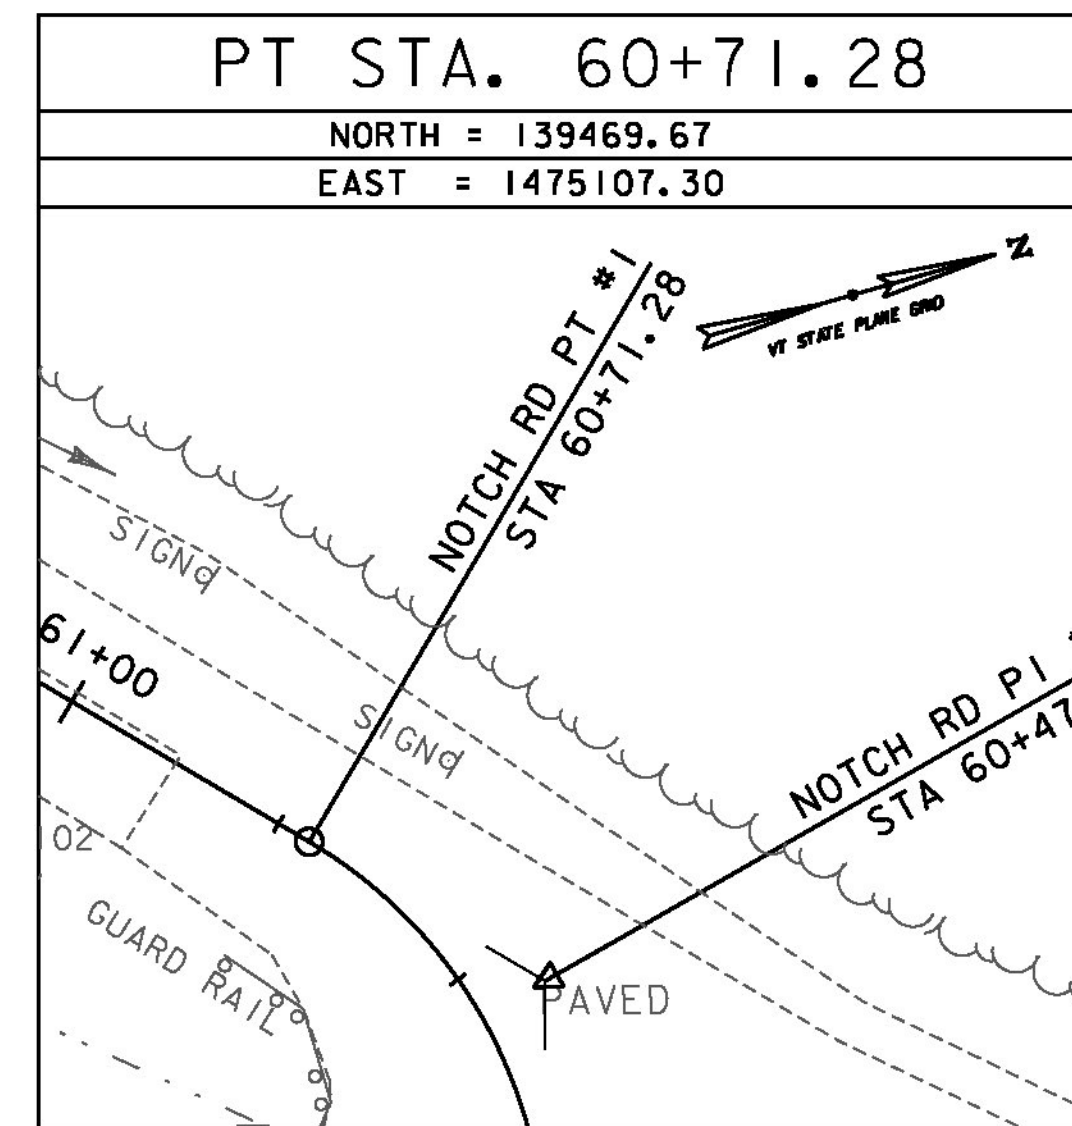
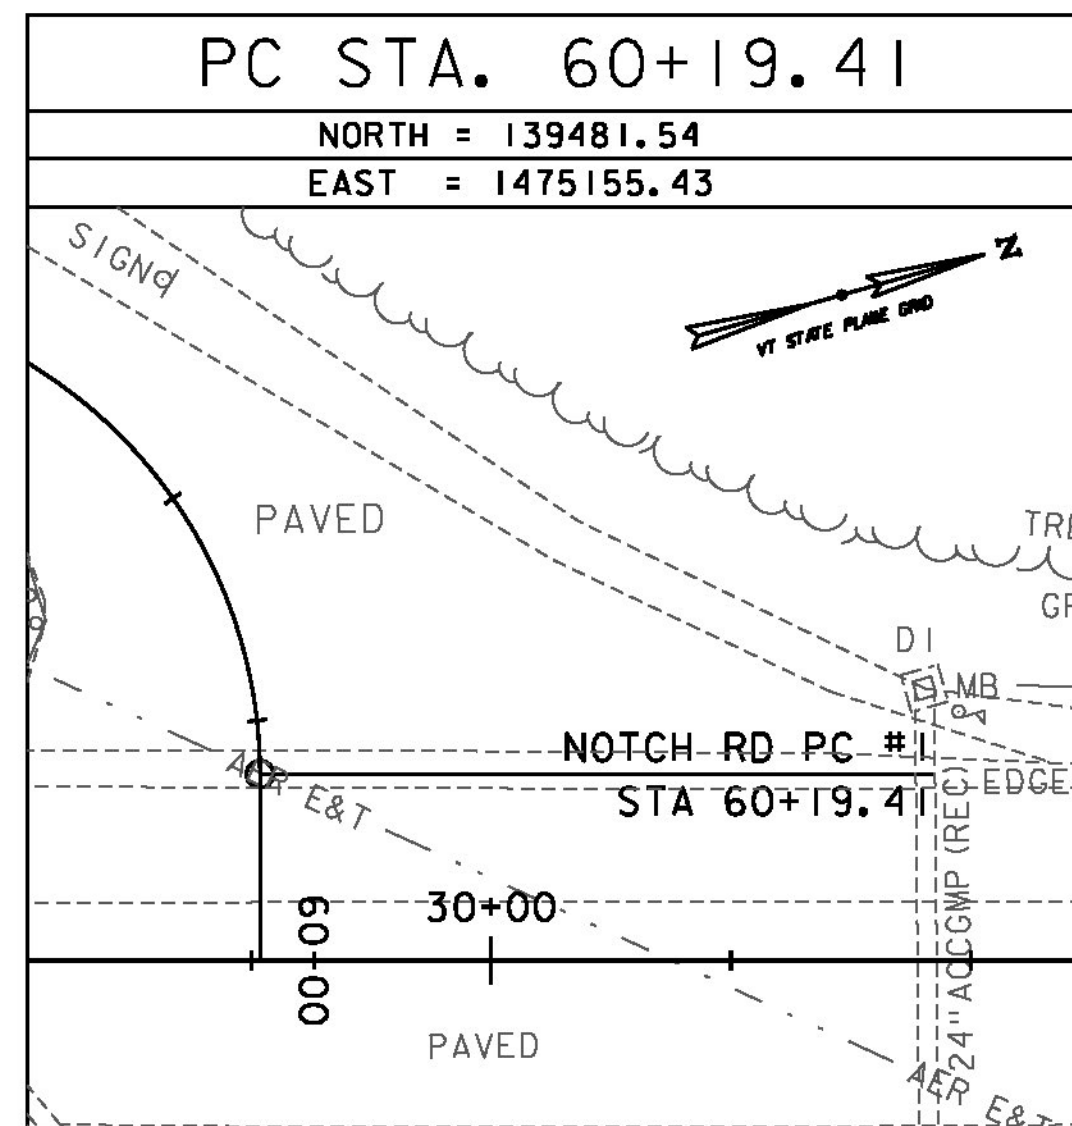






ALIGNMENT TIES

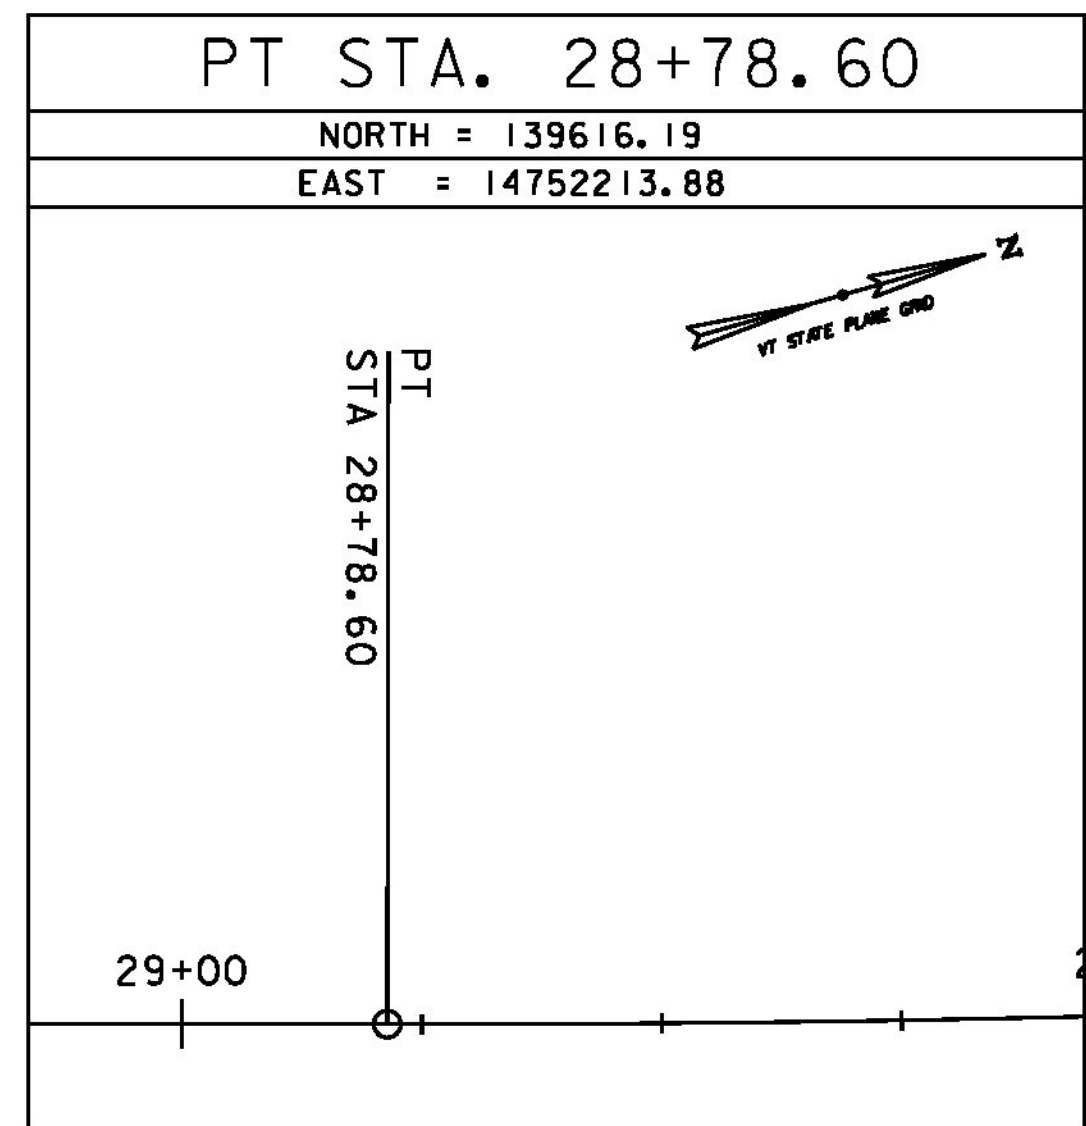

ALIGNMENT TIES

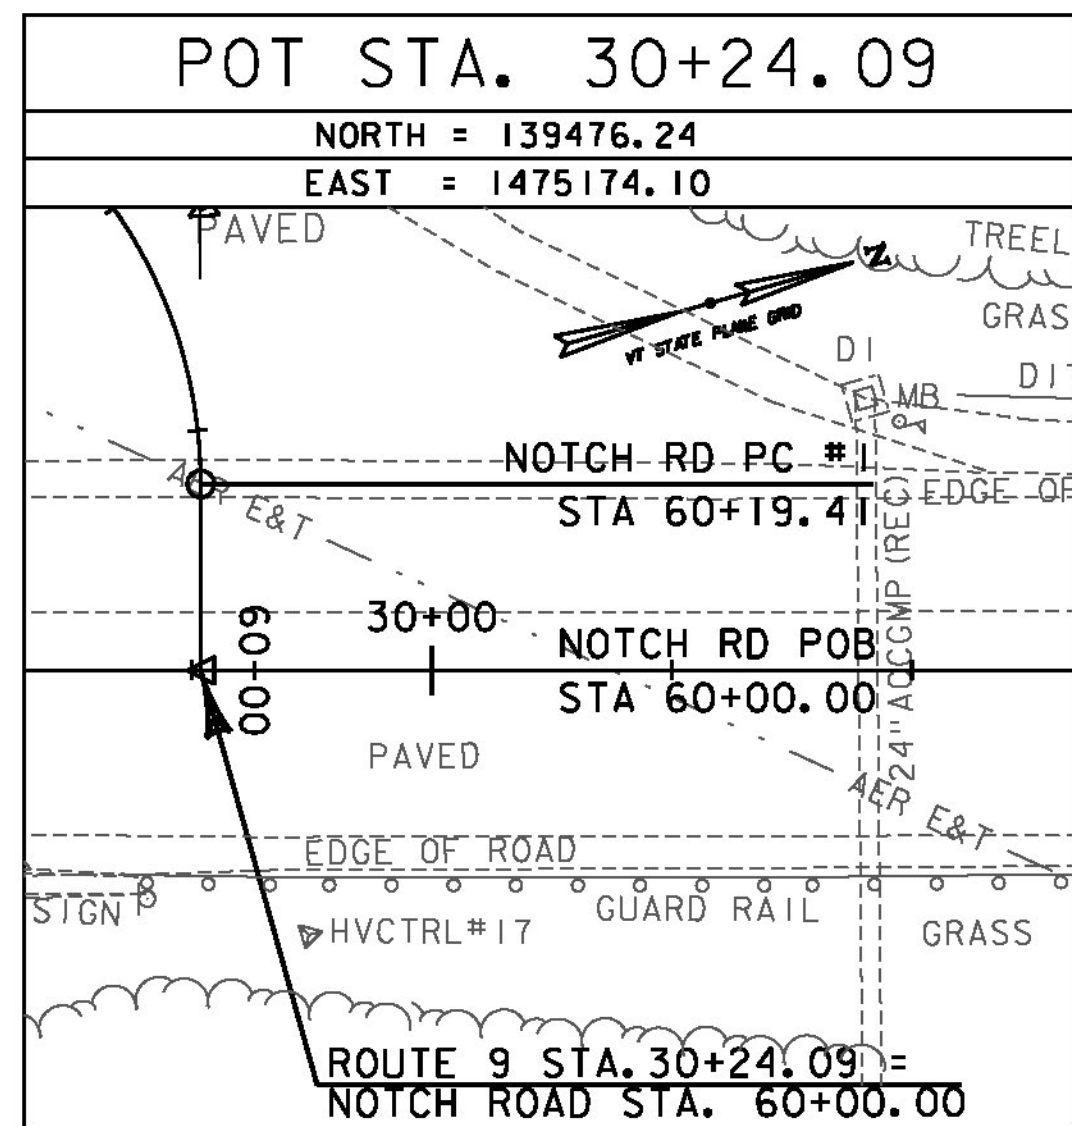

  ALIGNMENT TIES

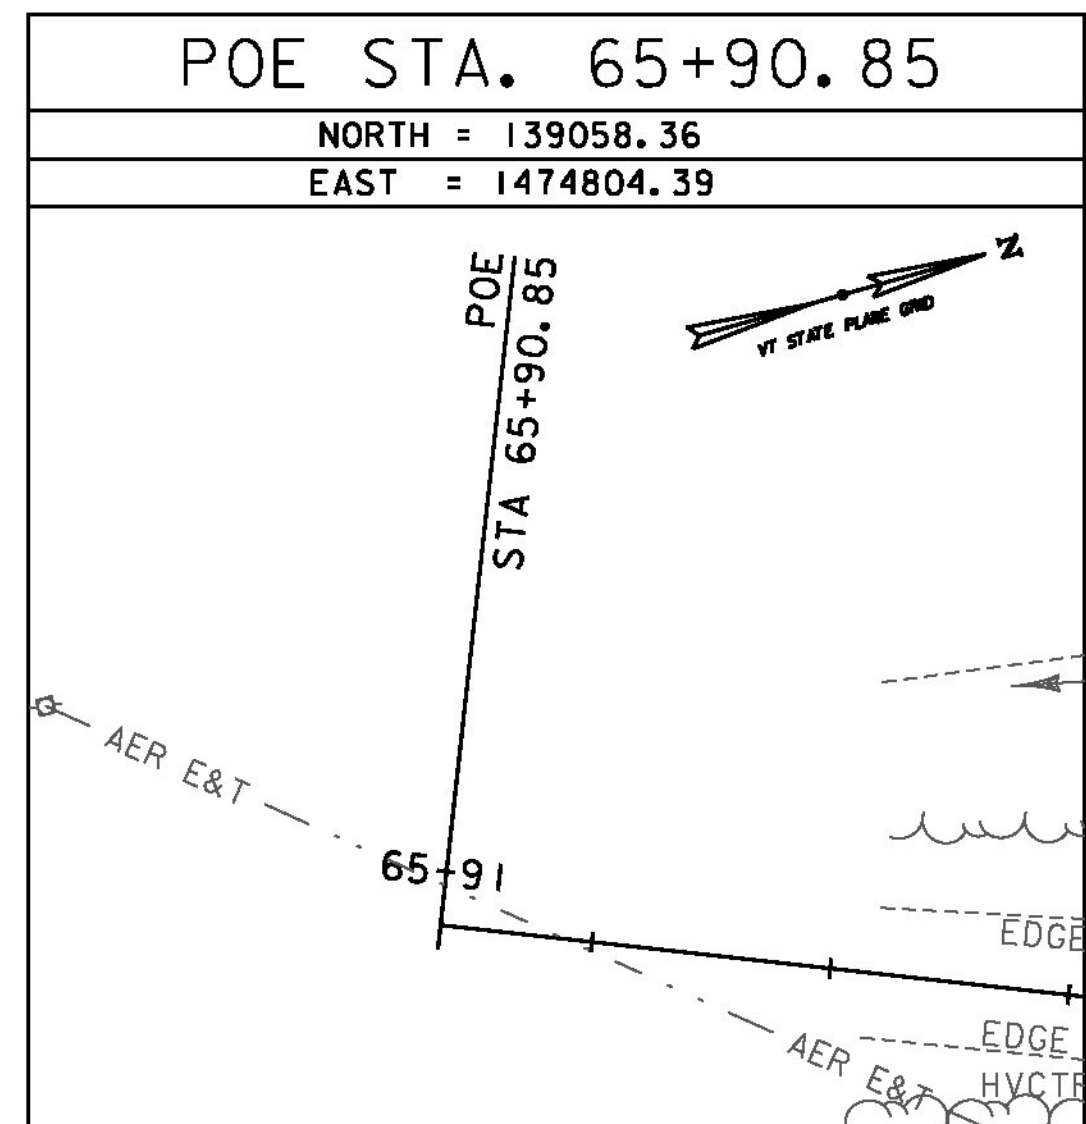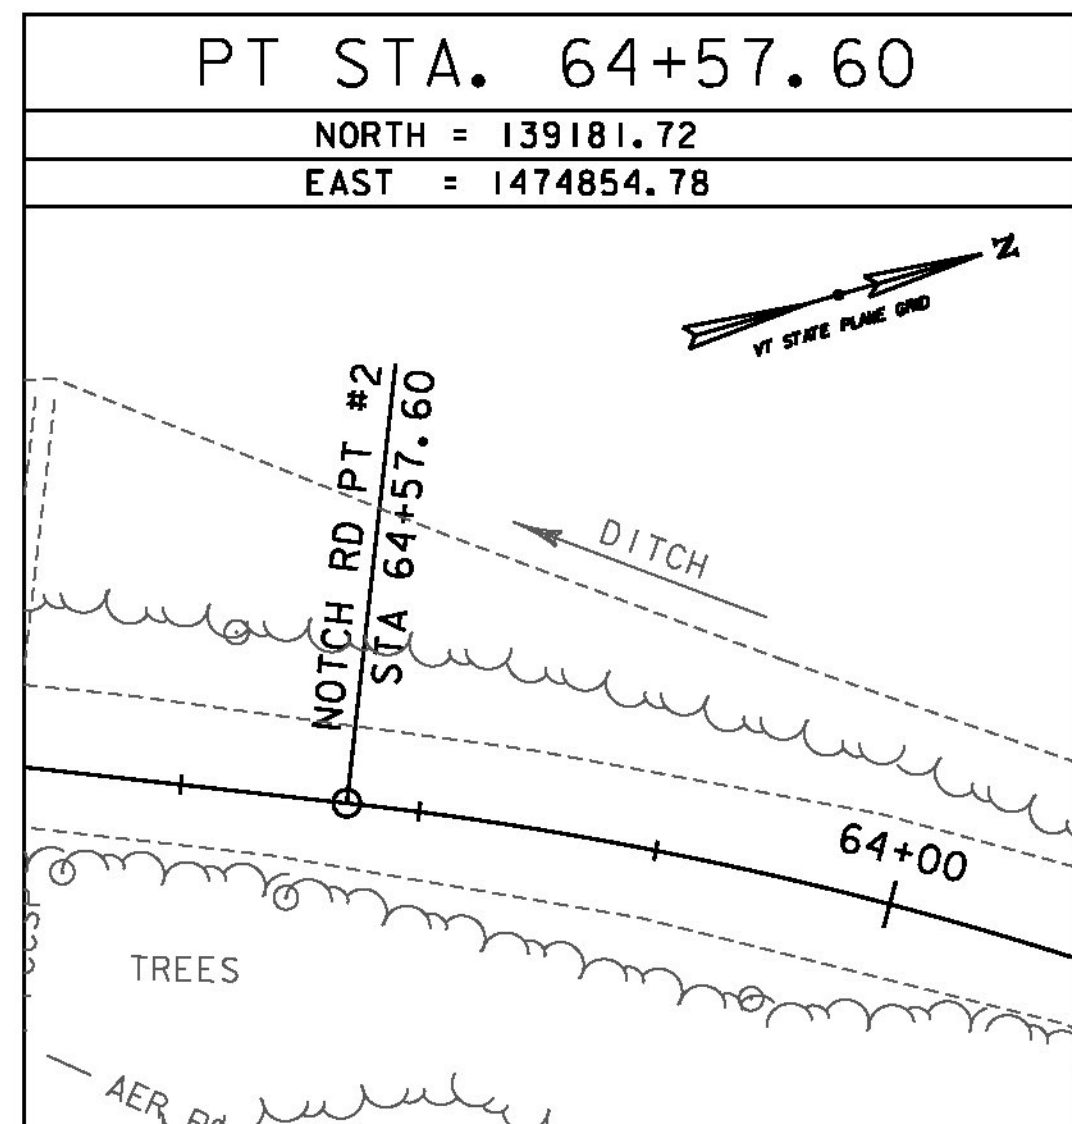

DATUM	
VERTICAL	NAVD 88 FT
HORIZONTAL	NAD 83(2011) sFT
ADJUSTMENT	NONE

PROJECT NAME:	WOODFORD
PROJECT NUMBER:	ER NH 010-1(47)
FILE NAME:	z12b402+1e.dgn
PROJECT LEADER:	E. ATKINS
DESIGNED BY:	M. BRADLEY
TIE SHEET 2	
PLOT DATE:	12/03/2014
DRAWN BY:	C. MORIN
CHECKED BY:	E. ATKINS
SHEET	7 OF 35

