

22 IF  
903C

SEED  
4+50 LT - 6+00 LT  
6+53 LT - 8+50 LT

HAY MULCH  
4+50 LT - 6+00 LT  
6+53 LT - 8+50 LT

SEED, WINTER RYE  
4+50 LT - 6+00 LT  
6+53 LT - 8+50 LT

TOP SOIL  
4+50 LT - 6+00 LT



FERTILIZER  
4+50 LT - 6+00 LT  
6+53 LT - 8+50 LT

TEMPORARY EROSION MATTING  
4+45 LT - 9+20 LT

AGRICULTURAL LIMESTONE  
4+50 LT - 6+00 LT  
6+53 LT - 8+50 LT

TEMPORARY STONE CHECK DAM, TYPE I  
8+80 LT

SPECIAL PROVISION  
(TEMPORARY WATER DIVERSION BARRIER)  
4+30 LT - 9+00 LT

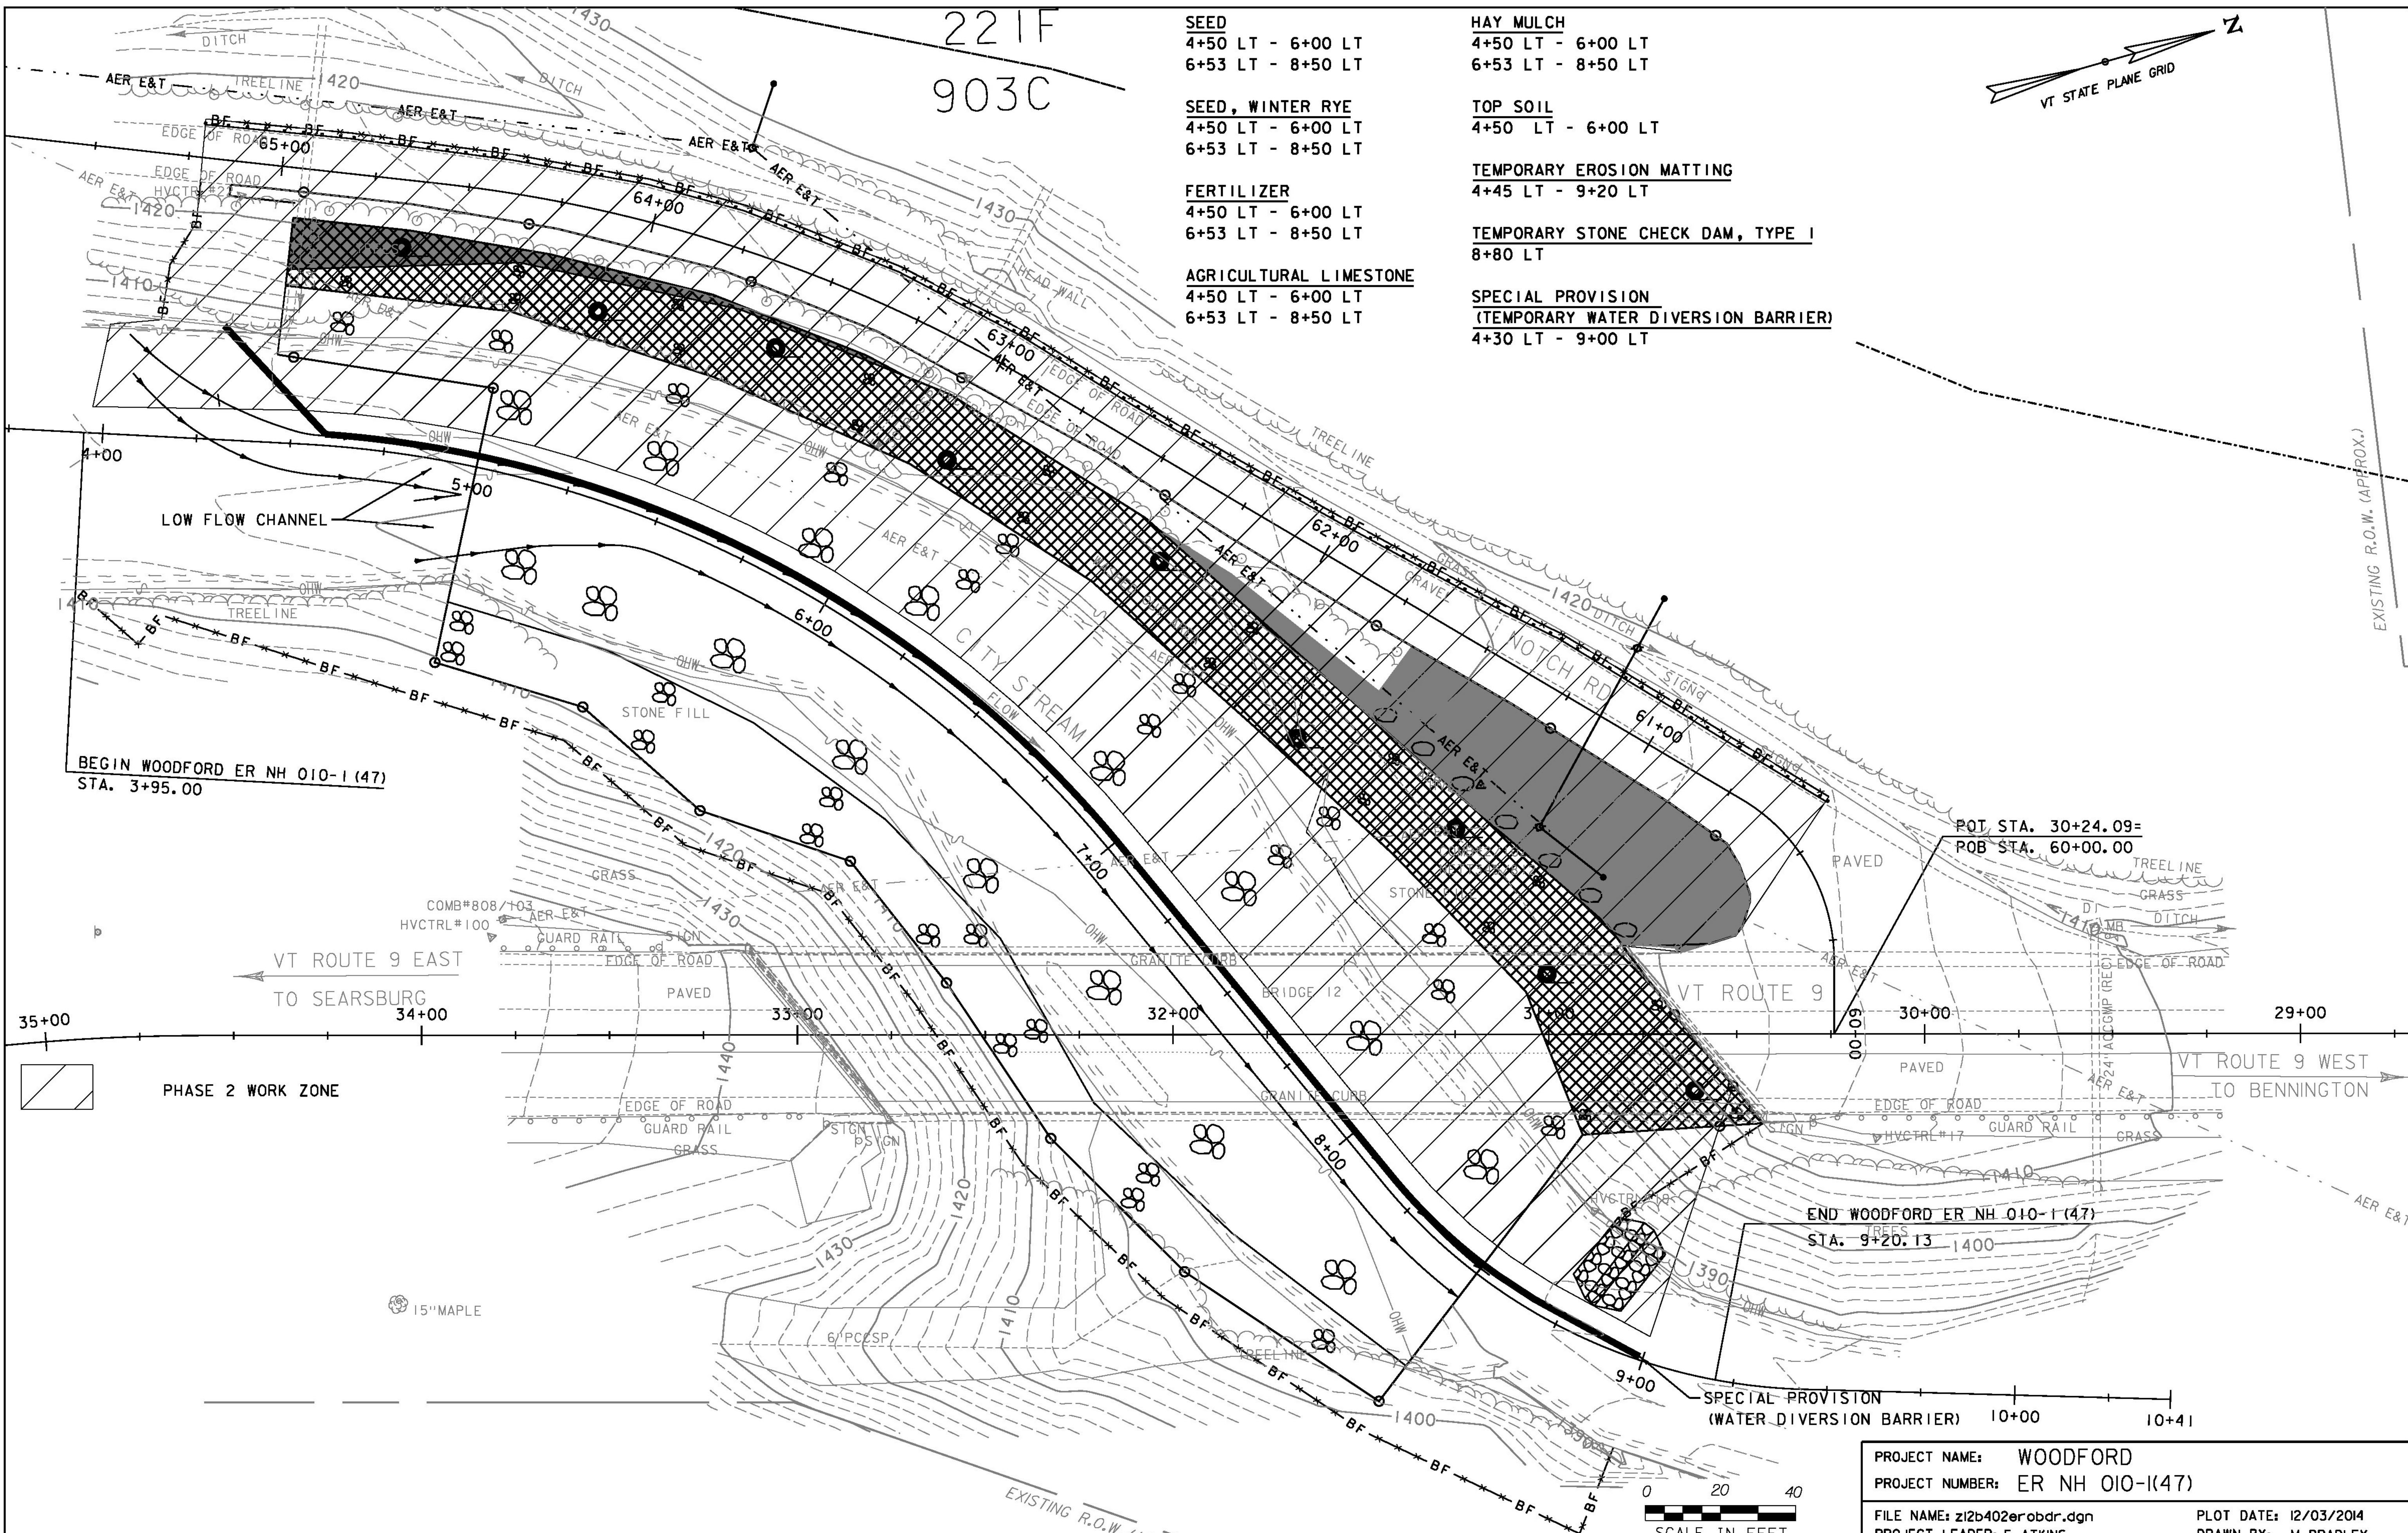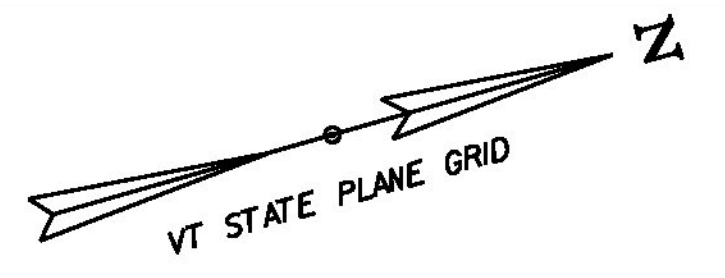


BEGIN WOODFORD ER NH 010-1 (47)  
STA. 3+95.00

POT. STA. 30+24.09=  
ROB. STA. 60+00.00

END WOODFORD ER NH 010-1 (47)  
STA. 9+20.13

PHASE 2 WORK ZONE

SPECIAL PROVISION  
(WATER DIVERSION BARRIER)

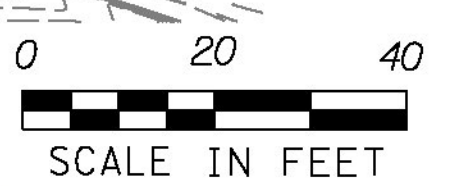

SCALE IN FEET  
GREEN INTERNATIONAL AFFILIATES, INC.  
CIVIL AND STRUCTURAL ENGINEERS

PROJECT NAME: WOODFORD  
PROJECT NUMBER: ER NH 010-1(47)  
FILE NAME: z12b402erobdr.dgn  
PLOT DATE: 12/03/2014  
PROJECT LEADER: E. ATKINS  
DRAWN BY: M. BRADLEY  
DESIGNED BY: M. BRADLEY  
CHECKED BY: E. ATKINS  
EPSC CONSTRUCTION PHASE 2 PLAN SHEET  
SHEET 20 OF 35

\*REFER TO NOTES ON EPSC CONSTRUCTION PHASE I SHEET