


4+46.10 24" PCCSP CULVERT  
 SKEWED 86° 17' 58.6" LT  
 BEGIN CHANNEL RESTORATION 4+45.60

BUILT ESSENTIALLY  
 AS SHOWN

NOTE: CROSS SECTION AND DETAILS AT STA 4+24 LT  
 ARE THE SAME AS STA 4+50 LT  
 FOR TYPE II AND TYPE IV STONE FILL

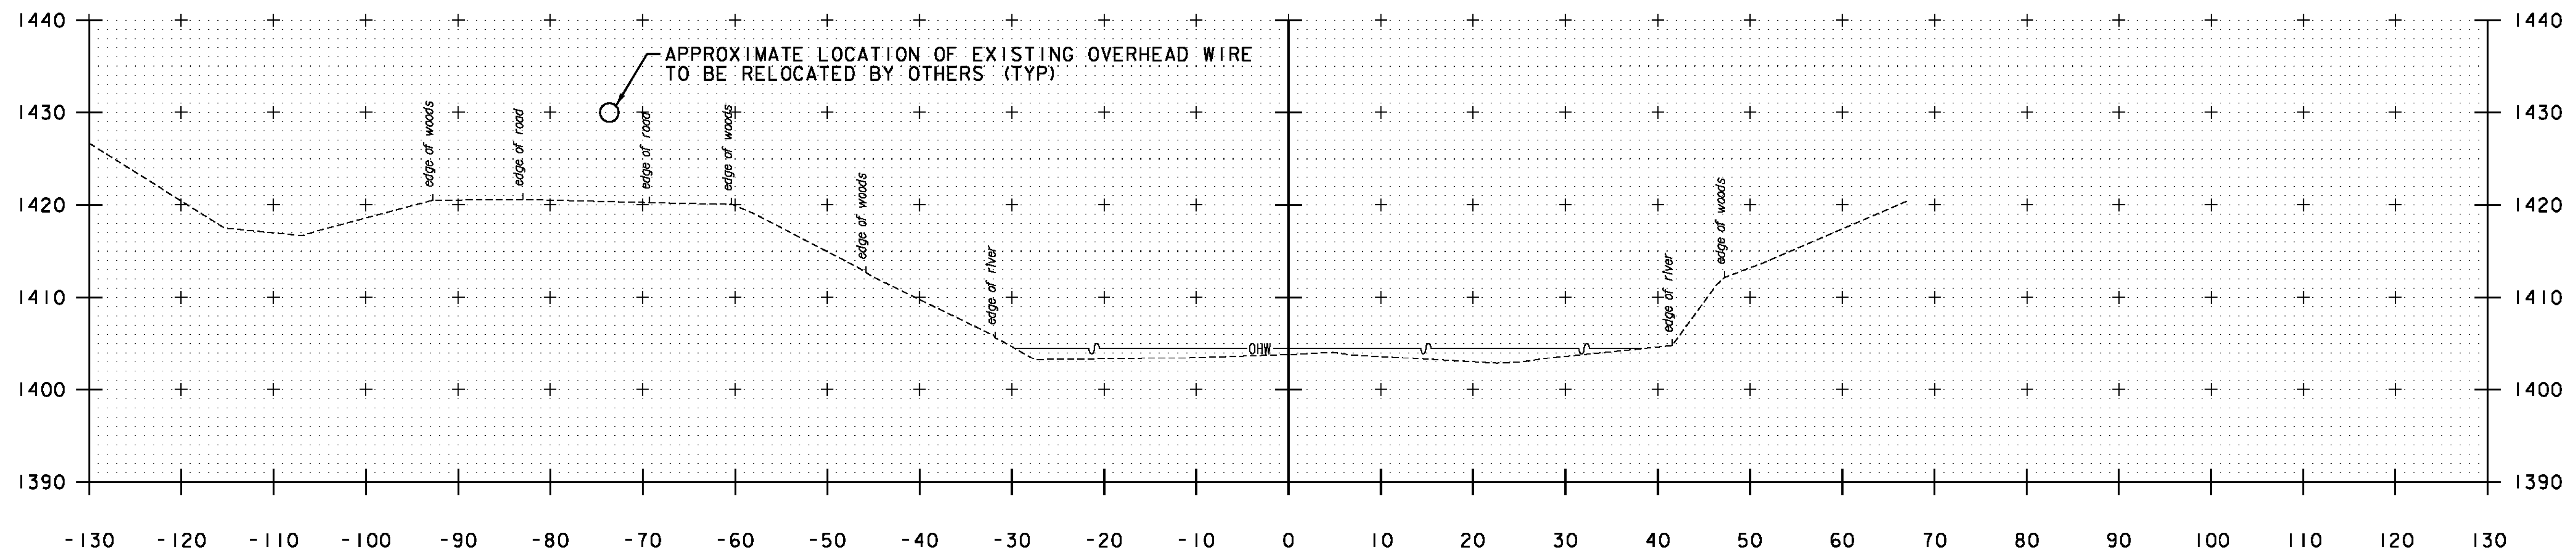

4+00  
 BEGIN PROJECT STA 3+95.00

STA. 3+95 TO STA. 4+46.10

PROJECT NAME: WOODFORD  
 PROJECT NUMBER: ER NH 010-1(47)

FILE NAME: z12b402xsl.dgn  
 PROJECT LEADER: E. ATKINS  
 DESIGNED BY: M. BRADLEY  
 CROSS SECTIONS SHEET 1

PLOT DATE: 12/03/2014  
 DRAWN BY: C. MORIN  
 CHECKED BY: E. ATKINS  
 SHEET 24 OF 35