


BUILT ESSENTIALLY
AS SHOWN

4+52.97 PC

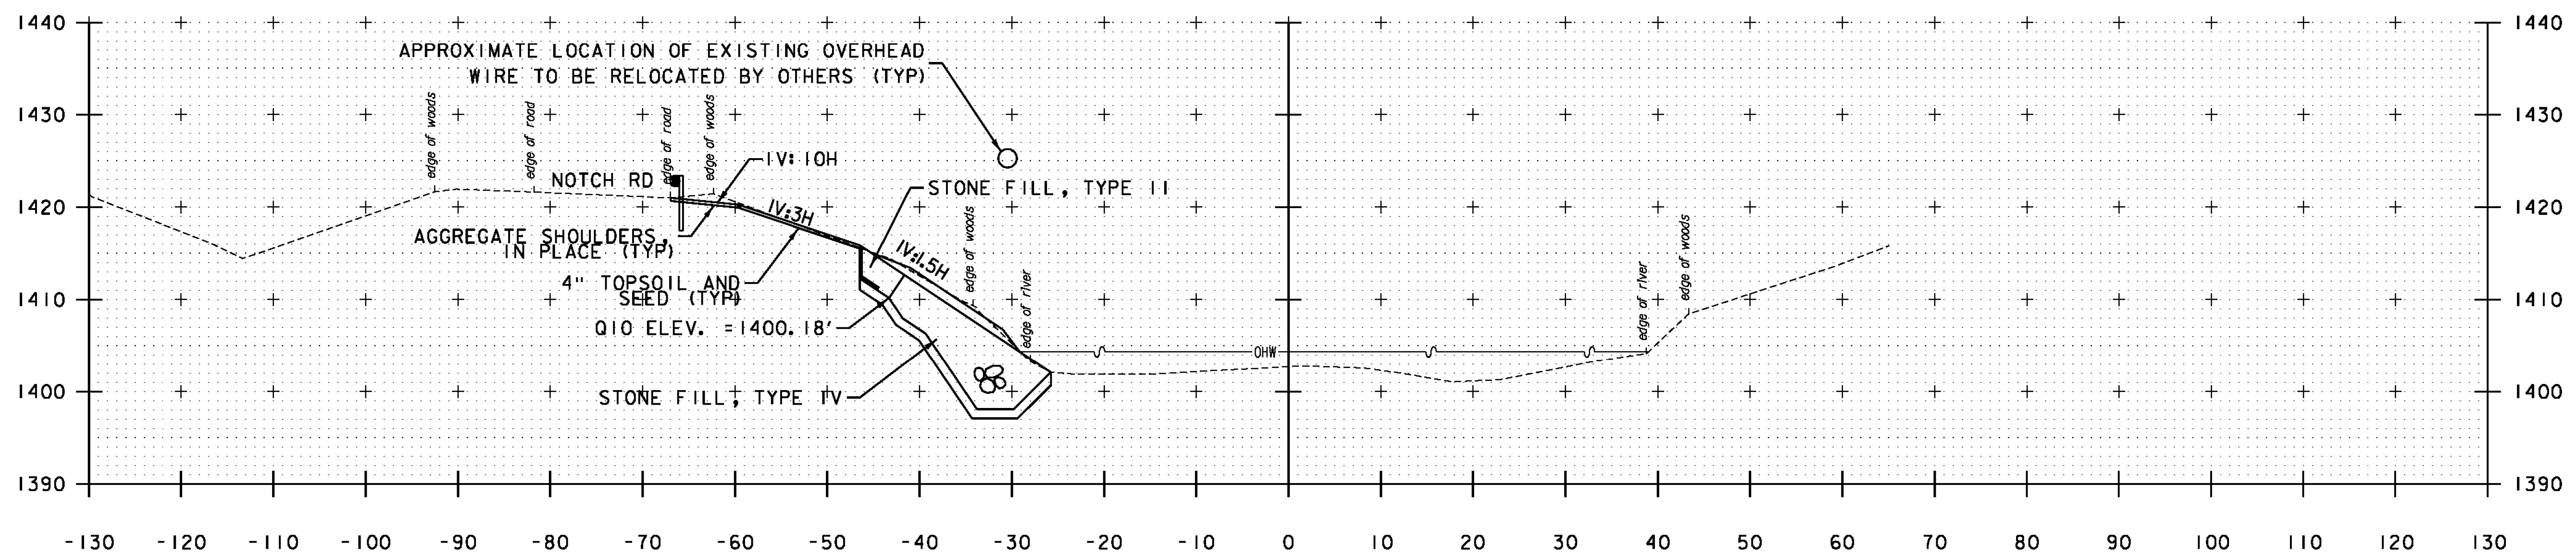

4+50
AND 4+24

SEE NOTE ON SHEET 24

STA. 4+50 TO STA. 4+52.97

PROJECT NAME: WOODFORD
PROJECT NUMBER: ER NH 010-1(47)

FILE NAME: z12b402xsl.dgn
PROJECT LEADER: E. ATKINS
DESIGNED BY: M. BRADLEY
CROSS SECTIONS SHEET 2

PLOT DATE: 12/03/2014
DRAWN BY: C. MORIN
CHECKED BY: E. ATKINS
SHEET 25 OF 35