


7+02.05 PT

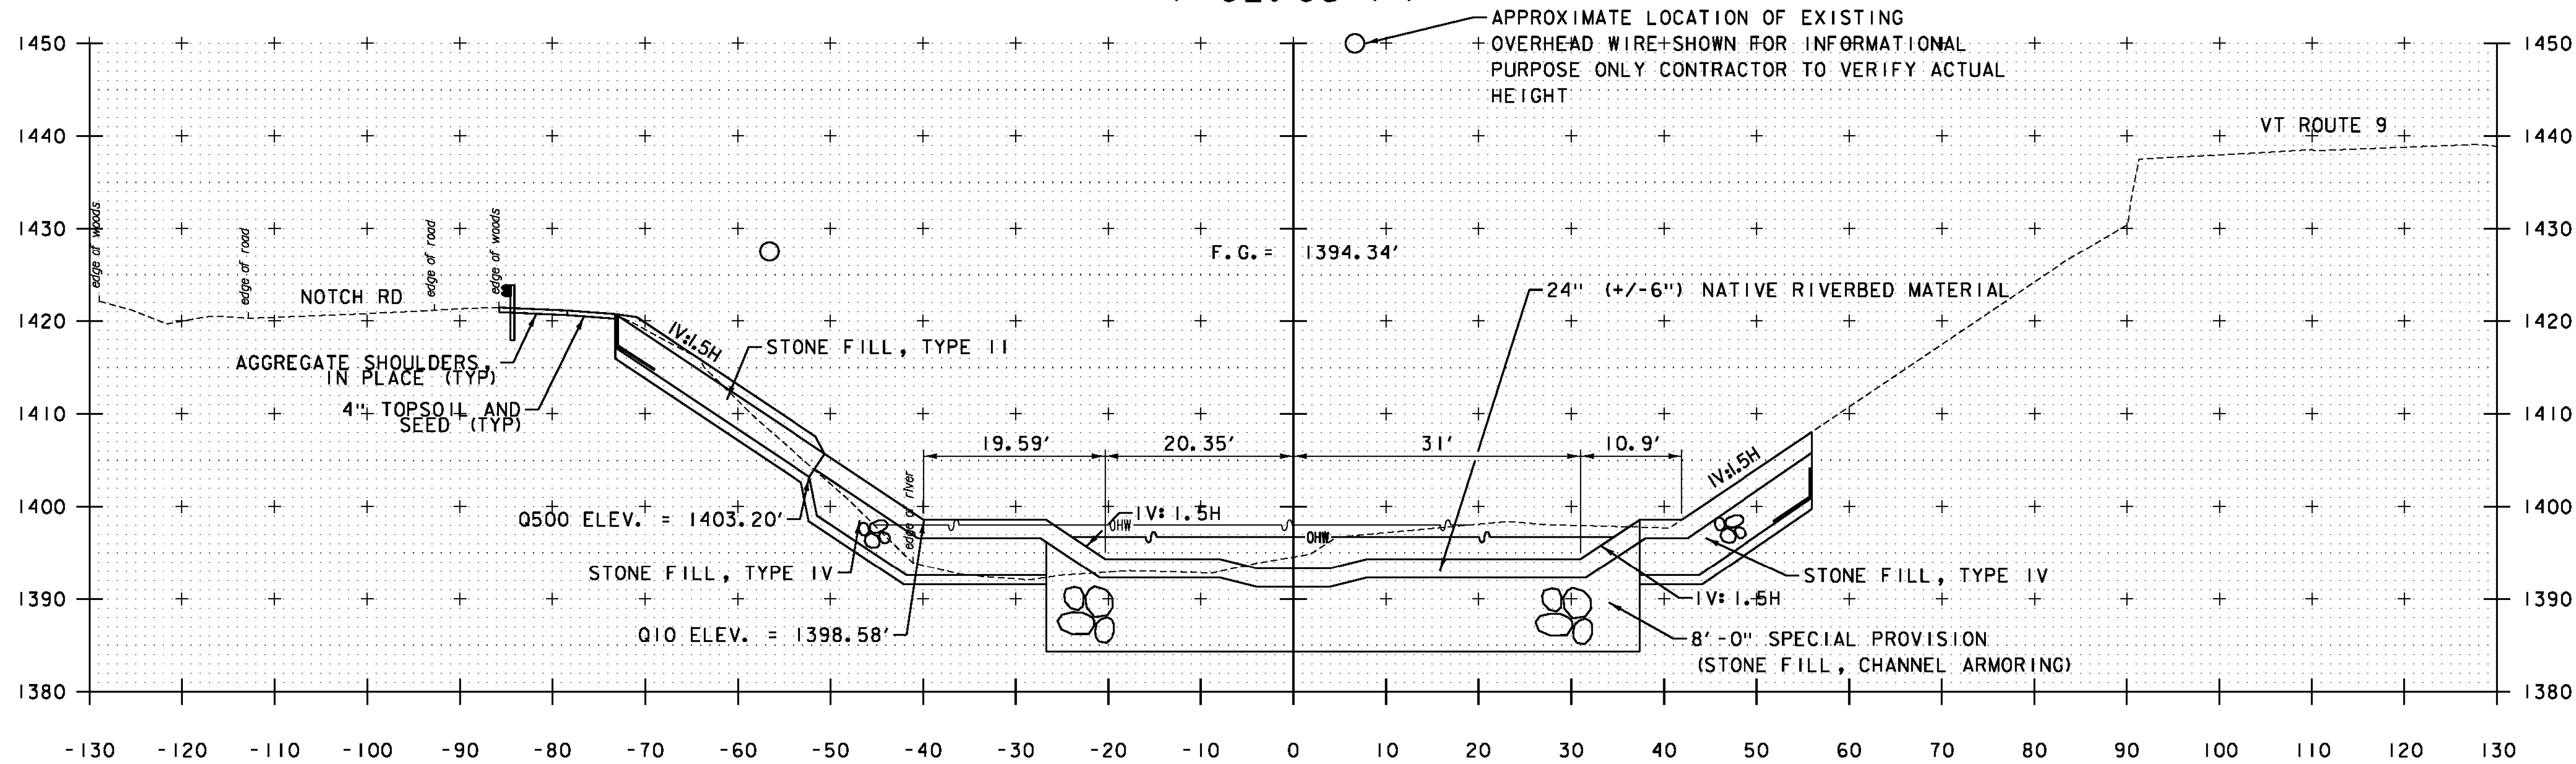

7+00

BUILT ESSENTIALLY AS SHOWN

NOTE: THERE WAS NO TYPE II OR TYPE IV STONE FILL PLACED FROM STA 7+13 RT TO STA 7+50 RT BEHIND PIER 2

STA. 7+00 TO STA. 7+02.05

PROJECT NAME: WOODFORD  
PROJECT NUMBER: ER NH 010-1(47)

FILE NAME: z12b402xsl.dgn  
PROJECT LEADER: E. ATKINS  
DESIGNED BY: M. BRADLEY  
CROSS SECTIONS SHEET 8

PLOT DATE: 12/03/2014  
DRAWN BY: C. MORIN  
CHECKED BY: E. ATKINS  
SHEET 31 OF 35

