


END CHANNEL BOTTOM  
ARMORING 8+50

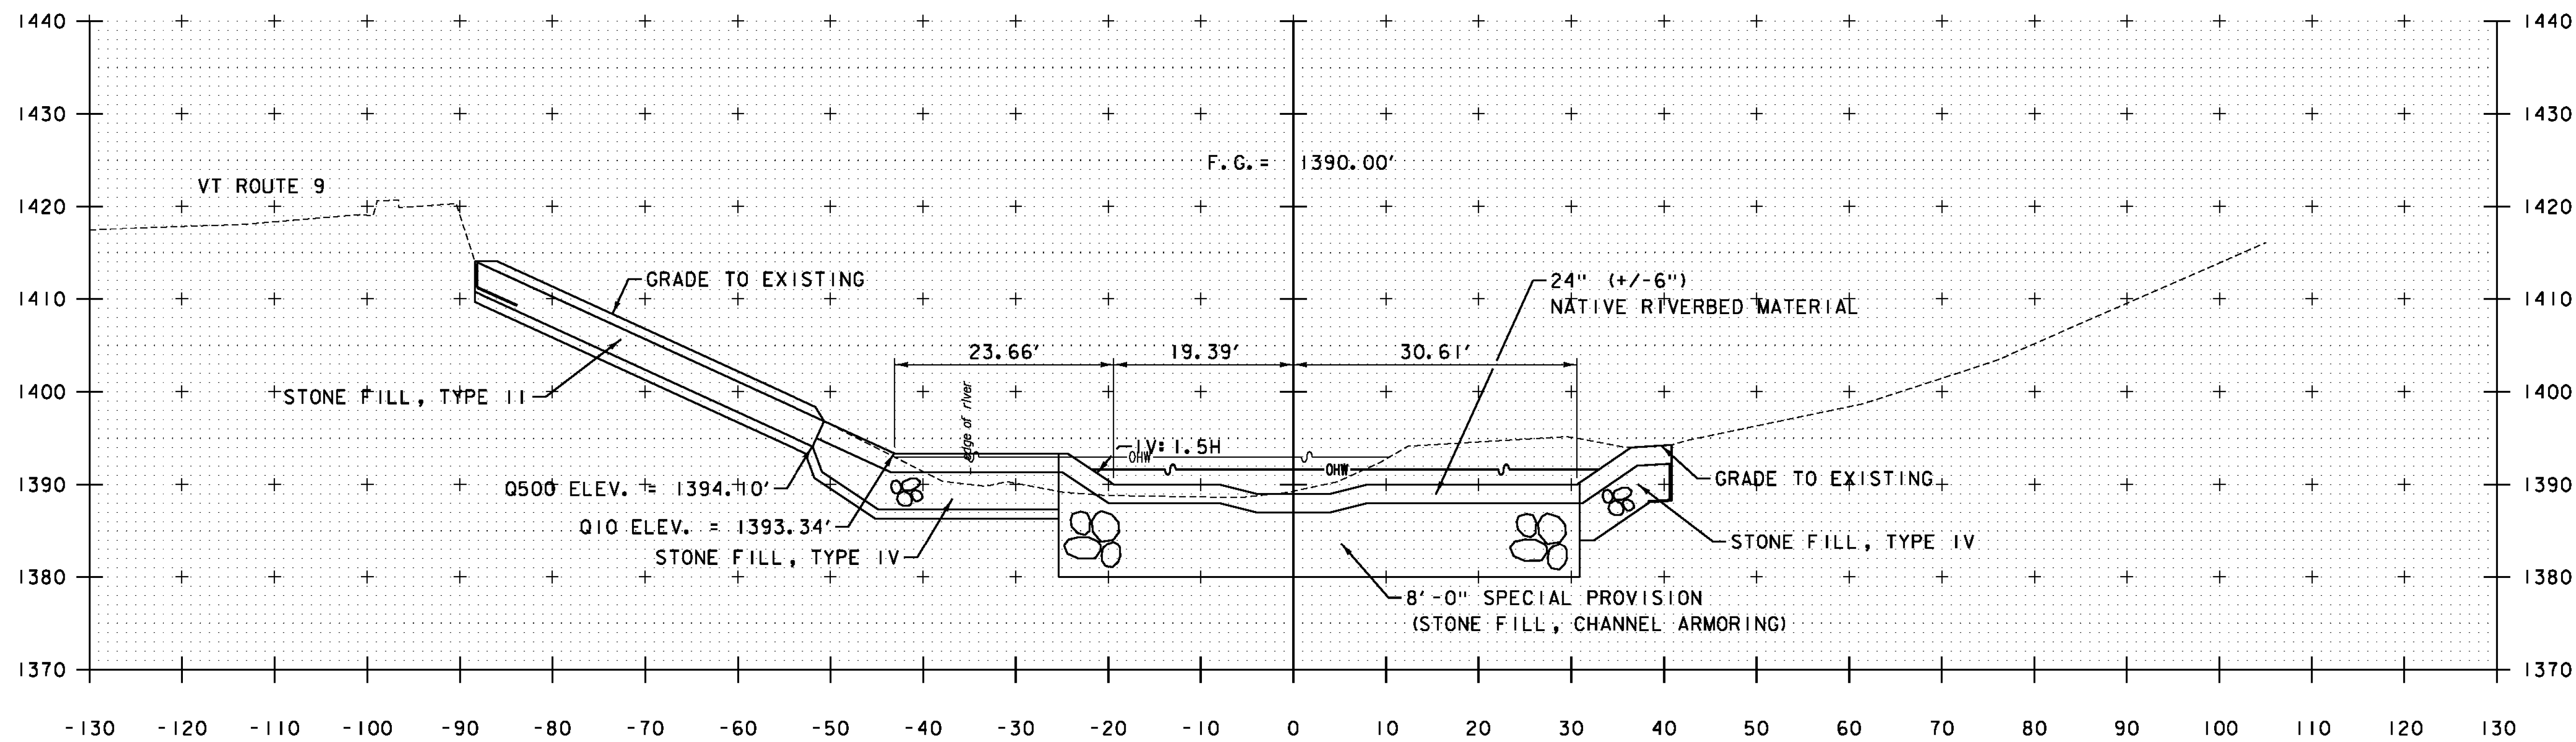

8+15.46 PC

BUILT ESSENTIALLY  
AS SHOWN

NOTE: RESUME TYPE II AND TYPE IV  
STONE FILL AT STA 8+14 LT

STA. 8+15.46 TO STA. 8+50

PROJECT NAME: WOODFORD  
PROJECT NUMBER: ER NH 010-1(47)

FILE NAME: z12b402xsl.dgn  
PROJECT LEADER: E. ATKINS  
DESIGNED BY: M. BRADLEY  
CROSS SECTIONS SHEET 10

PLOT DATE: 12/03/2014  
DRAWN BY: C. MORIN  
CHECKED BY: E. ATKINS  
SHEET 33 OF 35