


BUILT ESSENTIALLY
AS SHOWN

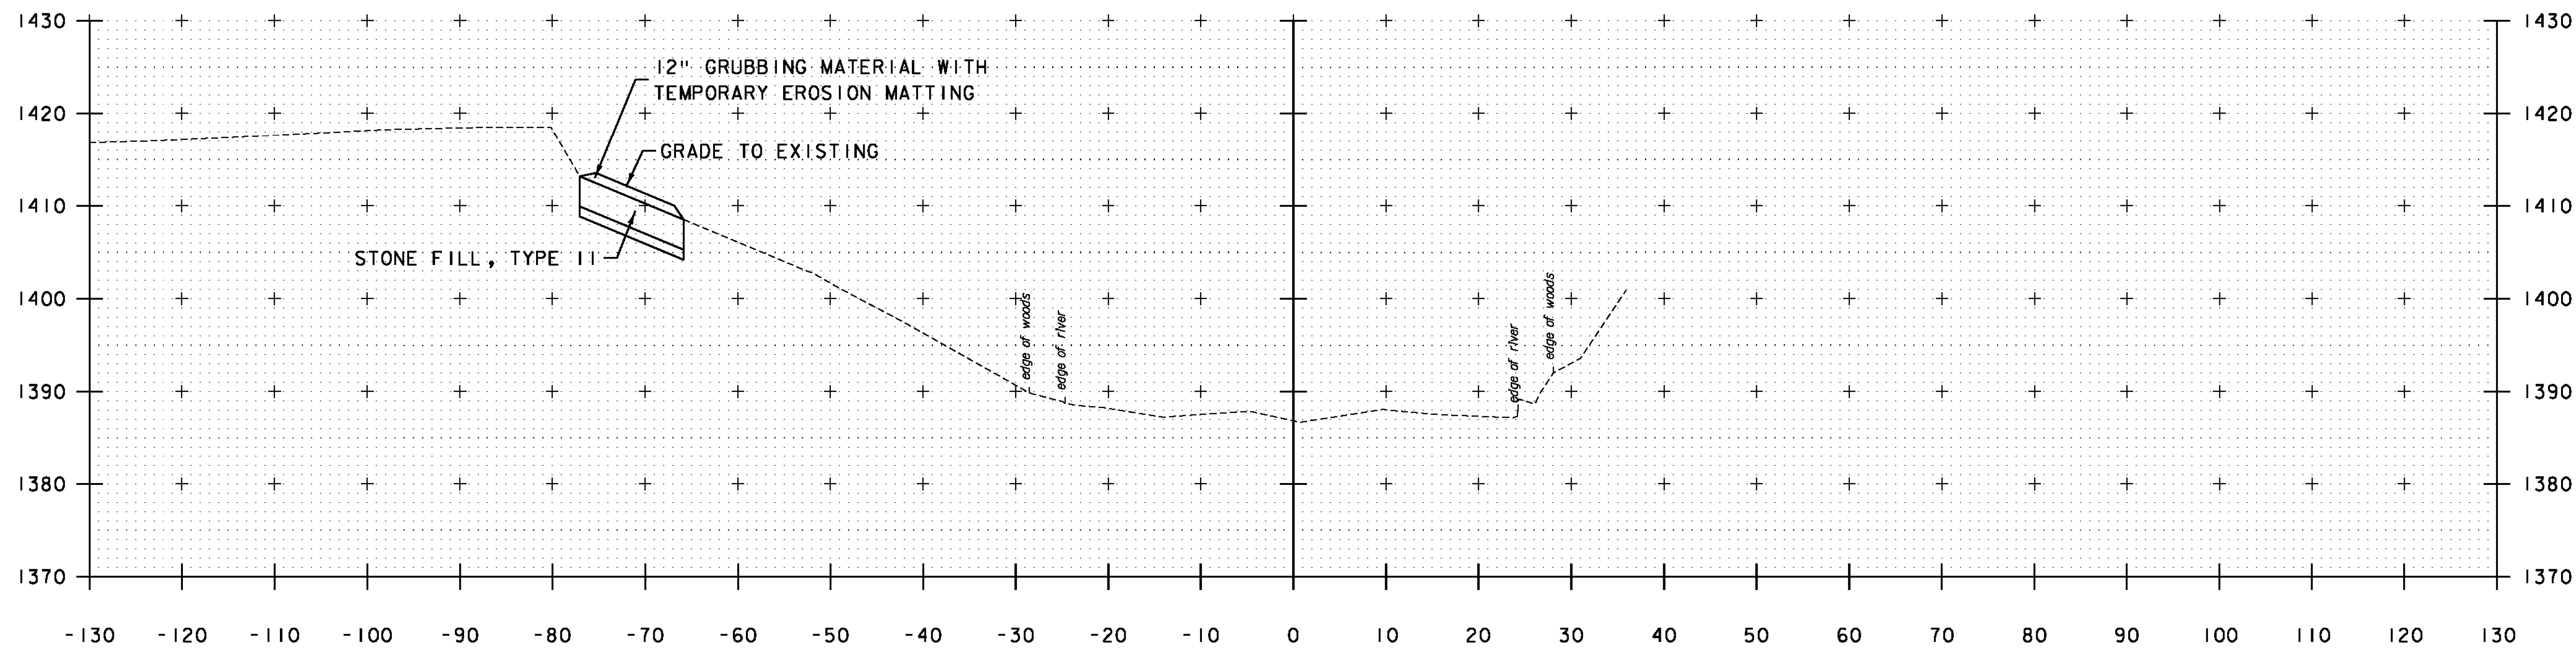

9+00
END PROJECT 9+20.13

STA. 9+00 TO STA. 9+20.13

PROJECT NAME: WOODFORD
PROJECT NUMBER: ER NH 010-1(47)

FILE NAME: z12b402xsl.dgn
PROJECT LEADER: E. ATKINS
DESIGNED BY: M. BRADLEY
CROSS SECTIONS SHEET II

PLOT DATE: 12/03/2014
DRAWN BY: C. MORIN
CHECKED BY: E. ATKINS
SHEET 34 OF 35