



STATE OF VERMONT AGENCY OF TRANSPORTATION

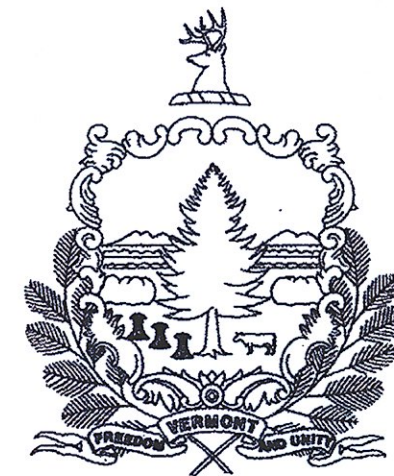


PROPOSED IMPROVEMENT TOWN OF SEARSBURG COUNTY OF BENNINGTON VT ROUTE 9 (PRINCIPAL ARTERIAL - NHS)

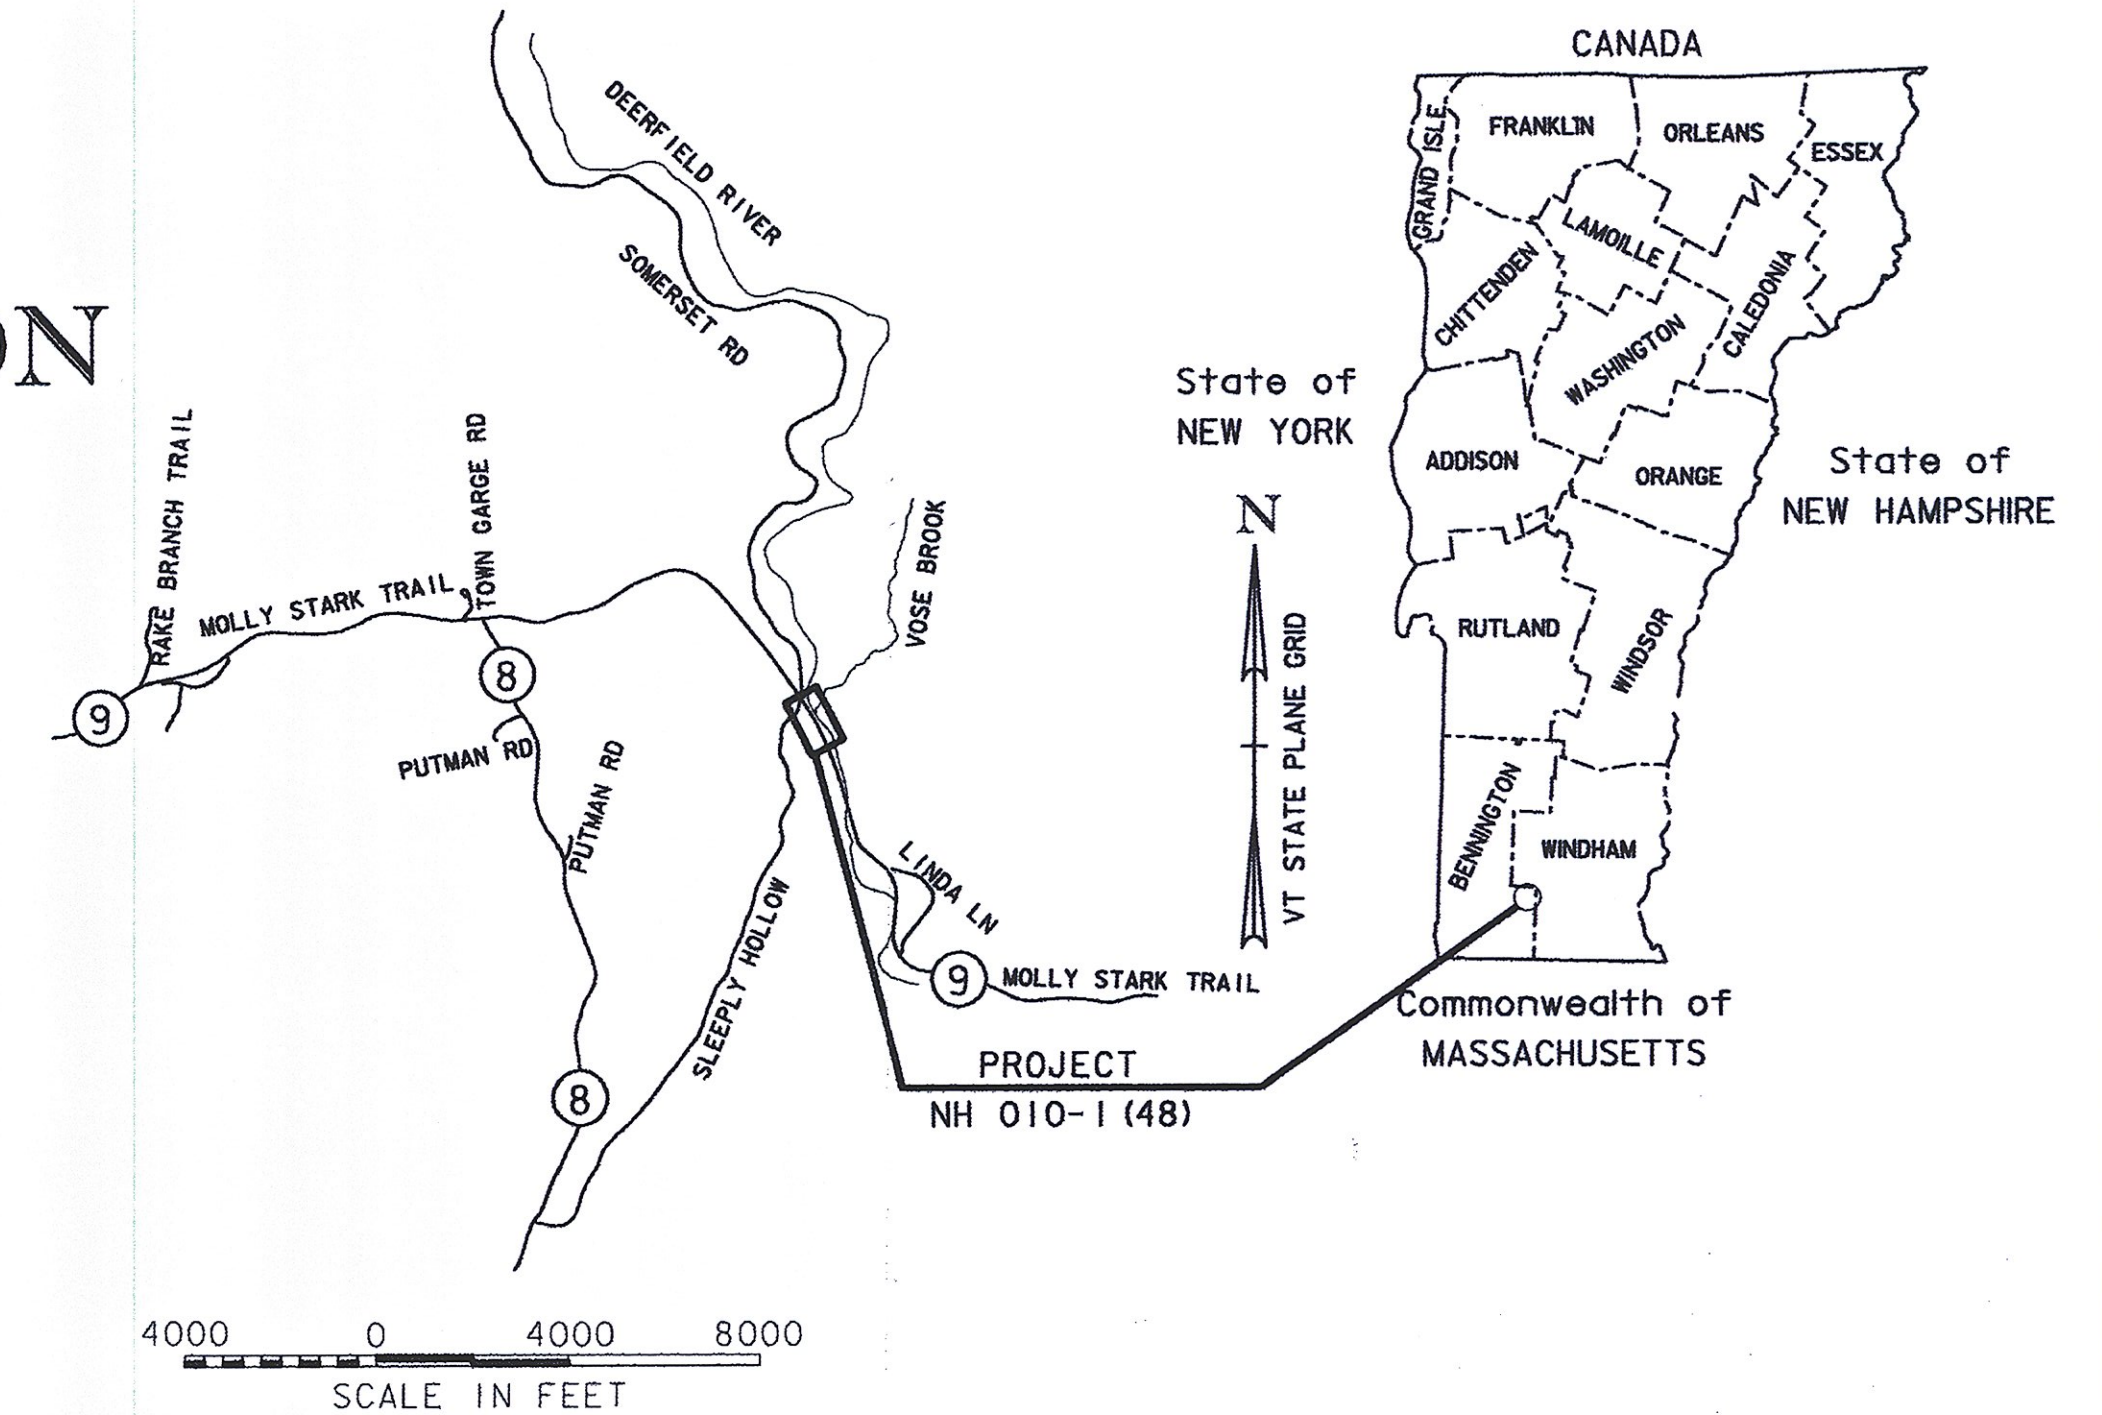

RECORD PLANS	
CONTRACTOR:	WEAVER EXCAVATING, INC. - SHAFTSBURY, VT
RESIDENT ENGINEER:	RON LEMAIRE
CONSTRUCTION BEGAN:	SEPTEMBER 25, 2014
CONSTRUCTION COMPLETE:	NOVEMBER 19, 2014
RECORD PLANS BY:	RON LEMAIRE & C. PIERCE
I HEREBY CERTIFY THAT ALL THE CONSTRUCTION REQUIRED BY THIS SET OF DRAWINGS HAS BEEN ACCOMPLISHED AS INDICATED HEREIN.	
BY	RESIDENT ENGINEER
DATE 3/7/16	Ronald Lemaire
NOTE: Any further information concerning final quantities, amounts or other details relative to this project may be found at Central Files in the electronic archives.	


BEGINNING IN THE TOWN OF SEARSBURG ON VT ROUTE 9 AT STATION 18+00.00 (MM 3.606±)
EXTENDING EASTERLY TO STATION 27+60.00 (MM 3.424±) 28+50 (MM 3.407)
LENGTH OF PROJECT = ~~960.00 FEET (0.182 MILES)~~ 1050.00 FEET (0.199 MILES)
THIS PROJECT CONSISTS OF EMBANKMENT RECONSTRUCTION, GUARDRAIL, CONSTRUCTION OF ACCESS ROAD, INSTALLING STONE FILL AND EROSION PREVENTION AND SEDIMENT CONTROL

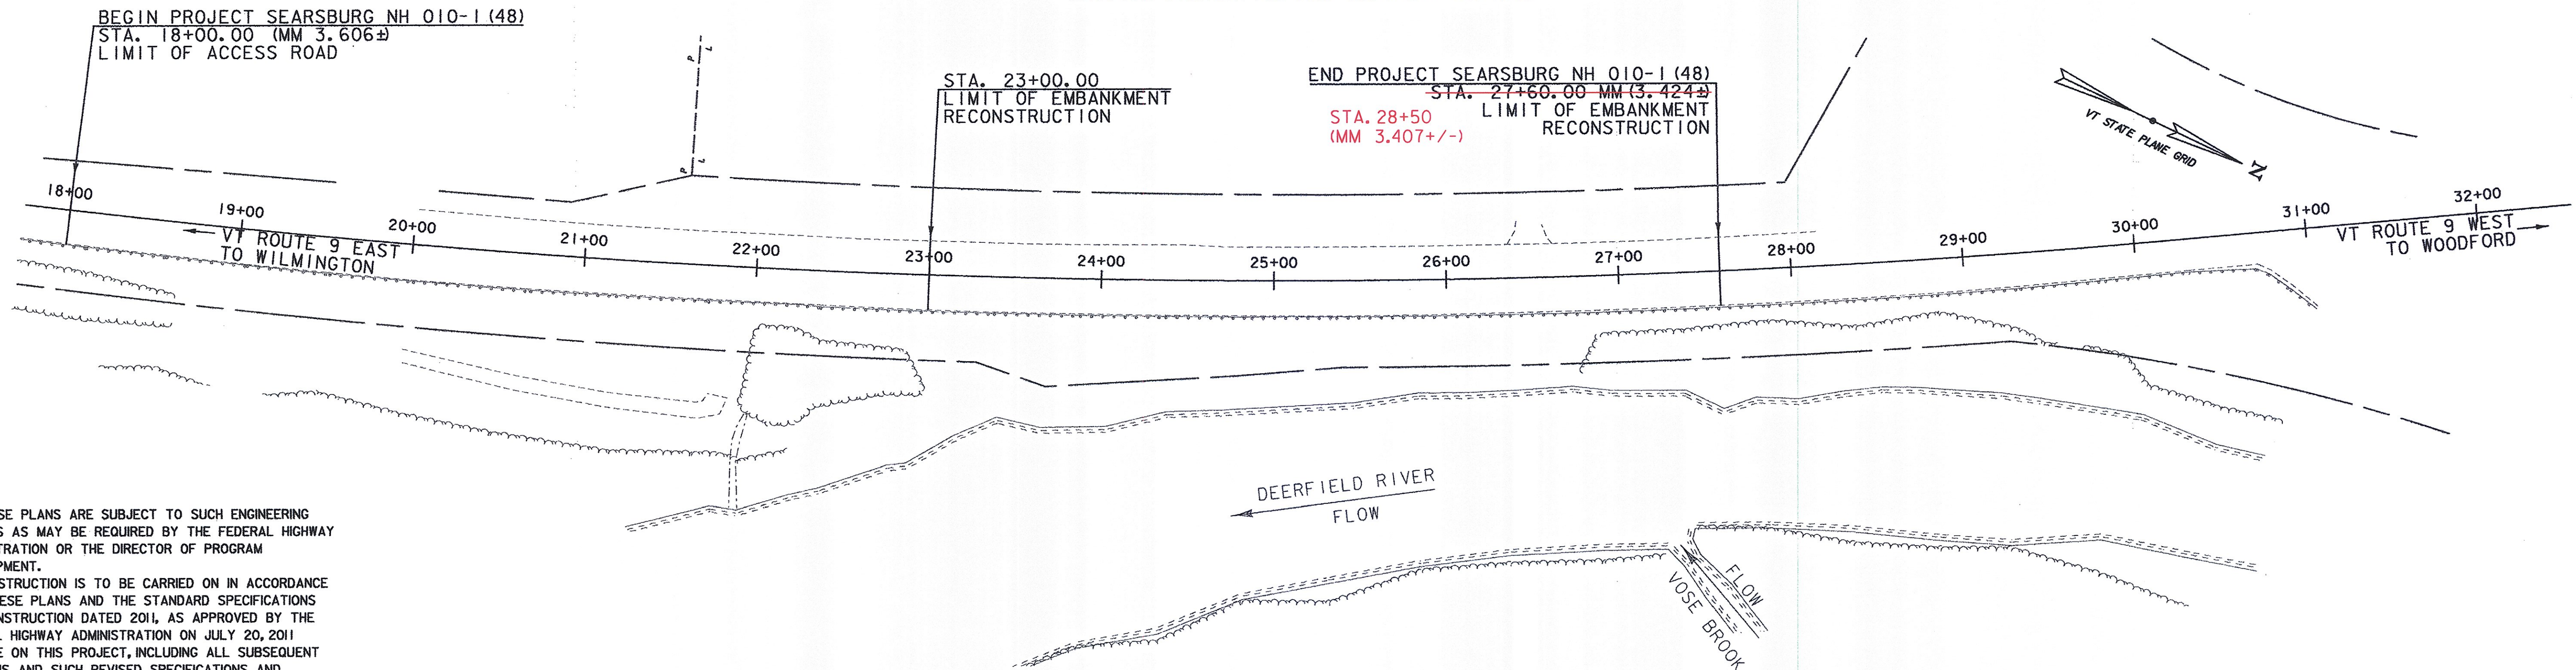

THESE PLANS ARE SUBJECT TO SUCH ENGINEERING CHANGES AS MAY BE REQUIRED BY THE FEDERAL HIGHWAY ADMINISTRATION OR THE DIRECTOR OF PROGRAM DEVELOPMENT.
CONSTRUCTION IS TO BE CARRIED ON IN ACCORDANCE WITH THESE PLANS AND THE STANDARD SPECIFICATIONS FOR CONSTRUCTION DATED 2011, AS APPROVED BY THE FEDERAL HIGHWAY ADMINISTRATION ON JULY 20, 2011 FOR USE ON THIS PROJECT, INCLUDING ALL SUBSEQUENT REVISIONS AND SUCH REVISED SPECIFICATIONS AND SPECIAL PROVISIONS AS ARE INCORPORATED IN THESE PLANS.

QUALITY ASSURANCE PROGRAM : LEVEL I
SURVEYED BY : VTRANS VERMONT SURVEY AND ENGINEERING
SURVEYED DATE : 4/15/2012 & 1/22/2013
DATUM
VERTICAL NAVD 88 FT
HORIZONTAL NAD 83 / (1992) sFT

TRAFFIC DATA					
YEAR	ADT	DHV	% D	% T	ADTT
2013	3,600	430	52%	9.8%	430
2023	3,700	580	52%	11.5%	520
18 kip ESAL for flexible pavement from 2013 to 2023: 1,433,000 18 kip ESAL for flexible pavement from 2013 to 2033: 3,123,000 Design speed: N/A					

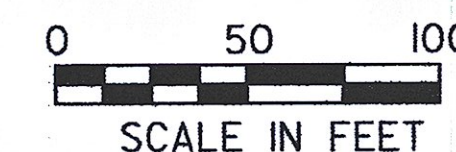

	DIRECTOR OF PROGRAM DEVELOPMENT
	APPROVED DATE 6-16-14
	PROJECT MANAGER : PAUL LIBBY
PROJECT NAME : SEARSBURG	
PROJECT NUMBER : NH 010-1 (48)	
SHEET 1 OF 45 SHEETS	