


TYPICAL SECTIONS


18" SUBBASE OF DENSE GRADED CRUSHED STONE

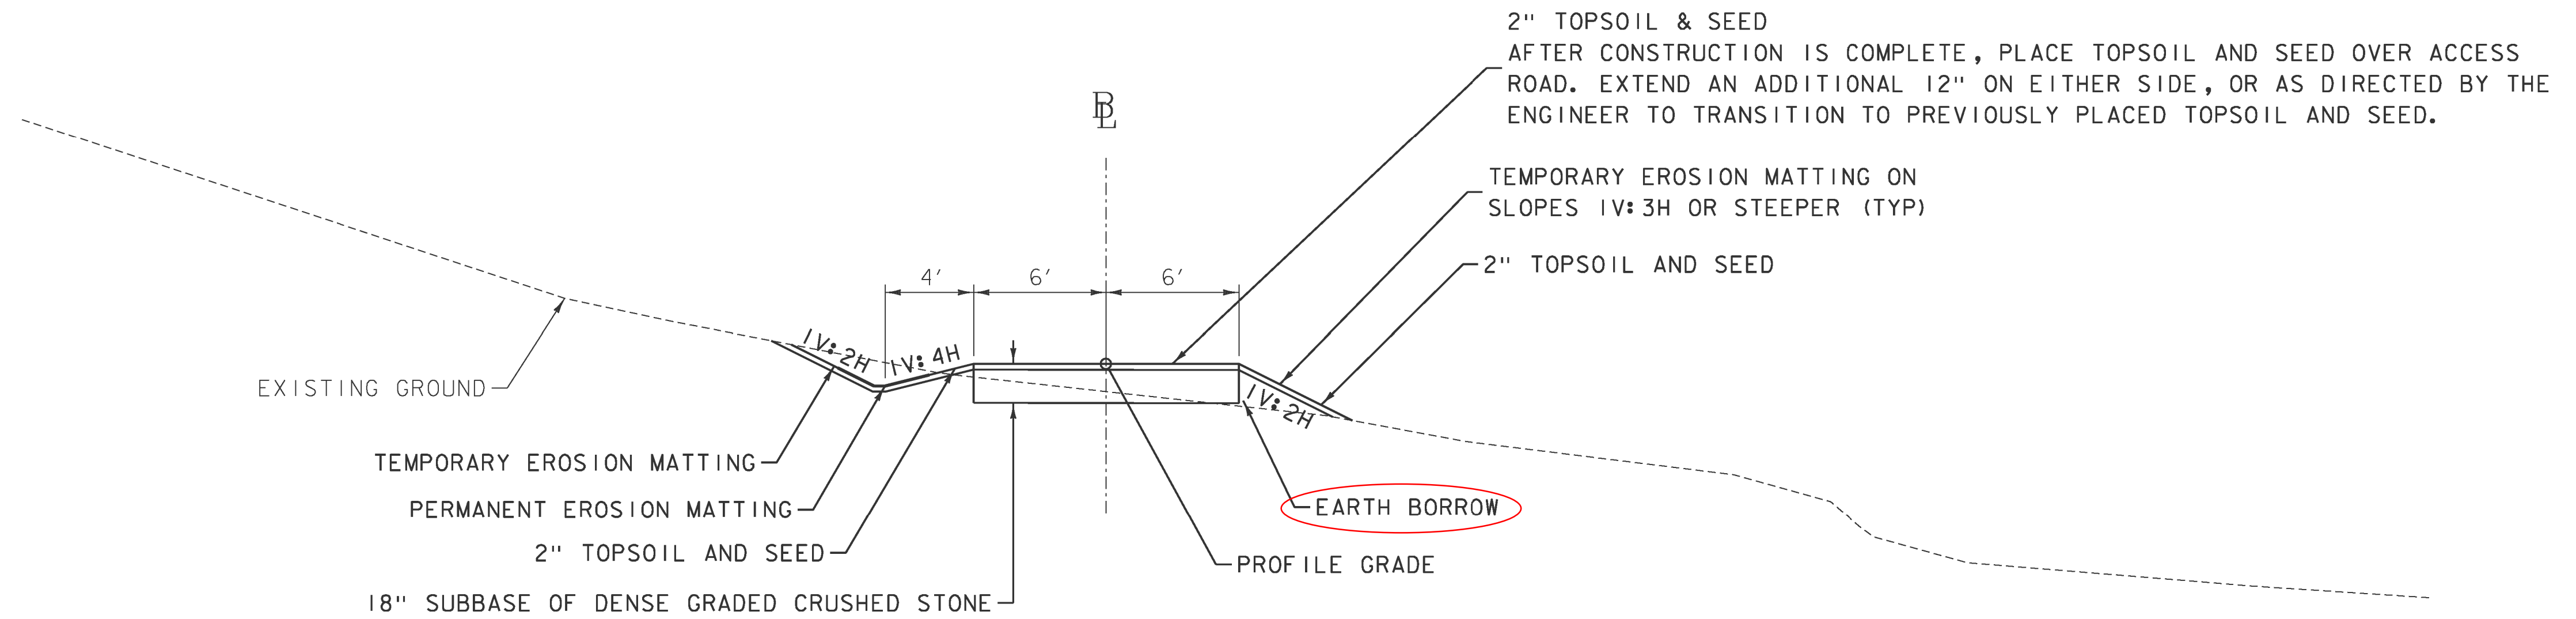

TYPICAL ACCESS ROAD SECTION
STA. 83+62.00-84+87.58

NOT TO SCALE

EARTH BORROW NOT USED
CONTRACTOR GRADED EXISTING
AREA + MATERIALS

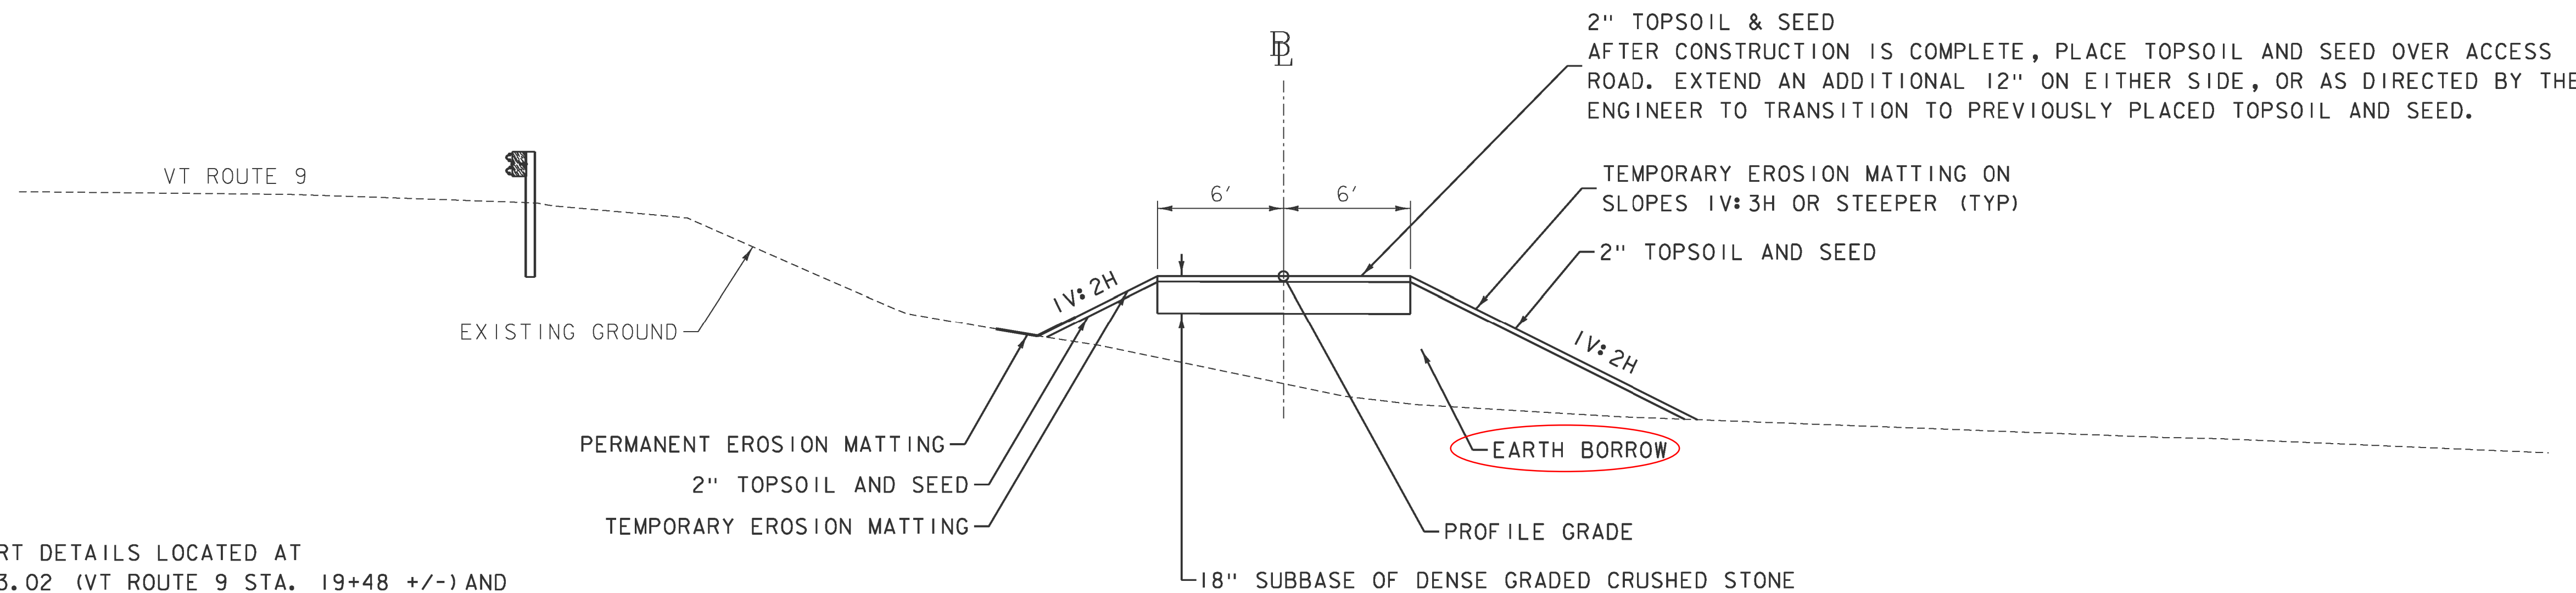

TYPICAL ACCESS ROAD SECTION
STA. 80+21.52-83+62.00

NOT TO SCALE

NOTES: FOR CULVERT DETAILS LOCATED AT
STA. 81+13.02 (VT ROUTE 9 STA. 19+48 +/-) AND
STA. 83+70.52 (VT ROUTE 9 STA. 21+98 +/-),
REFER TO CROSS SECTIONS

PROJECT NAME: SEARSBURG
PROJECT NUMBER: NH 010-1(48)

FILE NAME: z12B404typ.dgn
PROJECT LEADER: E. ATKINS
DESIGNED BY: M. BRADLEY
TYPICAL SECTION SHEET 3

PLOT DATE: 6/16/2014
DRAWN BY: M. BRADLEY
CHECKED BY: E. ATKINS
SHEET 6 OF 45