

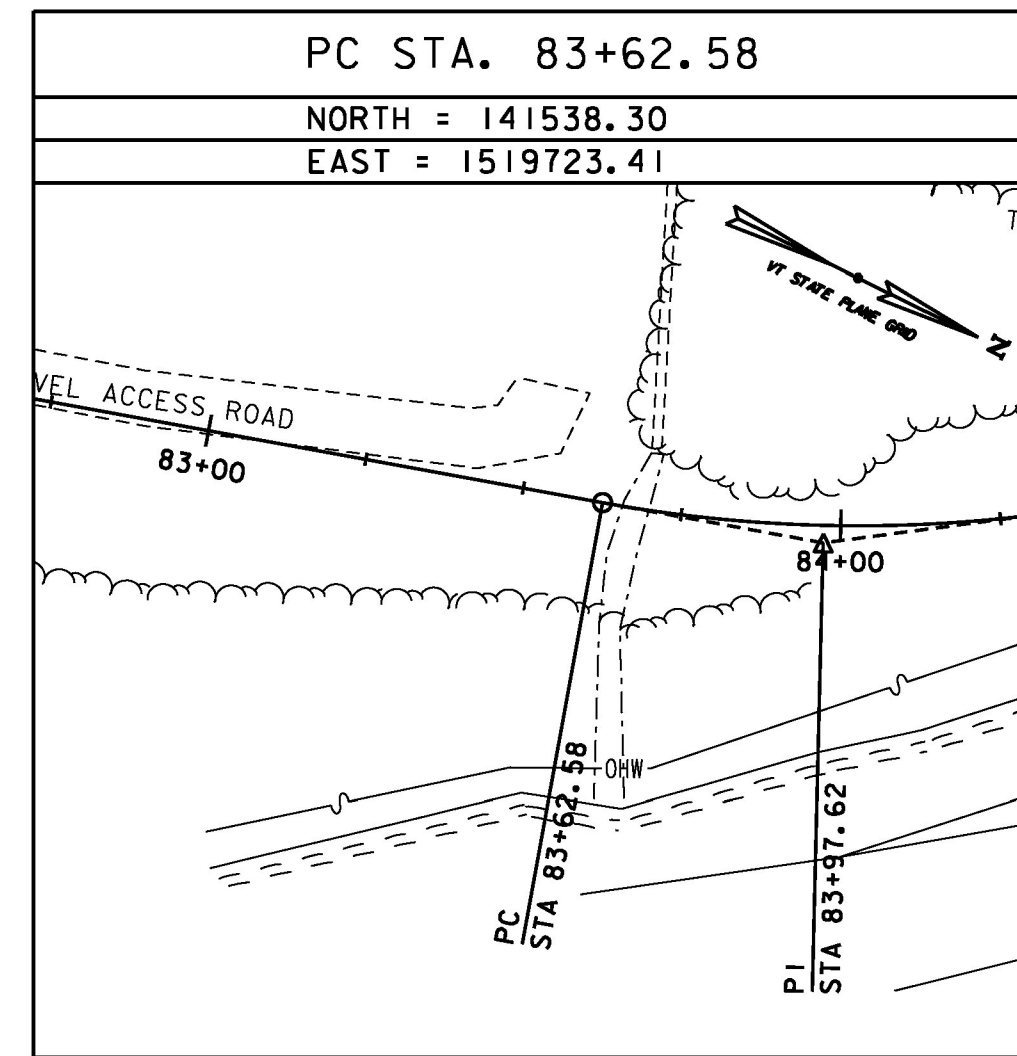
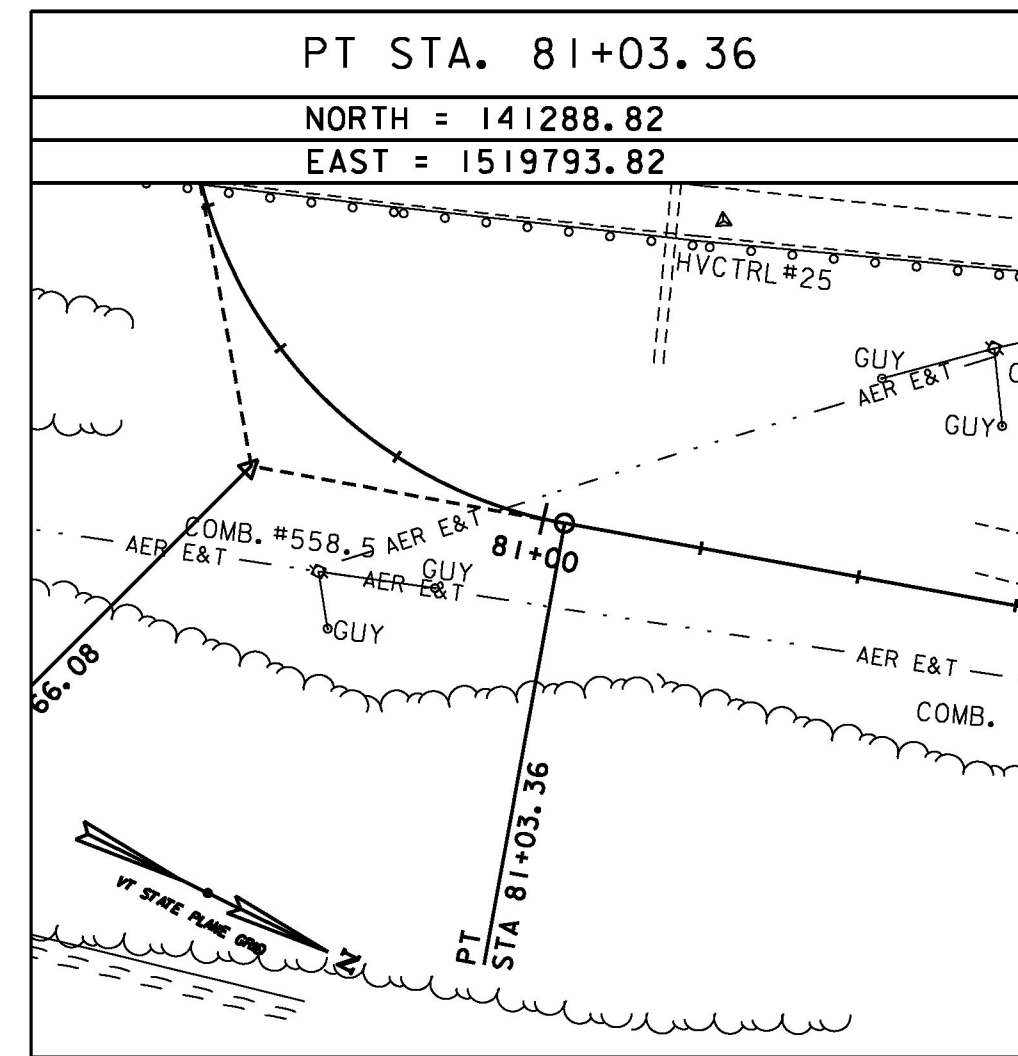
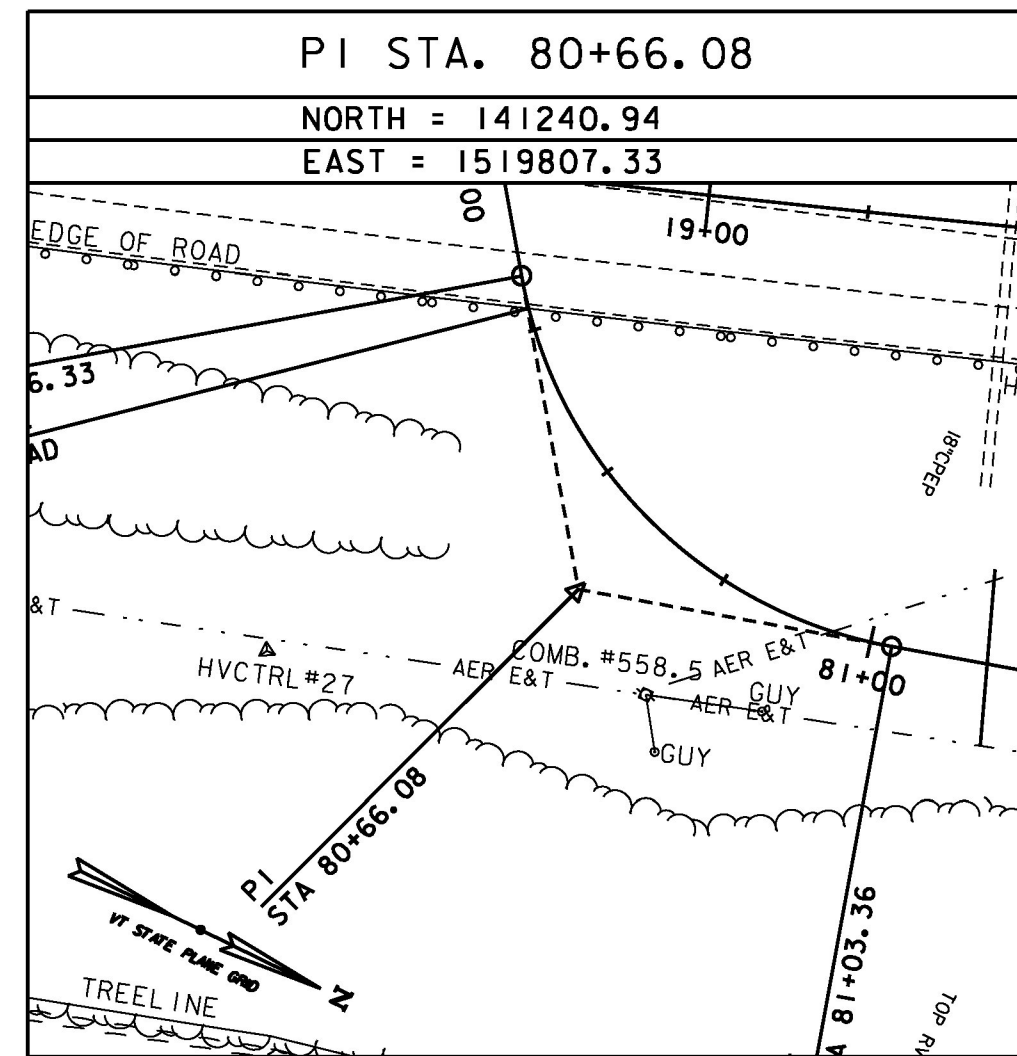
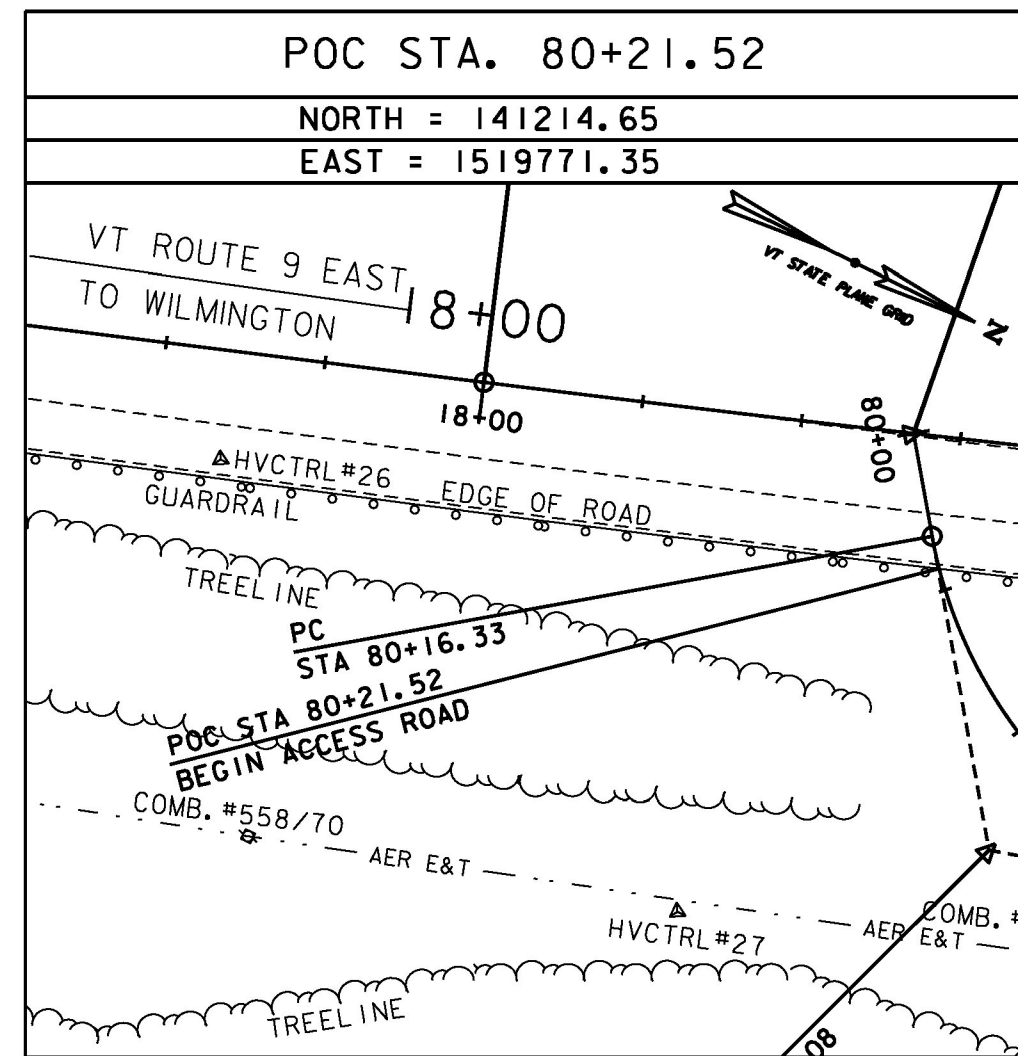 
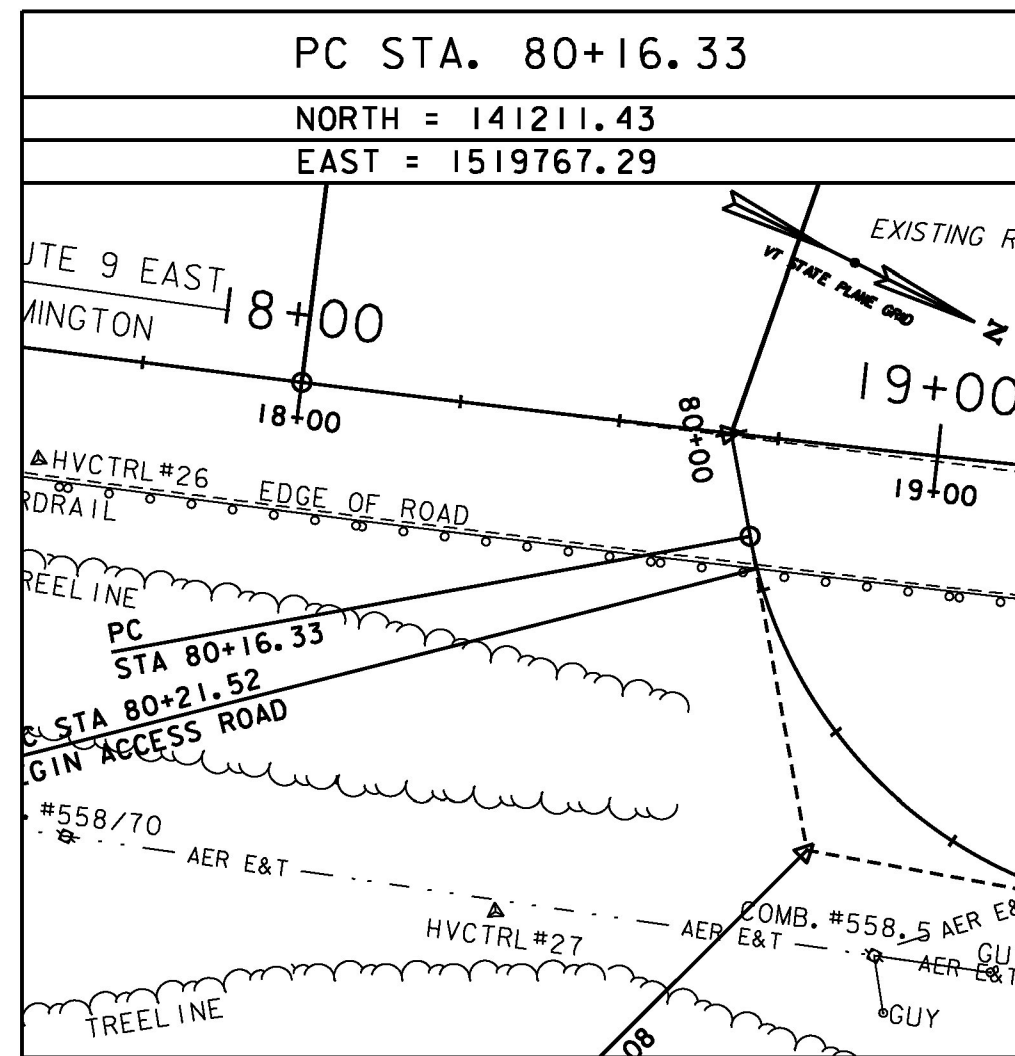 


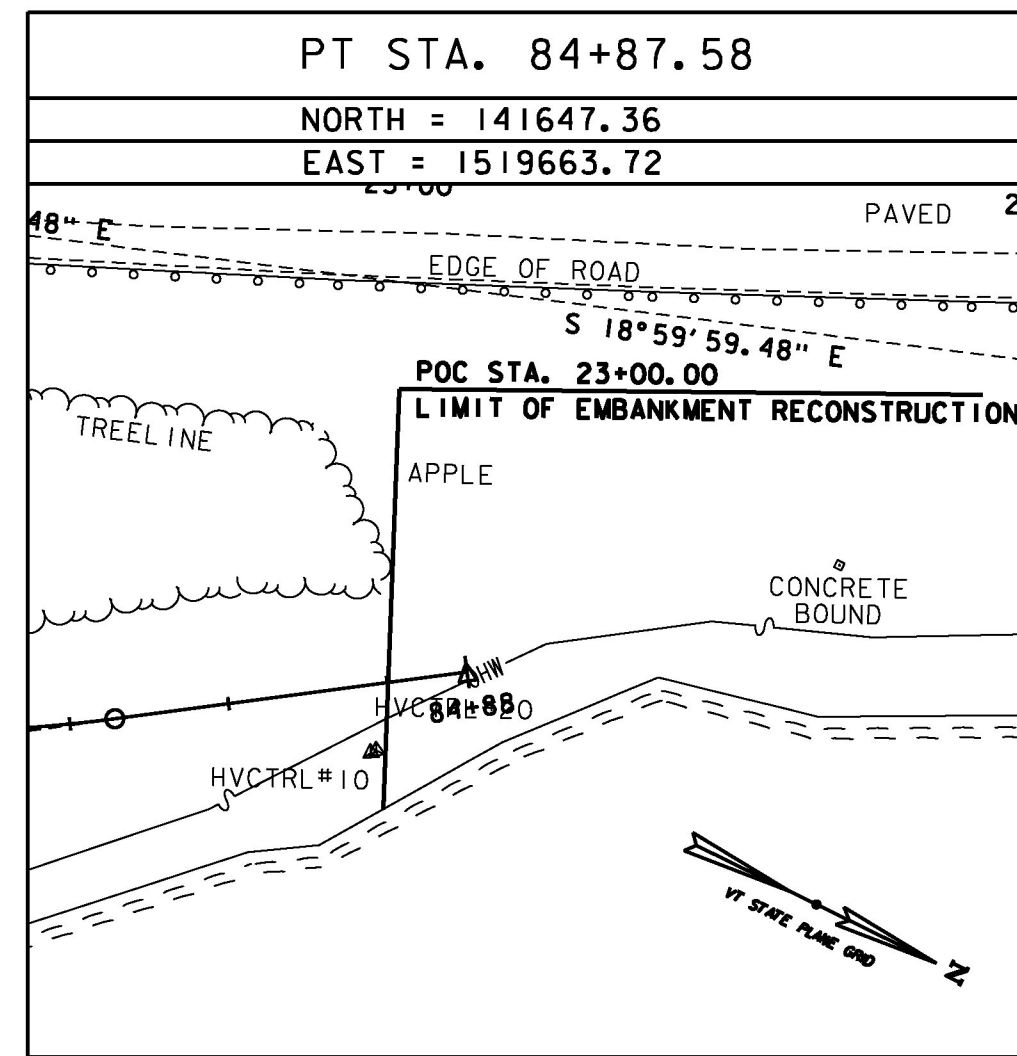







ALIGNMENT TIES

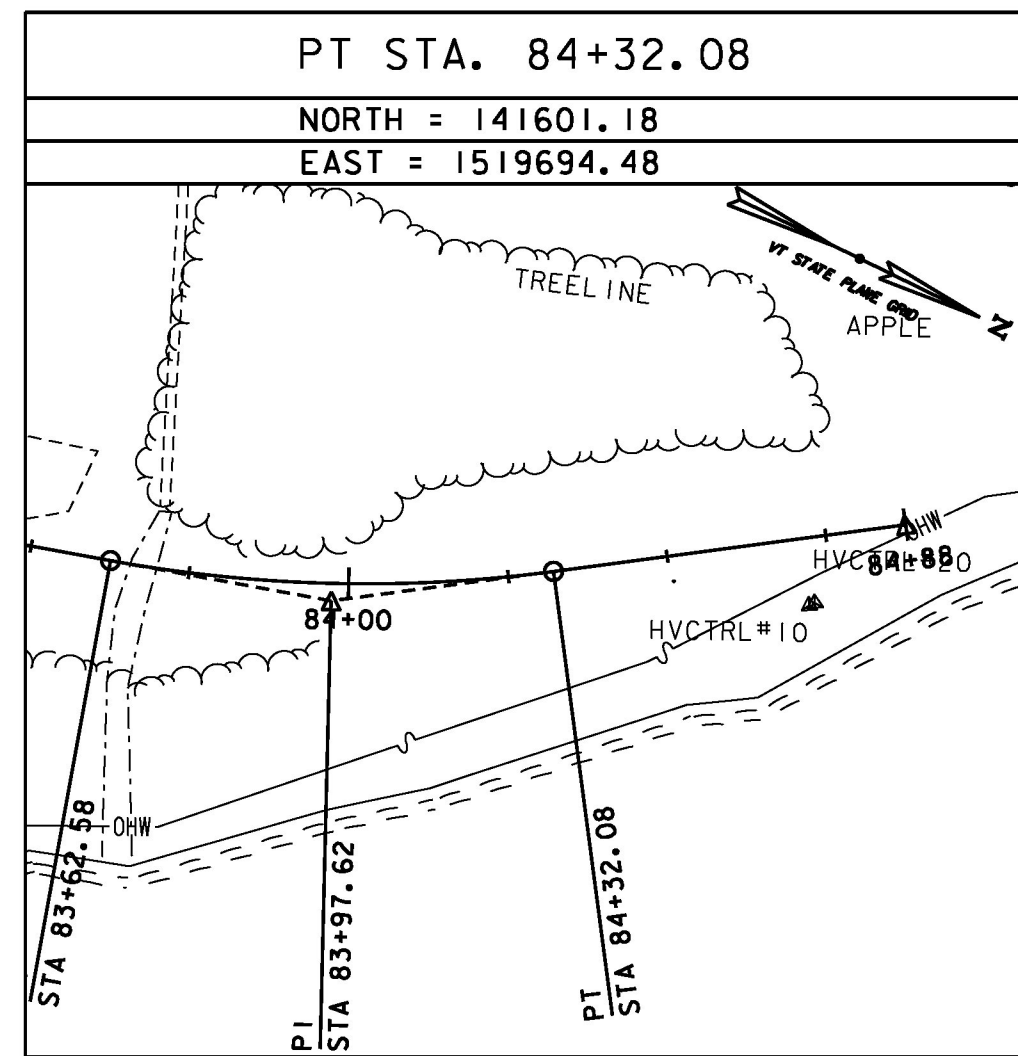


ALIGNMENT TIES

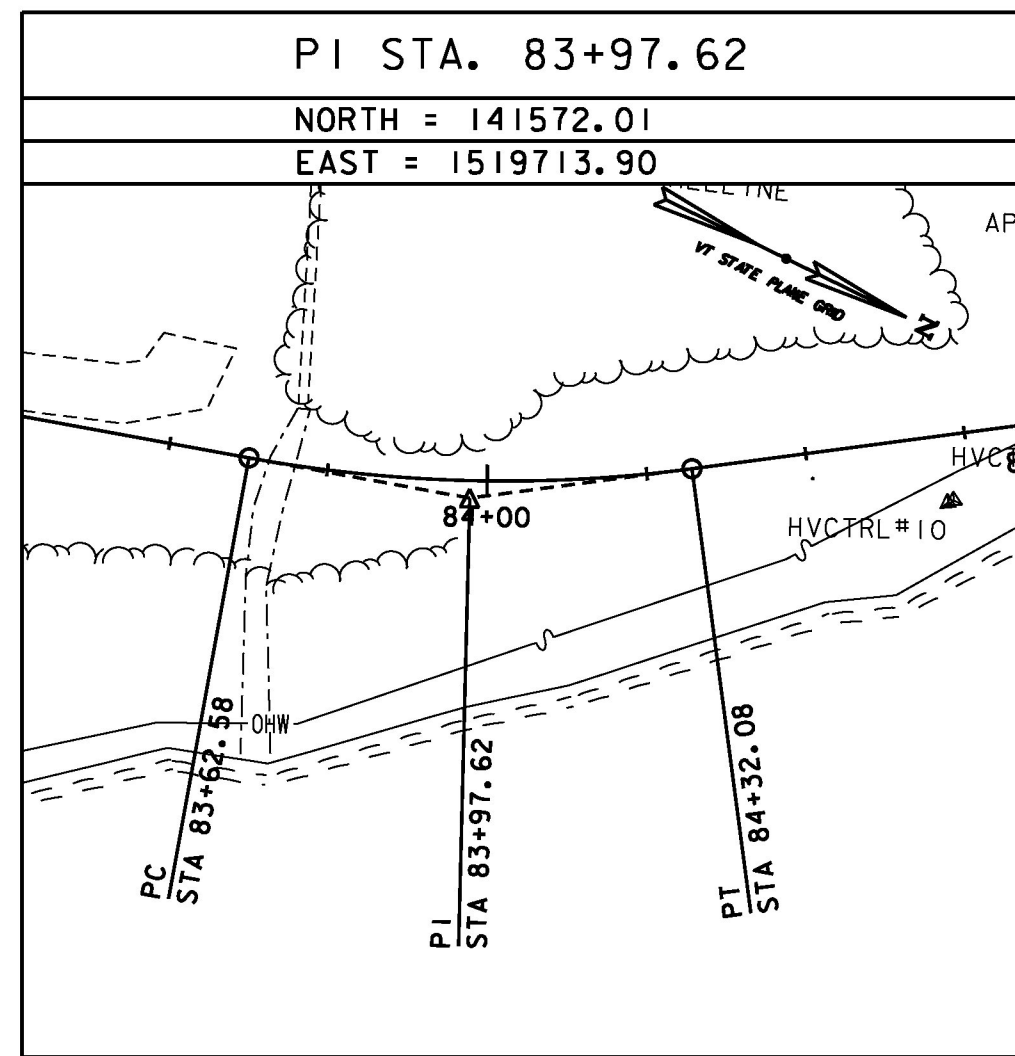

     ALIGNMENT TIES



DATUM
 VERTICAL NAVD 88 FT
 HORIZONTAL NAD 83(1992) sFT
 ADJUSTMENT NONE

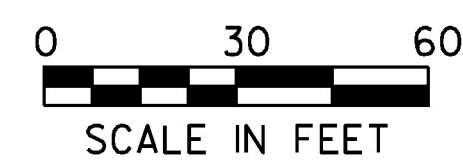

SCALE IN FEET
 GREEN INTERNATIONAL AFFILIATES, INC.
 CIVIL AND STRUCTURAL ENGINEERS

PROJECT NAME: SEARSBURG
 PROJECT NUMBER: NH 010-1(48)

FILE NAME: z12B404+1e2.dgn
 PROJECT LEADER: E. ATKINS
 DESIGNED BY: M. BRADLEY
 TIE SHEET 2

PLOT DATE: 6/16/2014
 DRAWN BY: C. MORIN
 CHECKED BY: E. ATKINS
 SHEET 8 OF 45